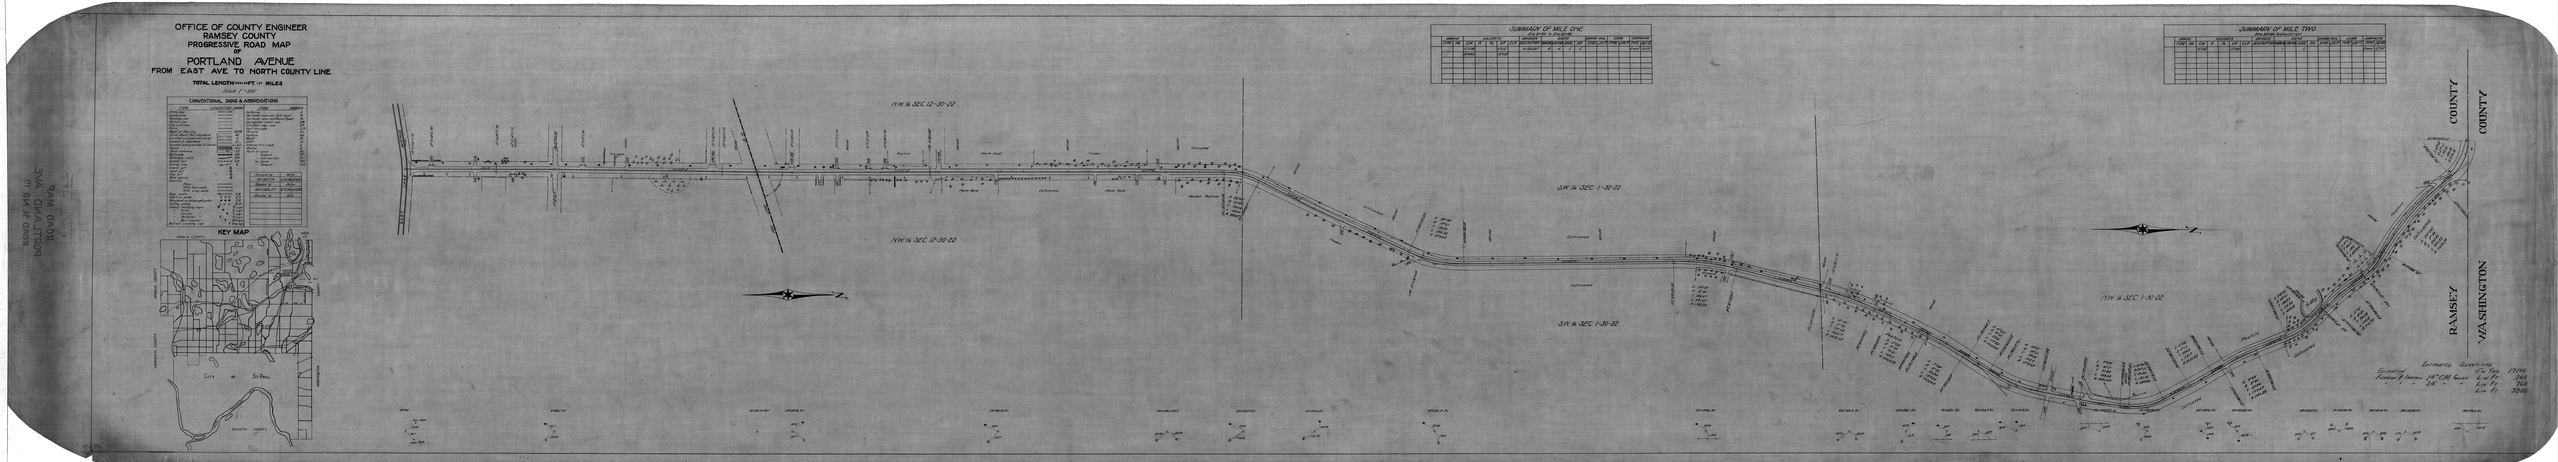
OFFICE OF COUNTY ENGINEER
RAMSEY COUNTY
PROGRESSIVE ROAD MAP
OF
PORTLAND AVENUE
FROM EAST AVE. TO NORTH COUNTY LINE
TOTAL LENGTH 4.4 MILES
CONVENTIONAL SIGNS & ABBREVIATIONS
KEY MAP
SUMMARY OF MILE ONE
SUMMARY OF MILE TWO
N.W. 1/4 SEC. 12-30-22
N.W. 1/4 SEC. 19-30-22
S.W. 1/4 SEC. 1-30-22
N.W. 1/4 SEC. 1-30-22
RAMSEY COUNTY
WASHINGTON COUNTY
ESTIMATES QUANTITIES