


CENTERVILLE ROAD

Surveyed By JOHN B. IRVINE County Surveyor
MARCH 13, 1902

Scale 50 feet pr. inch

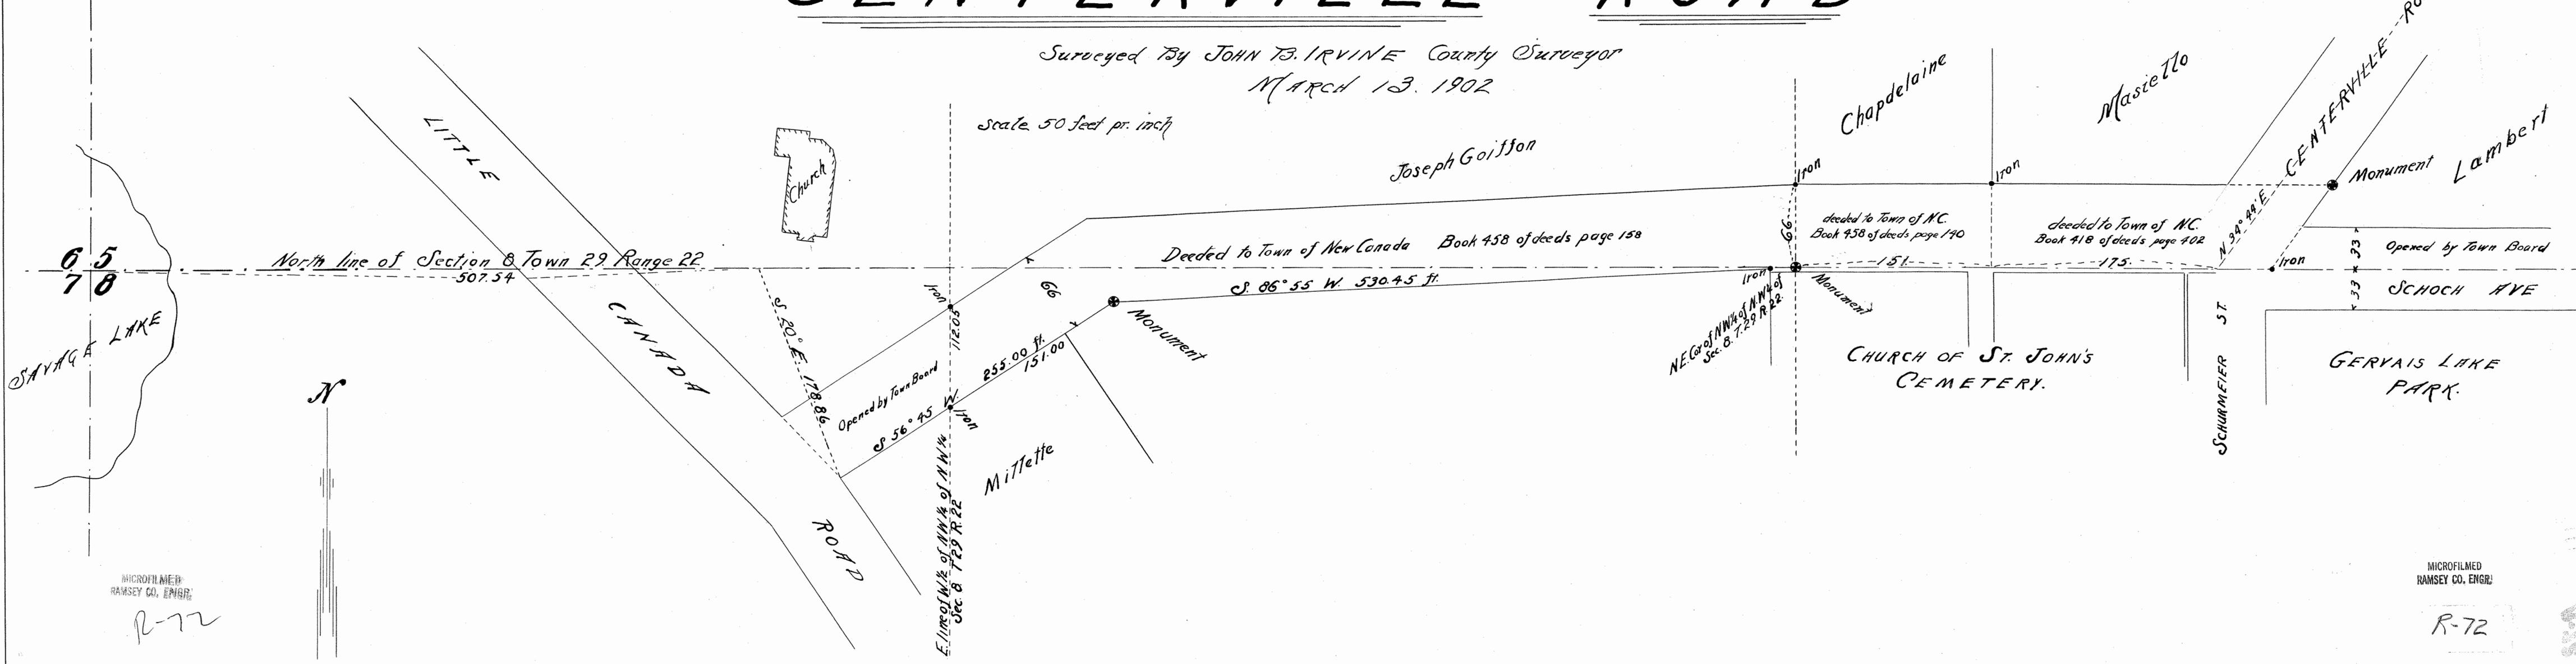

MICROFILMED
RAMSEY CO. ENGR.

R-72

MICROFILMED
RAMSEY CO. ENGR.

R-72