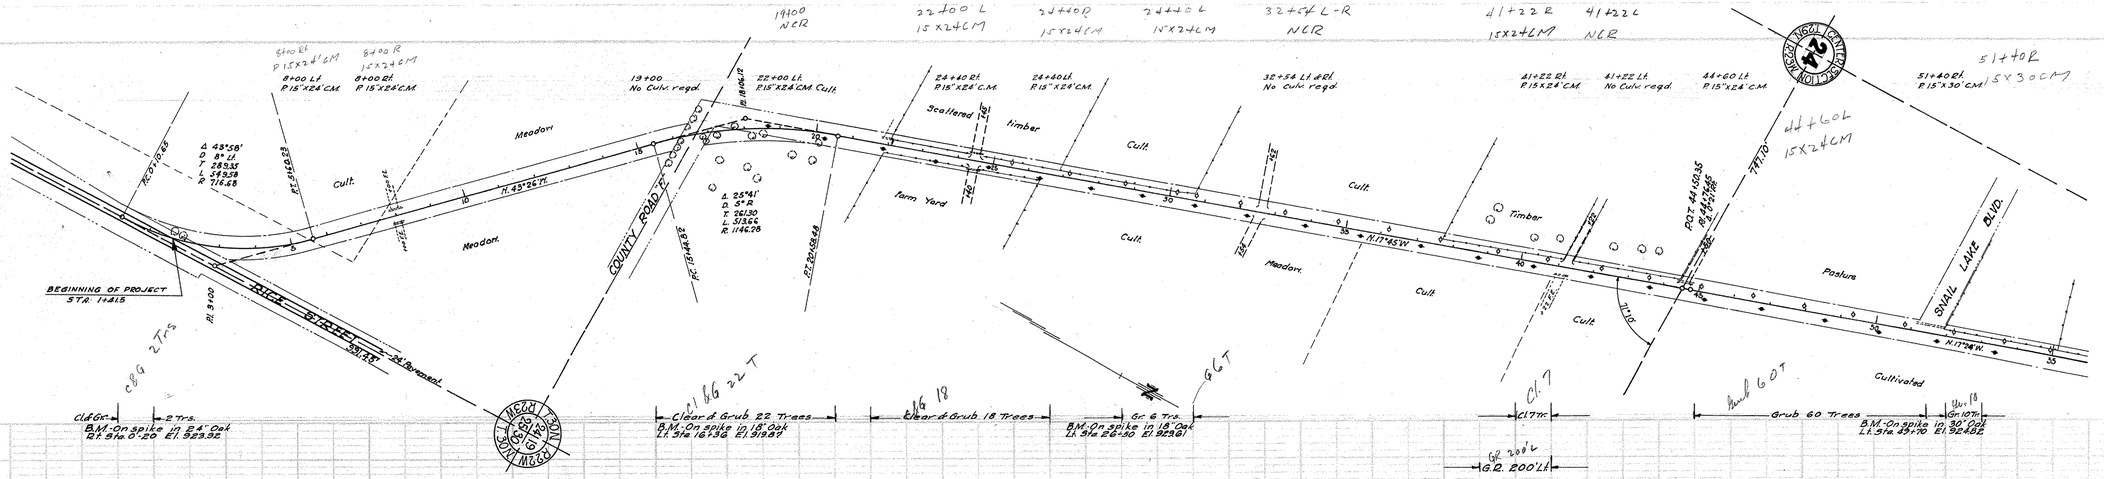
BEGINNING OF PROJECT STA. 14+81.5
RICE STREET
COUNTY ROAD D
SNAIL LAKE BLVD.
Meadow
Cult.
Farm Yard
Timber
Pasture
Cultivated
Scattered Timber
Cl. & Gr. 2 Trs.
Clear & Grub 22 Trees
Clear & Grub 18 Trees
Gr. 6 Trs.
Cl. 7 Trees
Grub 60 Trees
Gr. 10 Trees
G.R. 200' Lt.
B.M.-On spike in 24" Oak 12' Sta. 0+20 El. 923.32
B.M.-On spike in 18" Oak Lt. Sta. 16+30 El. 919.87
B.M.-On spike in 18" Oak Lt. Sta. 26+90 El. 922.61
B.M.-On spike in 30" Oak Lt. Sta. 49+70 El. 924.52
N. 17°24' W.
N. 17°45' W.
N. 21°48' W.
N. 41°14' W.
Δ 45°58'
D 8° 1'
T 289.35
L 549.58
R 716.68
Δ 25°41'
Δ 3° R
T 260.80
L 512.66
R 1146.28
63°45'
71°28'
71°55'
8+00 Rt. R 15"x24' CM
8+00 Lt. R 15"x24" CM
8+00 R 15"x24" CM
13+00 No Culv. regd.
22+00 Lt. R 15"x24" CM. Cult.
24+40 Rt. R 15"x24" C.M.
24+40 Lt. R 15"x24" C.M.
32+54 Lt. & Rt. No Culv. regd.
41+22 Rt. R 15"x24" C.M.
41+22 Lt. No Culv. regd.
44+60 Lt. R 15"x24" C.M.
51+40 Rt. R 15"x30" CM
19400 N.C.R.
32+54 L-R N.C.R.
41+22 R 15"x24" CM
41+22 L N.C.R.
44+60 L 15"x24" CM
51+40 R 15"x30" CM
NCR
Rt. 3100
