
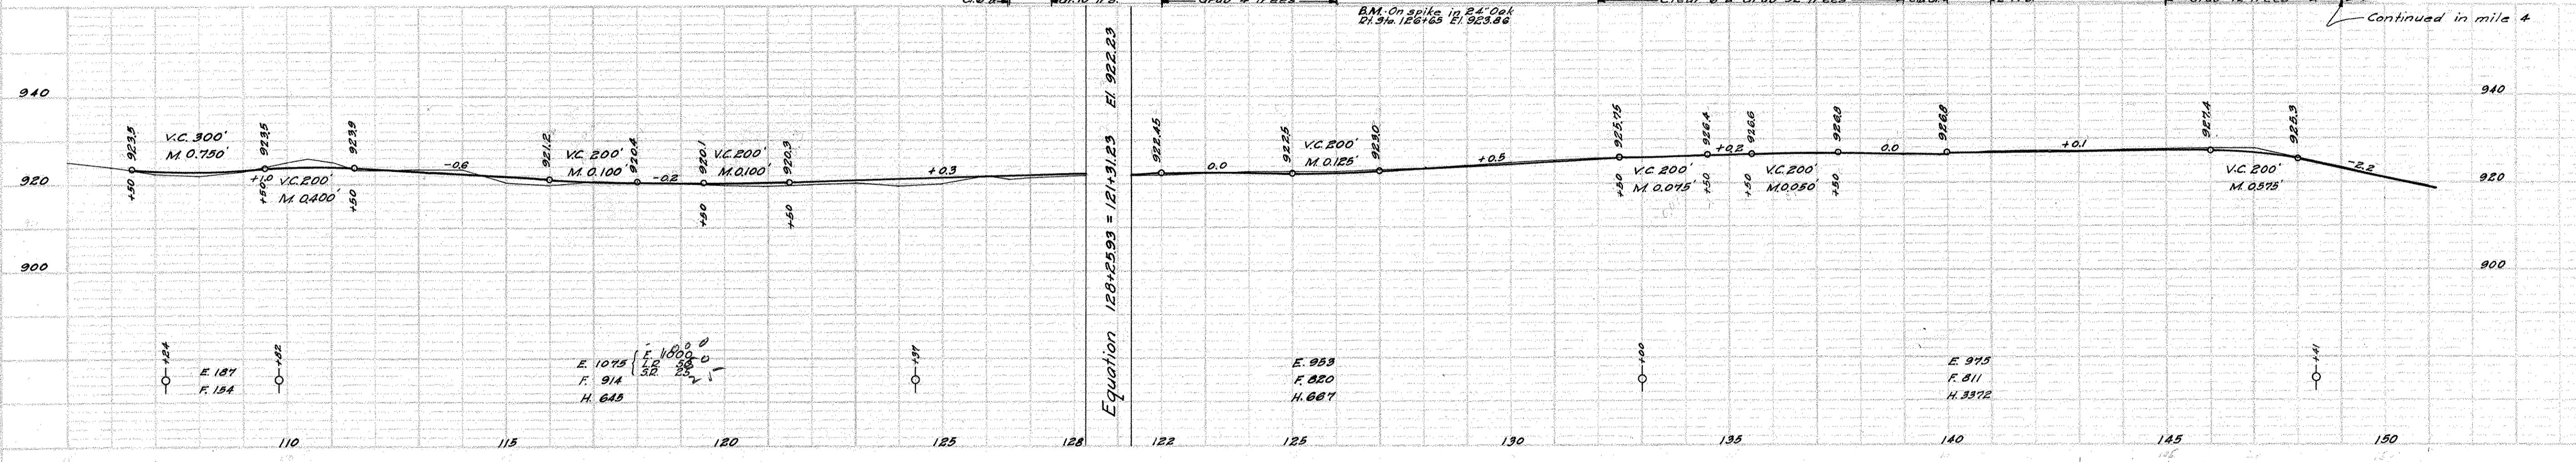






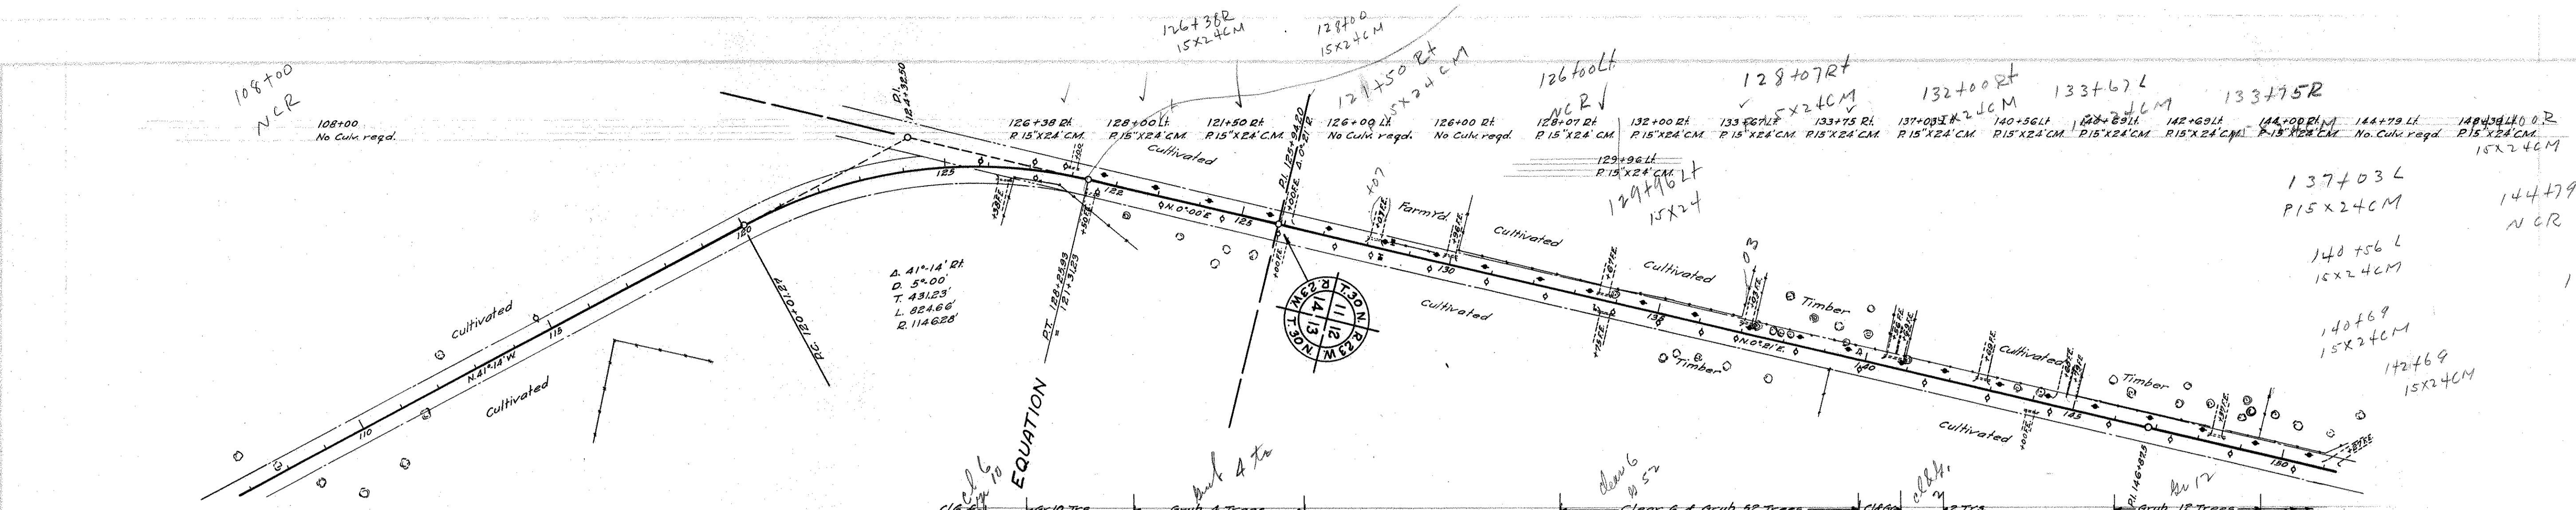

**MILE THREE**  
 ESTIMATED QUANTITIES  
 STA 108+00 TO STA 148+00

Clearing Trees	18
Grubbing	80
Exc. Earth Cu Yds	30125
L.R.	50
S.R.	25
O.H.	14850
Install 15' CM Lin.Ft	3350

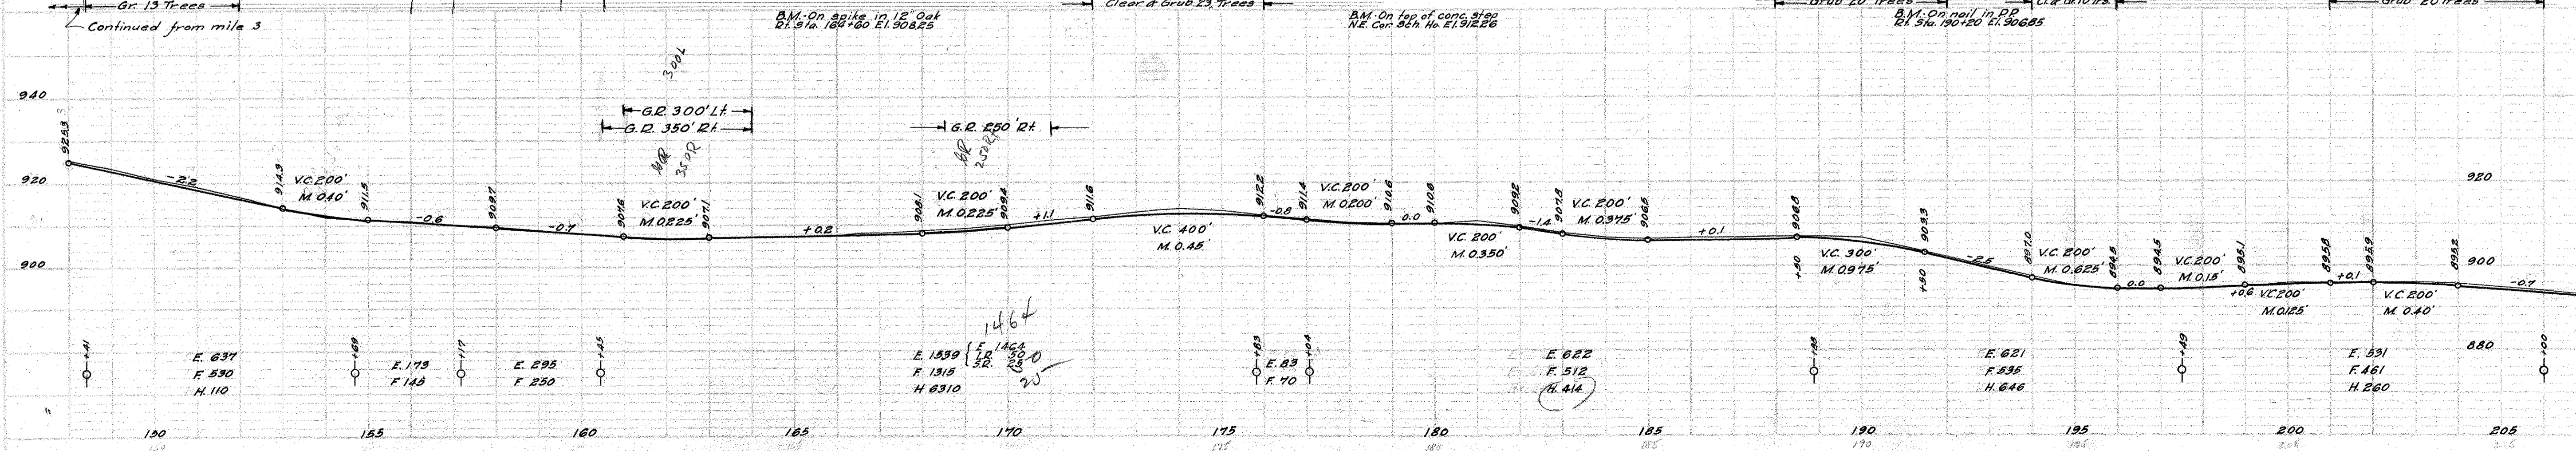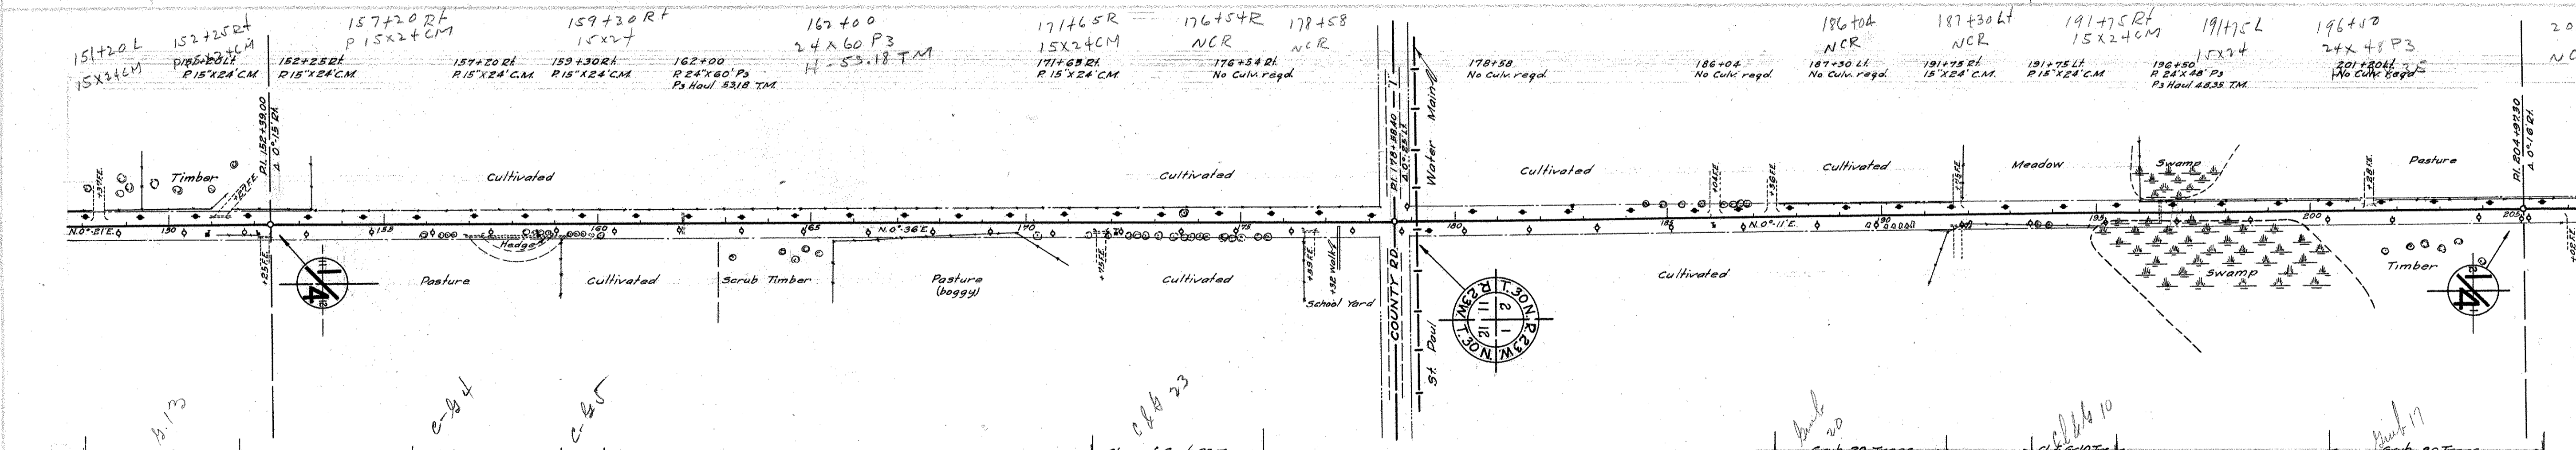

**MILE FOUR**  
 ESTIMATED QUANTITIES  
 STA 148+00 TO STA 206+00

Clearing Trees	48
Grubbing	75
Exc. Earth Cu Yds	4420
L.R.	50
S.R.	25
O.H.	7740
Install 15' CM Lin.Ft	1880
24' Ps	1880
Ps Culvert/Haul T.M.	10153
Guard Rail Cable Lin.Ft	2900
Anchors Each	6

RECORDED  
 RAMSEY CO. MINN.