
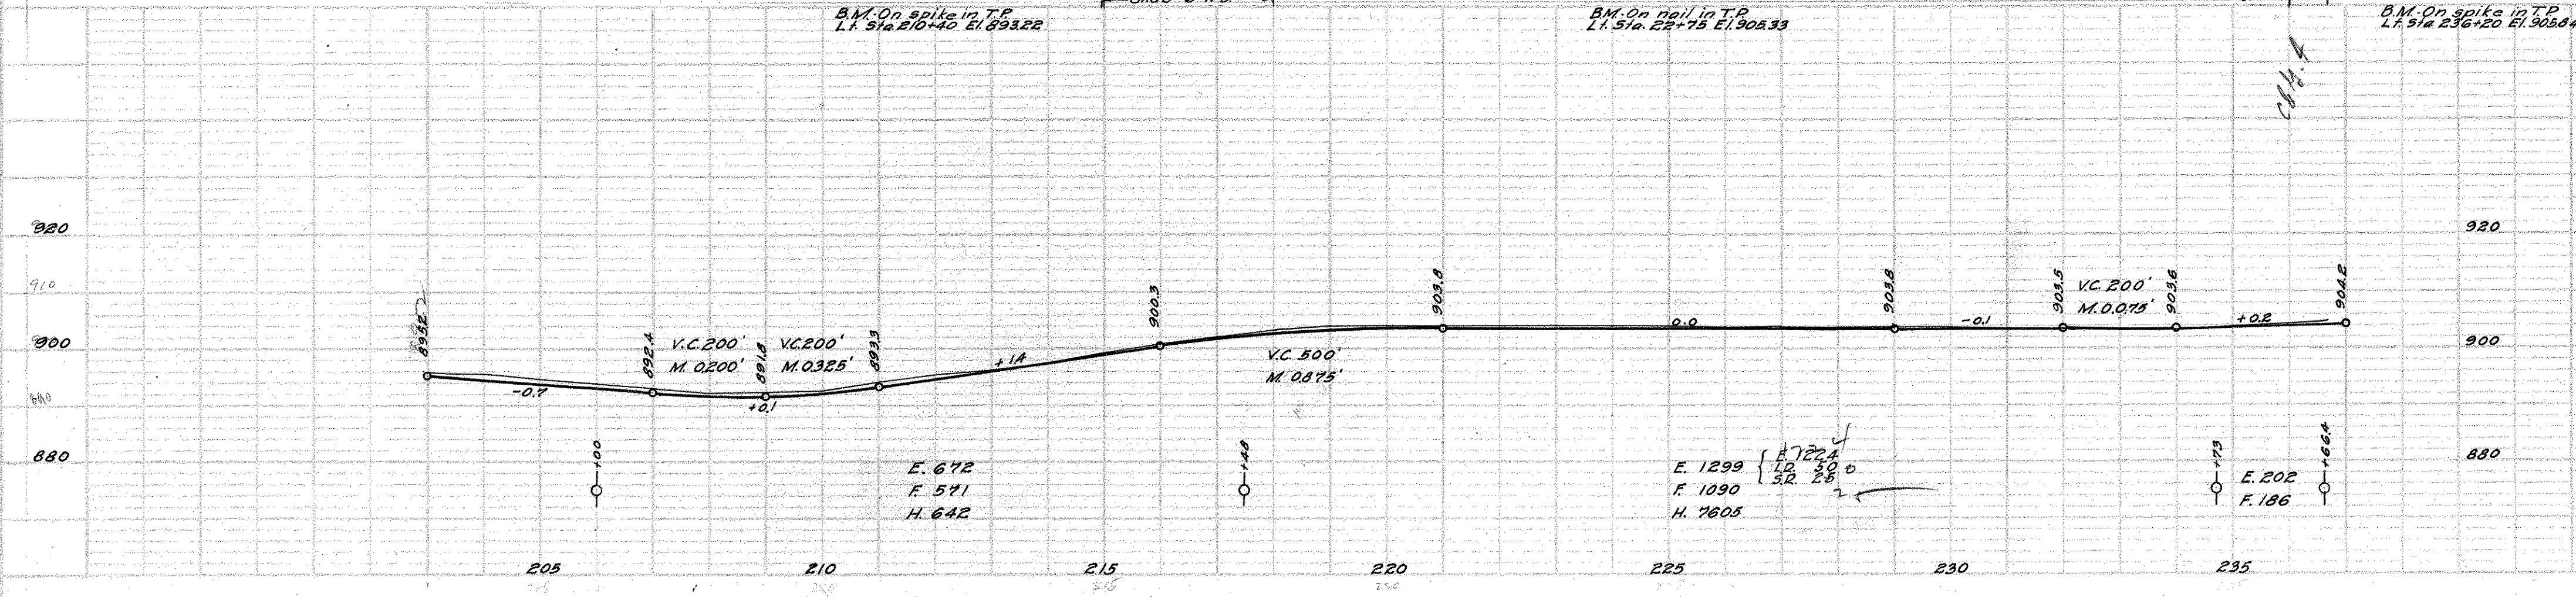


PLAN APPROVED  
 DATE  
 PLATTER  
 NOTE BOOK  
 CHECKED  
 REVISIONS

PROFILE APPROVED  
 DATE  
 PLATTER  
 NOTE BOOK  
 CHECKED  
 REVISIONS

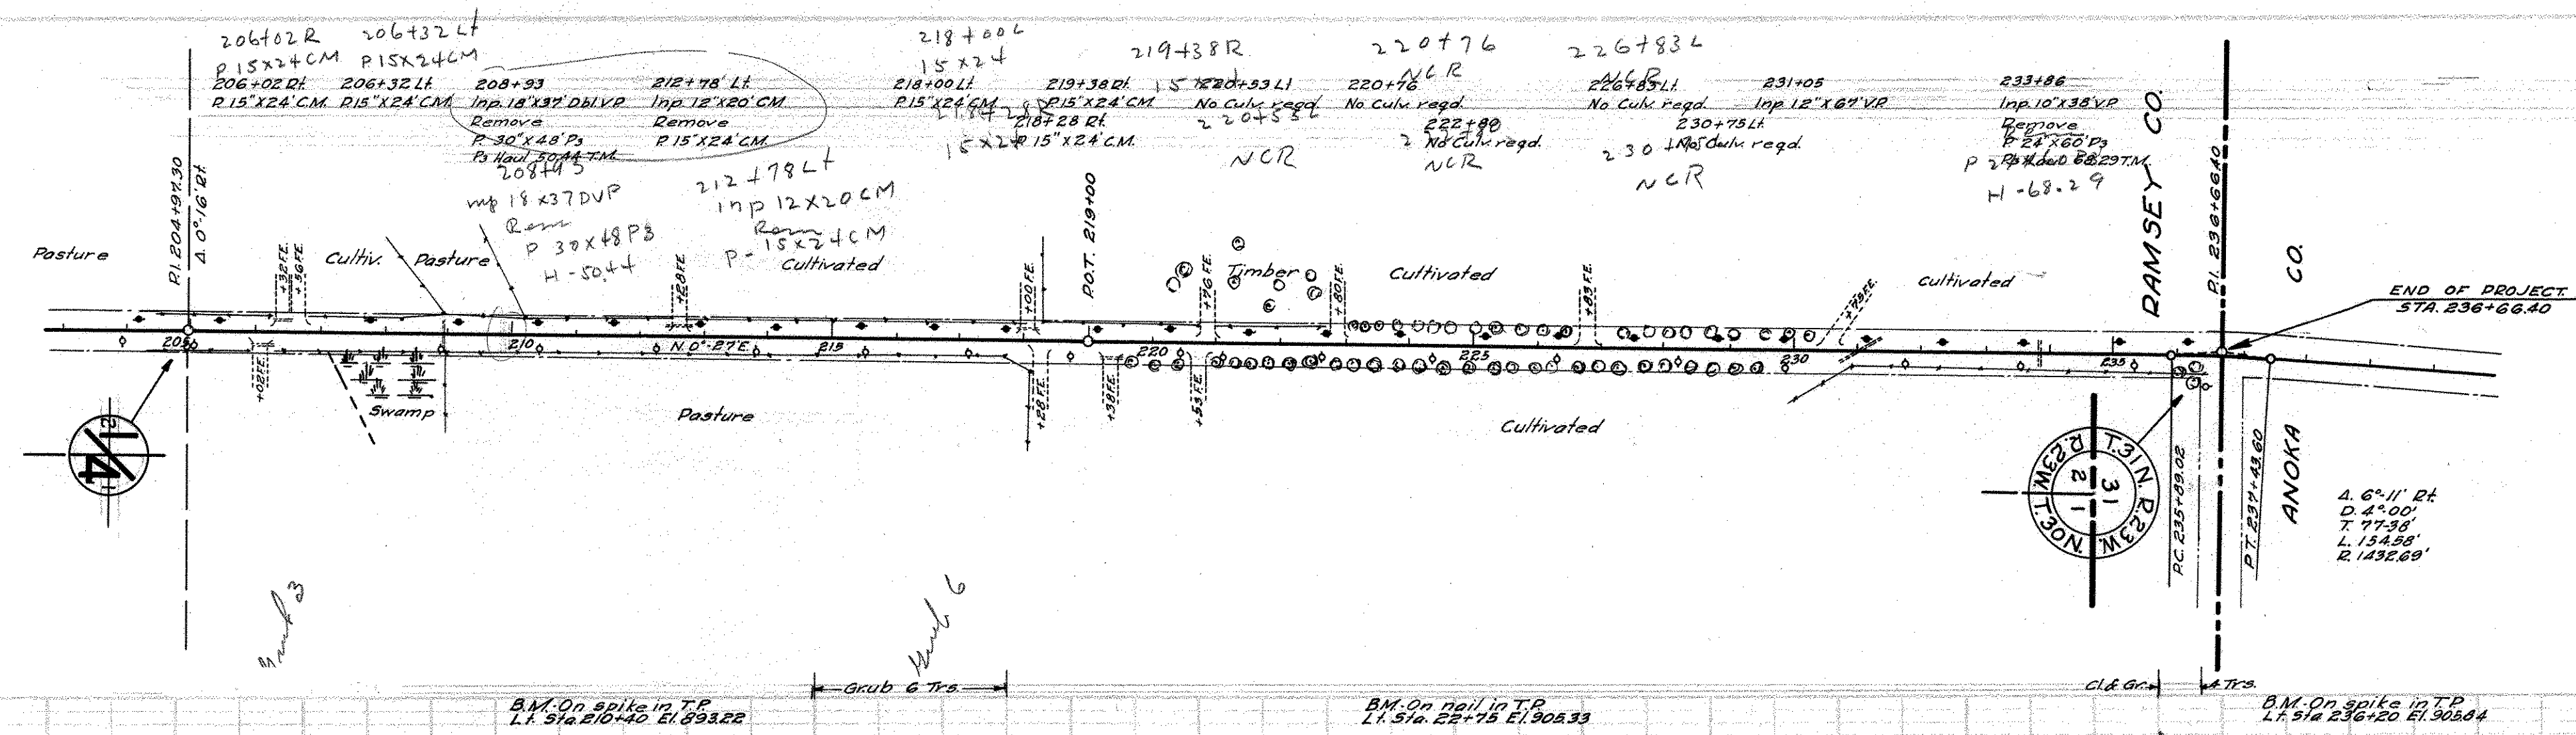

**MILE FIVE**  
 ESTIMATED QUANTITIES  
 STA 206+00 TO STA 236+66.40

Clearing	Trees	4
Grubbing	"	10
Exc. Earth	Cu Yds	2098
- LR	"	50
- SR	"	28
- OH	"	8247
Install 15" CM Lin. FA		144
- 28" Ps		600
- 30" Ps		488
P3 Culvert Haul TM		114.03
Remove old Culvert Lin. FA		132.2

UNAPPROVED  
 RAMSEY CO. ENGR.