OFFICE OF COUNTY ENGINEER
RAMSEY COUNTY
PROGRESSIVE ROAD MAP
OF
BIRCH LAKE BLVD. S.

FROM CENTERVILLE ROAD TO BIRCH LAKE BLVD.N.

TOTAL LENGTH 8126.4 FT. 1.54 MILES

SCALE 1"= 100'

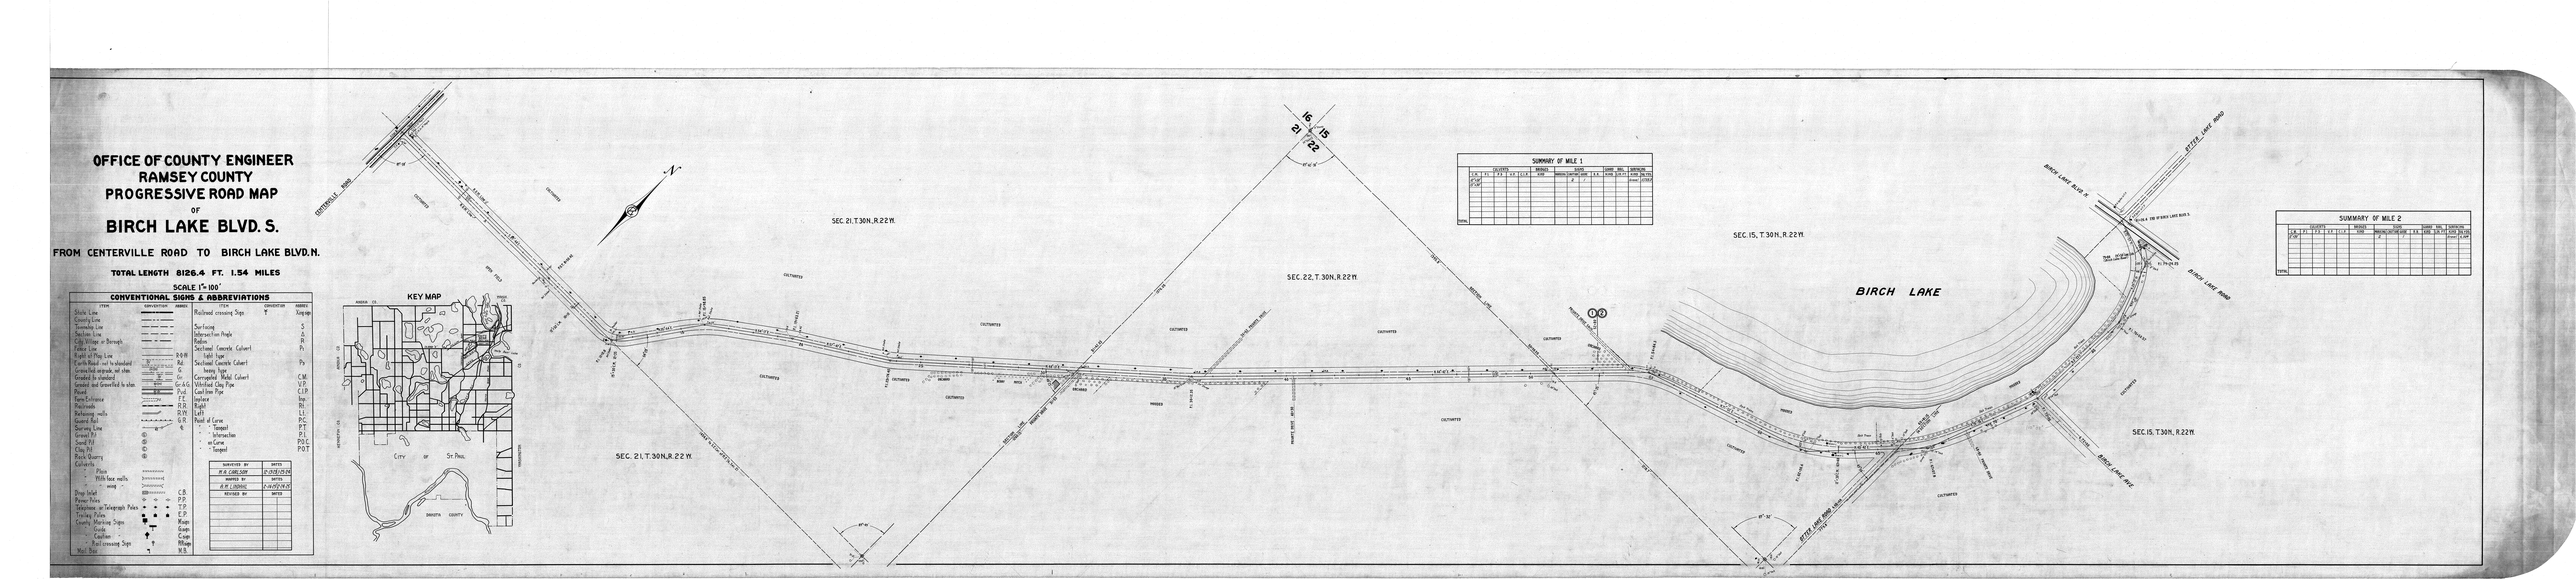
CENTERVILLE ROAD
SEC. 21, T.30N., R.22W.
SEC. 22, T.30N., R.22W.
SEC. 15, T.30N., R.22W.
SEC. 21, T.30N., R.22W.
BIRCH LAKE
BIRCH LAKE BLVD. S.
BIRCH LAKE ROAD
BIRCH LAKE AVE.
CULVERTED
WOODED
