OFFICE OF COUNTY ENGINEER
RAMSEY COUNTY
PROGRESSIVE ROAD MAP
OF

STILLWATER STREET

FROM OTTER LAKE RD TO DIVISION STREET

TOTAL LENGTH 5280 FT. 1.0 MILES

Scale 1 in. = 100 ft.

CONVENTIONAL SIGNS & ABBREVIATIONS

ITEM	CONVENTION	ABBREV.
State Line		
County Line		
Township Line		
Section Line		
Quarter Line		
City or Village Limit		
Right of Way Line		
Center Line Highway		
Center Line Railroad		
Graded to Standard		
Graded Not to Standard		
Paved		
Paved Concrete		
Paved Bituminous		
Gravel		
Earth		
Curbing, Low		
Curbing, High		
Walk, Low		
Walk, High		
Ditch		
Drain		
Culvert		
Bridge		
Fence		
Hedge		
Trees, Deciduous		
Trees, Coniferous		
Telephone or Telegraph Pole		
Electric Pole		
Electric Pole with Light		
Guy Wire		
Hydrant		
Mailbox		
Railroad Crossing Signal		

ITEM	ABBREV.
Bituminous Concrete	
Portland Concrete	
Portland Concrete Cem. Conc.	
Portland Concrete Asphalt Surface	
Bituminous Surface	
Bituminous Base	
Gravel Surface	
Gravel Base	
Concrete	
Curb	
Gutter	
Sidewalk	
Concrete Apron	
Bituminous Apron	
Gravel Apron	
Ditch	
Culvert	
Catch Basin	
Manhole	
Storm Sewer	
Sanitary Sewer	
Combination Sewer	
Water Main	
Gas Main	
Telephone Conduit	
Electric Conduit	

Surveyed by	Date
C.H. BISHOP	4-29-30
Plotted by	Date
ADDISON	4-29-30

KEY MAP

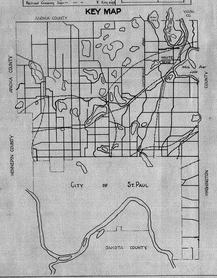

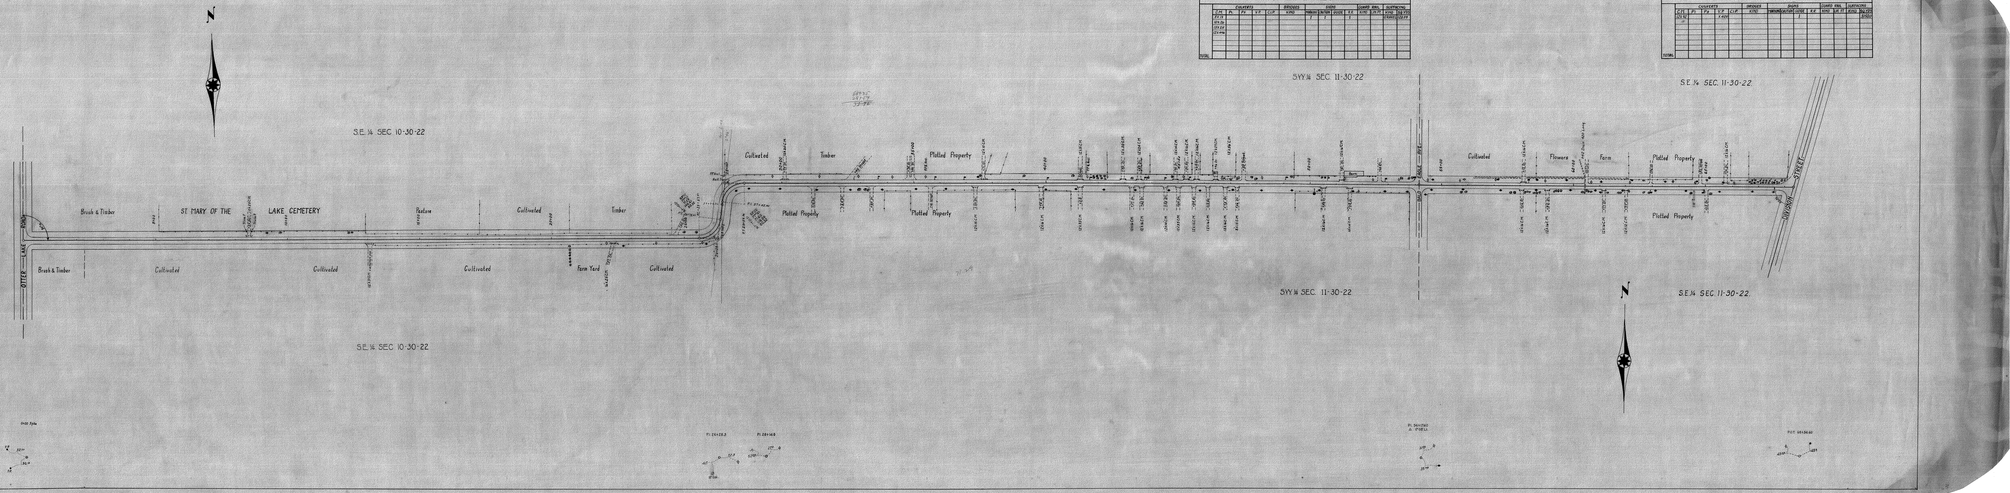

SUMMARY OF MILE 1




DAN GOST