Fed. Proj. No.

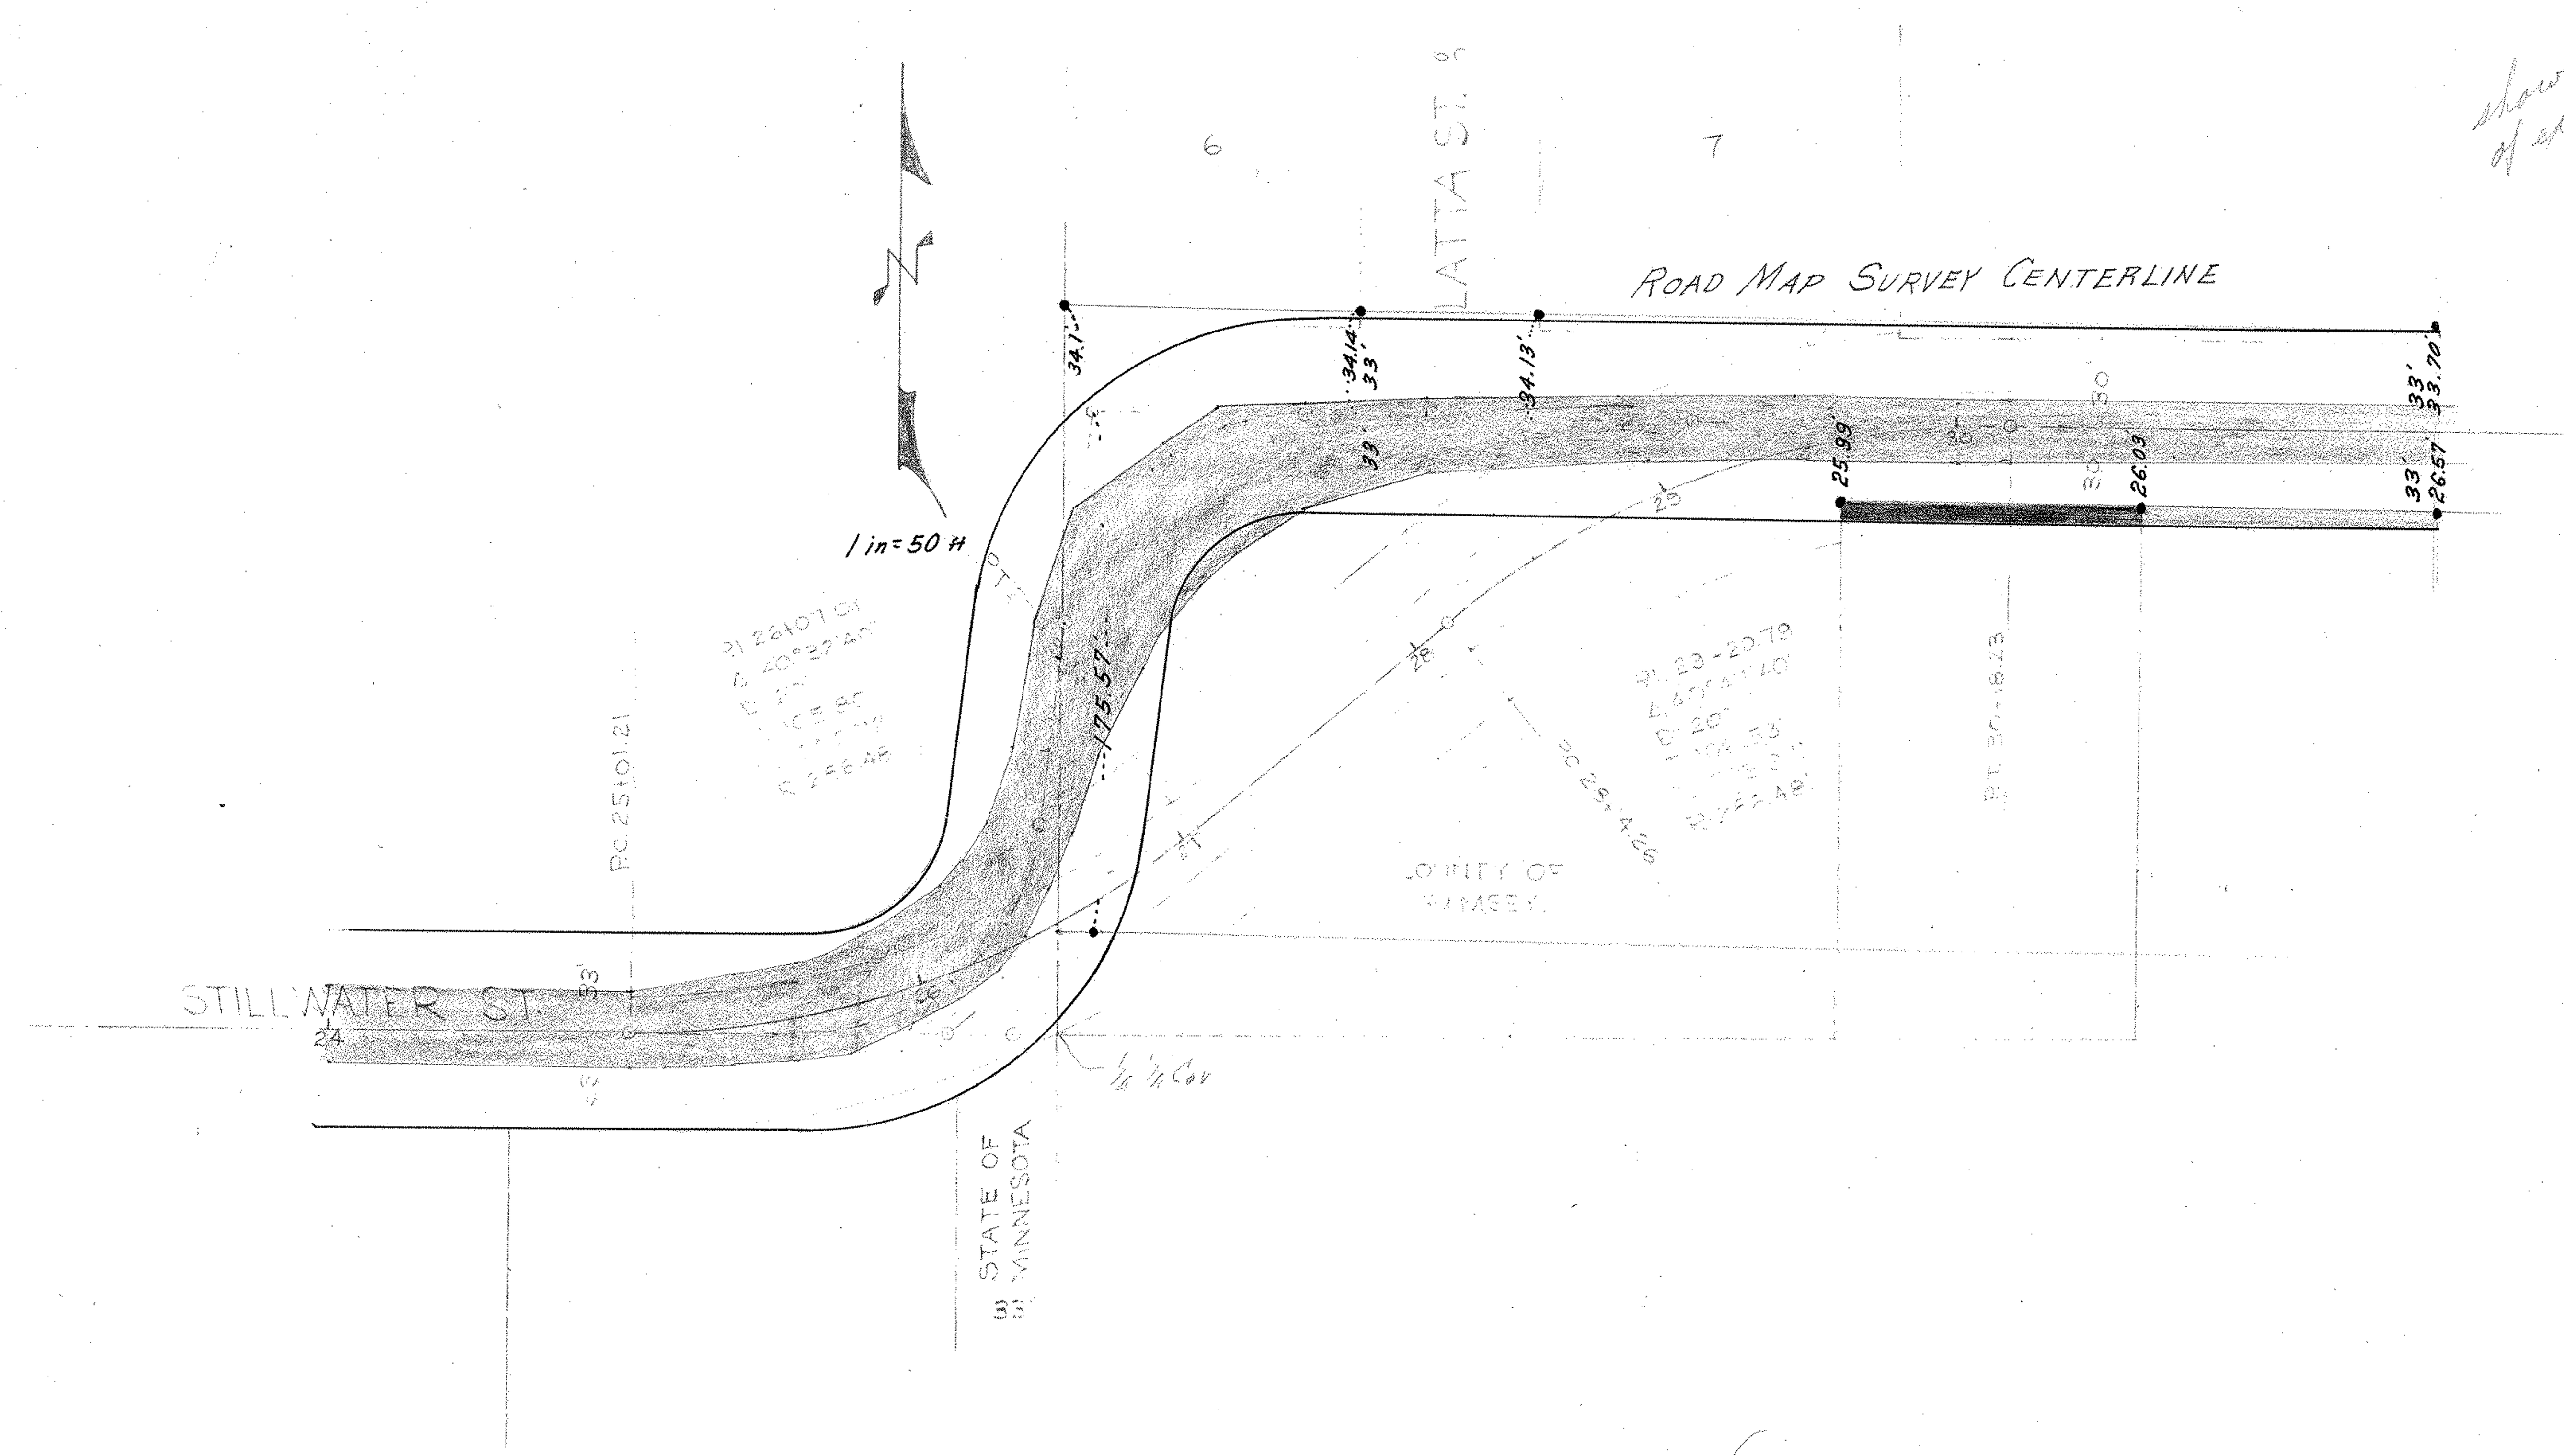

TYPICAL SECTION

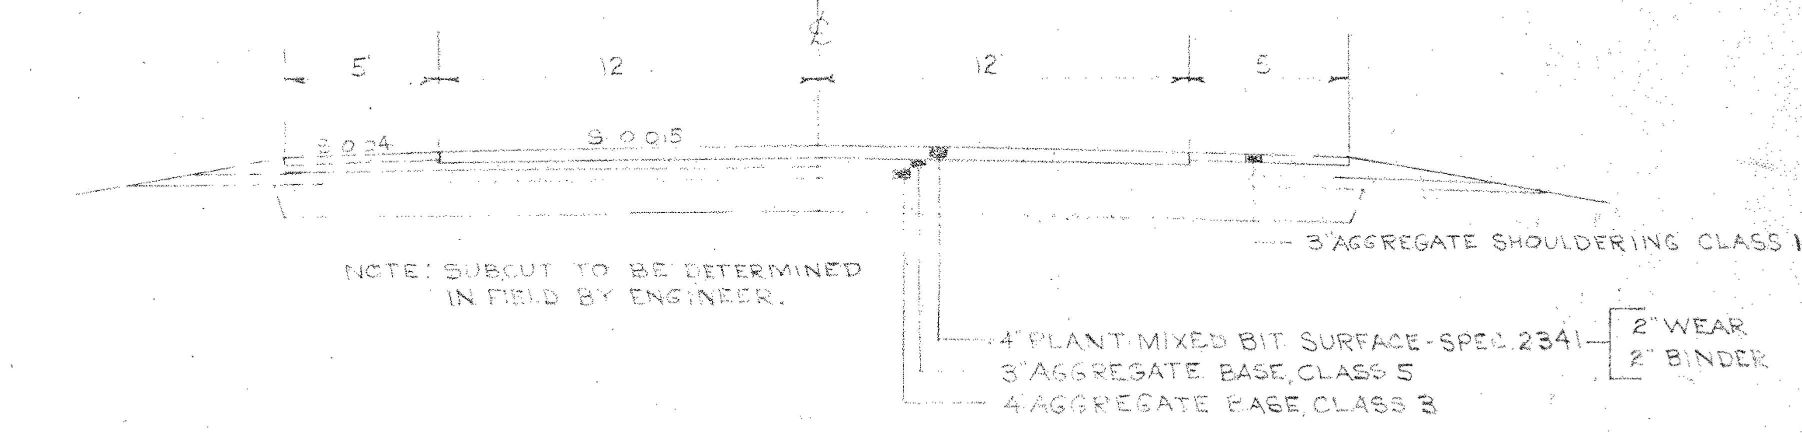

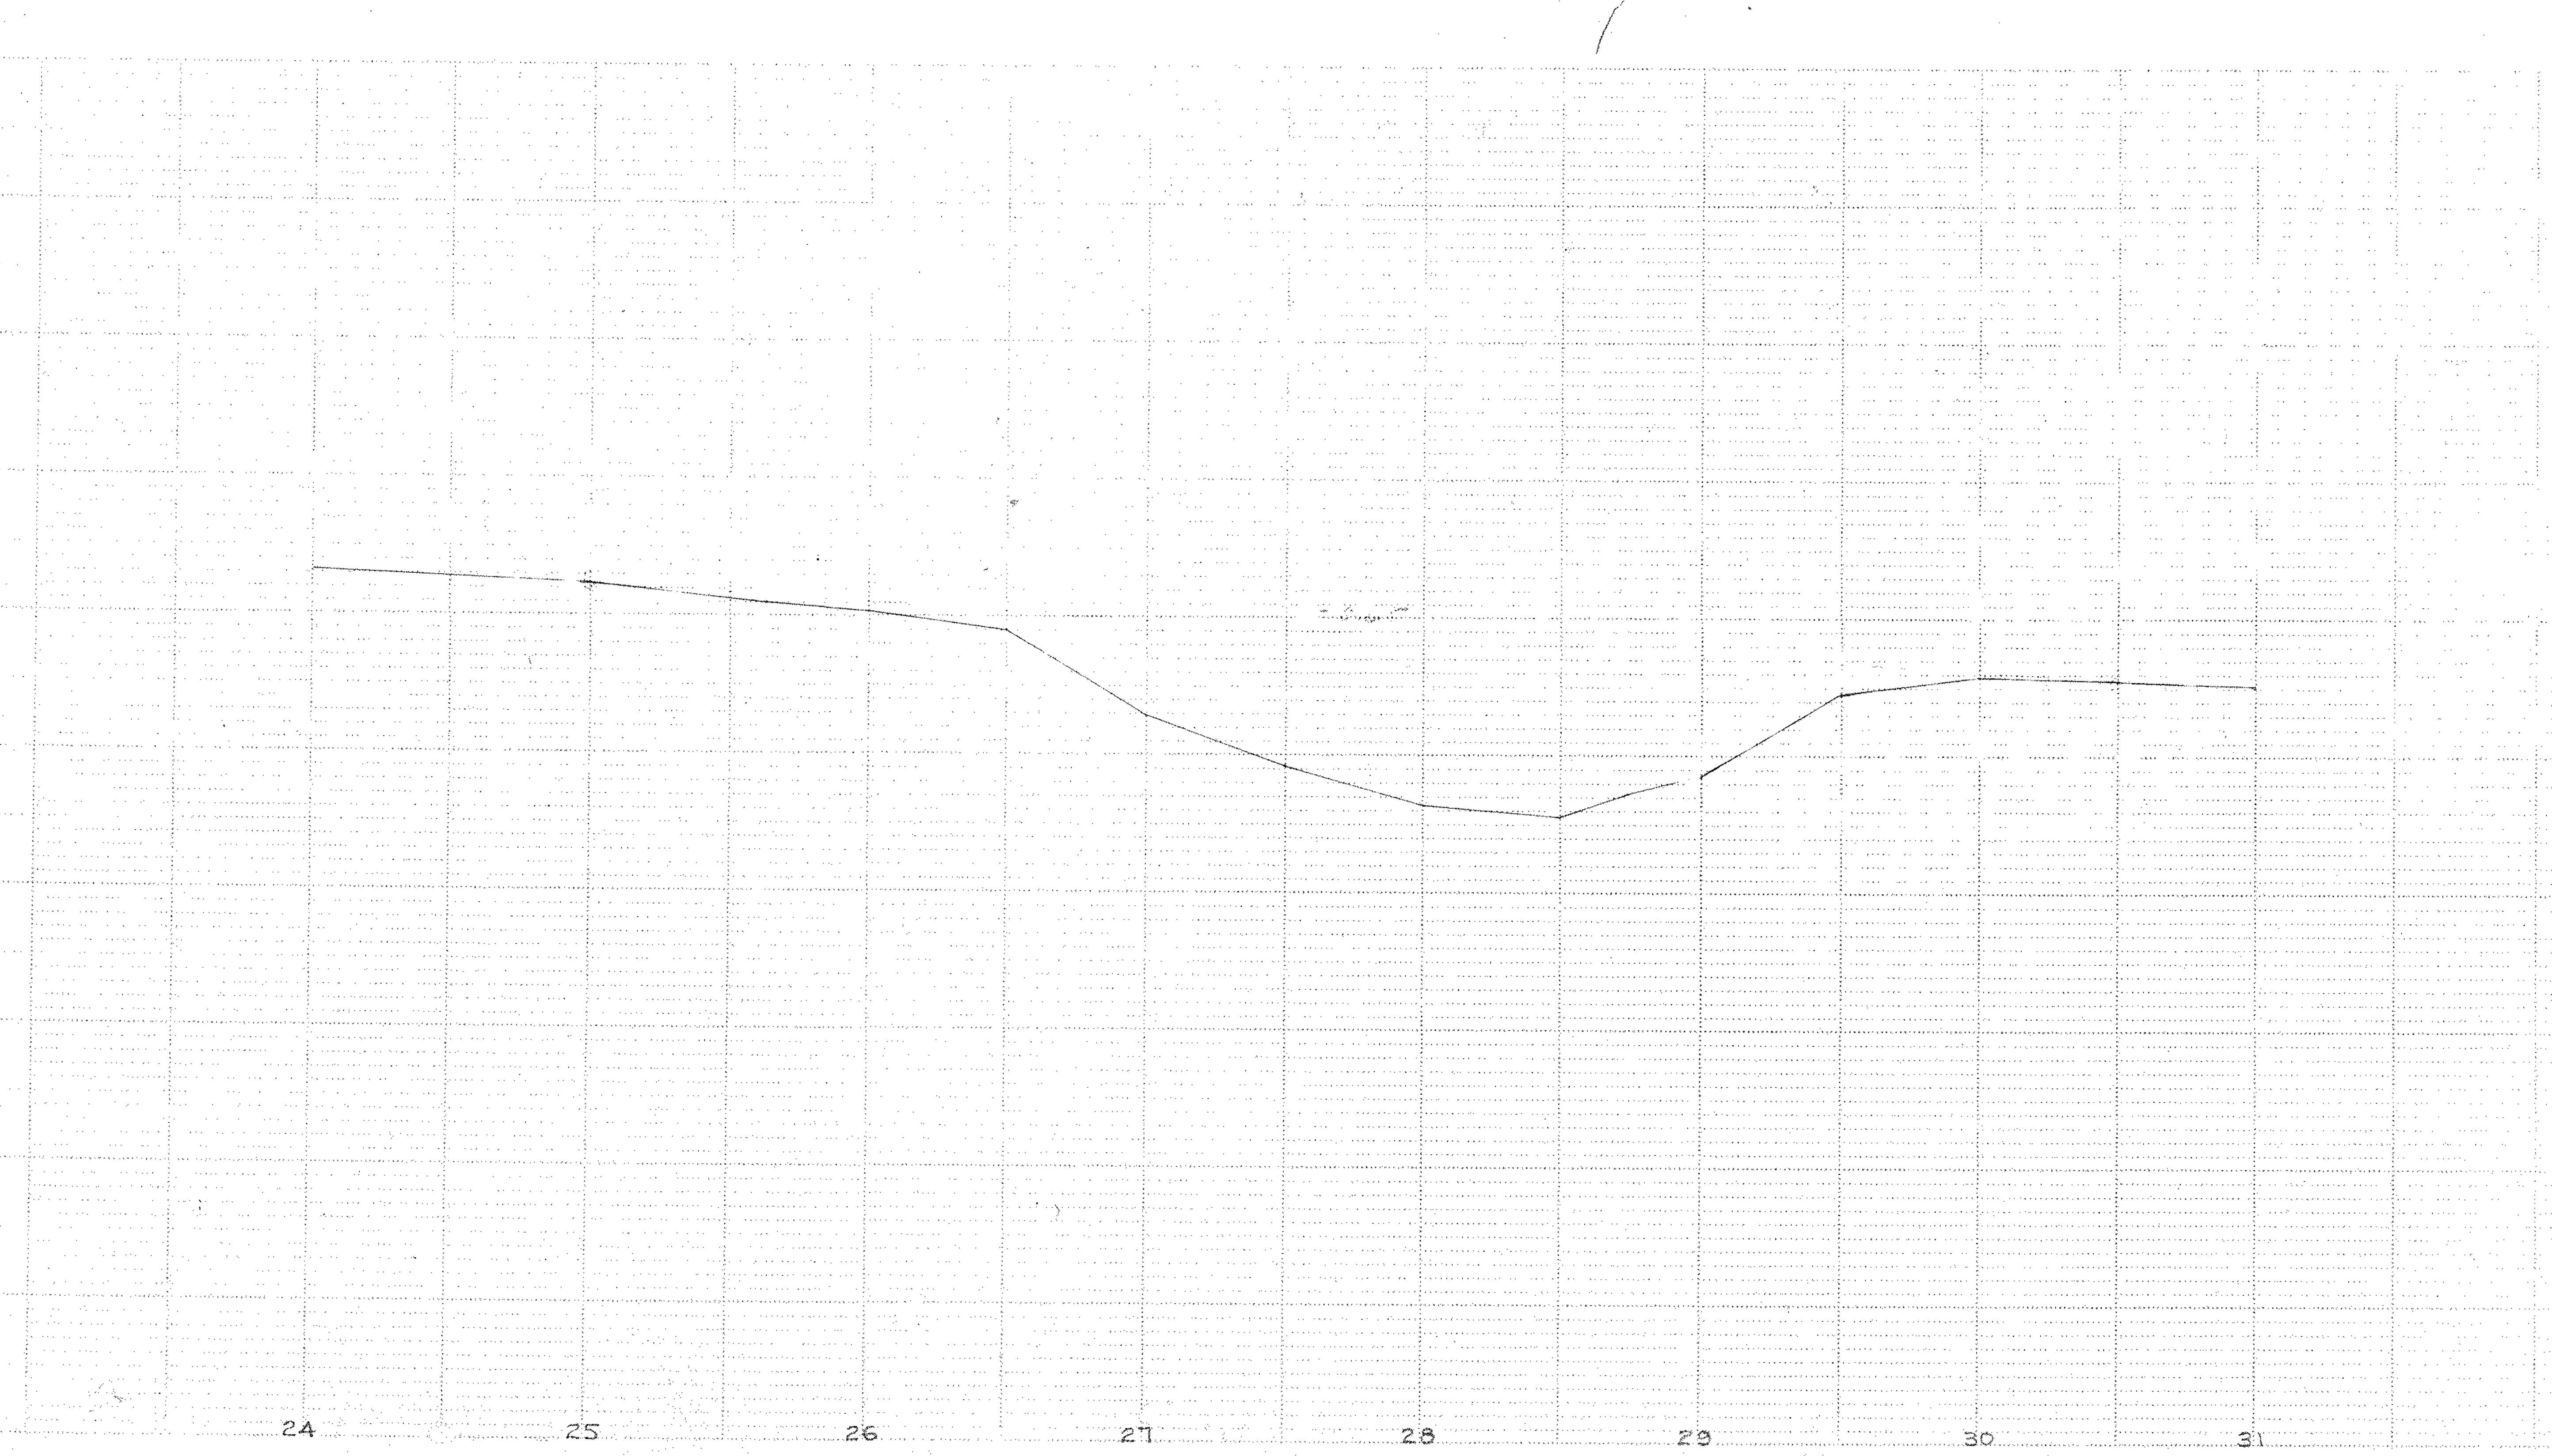

OFFICE OF
RAMSEY COUNTY ENGINEER
STILLWATER ST.

State Proj. No. Sheet No. of Sheets