OFFICE OF COUNTY ENGINEER
RAMSEY COUNTY
PROGRESSIVE ROAD MAP
OF
OWASSO BLVD. NO.
FROM VICTORIA STR. TO RICE ST.

TOTAL LENGTH 942.75 FT. 1.78 MILES

SCALE: 1" = 100'

CONVENTIONAL SIGNS & ABBREVIATIONS

ITEM	CONVENTION	ABBREV.
County Line		
Township Line		
Section Line		
City or Village		
Fence		
Right-of-Way Line		R.O.W.
Earth Road - not standard		Rd.
Graveled on Grade not standard		G.
Graded to Standard		Gr.
Graded & Graveled to Stand.		Gr. & G.
Bituminous Treated		Bit. Tr.
Paved		Pvd.
Farm Entrance	F.E.	F.E.
Railroads		R.R.
Retaining Walls		R.W.
Guard Rail		G.R.
Survey Line	45	℄
Gravel Pit	G	
Sand Pit	S	
Clay Pit	C	
Culverts		
" Plain		
" With Headwalls		
Manhole	M.H.	M.H.
Catch Basin		C.B.
Electric Poles		P.P.
Telephone or Telegraph Poles		T.P.
Trolley Poles		Tr.P.
Road Lamps		R.L.
County Marking Signs		M. sign
" Guide		G. sign
" Caution		C. sign
" Reflector		R. sign
" Rail Crossing		R.R. sign
Railroad - Crossing Sign		Xing sign

ITEM	ABBREV.
Surfacing	S
Sectional Conc. Culv. (light type)	P-1
Sectional Conc. Culv. (heavy type)	P-3
Corrugated Metal Culvert	C.M.
Vitrified Clay Pipe	V.P.
Cast Iron Pipe	C.I.P.
Private	Pri.
In place	Inp.
Right	Rt.
Left	Lt.
Intersection Angle	Δ
Radius	R.
Point of Curve	P.C.
" " Tangent	P.T.
" " Intersection	P.I.
" on Curve	P.O.C.
" " Tangent	P.O.T.

Surveyed by	Dates
O.R. VANKREVELEN	3-26
Mapped by	**Dates**
R.J. WOLFANGLE	1-32
Revised by	**Dates**
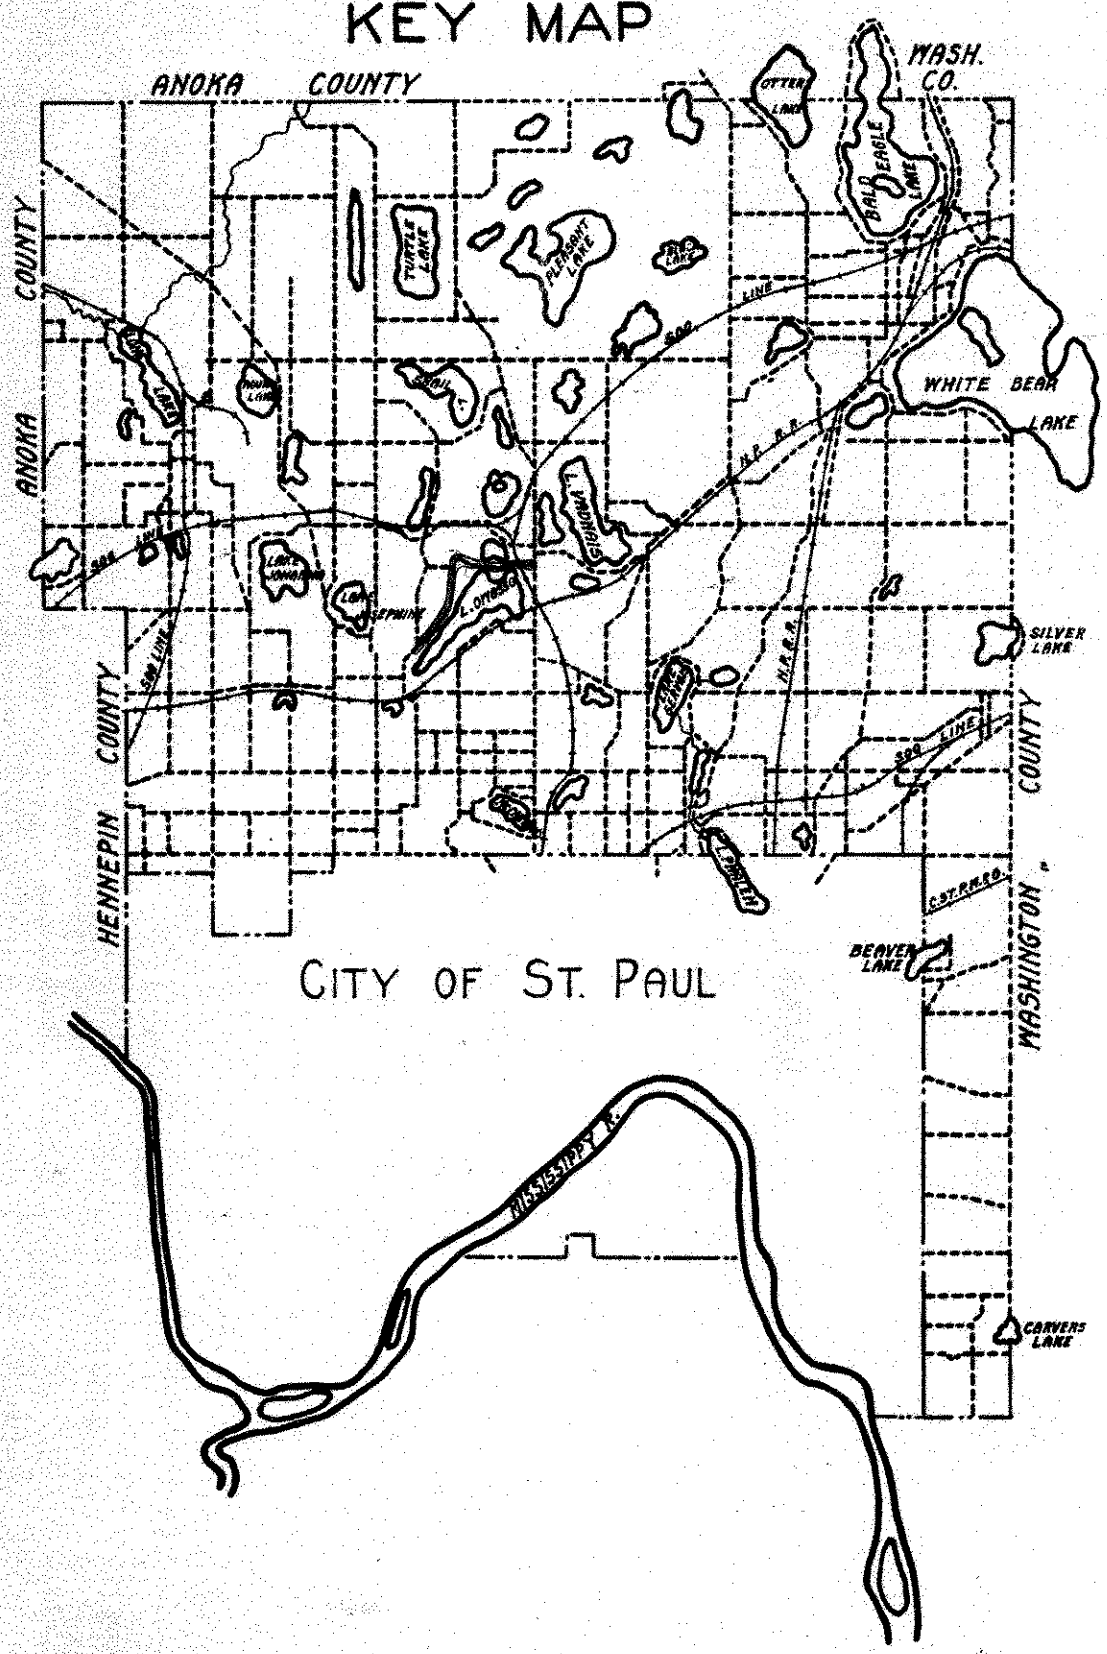
KEY MAP