OFFICE OF COUNTY ENGINEER
RAMSEY COUNTY
PROGRESSIVE ROAD MAP
OF
EUSTIS STREET
FROM Como Ave. TO Midland Golf Course

TOTAL LENGTH 492265 FT. 093 MILES
SCALE 1"=100'

CONVENTIONAL SIGNS & ABBREVIATIONS

ITEM	CONVENTION	ABBREV.
County Line		
Township Line		
City or Village		
Fence		
Right of Way Line		
Concrete Curb & Gutter		
Crushed Limestone Shoulder		
Graded & Drained		Gr. & D.
Bituminous Surface		Bit. Surf.
Bituminous Treated		
Pavement		Pvmt.
Curb Entrance		
Culvert		
Reference Marker		
Guard Rail		
Survey Line		
Gas Line		
City Pit		
County Pit		
Catch Basin		
Manhole		
Hydrant		
Water Gate		
Power Pole		
Electric Pole		
Telephone or Telegraph Poles		
Sidewalk		
County Marking Signs		
Grade		
Curve		
Railroad		
Railroad - Crossing Sign		

ITEM	ABBREV.
Surfacing	Surf.
Sectional Conc. Culv. (Tight Joint)	S.C.C.
Sectional Conc. Culv. (Flexible Joint)	S.C.C.
Corrugated Metal Culvert	C.M.C.
Clay Drain Tile	C.D.T.
Cast Iron Pipe	C.I.P.
Private	Pvt.
Telephone	Tel.
Telegraph	Tel.
Left	Lt.
Intersection Angle	I.
Radius	R.
Point of Curve	P.C.
Point of Intersection	P.I.
Point of Curve	P.C.
Tangent	Tan.

Surveyed by	Dates
P.J. CRANE	8-26
Mapped by	Dates
M.W. CARLEY	1-31
Revised by	Dates
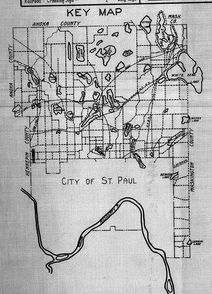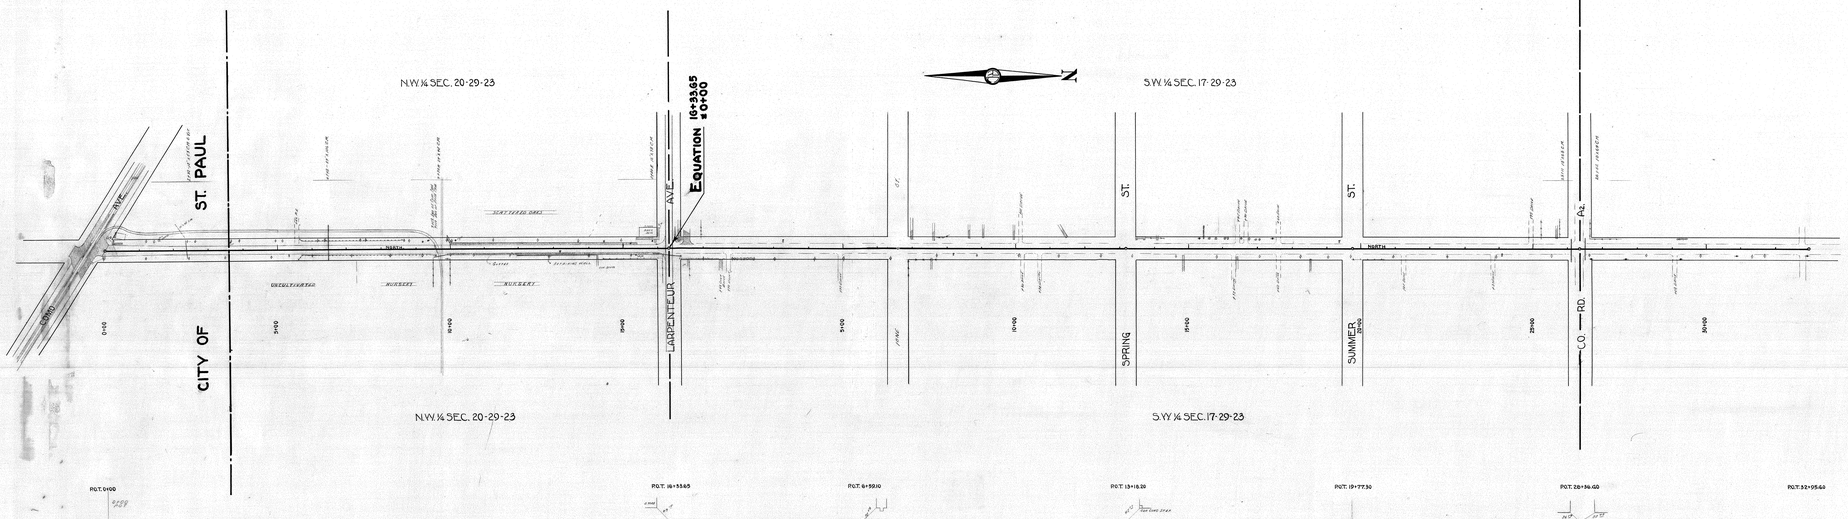
KEY MAP