OFFICE OF COUNTY ENGINEER
RAMSEY COUNTY
PROGRESSIVE ROAD MAP
OF
COUNTY ROAD B2.
FROM EDGERTON ST. TO ARCADE ST.

TOTAL LENGTH 2643.7 FT. 0.5 MILES

Scale 1 in. = 100 ft.

CONVENTIONAL SIGNS & ABBREVIATIONS

ITEM	CONVENTION	ABBREV.
State Line		
County Line		
Township Line		
Section Line		
City or Village		
Fence		
Right-of-way Line		R-O-W
Earth Road - not standard		Rd.
Graveled on Grade not stand.		G
Graded to Standard		Gr.
Graded & Graveled to stand.		Gr. & G
Paved		Pvd.
Farm Entrance		F.E.
Railroads		R.R.
Retaining walls		R.W.
Guard Rail		G.R.
Survey Line		
Gravel Pit		
Sand Pit		
Clay Pit		
Rock Quarry		
Culverts		
Plain		
With face walls		
With wing walls		
Drop Inlets		C.B.
Electric Poles		E.P.
Telephone or Telegraph Poles		T.P.
Trolley Poles		Tr.P.
County Marking Signs		M. sign
" Guide		G. sign
" Caution		C. sign
" Reflector		R. sign
" Rail Crossing		RR sign
Railroad Crossing Signs		Xing sign

ITEM	ABBREV.
Surfacing	S
Sectional Conc. Culv. (light type)	Pz.
Sectional Conc. Culv. (heavy type)	Pz.
Corrugated Metal Culvert	C.M.
Vitrified Clay Pipe	V.P.
Cast Iron Pipe	C.I.P.
Private	Pri.
Inplace	Inp.
Right	Rt.
Left	Lt.
Intersection Angle	Δ
Radius	R
Point of Curve	P.C.
" " Tangent	P.T.
" " Intersection	P.I.
" on Curve	P.O.C.
" " Tangent	P.O.T.

Surveyed by	Dates
H. L. Wilshusen	1-6-27 / 1-7-27
Mapped by	**Dates**
A. O. Wilson	5-25-27 / 6-4-27
Revised by	**Date**

KEY MAP

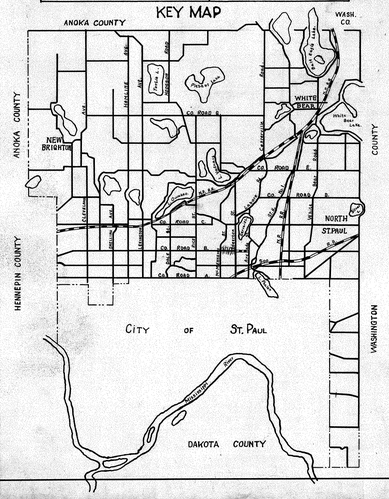

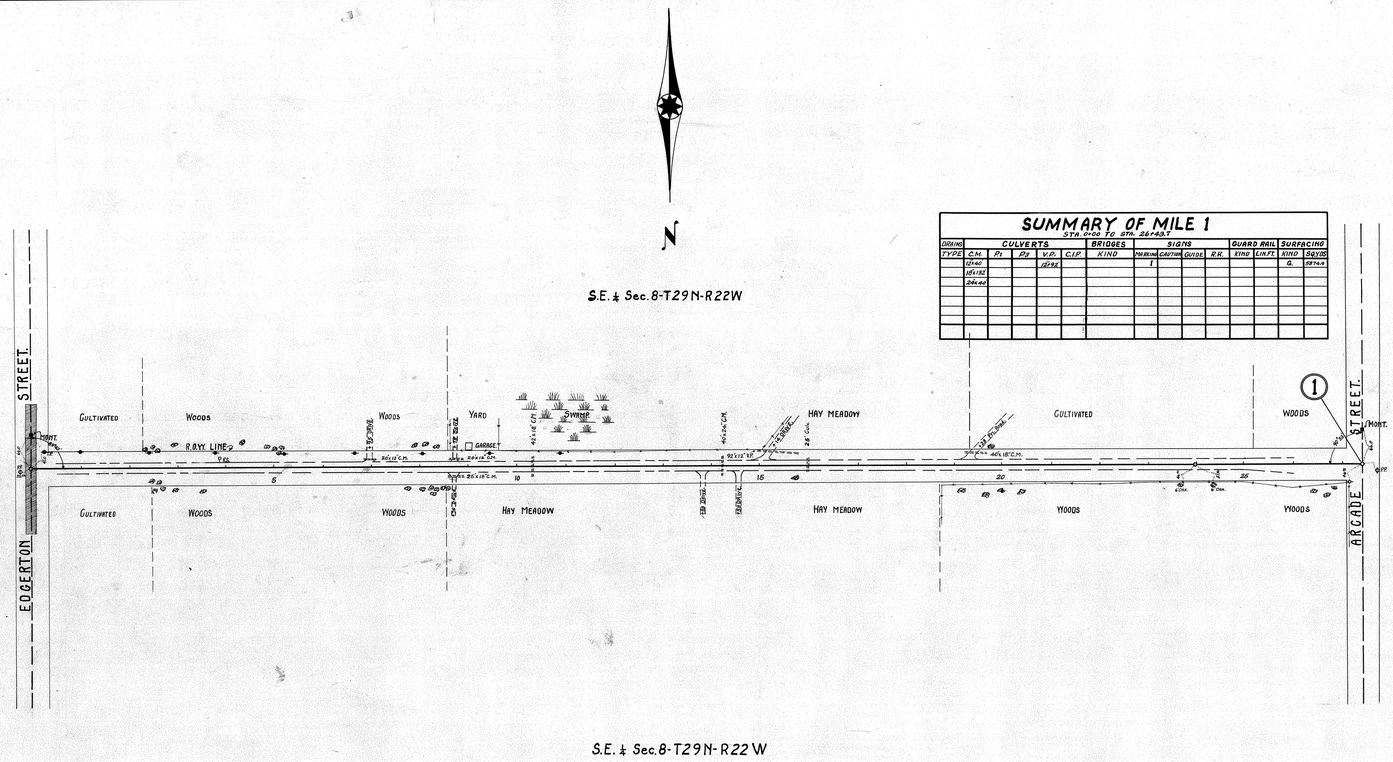

SUMMARY OF MILE 1
STA. 0+00 TO STA. 26+43.7

DRAINS	CULVERTS					BRIDGES	SIGNS				GUARD RAIL		SURFACING	
TYPE	C.M.	Pz	Pz	V.P.	C.I.P.	KIND	MARKING	CAUTION	GUIDE	R.R.	KIND	LIN. FT.	KIND	SQ. YDS.
	12+40			12+42			1						G.	53+49
	15+12													
	24+40													