MINNEHAHA ST.

PRINT ALL

SUMMARY

0+00.00 to 52+57.68
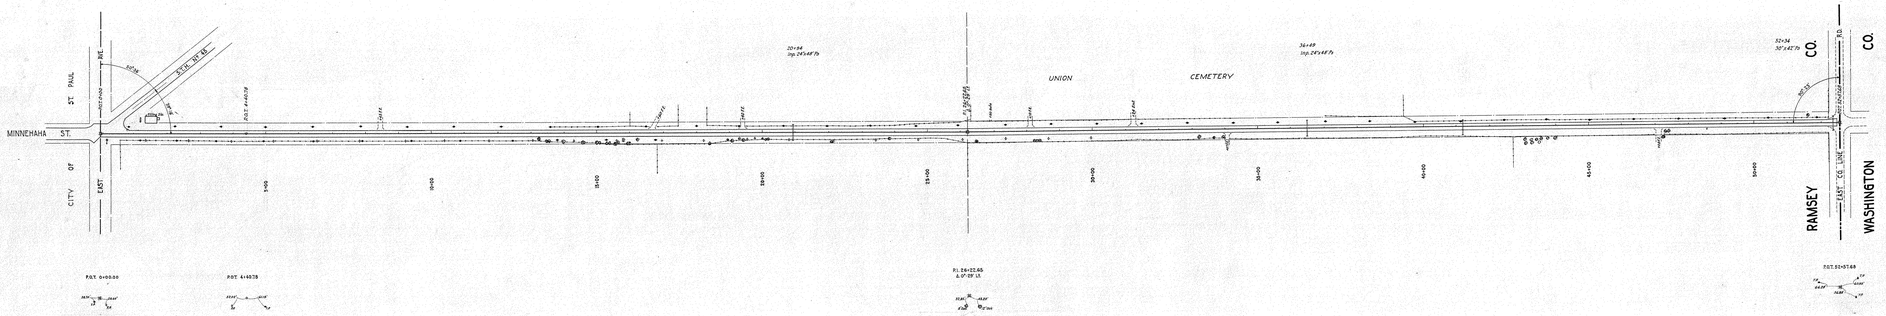
DRAINS		CULVERTS						BRIDGES	SIGNS							GUARD RAIL		CURB		SURFACING	
TYPE	NO.	DIA.	C.M.	Pi	Pb	V.P	C.I.P	DESCRIPTION	MARKING	CAUTION	GUIDE	REFLECTOR	R.R.	R.R.SIGN		TYPE	LIN.FT.	TYPE	LIN.FT.	TYPE	SQ.YDS.
		24"			96'																
		30"			42'