OFFICE OF COUNTY ENGINEER
RAMSEY COUNTY
PROGRESSIVE ROAD MAP
OF
LOWER AFTON ROAD

FROM ST. PAUL CITY LIMITS **TO** EAST COUNTY LINE

TOTAL LENGTH 54848 FT. 1.189 MILES

Scale 1 in = 100 ft.

CONVENTIONAL SIGNS & ABBREVIATIONS

ITEM	CONVENTION	ABBRV	ITEM	ABBRV
State Line			Surfacing	
County Line			Surfaced (Give City Type)	Sf
Section Line			Gravel (Give City Type)	Gr
Settlers Line			Completely Milled Culvert	C.M
City or Village			Corrugated Metal Culvert	C.M
Road			Unsurfaced Road	U.R
Road of Any Type		D.O.T.	Unsurfaced Trail	U.T
Earth Road (not Graded)		Grd	Pavement	Pvt
Graded & Drained		Gr.D	Shoulder	Sh
Graded & Gravelled (or Macad.)		Gr.G	Left	L
Graded & Surfaced (or Macad.)		Gr.S	Right	R
Trail		Tr	Intersection Angle	I
Park, Cemetery		P.C	Radius	R
Bridge		Br	Point of Curve	P.C
Railroad		R.R	Tangent	Tan
Power Line		P.L	Long Chord	L.C
Survey Line		S	Point of Tangent	P.T
Building		Bldg	Survey	SVY
Culvert				
Line Fill				
Property Boundary				
Fence				
Pipe				
Rock, Stone, Riprap				
Power Substation		P.S		
Telephone, Telegraph Poles		T.P		
Telephone Booth		T.B		
Culvert Marking Types	Concrete	C.M		
	Corrugated Metal	C.M		
	Timber	T.M		
	Stone	S.M		
	Reinforced Concrete	R.C.M		

Surveyed by	Date
R.E. AUSTIN	7/1961
Measured by	
M.H. OAKLEY	6/1964
Revised by	Date

KEY MAP

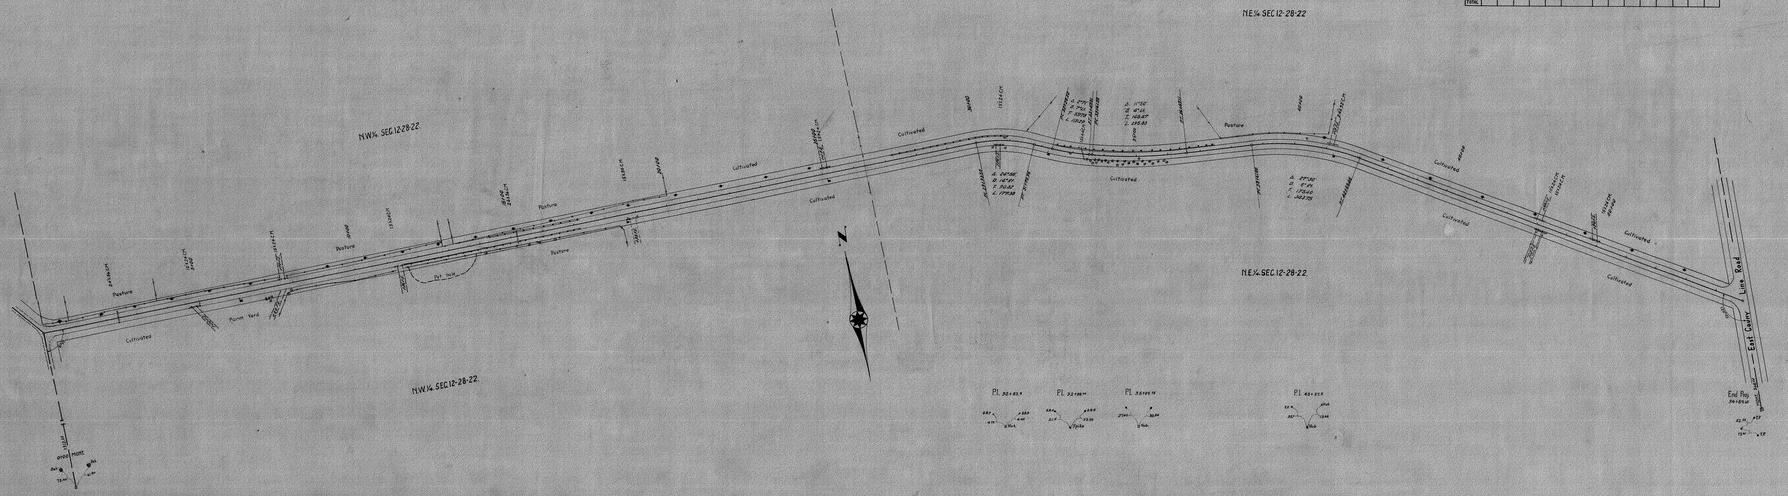

SUMMARY OF MILE 1

	CULVERTS				BRIDGES		SIGNS			GUARD RAIL		SURFACING
	C.M.	P.I.	P.S.	V.P.	C.I.P.	KIND	TYPE	NUMBER	SIZE	SIZE	KIND	LGH. FT.	KIND	SQ. YDS.
TOTAL														
FROM														
TO														
TOTAL														

SCRIBE RED 'N
POWERS YELLOW SD
WORK WHITE
PRINT ALL