


PROPOSED
ASST. CO. ENGR.

*Little Canada Rd.
Alignment
according to plan!*

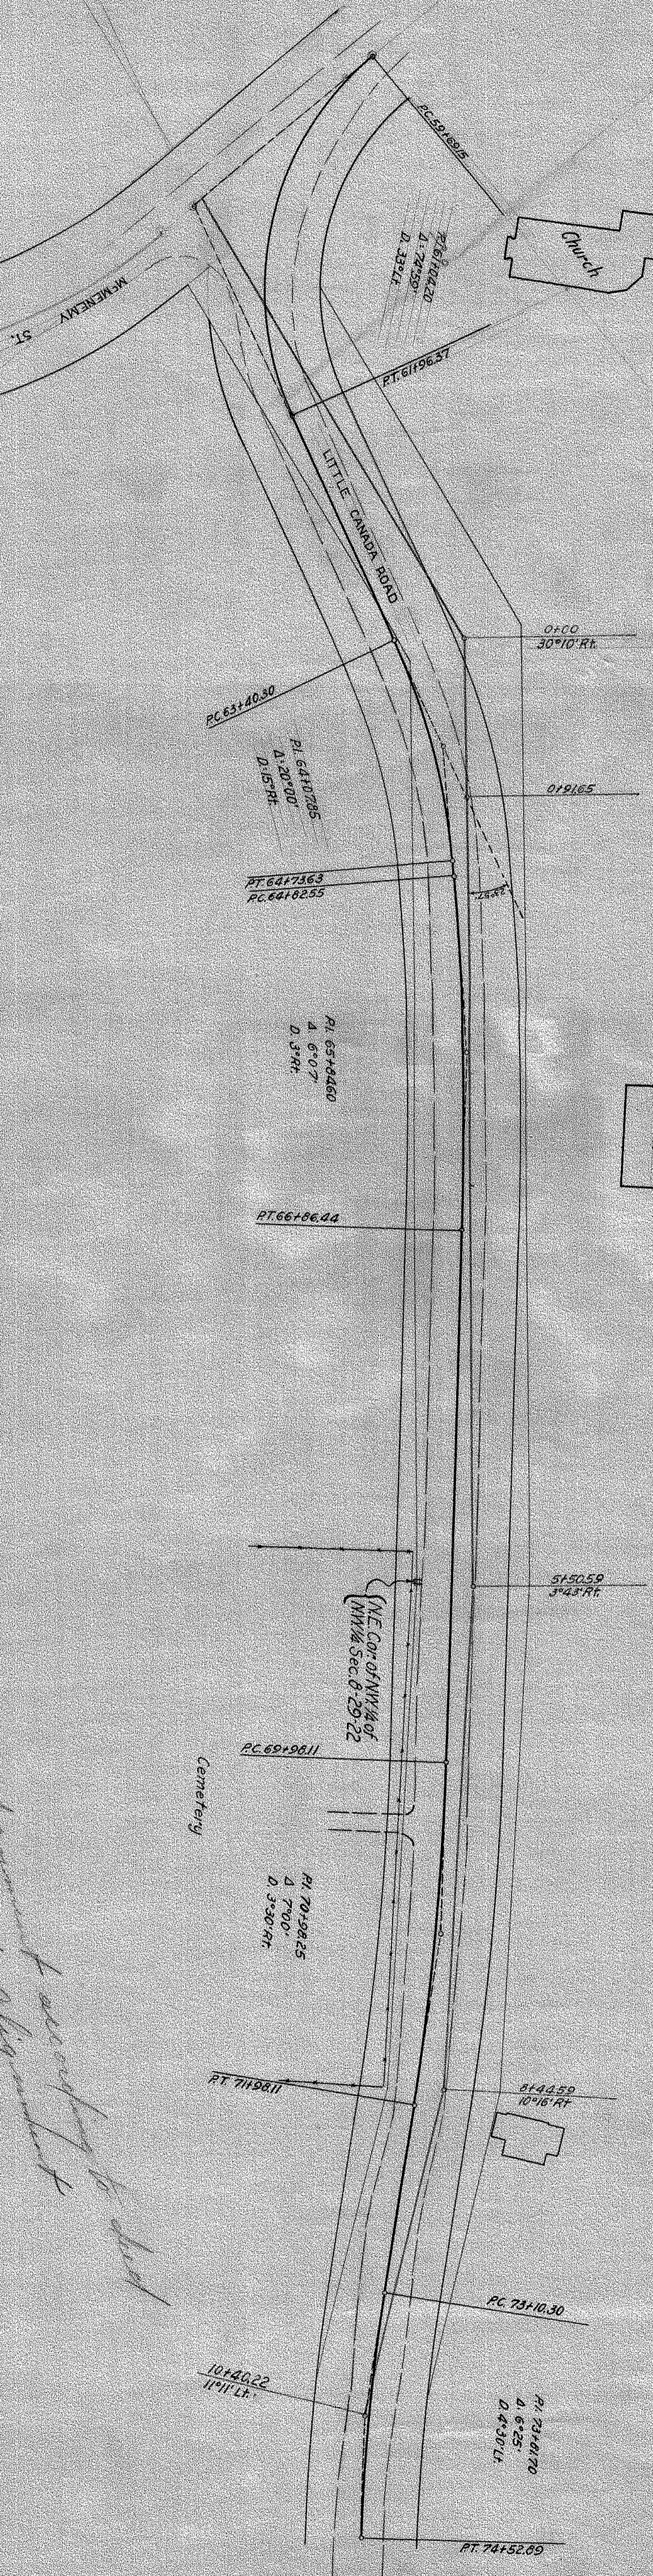

*Red - Alignment according to plan
Black - Present alignment
1" = 50'*

R-72

PROPOSED
ASST. CO. ENGR.