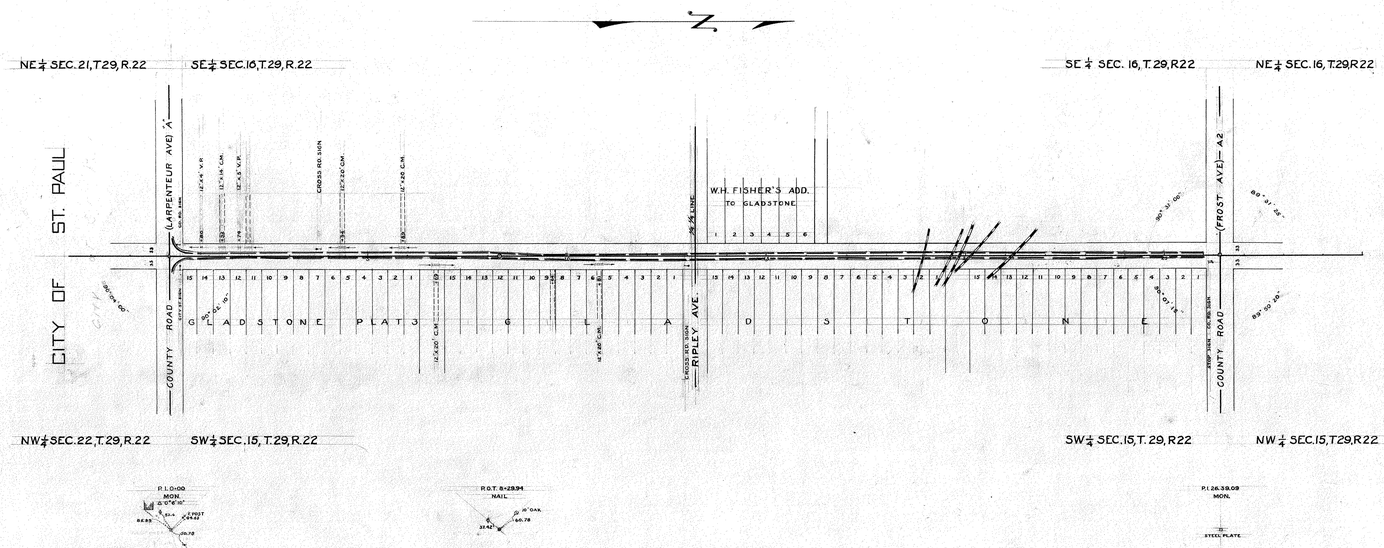
NE¼ SEC. 21, T29, R.22
SE¼ SEC. 16, T29, R.22
SE¼ SEC. 16, T. 29, R22
NE¼ SEC. 16, T.29, R22
CITY OF ST. PAUL
LARPENTEUR AVE.
COUNTY ROAD
W.H. FISHER'S ADD. TO GLADSTONE
GLADSTONE PLAT 3
GLADSTONE
RILEY AVE.
(FROST AVE.) A2
COUNTY ROAD
NW¼ SEC. 22, T.29, R.22
SW¼ SEC. 15, T. 29, R.22
SW¼ SEC. 15, T. 29, R22
NW¼ SEC. 15, T29, R22
P.I. 0+00 MON.
R.O.T. 8+28.94 NAIL
P.I. 26+39.09 MON.
STEEL PLATE