


TO LARRENTEUR AVE. FROM NORTH SIDE LAKE DRIVE
FROM NORTH SIDE LAKE DRIVE TO LARRENTEUR AVE.

SW 1/4 SEC. 16, T. 29 R. 22

SW 1/4 SEC. 16, T. 29 R. 22

SE 1/4 SEC. 16, T. 29 R. 22

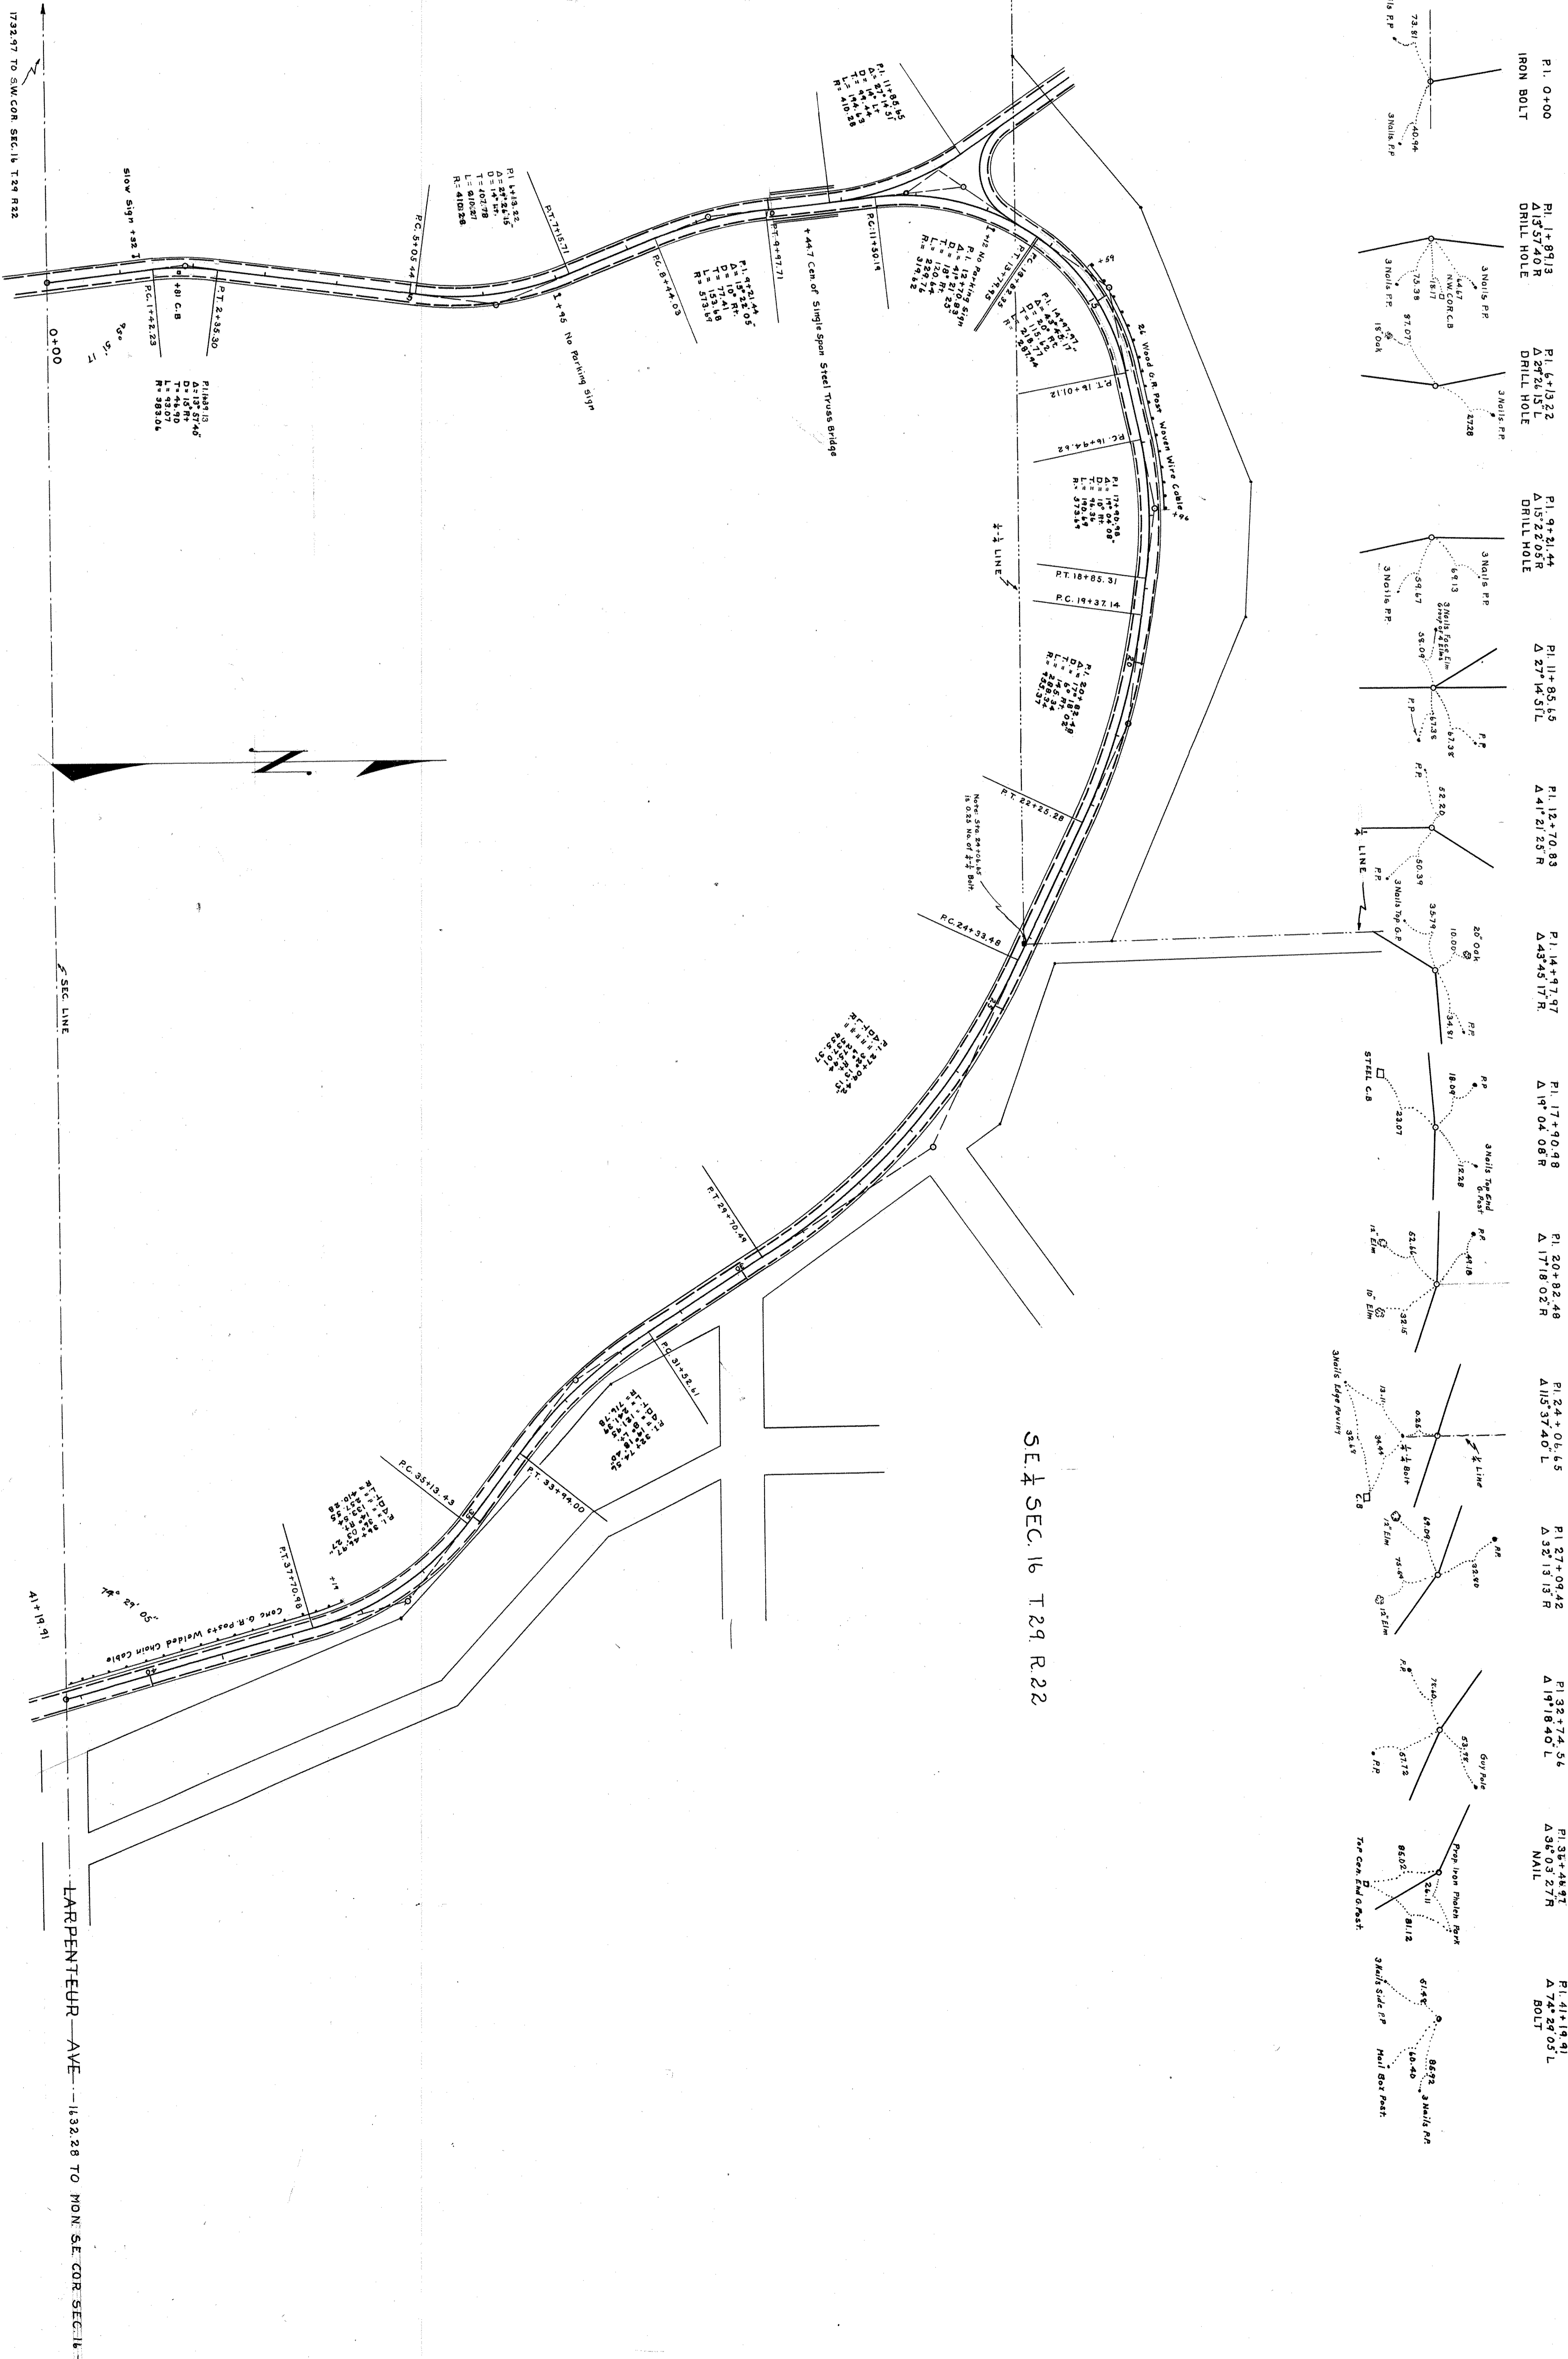

- PI 0+00 IRON BOLT
