

OFFICE OF COUNTY ENGINEER RAMSEY COUNTY PROGRESSIVE ROAD MAP OF LAKE AVE.

FROM S.T.H. NO. 1 TO E. CO. LINE.


TOTAL LENGTH 8859.95 FT. 1.68 MILES
SCALE: 1" = 100'

CONVENTIONAL SIGNS & ABBREVIATIONS

ITEM	CONVENTION	ABBREV.	ITEM	ABBREV.
County Line	---		Surfacing	S
Township Line	----		Sectional Conc. Culv. (light type)	P1
Section Line	-----		Sectional Conc. Culv. (heavy type)	P3
City or Village	-----		Corrugated Metal Culvert	C.M.
Fence	=====		Vitrified Clay Pipe	V.P.
Right-of-Way Line	=====	R.O.W.	Cast Iron Pipe	C.I.P.
Earth Road - not standard	-----	Rd.	Private	Pri.
Graveled on Grade not standard	-----	G.	In place	Imp.
Graded to Standard	-----	Gr.	Right	Rt.
Graded & Graveled to Stand.	-----	Gr. & G.	Left	Lt.
Bituminous Treated	-----	Bit. Tr.	Intersection Angle	Δ
Paved	=====	Pvd.	Radius	R
Farm Entrance	-----	F.E.	Point of Curve	P-C
Railroads	-----	R.R.	" " Tangent	P-T
Retaining Walls	-----	R.W.	" " Intersection	P-I
Guard Rail	-----	G.R.	" on Curve	P-O-C
Survey Line	-----	€	" " Tangent	P-O-T
Gravel Pit	④			
Sand Pit	③			
Clay Pit	②			
Culverts				
" Plain	-----			
" With Headwalls	-----			
Manhole	○	M.H.		
Catch Basin	□	C.B.		
Electric Poles	◇	P.P.		
Telephone or Telegraph Poles	◆	T.P.		
Trolley Poles	■	Tr.P.		
Road Lamps	⊕	R.L.		
County Marking Signs	■	M. sign		
" Guide	⊥	G. sign		
" Caution	◆	C. sign		
" Reflector	●	R. sign		
" Rail Crossing	⊕	R.R. sign		
Railroad - Crossing Sign	⊕	Xing sign		

Surveyed by	Dates
A.W. LINDAHL	7-27
Mapped by	Dates
M.W. CARLEY	7-31
Revised by	Dates

KEY MAP

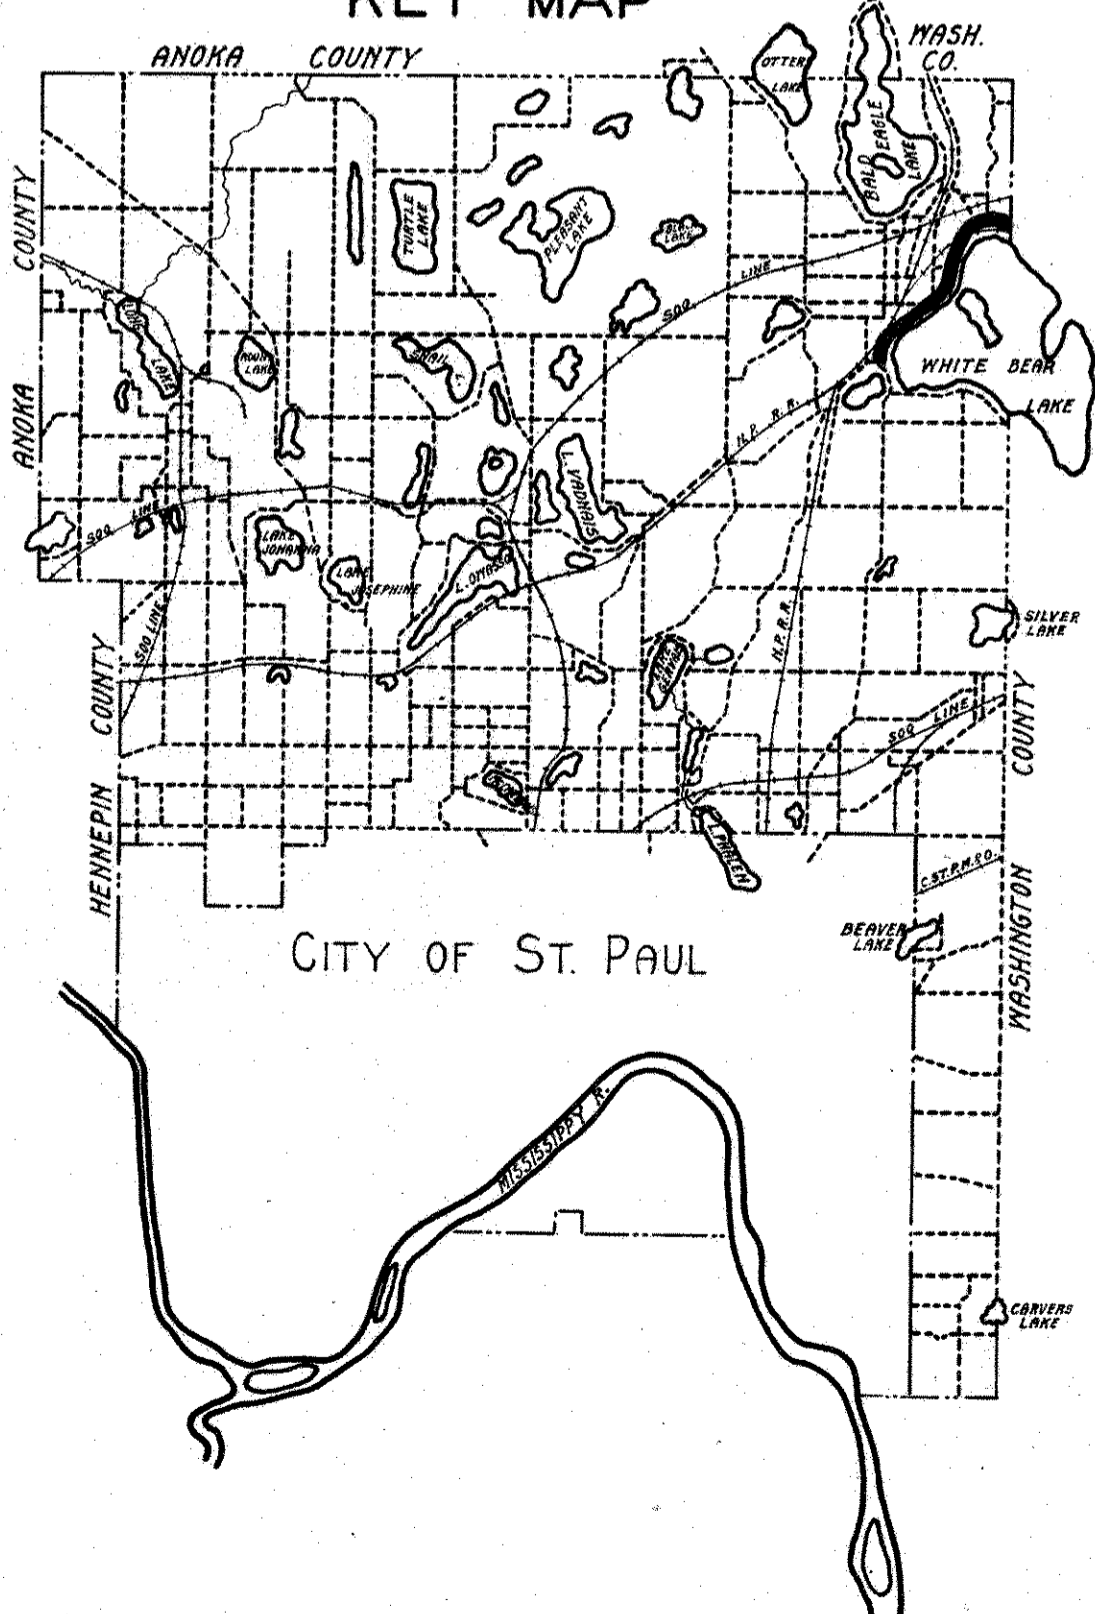

see H.T. 2. ava. 2/21/11