SUMMARY

0+00.00 to 26+36.15

DRAINS		CULVERTS						BRIDGES	SIGNS							GUARD RAIL		CURB		SURFACING	
TYPE	NO.	DIA.	C.M.	P1	P3	V.P.	C.I.P.	DESCRIPTION	MARKING	CAUTION	GUIDE	REFLECTOR	R.R.	RR.XING		TYPE	LIN.FT.	TYPE	LIN.FT.	TYPE	SQ.YDS.
		15"	216																		
		24"			168																

S.W. $\frac{1}{4}$ 17·29·23

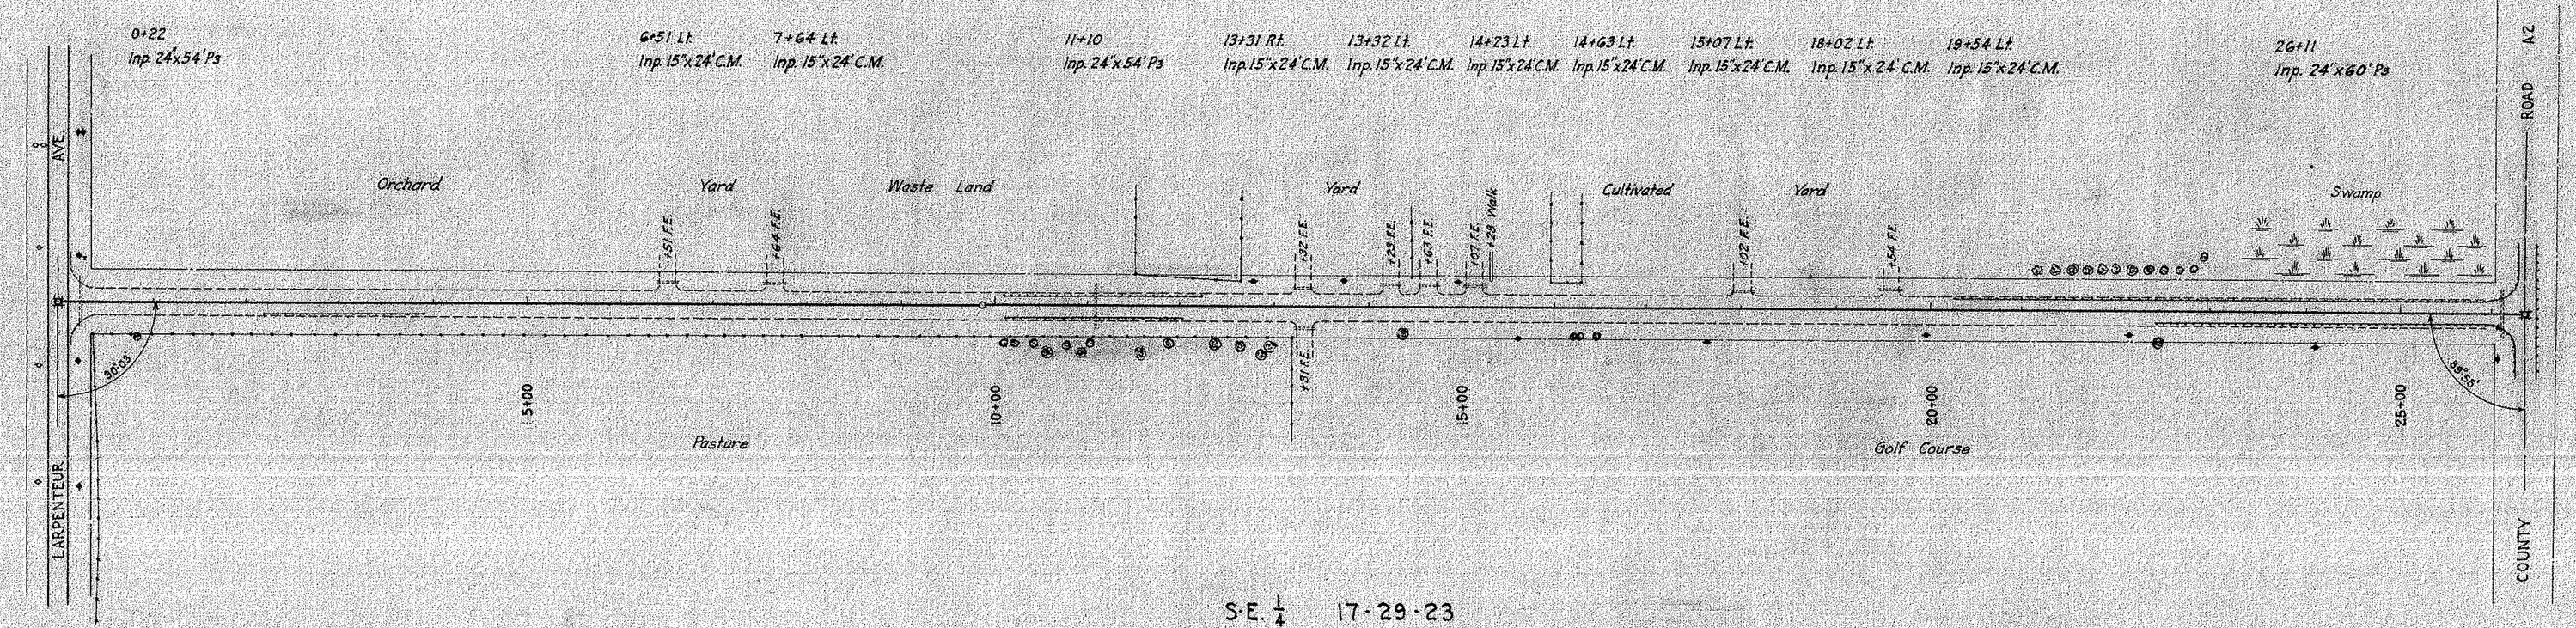

S.E. $\frac{1}{4}$ 17·29·23

P.O.T. 0+00.0

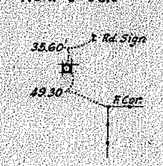

P.O.T. 9+88.70

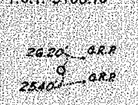

P.O.T. 26+36.15