


SEC. 14 • 29 • 23

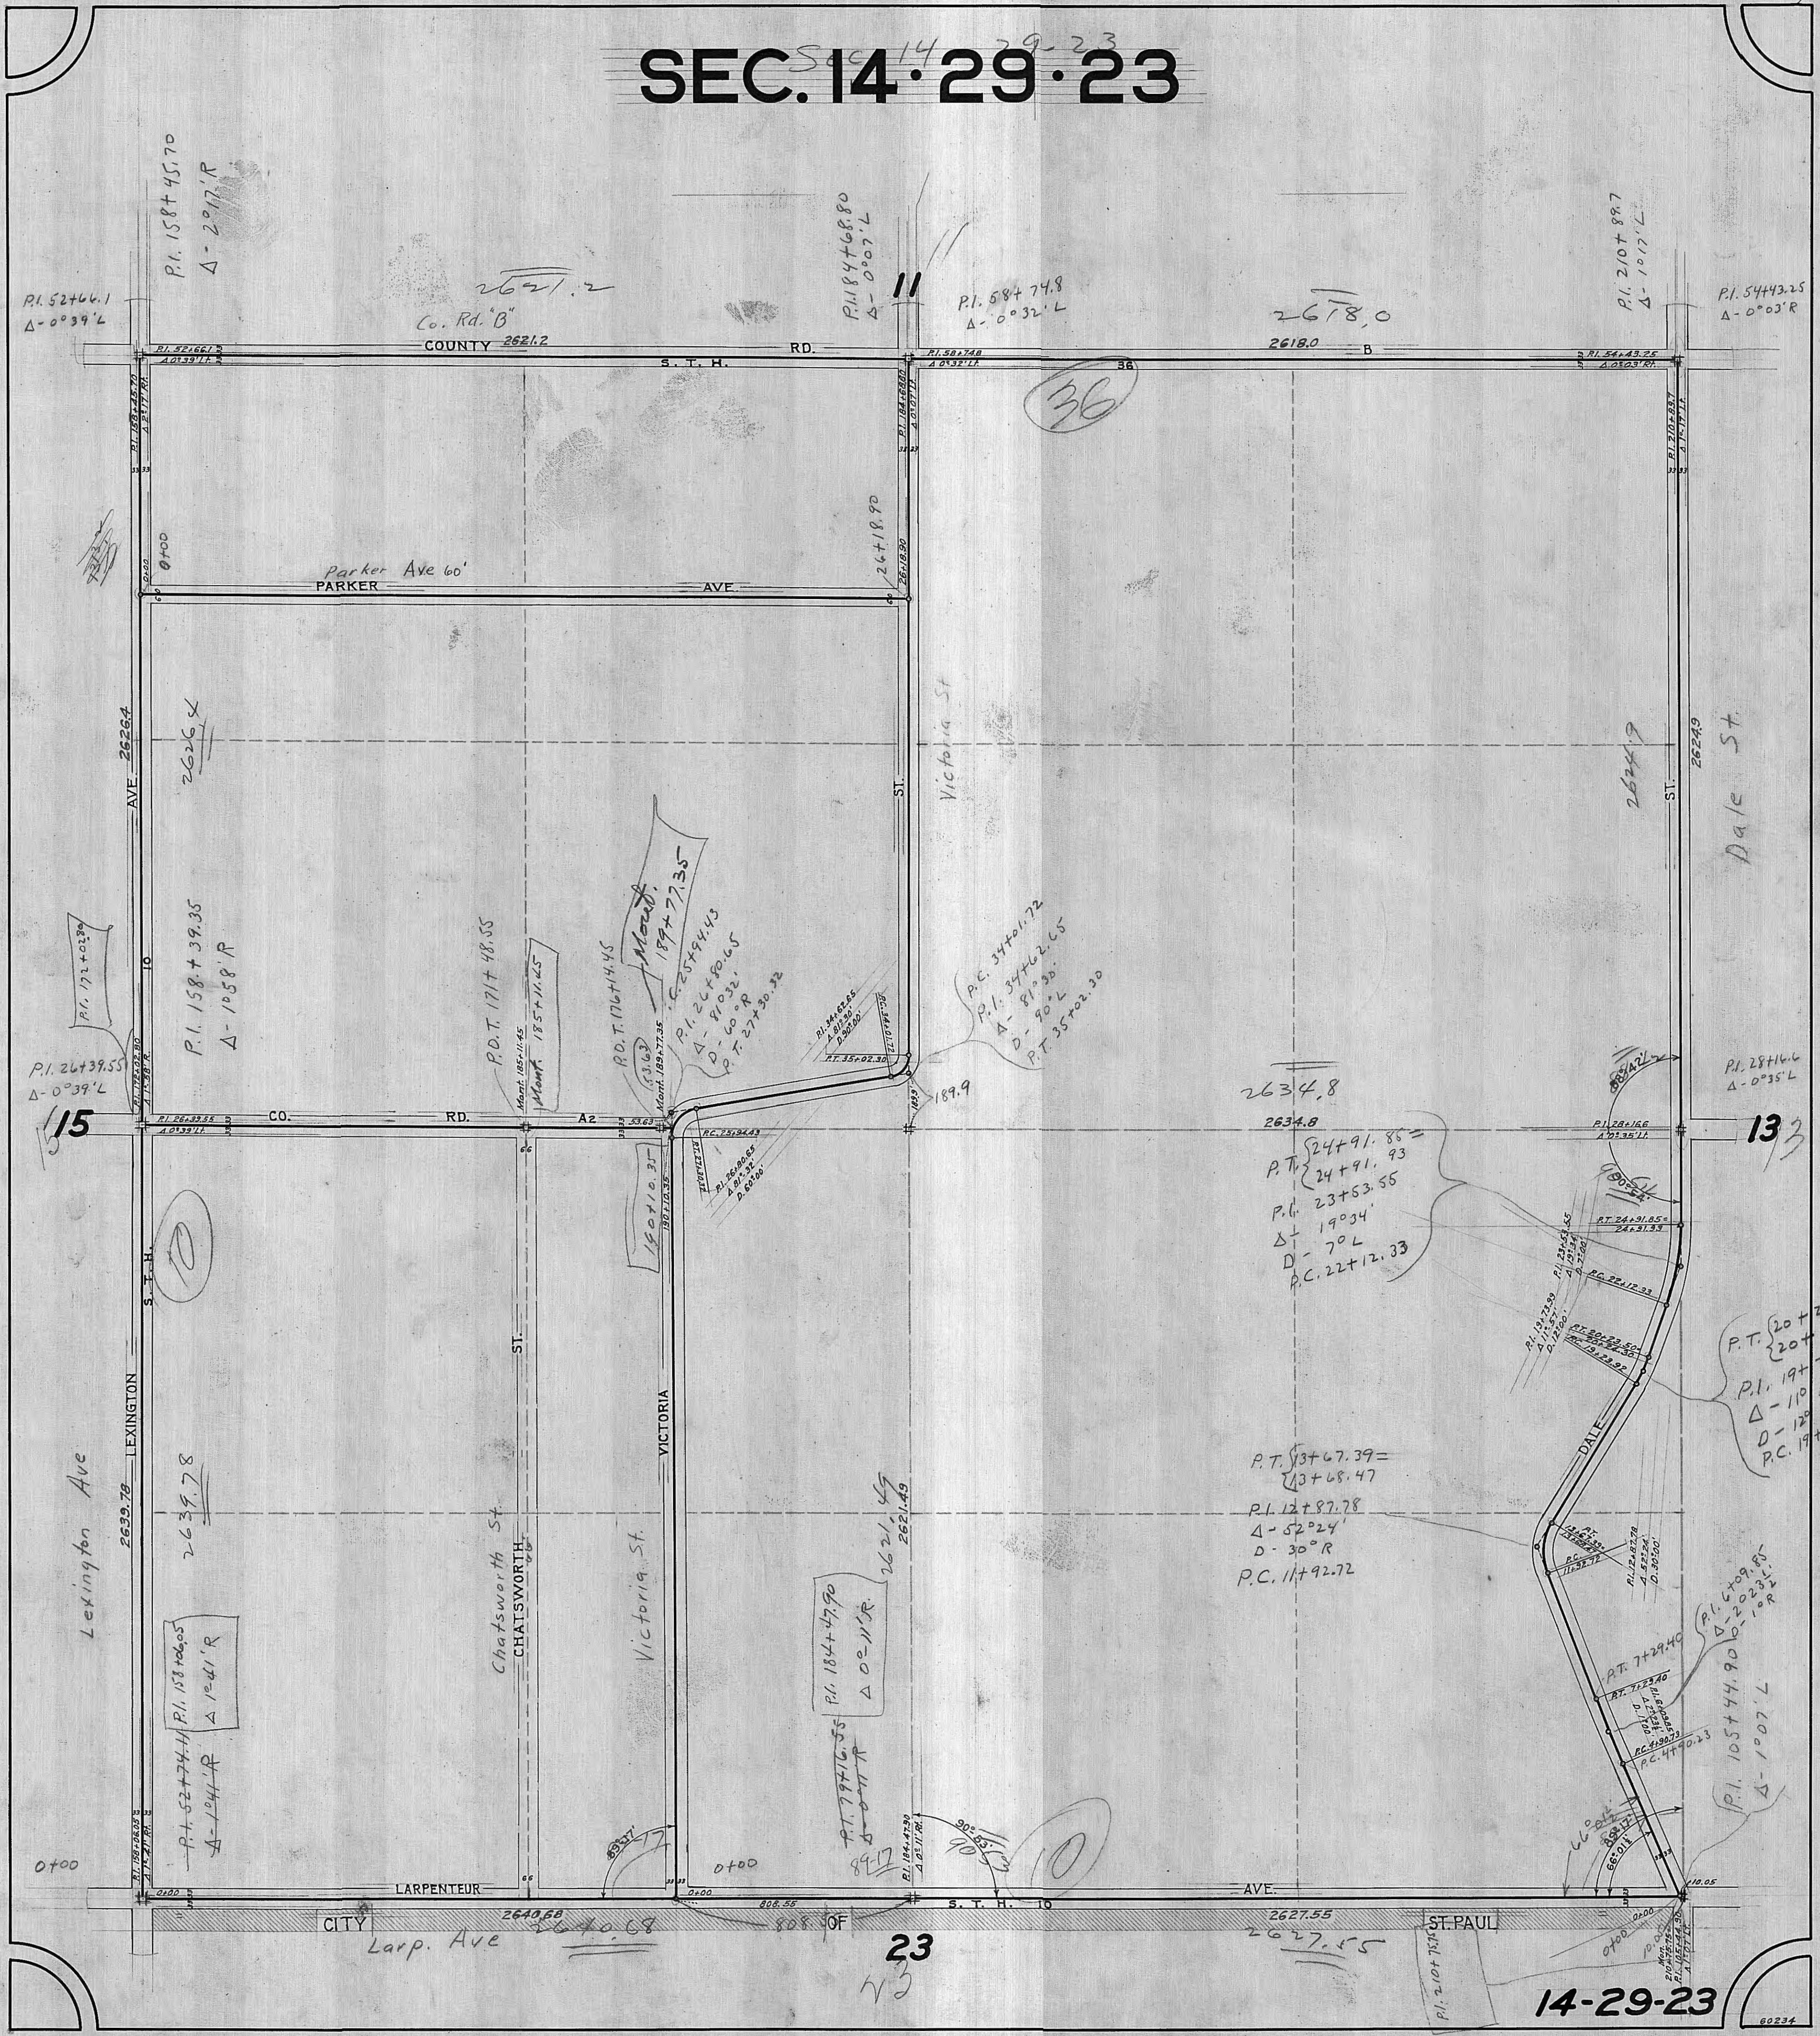

14-29-23

60234