


Sec. -36-30-22

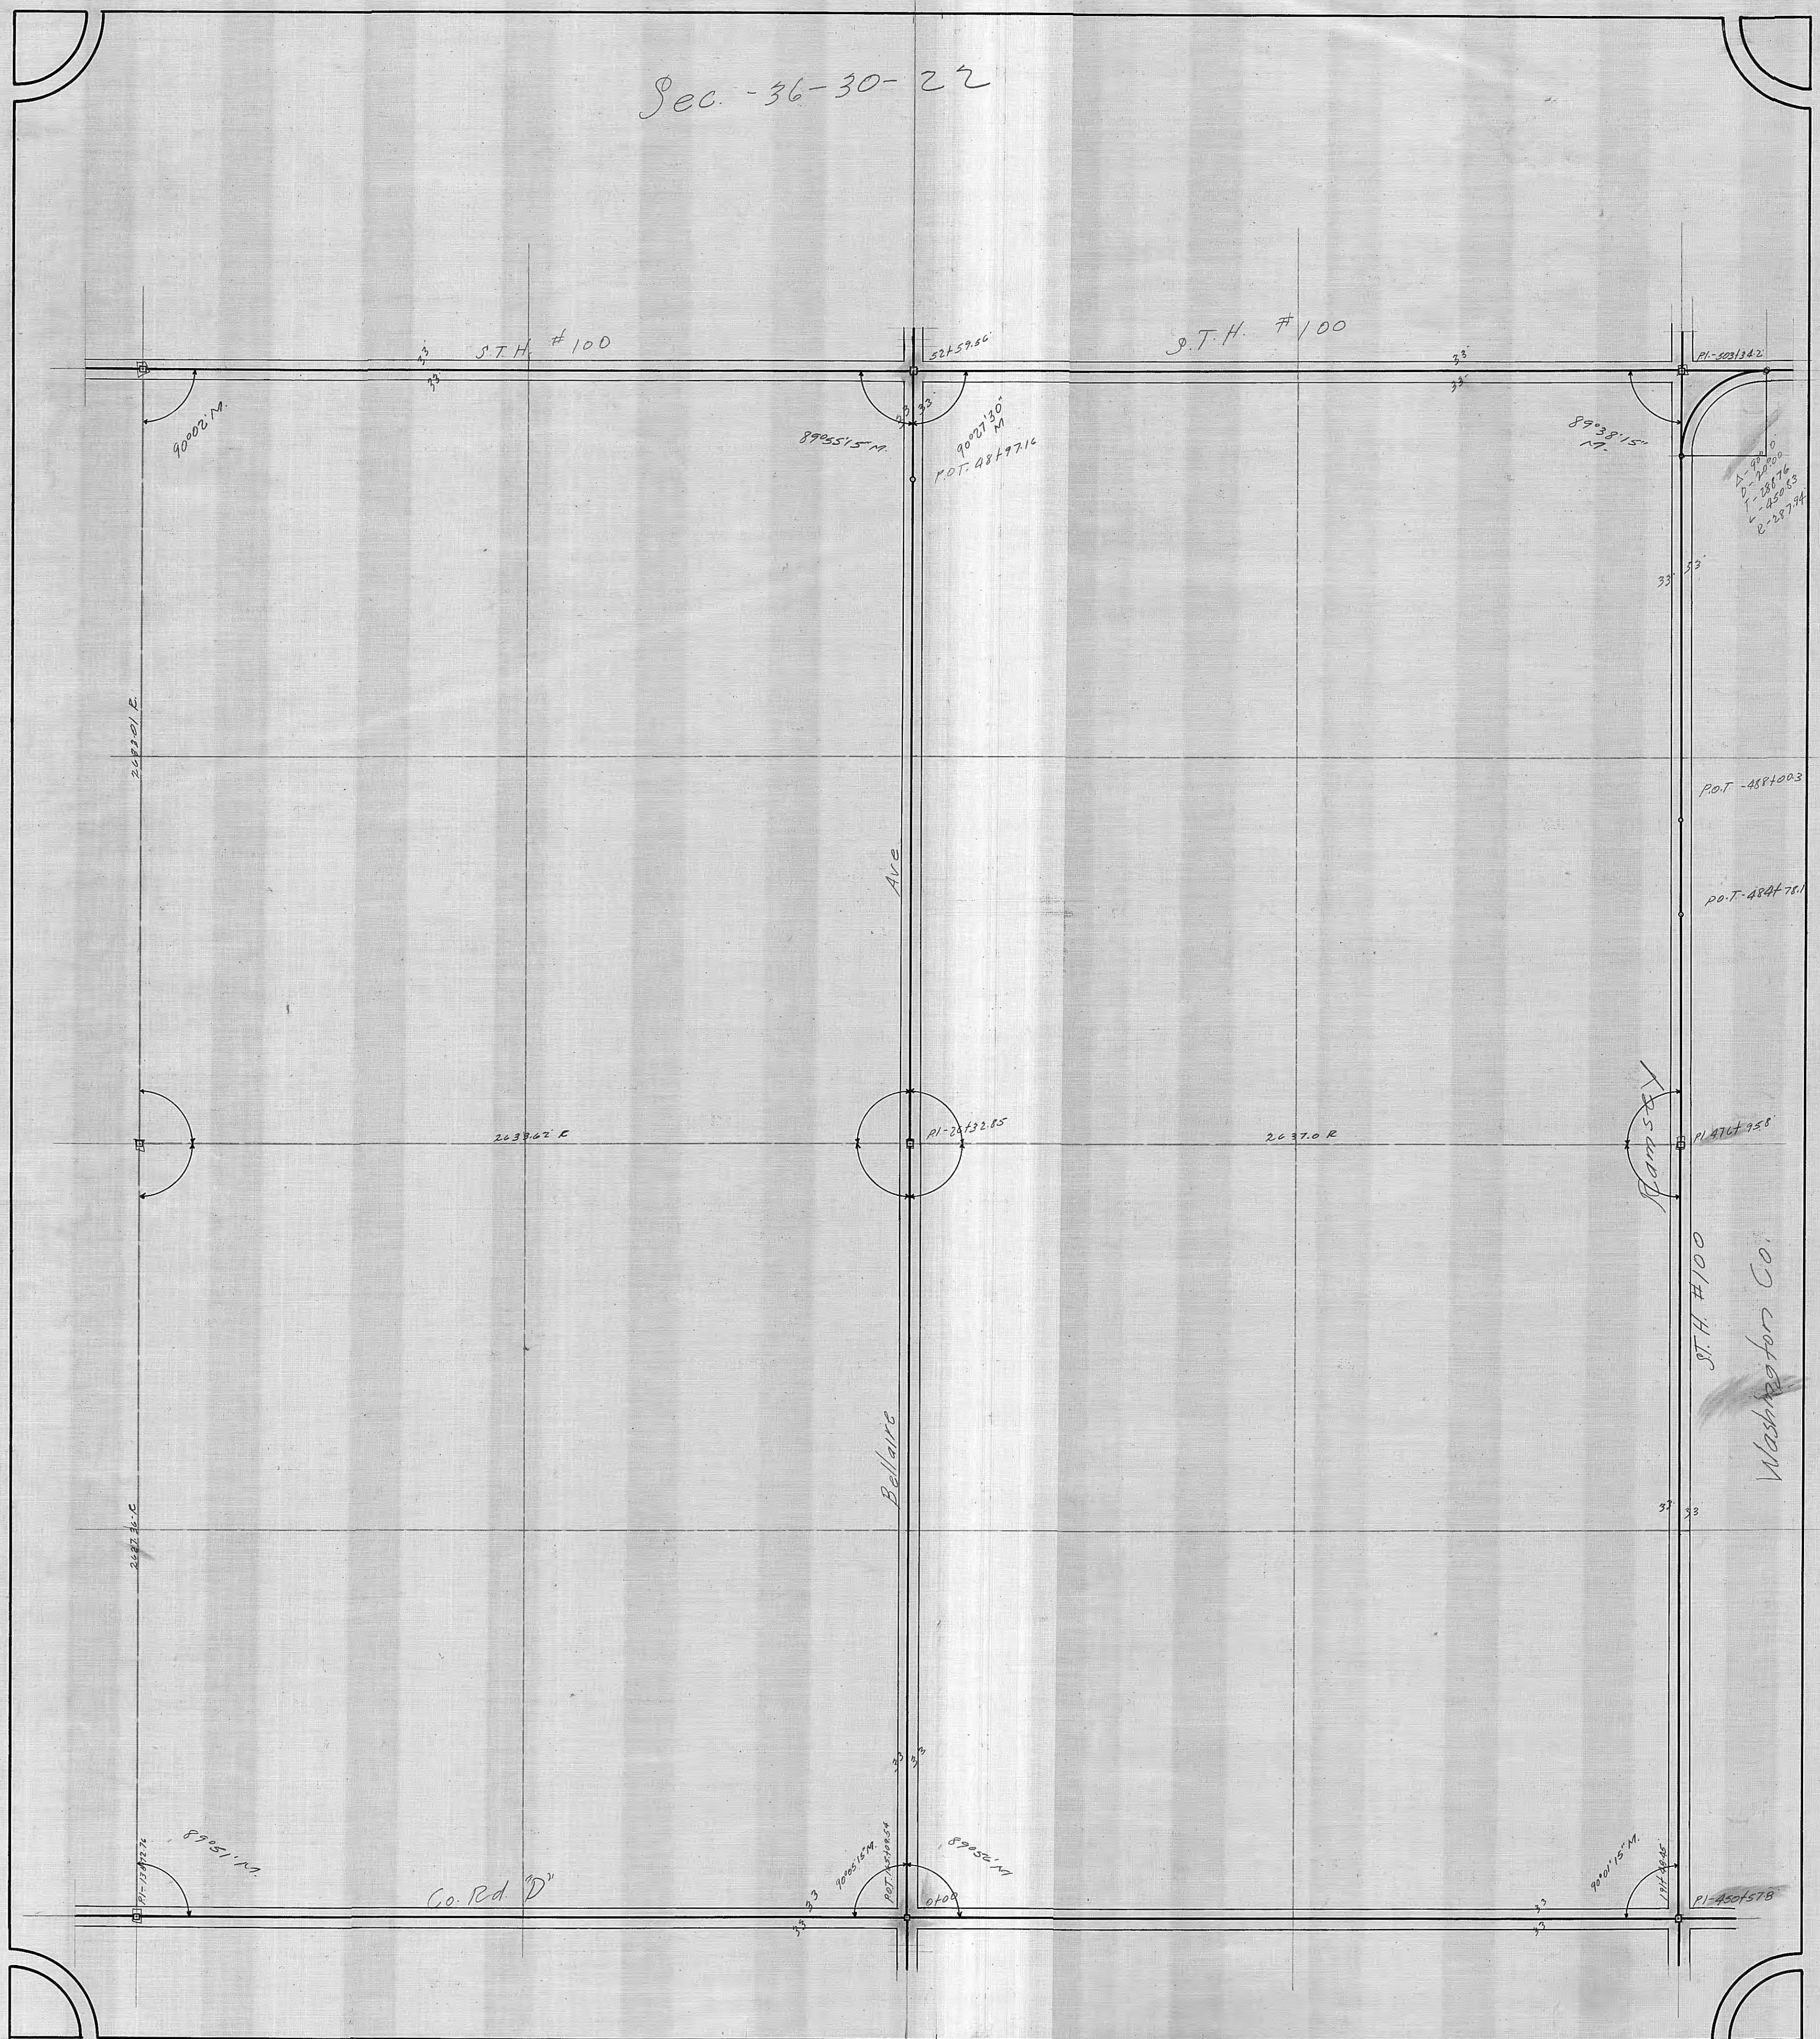

Washington Co.