


PLAT OF DITCH #7

N.E. $\frac{1}{4}$ SECTION 5 T.29 N. R.22 W.

Sept 20 - 1923

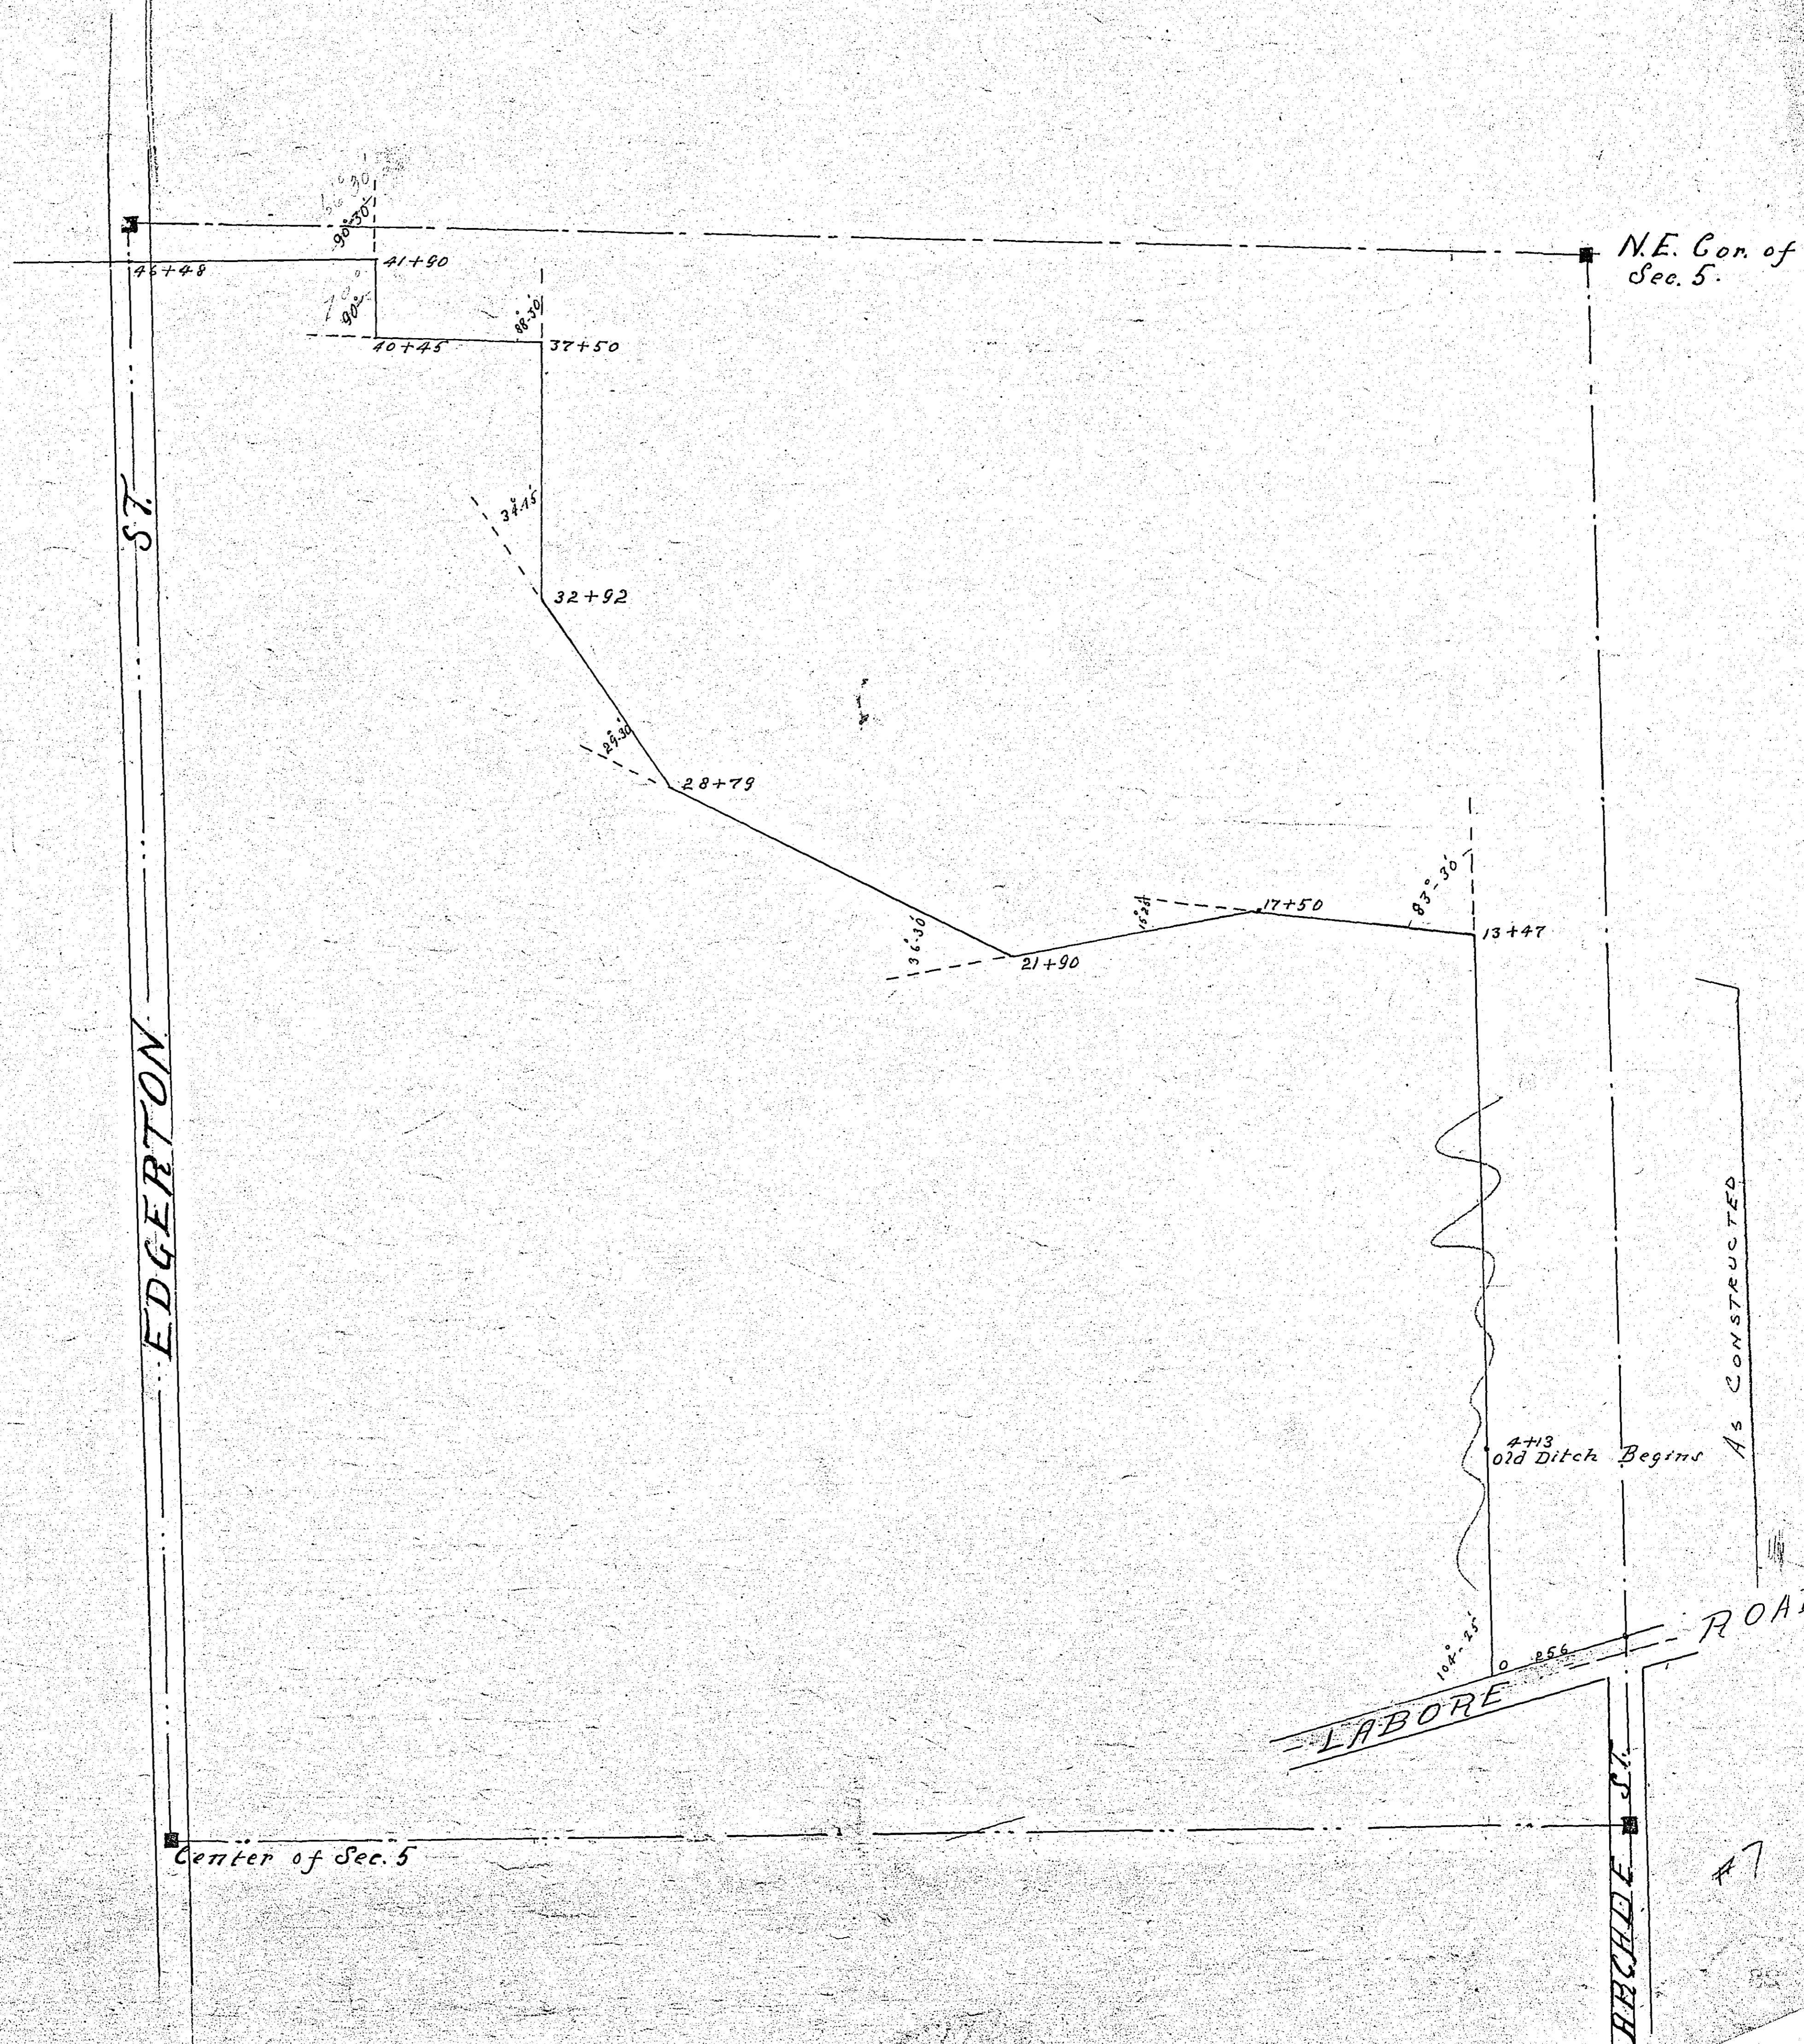

N.E. Cor. of Sec. 5.

ST

EDGERTON

Center of Sec. 5

LABORE

ROAD

ST

#7

66

W. H. Lightner.

M. Nadeau

Aug. Barfuss

Tornton & Costa

A. Nadeau.

G. Nadeau.

P. Frattalone.

T. Carle.

D. La May.

P. Frattalone

Co. Ditch 7 (Branch)

From Twin Lake 2

Co. Ditch 16

PRIVATE CARTWAY

CONCEDED CARTWAY

PRIVATE CARTWAY

PRIVATE CARTWAY

M. Frattalone

P. Frattalone

Katherine White

Proposed Town Road

A. Nadeau.

Centerville Road

16

15

14

13

12

11

3

4

5

6

7

8

9

21

St Paul Water Works Right of Way

To Lake Gervais

Map Showing Portions of County Ditches 16 & 7 in Sections 5 & 6 New Canada Township (R-22 T29)

Prepared - 6-27-25 in the Office of the Ramsey Co. Engineer. SCALE 1" = 200'

7

1307