


FOR QUANTITIES SEE SHEET NO. 10

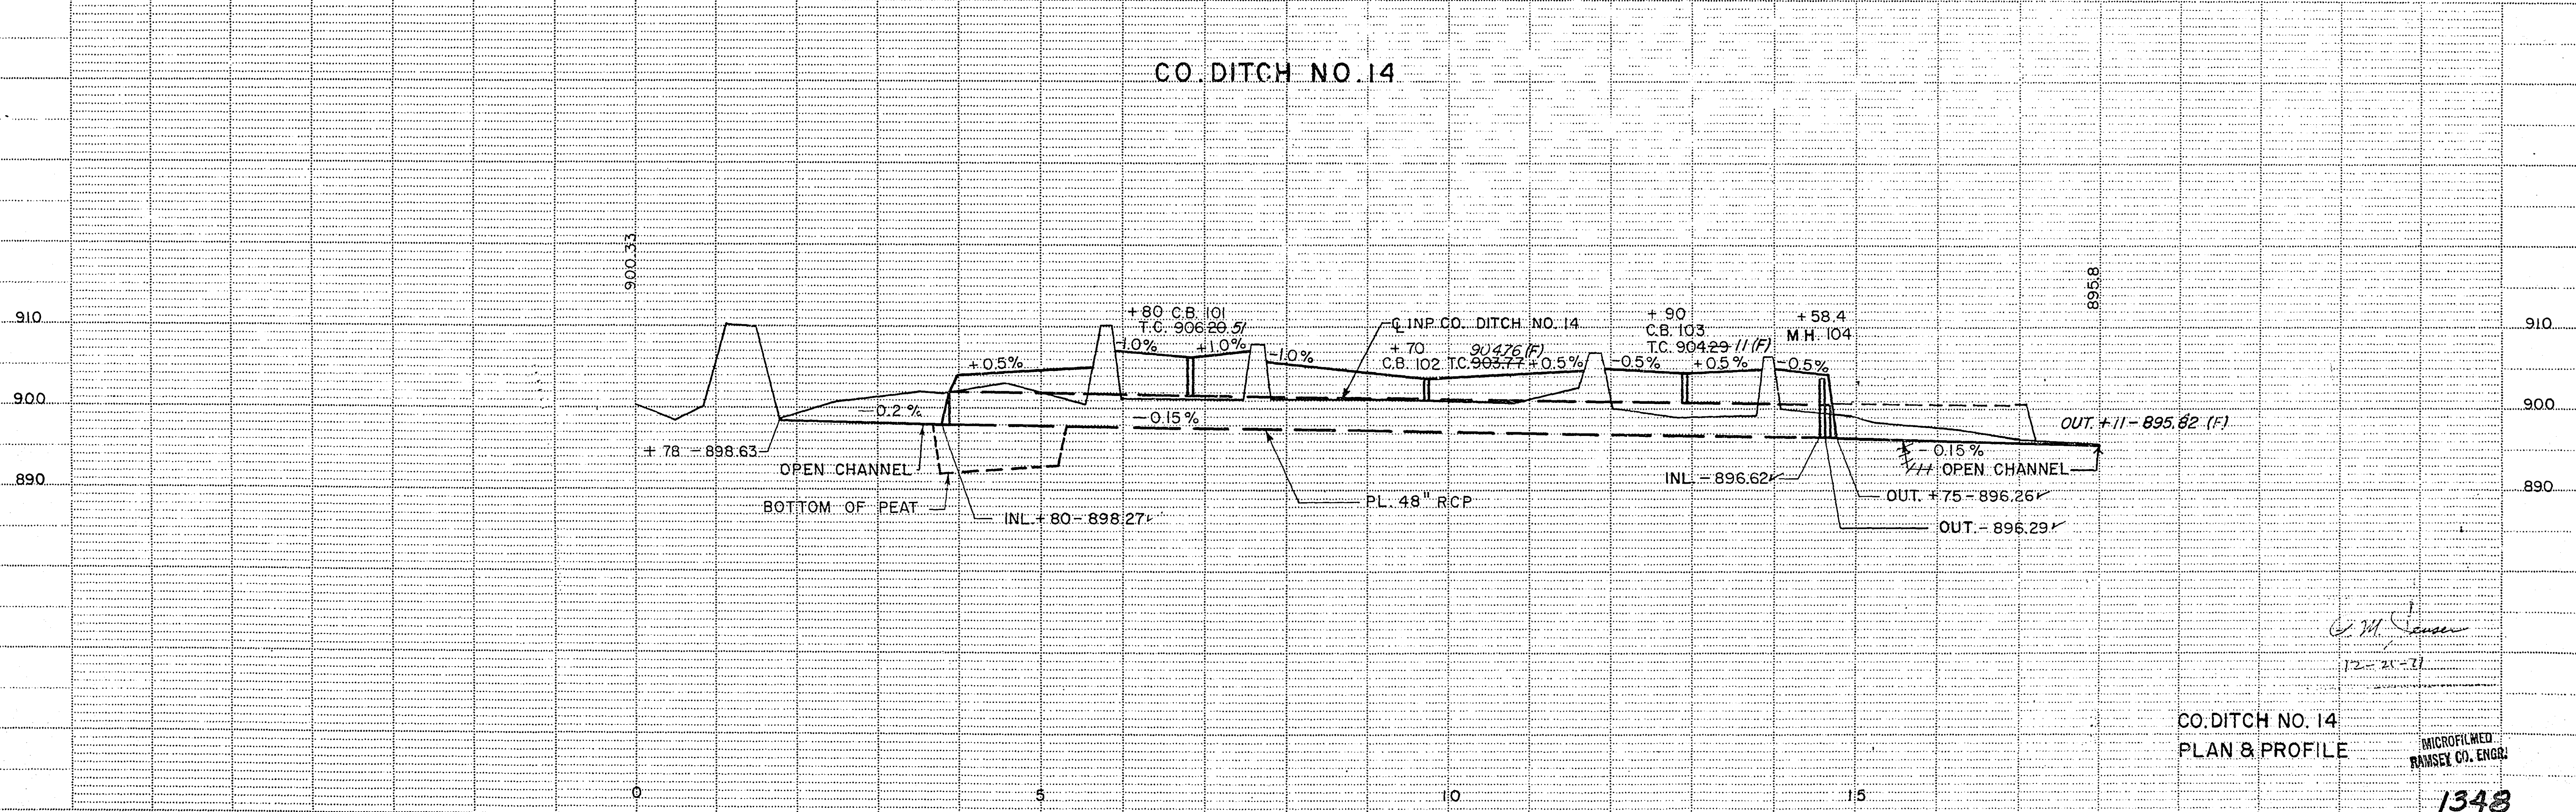

CO. DITCH NO. 14  
 PLAN & PROFILE  
 MICROFILMED  
 RAMSEY CO. ENGRS

1348