


MAP OF INTERSECTION OF LEXINGTON AVE. AND LARPENTEUR AVE.

AS OF OCT. 13, 1928.
SCALE ~ 1 in. = 10 FT. DRAWN BY ~ H.R. PETERSEN.

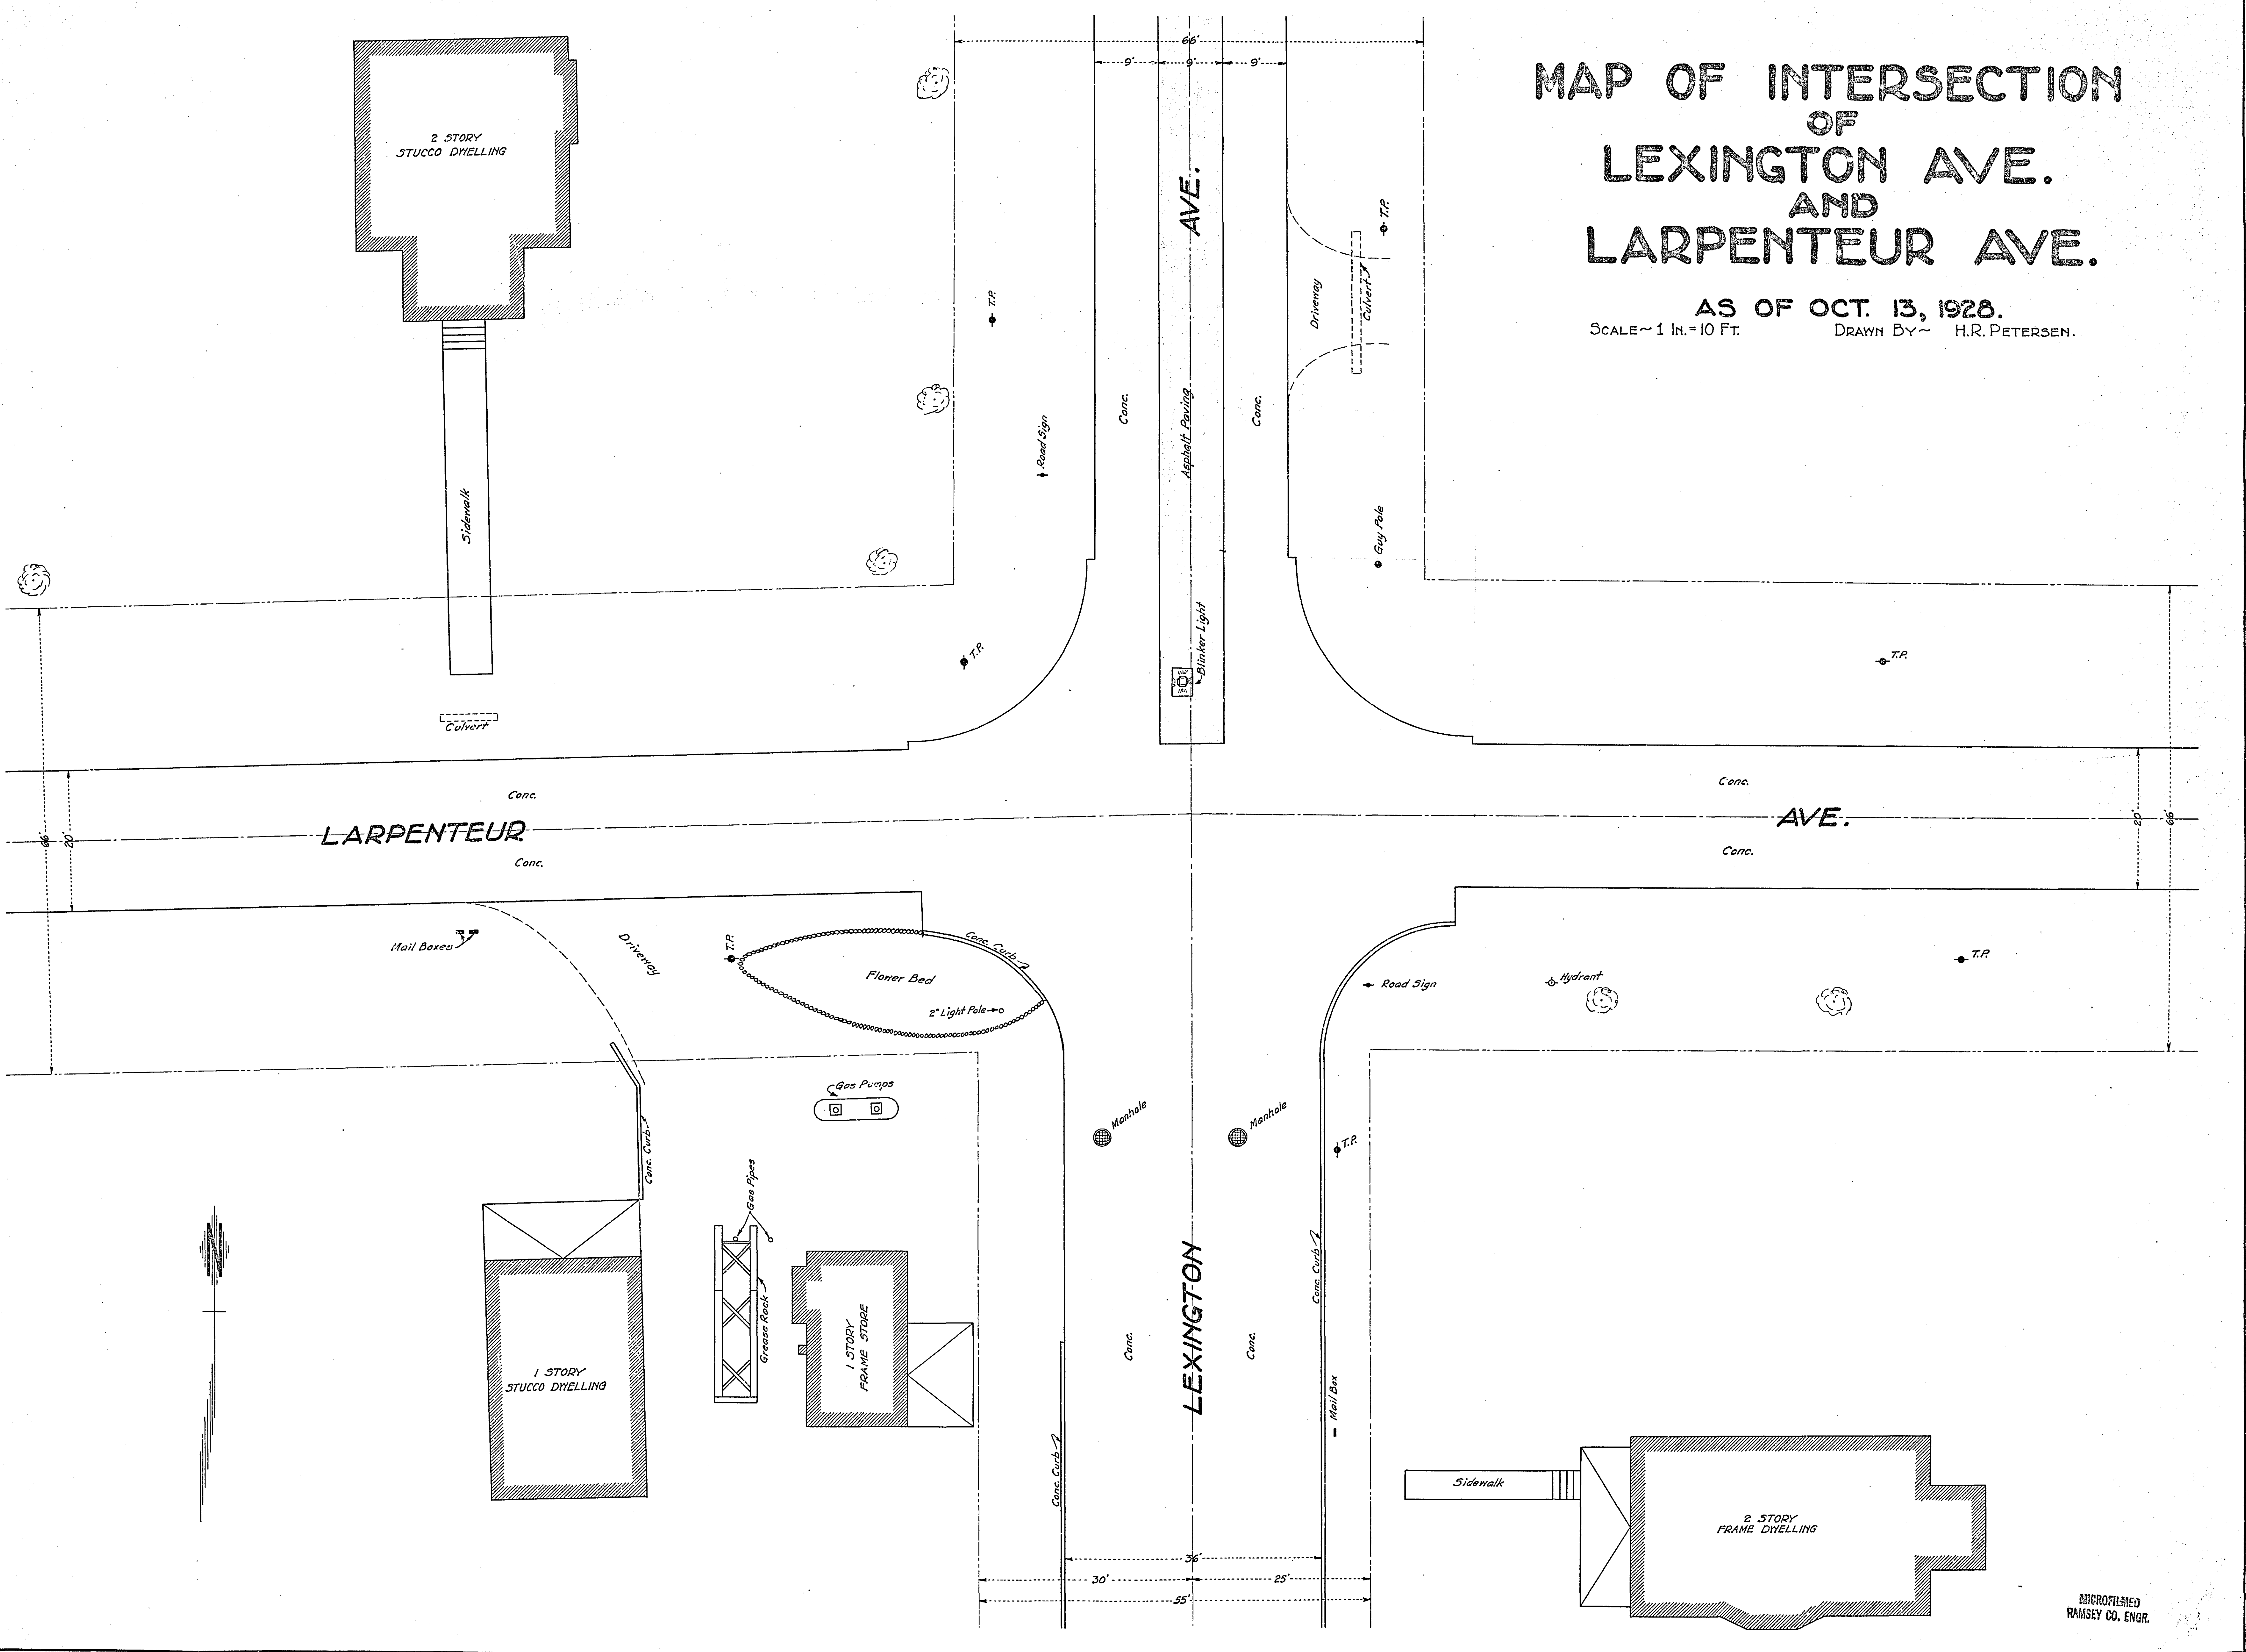

MICROFILMED
RAMSEY CO. ENGR.