

OFFICE OF RAMSEY COUNTY ENGINEER
ST. PAUL, RAMSEY CO. MINN.
PAUL N. COATES
COUNTY ENGINEER

CERTIFICATE OF SURVEY

N.W. Cor. of Gov't. Lot 2

N.E. Cor. of Gov't. Lot 2

S89°52'E
1314.24

~DESCRIPTION~


All that portion of Gov't. Lot 2, Sec. 36 T30N-R23W, described as follows; Beginning at the N.E. Cor. of said Gov't. Lot 2 thence South, 1522.4 ft. to the North line of Lake Owasso Boulevard; thence N70°10'W, 487.25 ft.; thence N84°30'W, 174.47 ft.; thence S88°14'W, 267.04 ft. to the beginning of a curve to the Right the Radius of which is 254.94 ft. and central angle is 29°12' thence 129.20 ft. along and to the end of said curve; thence N62°34'W, 107.11 ft.; thence N69°34'W, 205.57 ft. to the West line of said Gov't. Lot 2; thence N0°07'W along said West line 1201.95 ft. to the Northwest Corner of said Gov't. Lot 2; thence S89°52'E along the North line of said Gov't. Lot 2, 1314.24 ft to point of beginning.

N0°07'W
1201.95
1317.13

1522.4
SOUTH
1316.38

GOV'T. LOT 2

Wabasso Lake

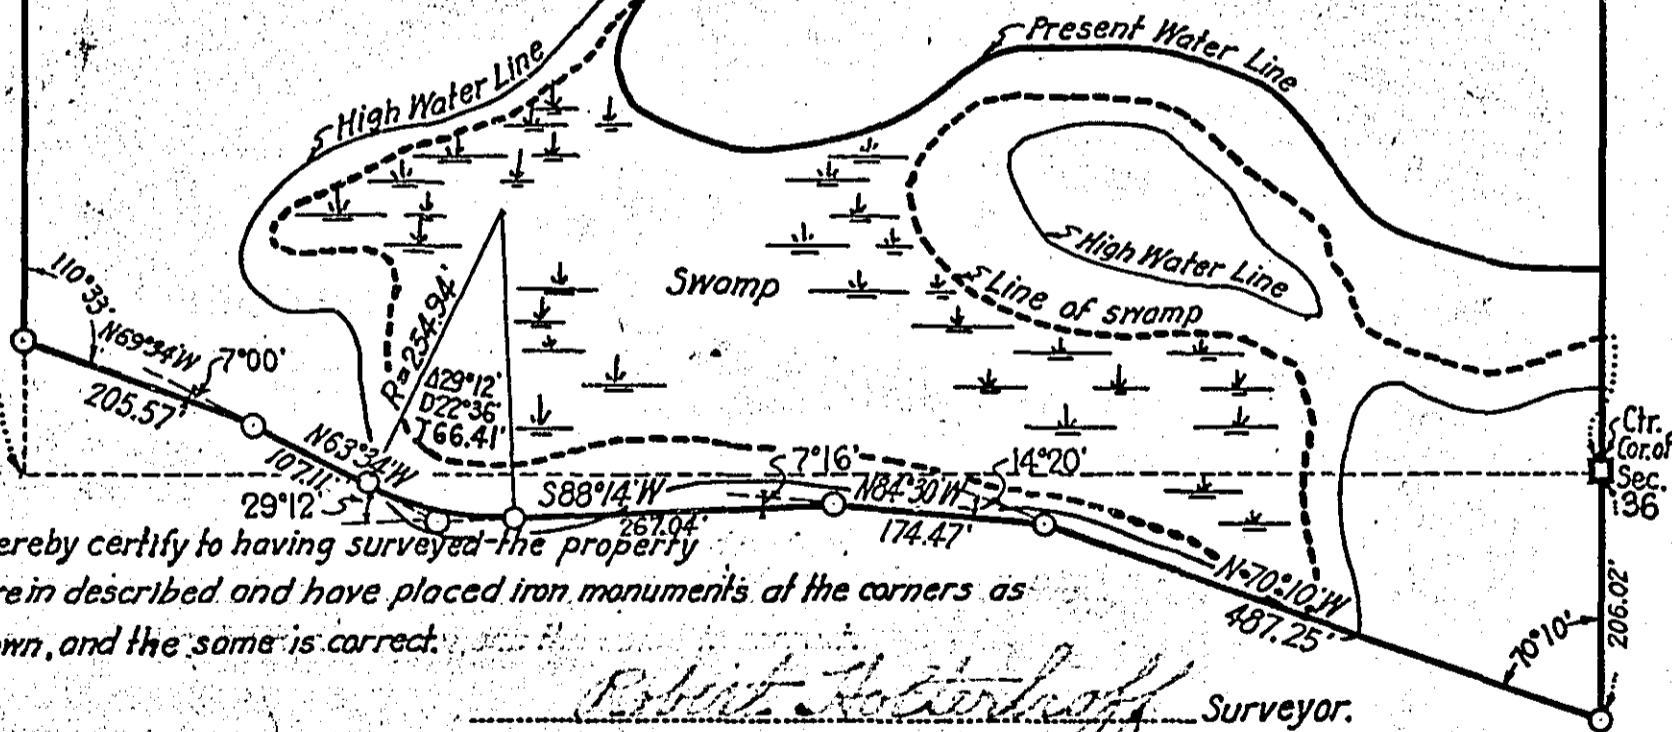

I hereby certify to having surveyed the property herein described and have placed iron monuments at the corners as shown, and the same is correct.

Robert Holterhoff Surveyor.

State of Minnesota }
County of Ramsey } On this 28th day of January A.D. 1925, before me personally appeared, Robert Holterhoff, to me well known, and acknowledged that he executed the foregoing certificate as his own free act and deed.

E. H. Liplin

Notary Public, Ramsey Co. Minnesota

My Commission expires Dec. 24 - 1929

MICROFILMED
RAMSEY CO. ENGR!

1597 1926