

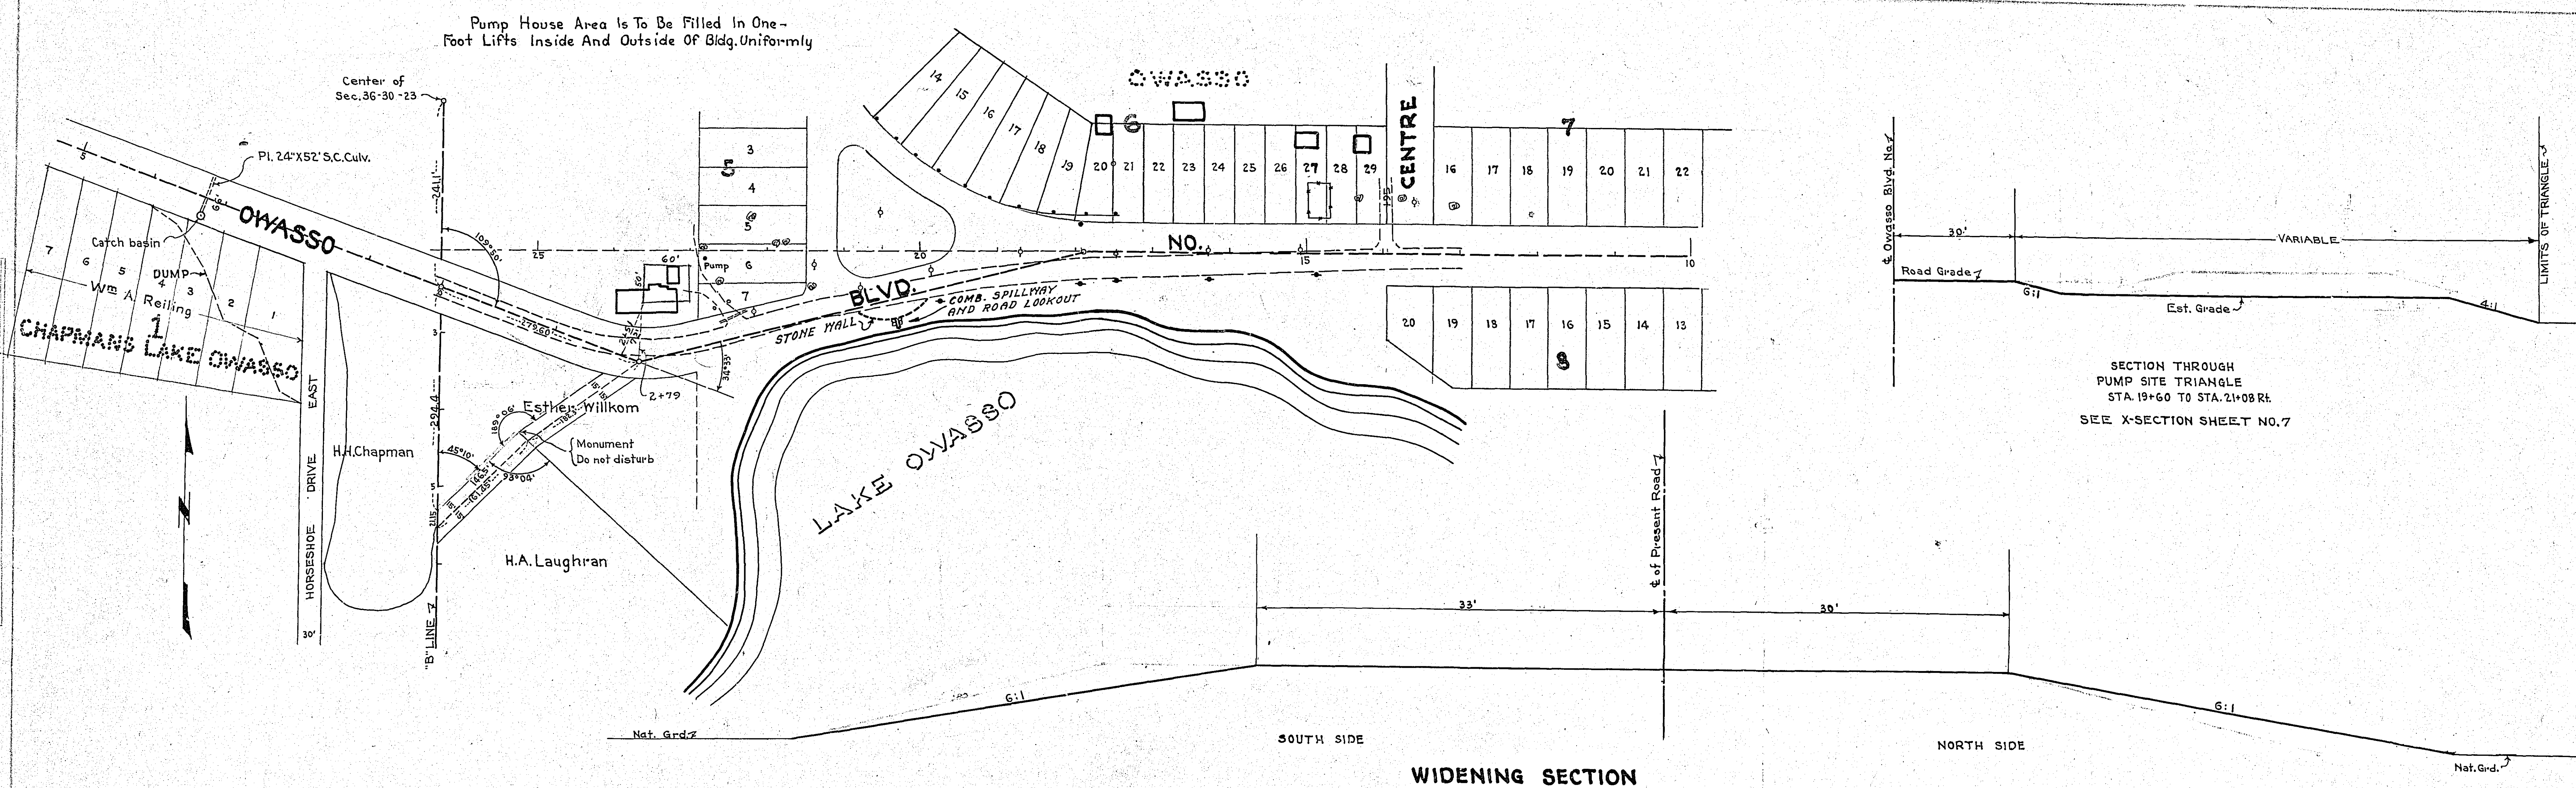


Pump House Area Is To Be Filled In One-Foot Lifts Inside And Outside Of Bldg. Uniformly

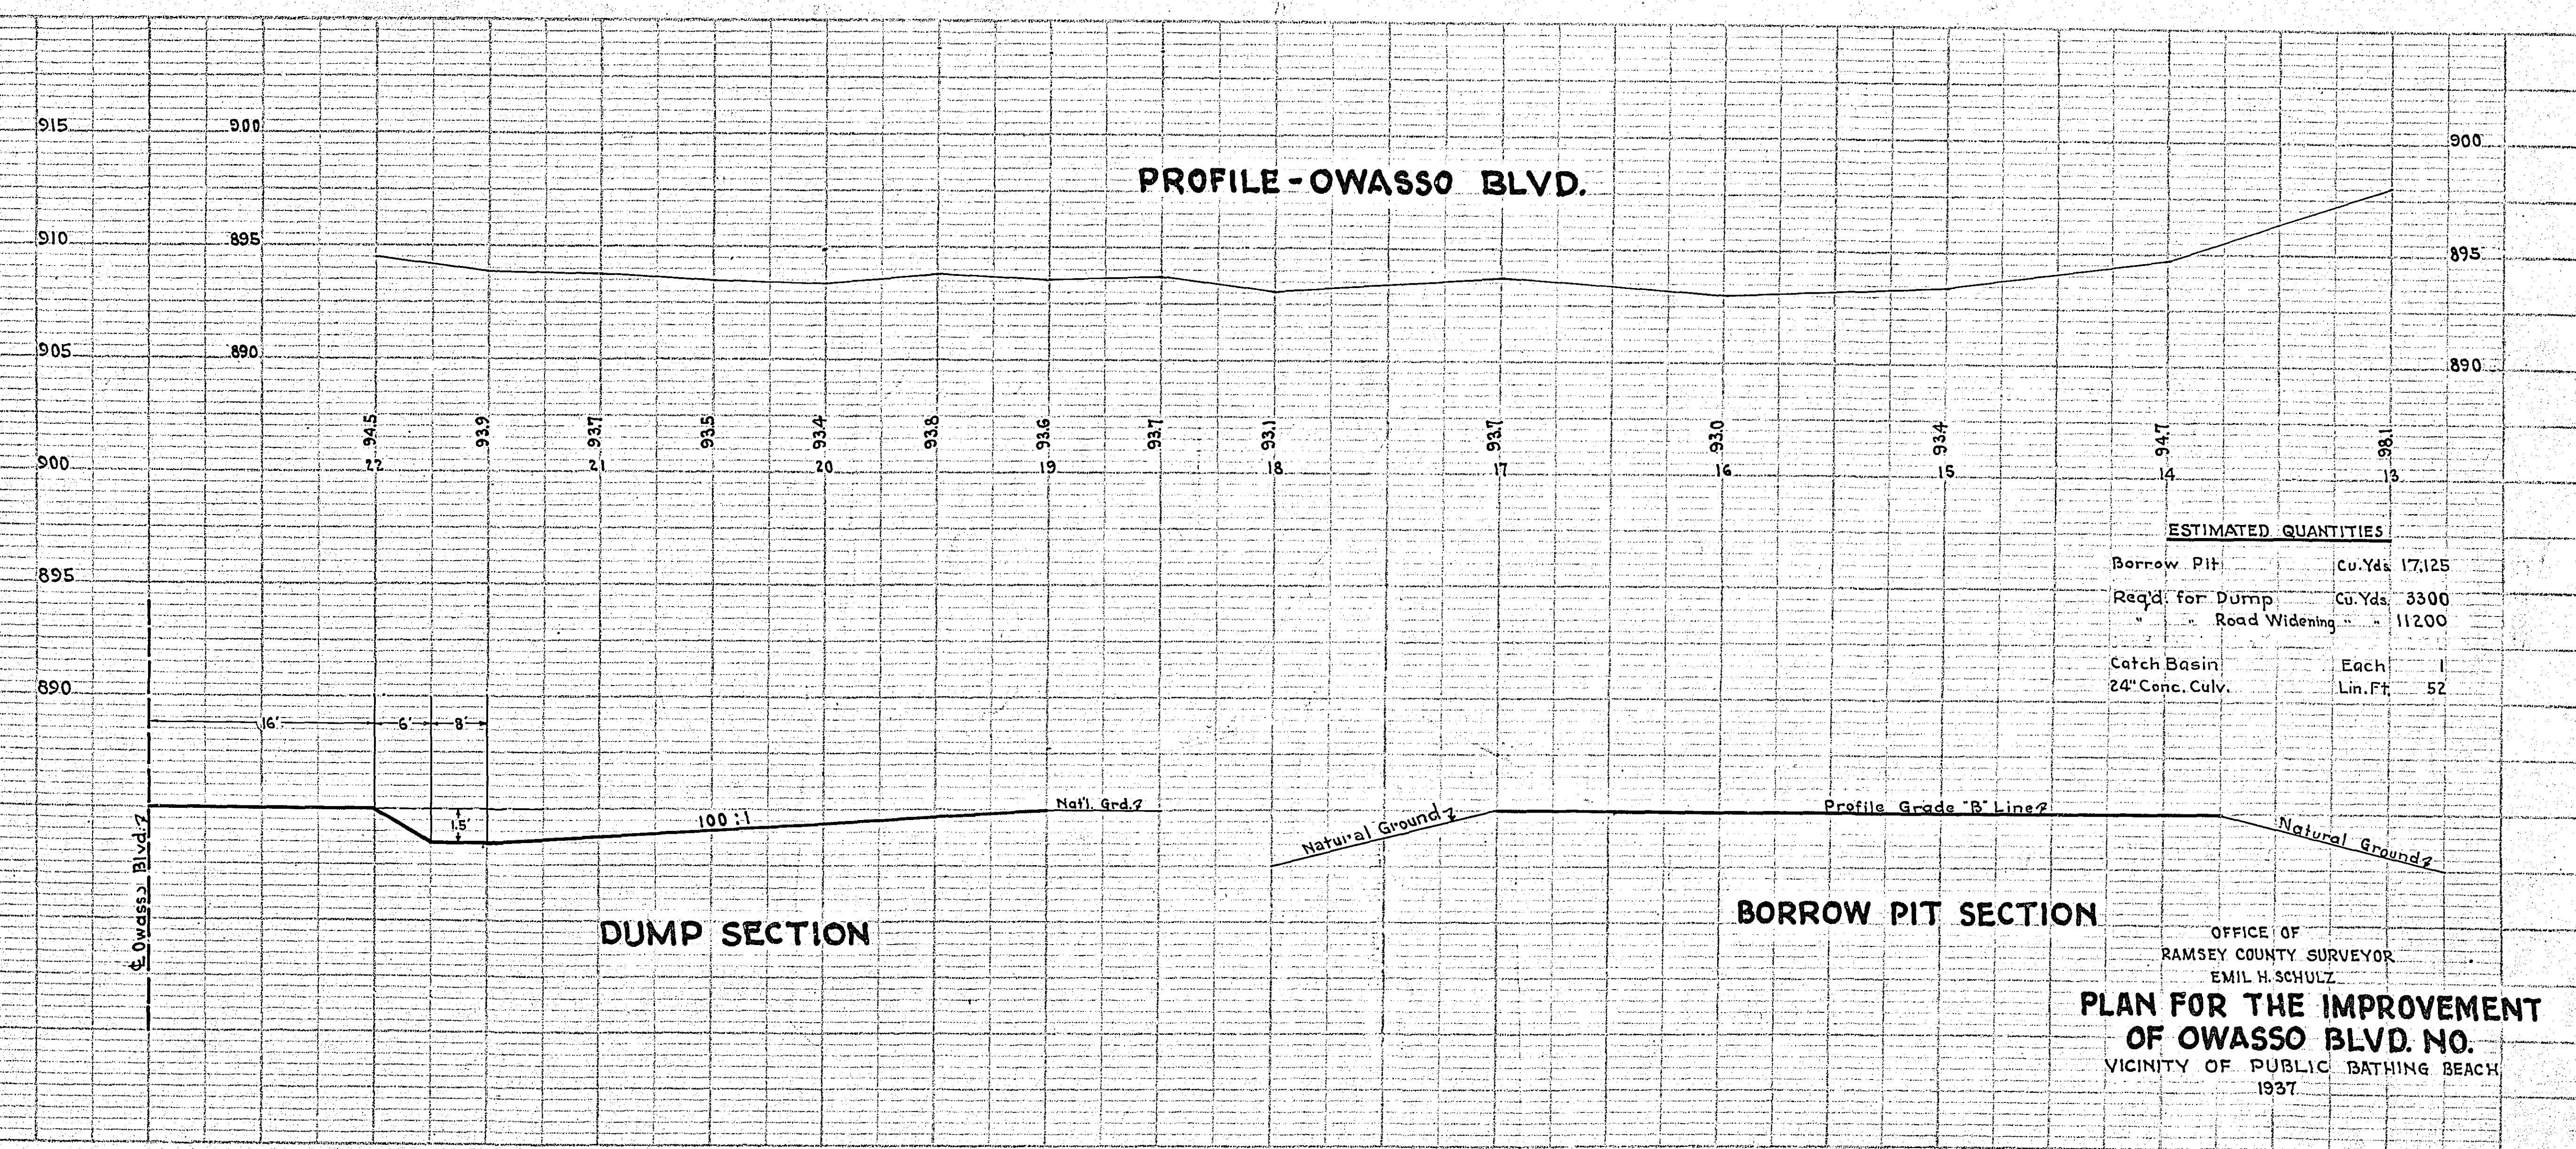

PLAN
 BOUNDARY
 NOTES BOOK
 NO.

PROFILE
 B.M. Spk. in 24" oak
 S.W. Cor. Park Triangle
 Elev. 892.35

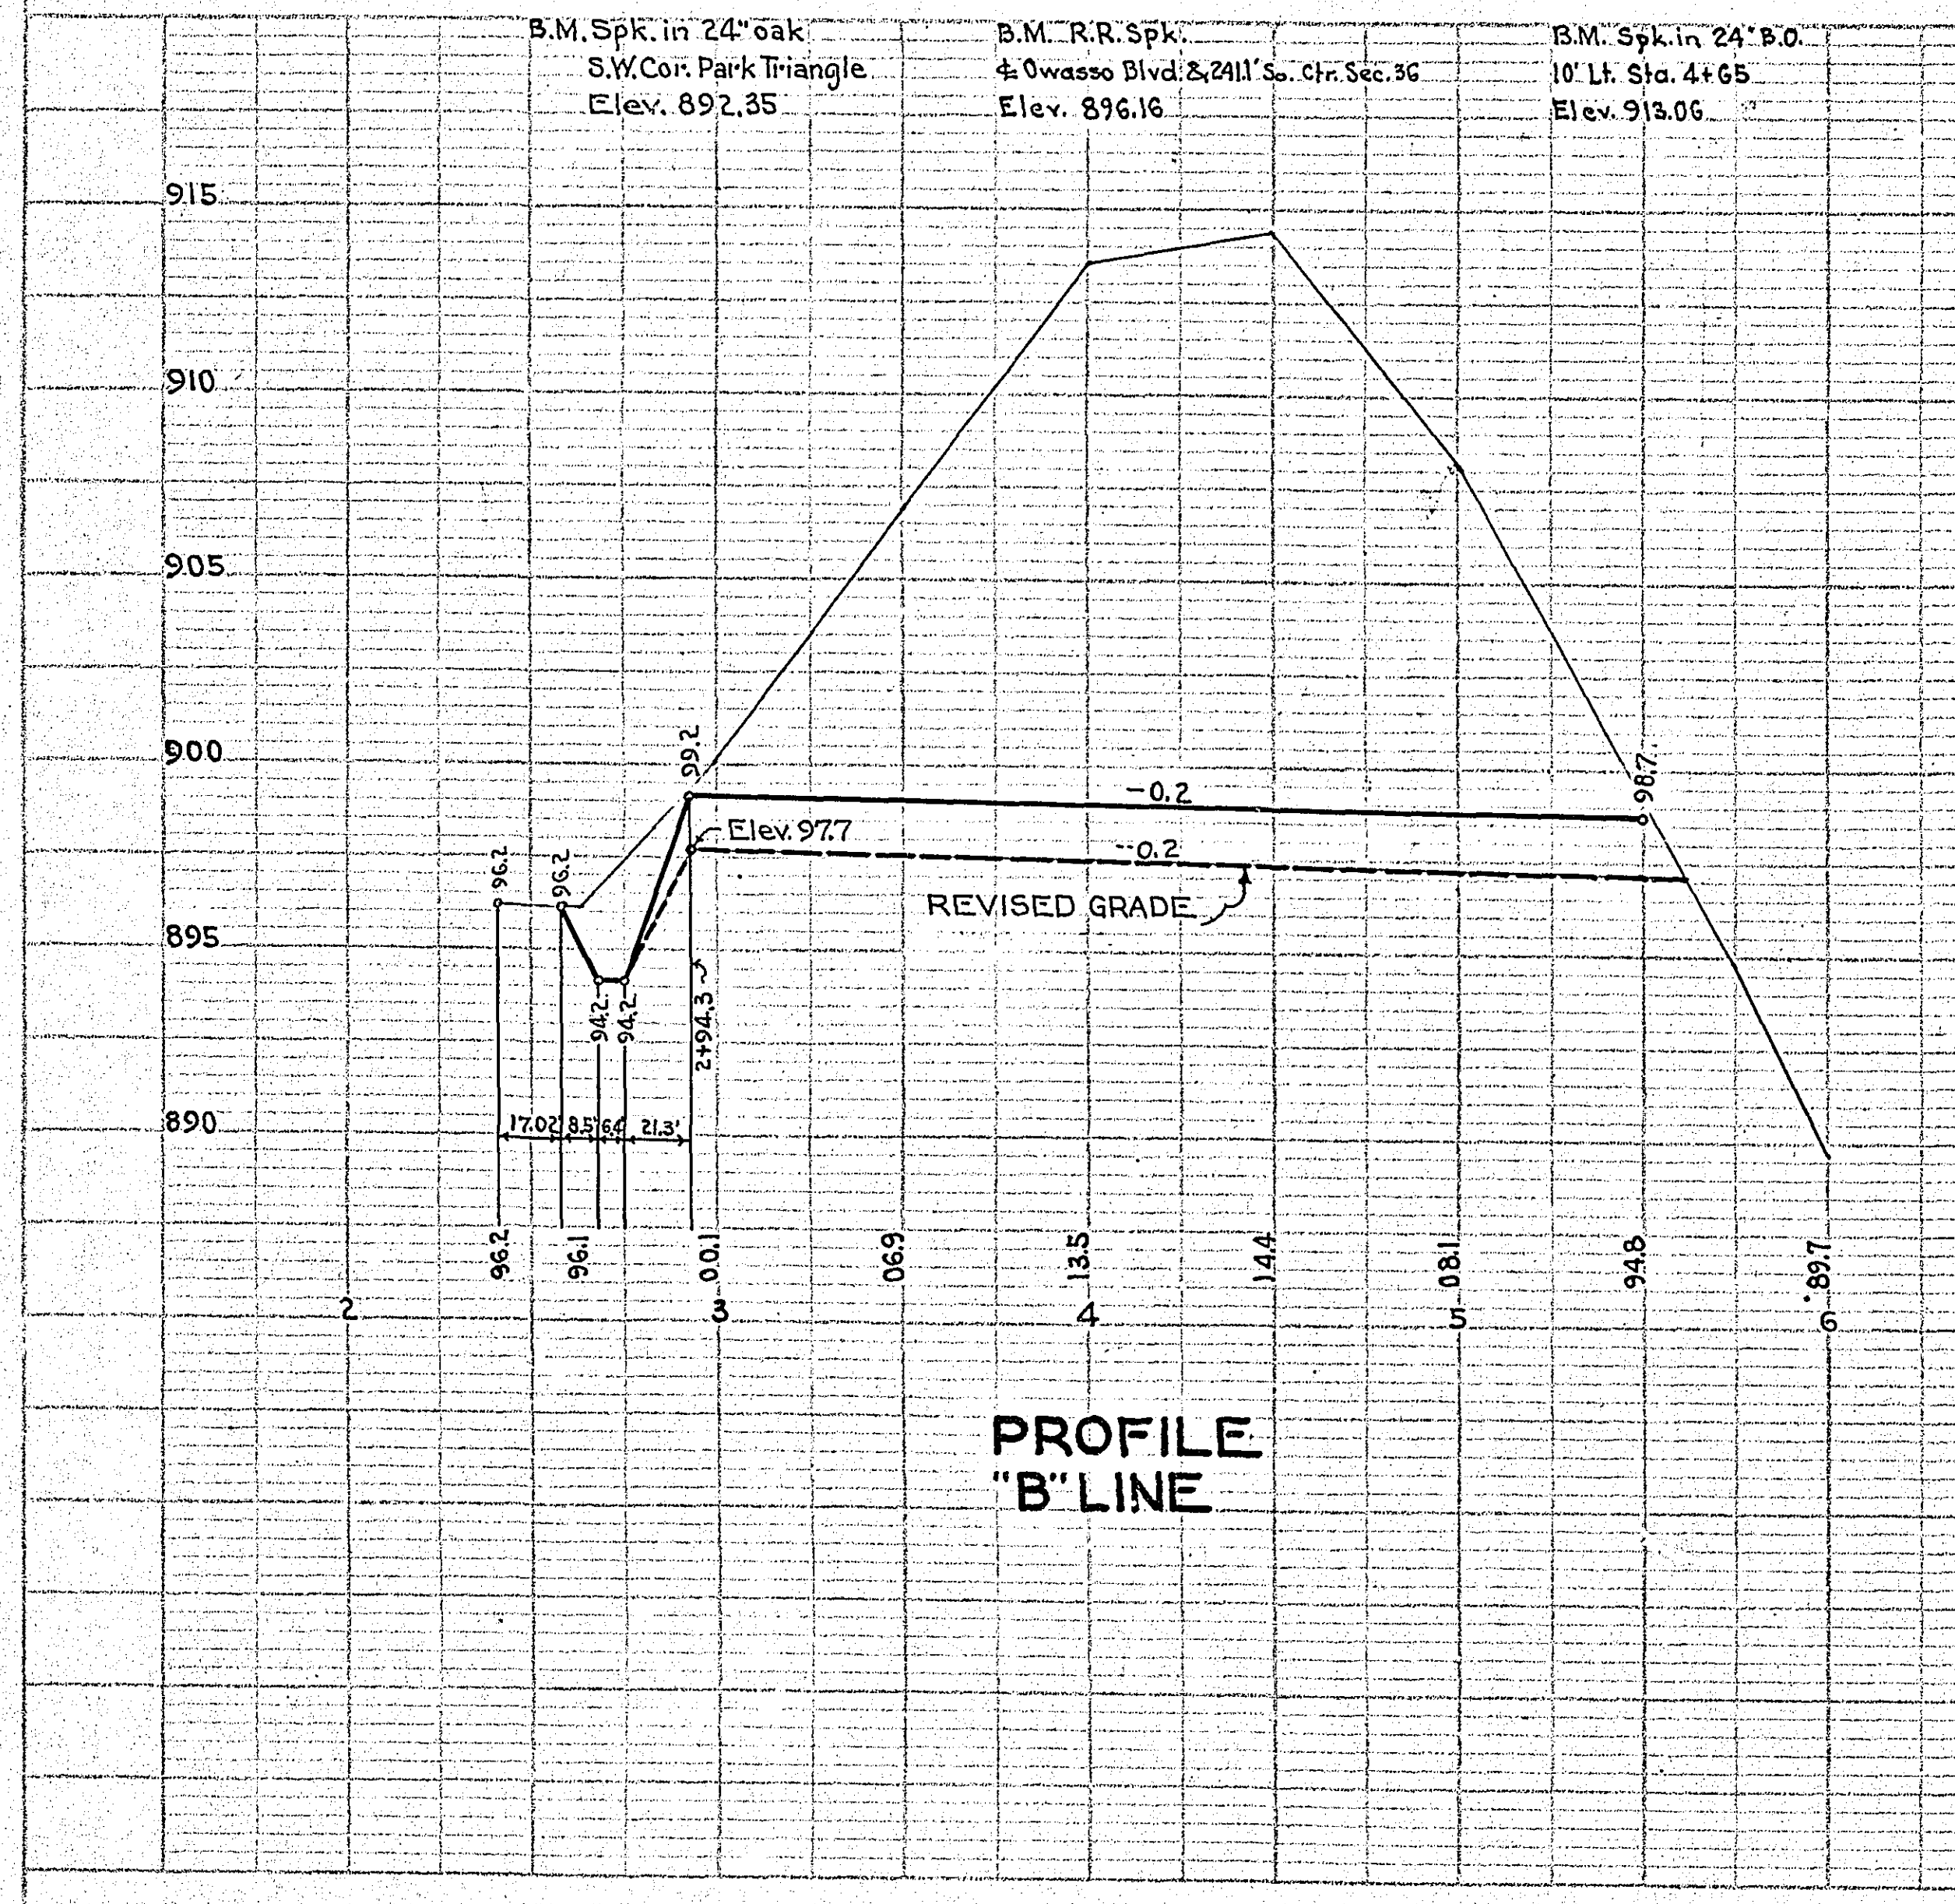

ESTIMATED QUANTITIES

Borrow Pit	Cu. Yds.	17,125
Req'd for Dump	Cu. Yds.	3300
Road Widening	"	11200
Catch Basin	Each	1
24" Conc. Culv.	Lin. Ft.	52

OFFICE OF
 RAMSEY COUNTY SURVEYOR
 EMIL H. SCHULZ
**PLAN FOR THE IMPROVEMENT
 OF OWASSO BLVD. NO.**
 VICINITY OF PUBLIC BATHING BEACH
 1937

