

PLAN	DATE
BY	
REVISIONS	
NO.	
NOTE BOOK	
ALIGNMENT CHECKED	
RT. OF WAY CHECKED	

PROFILE	DATE
BY	
REVISIONS	
NO.	
NOTE BOOK	
GRADES CHECKED	
B. M. NOTED	
STRUCTURE NOTATIONS CHECKED	

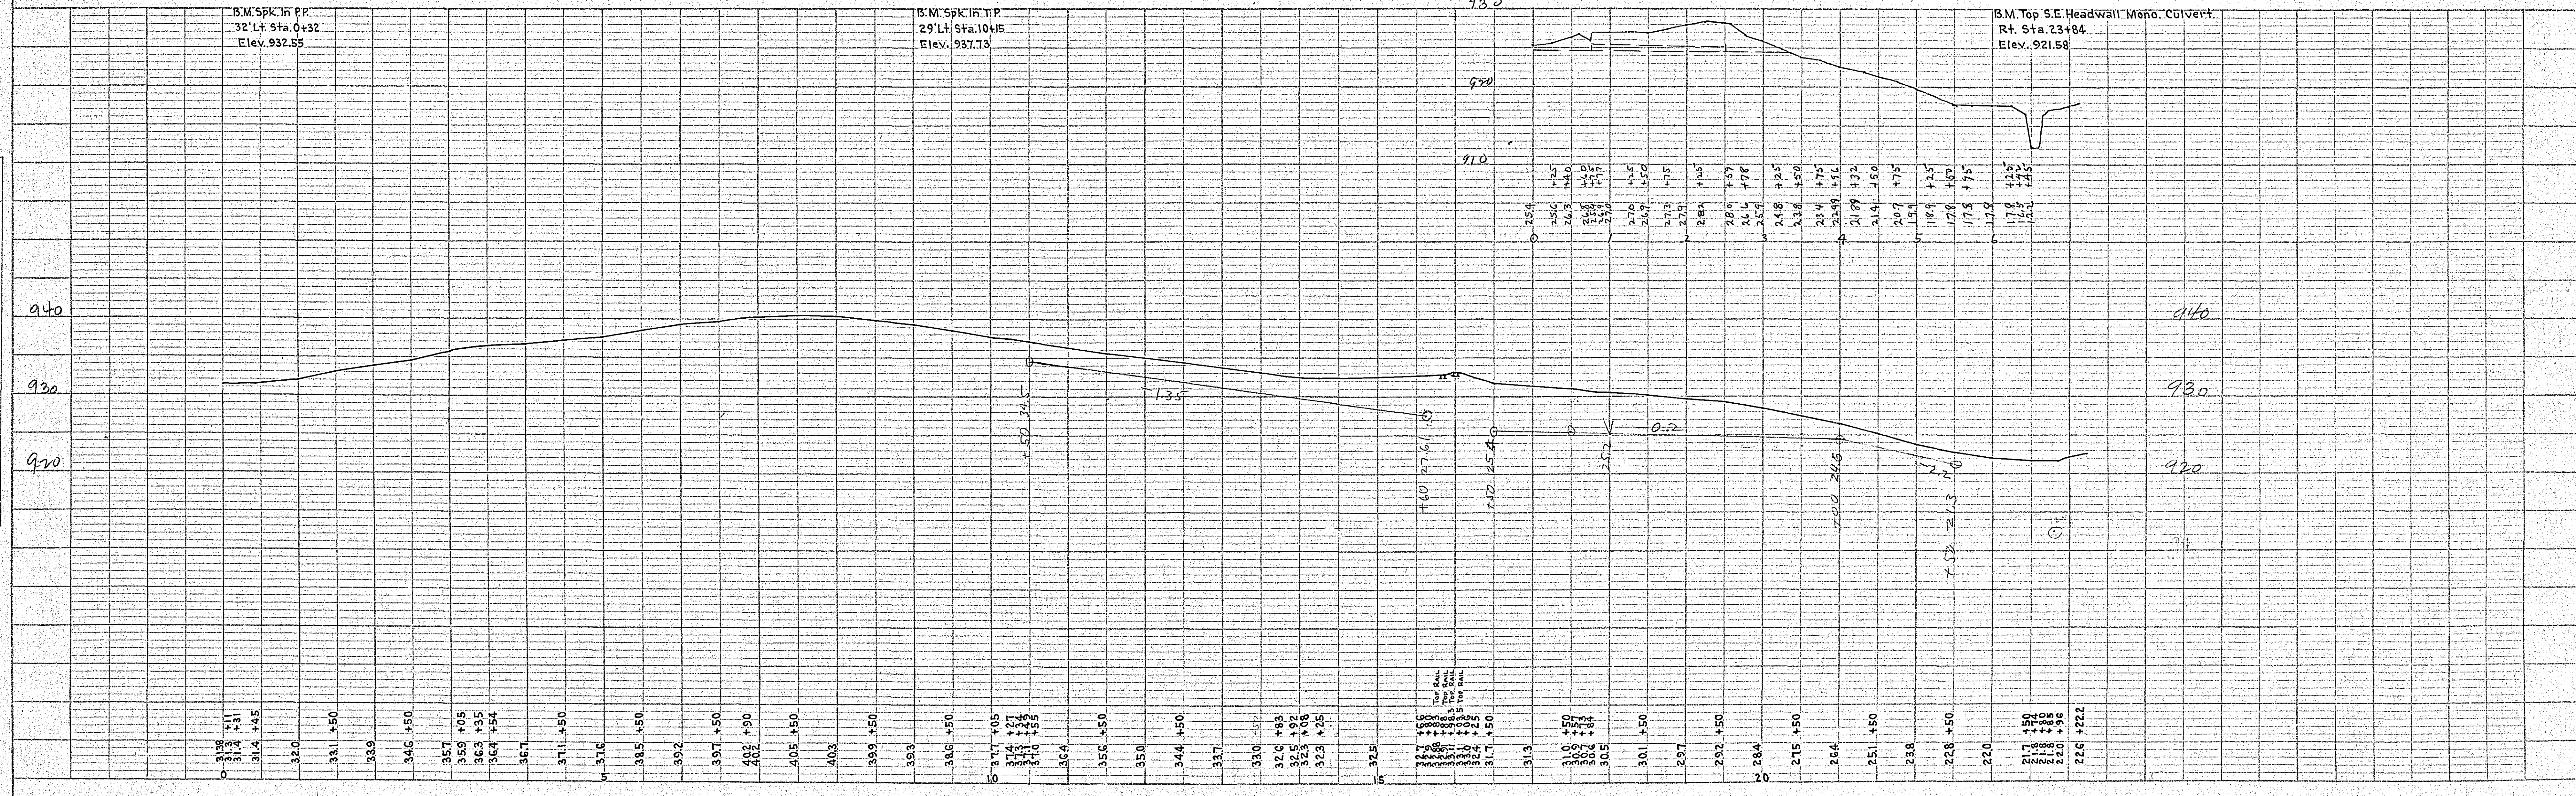
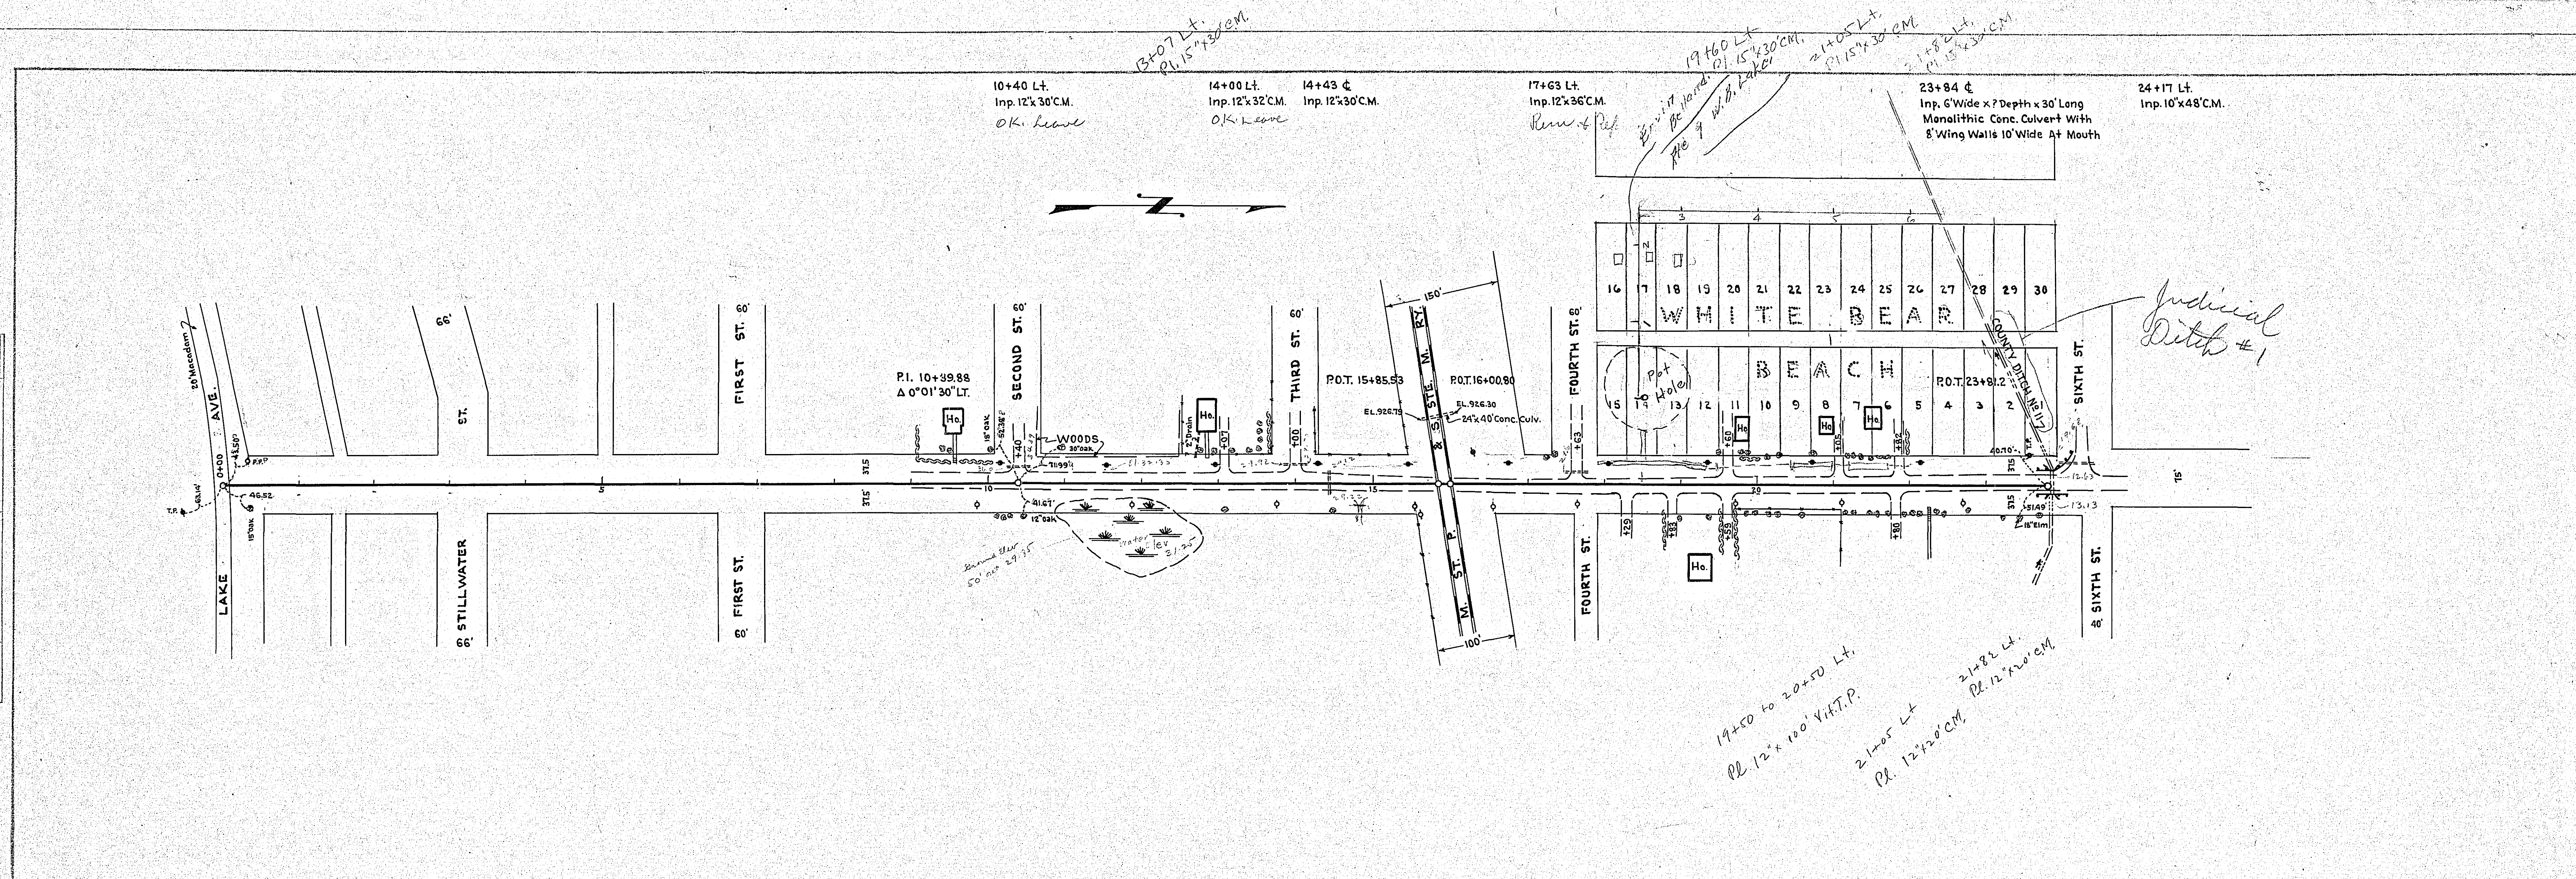


PLATE 1 - PLAN - PROFILE © P. R. & R. S. STANDARD  
KEUPPEL & ESSE, CO., NEW YORK