

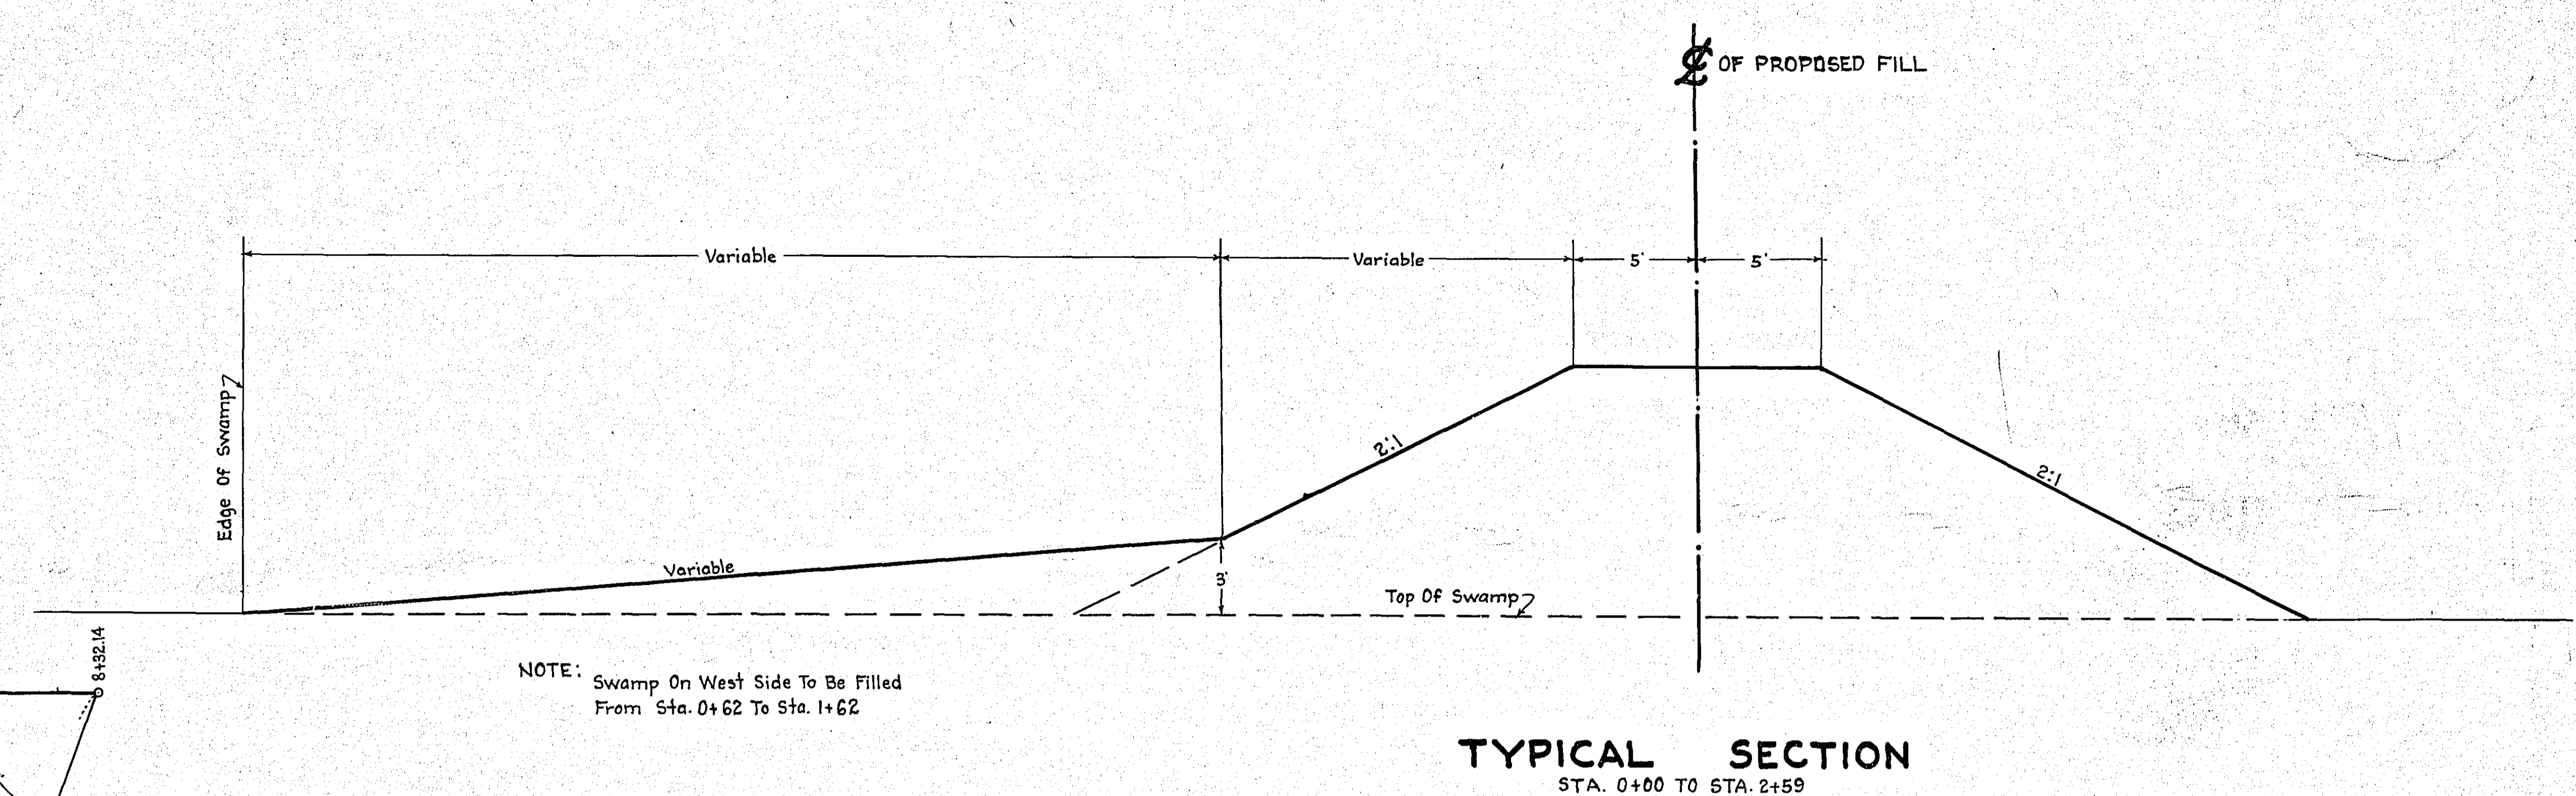


DATE	
BY	
SURVEYED	
PLOTTED	
ALIGNED CHECKED	
NOTE BOOK	
NO.	

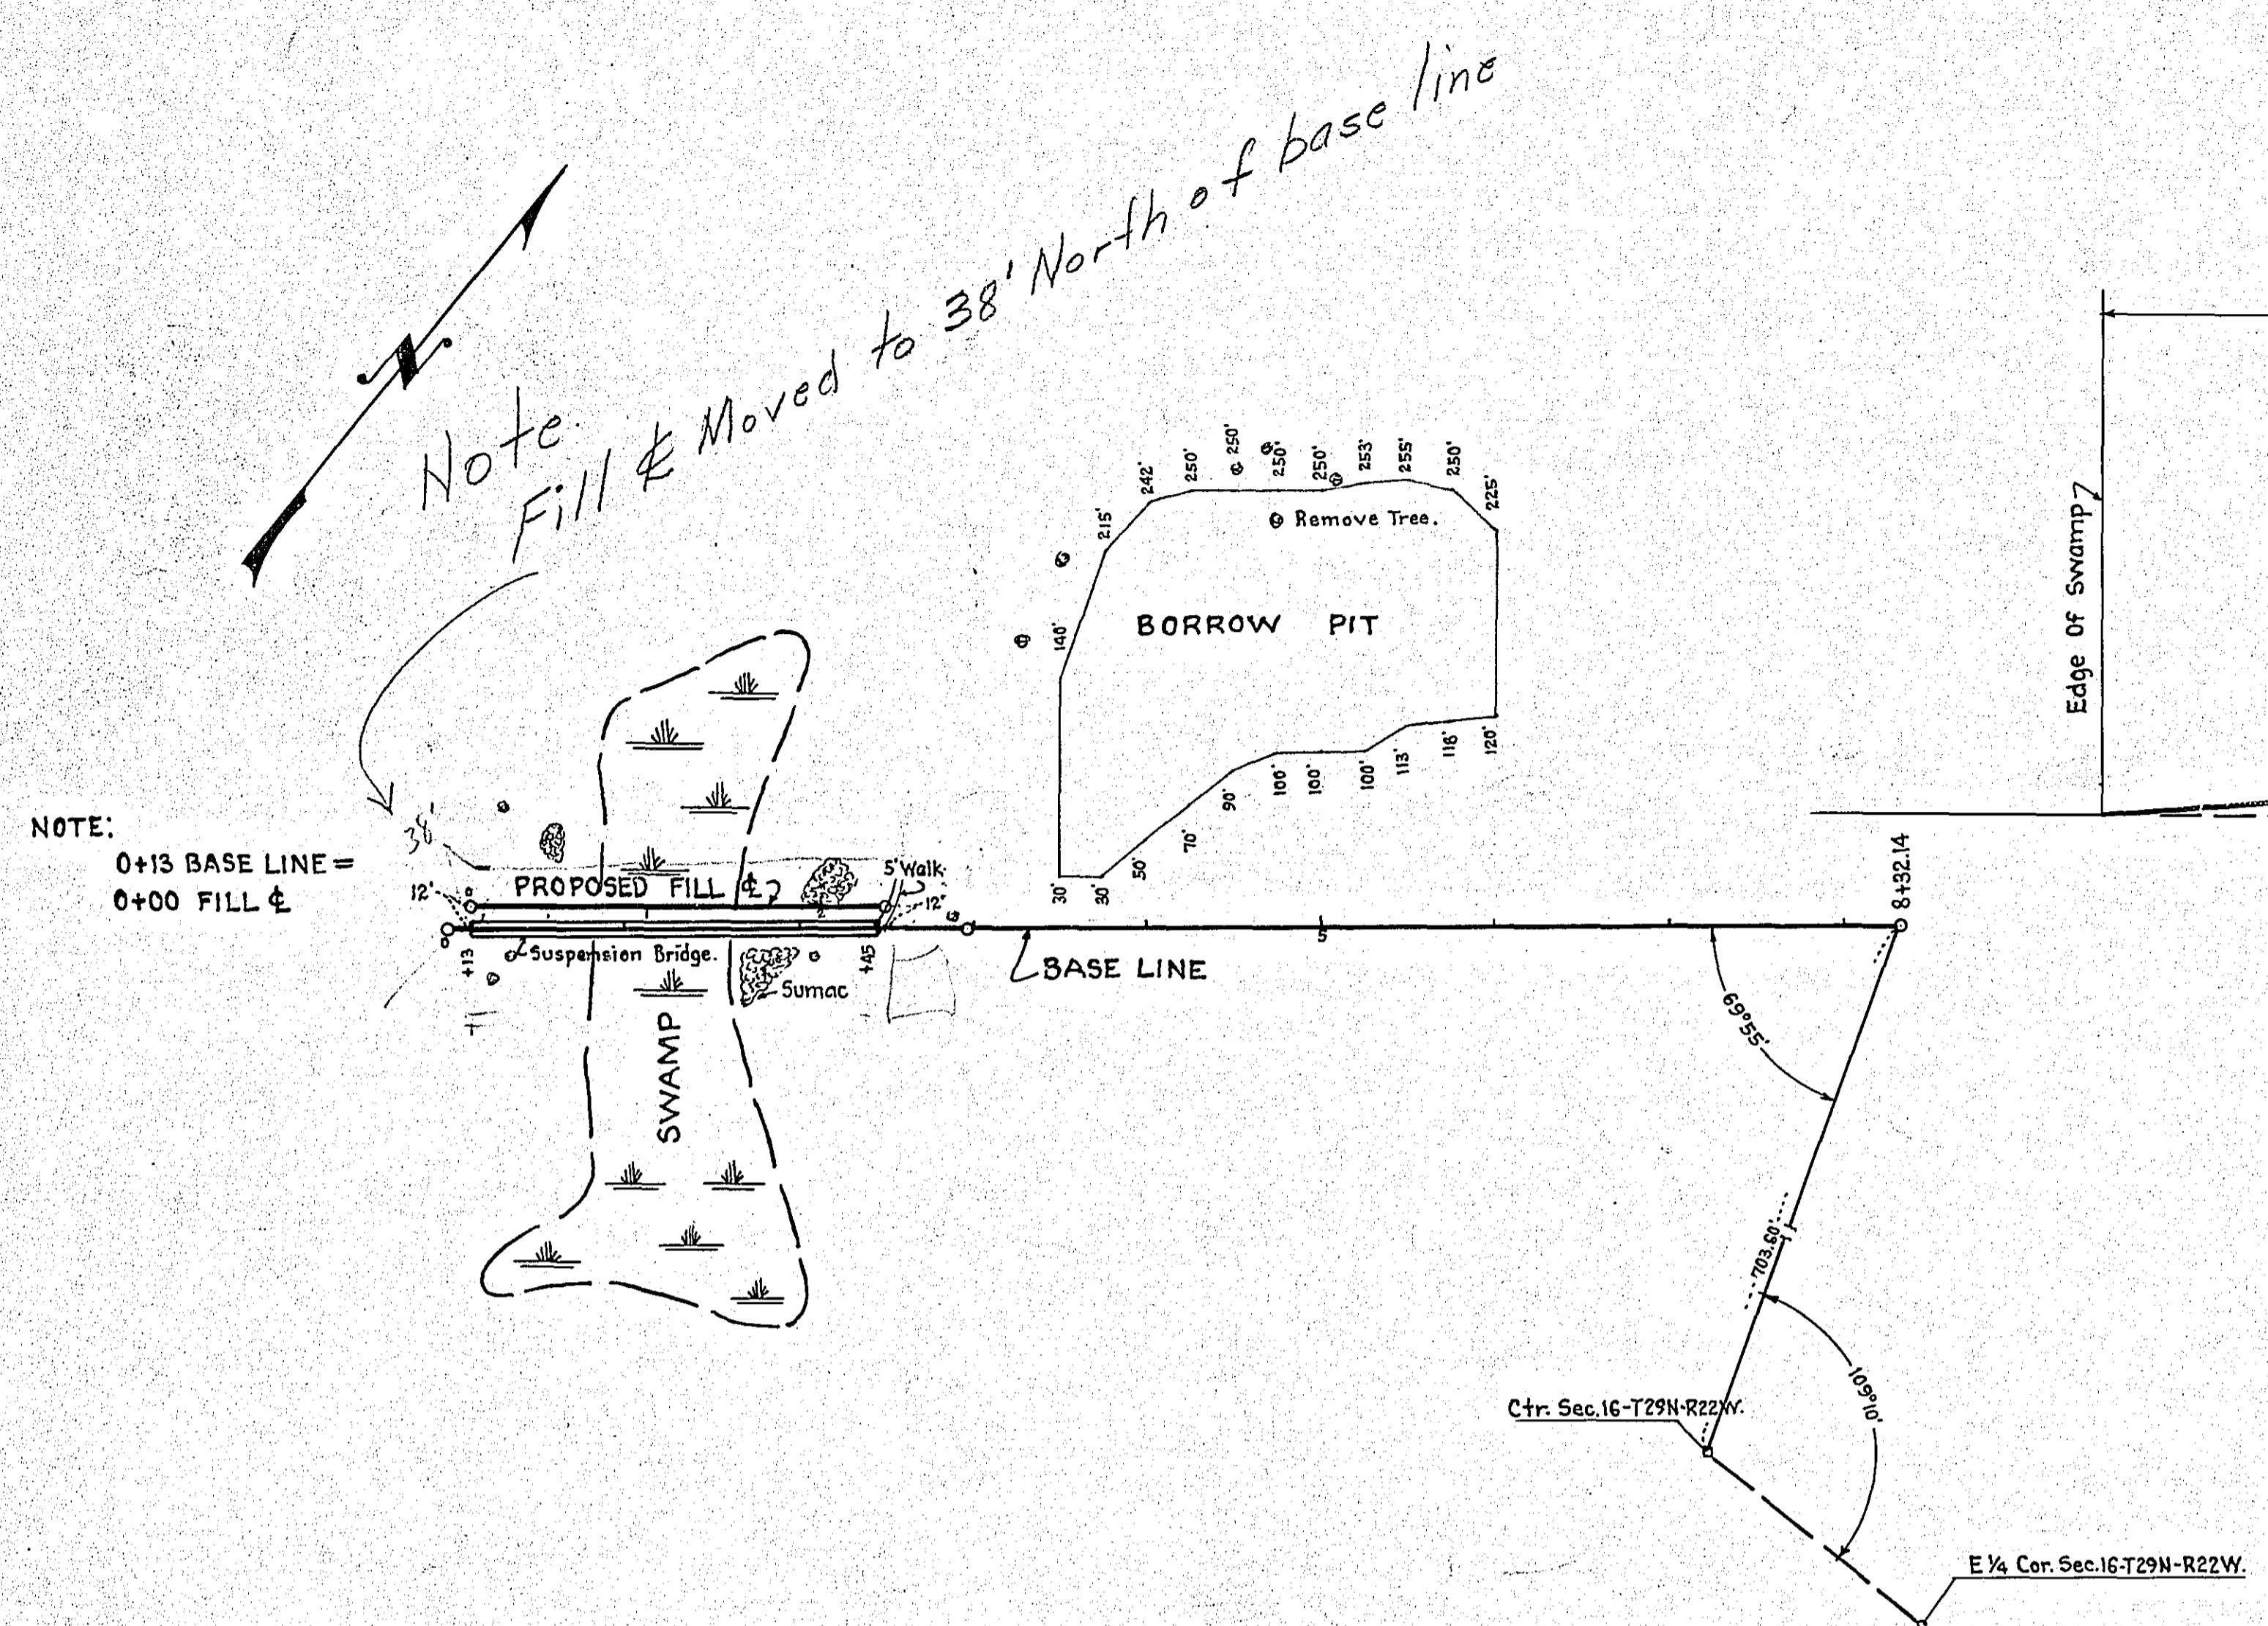

DATE	
BY	
SURVEYED	
PLOTTED	
GRADES CHECKED	
STRUCTURE NOTATION CHECKED	
NOTE BOOK	
NO.	

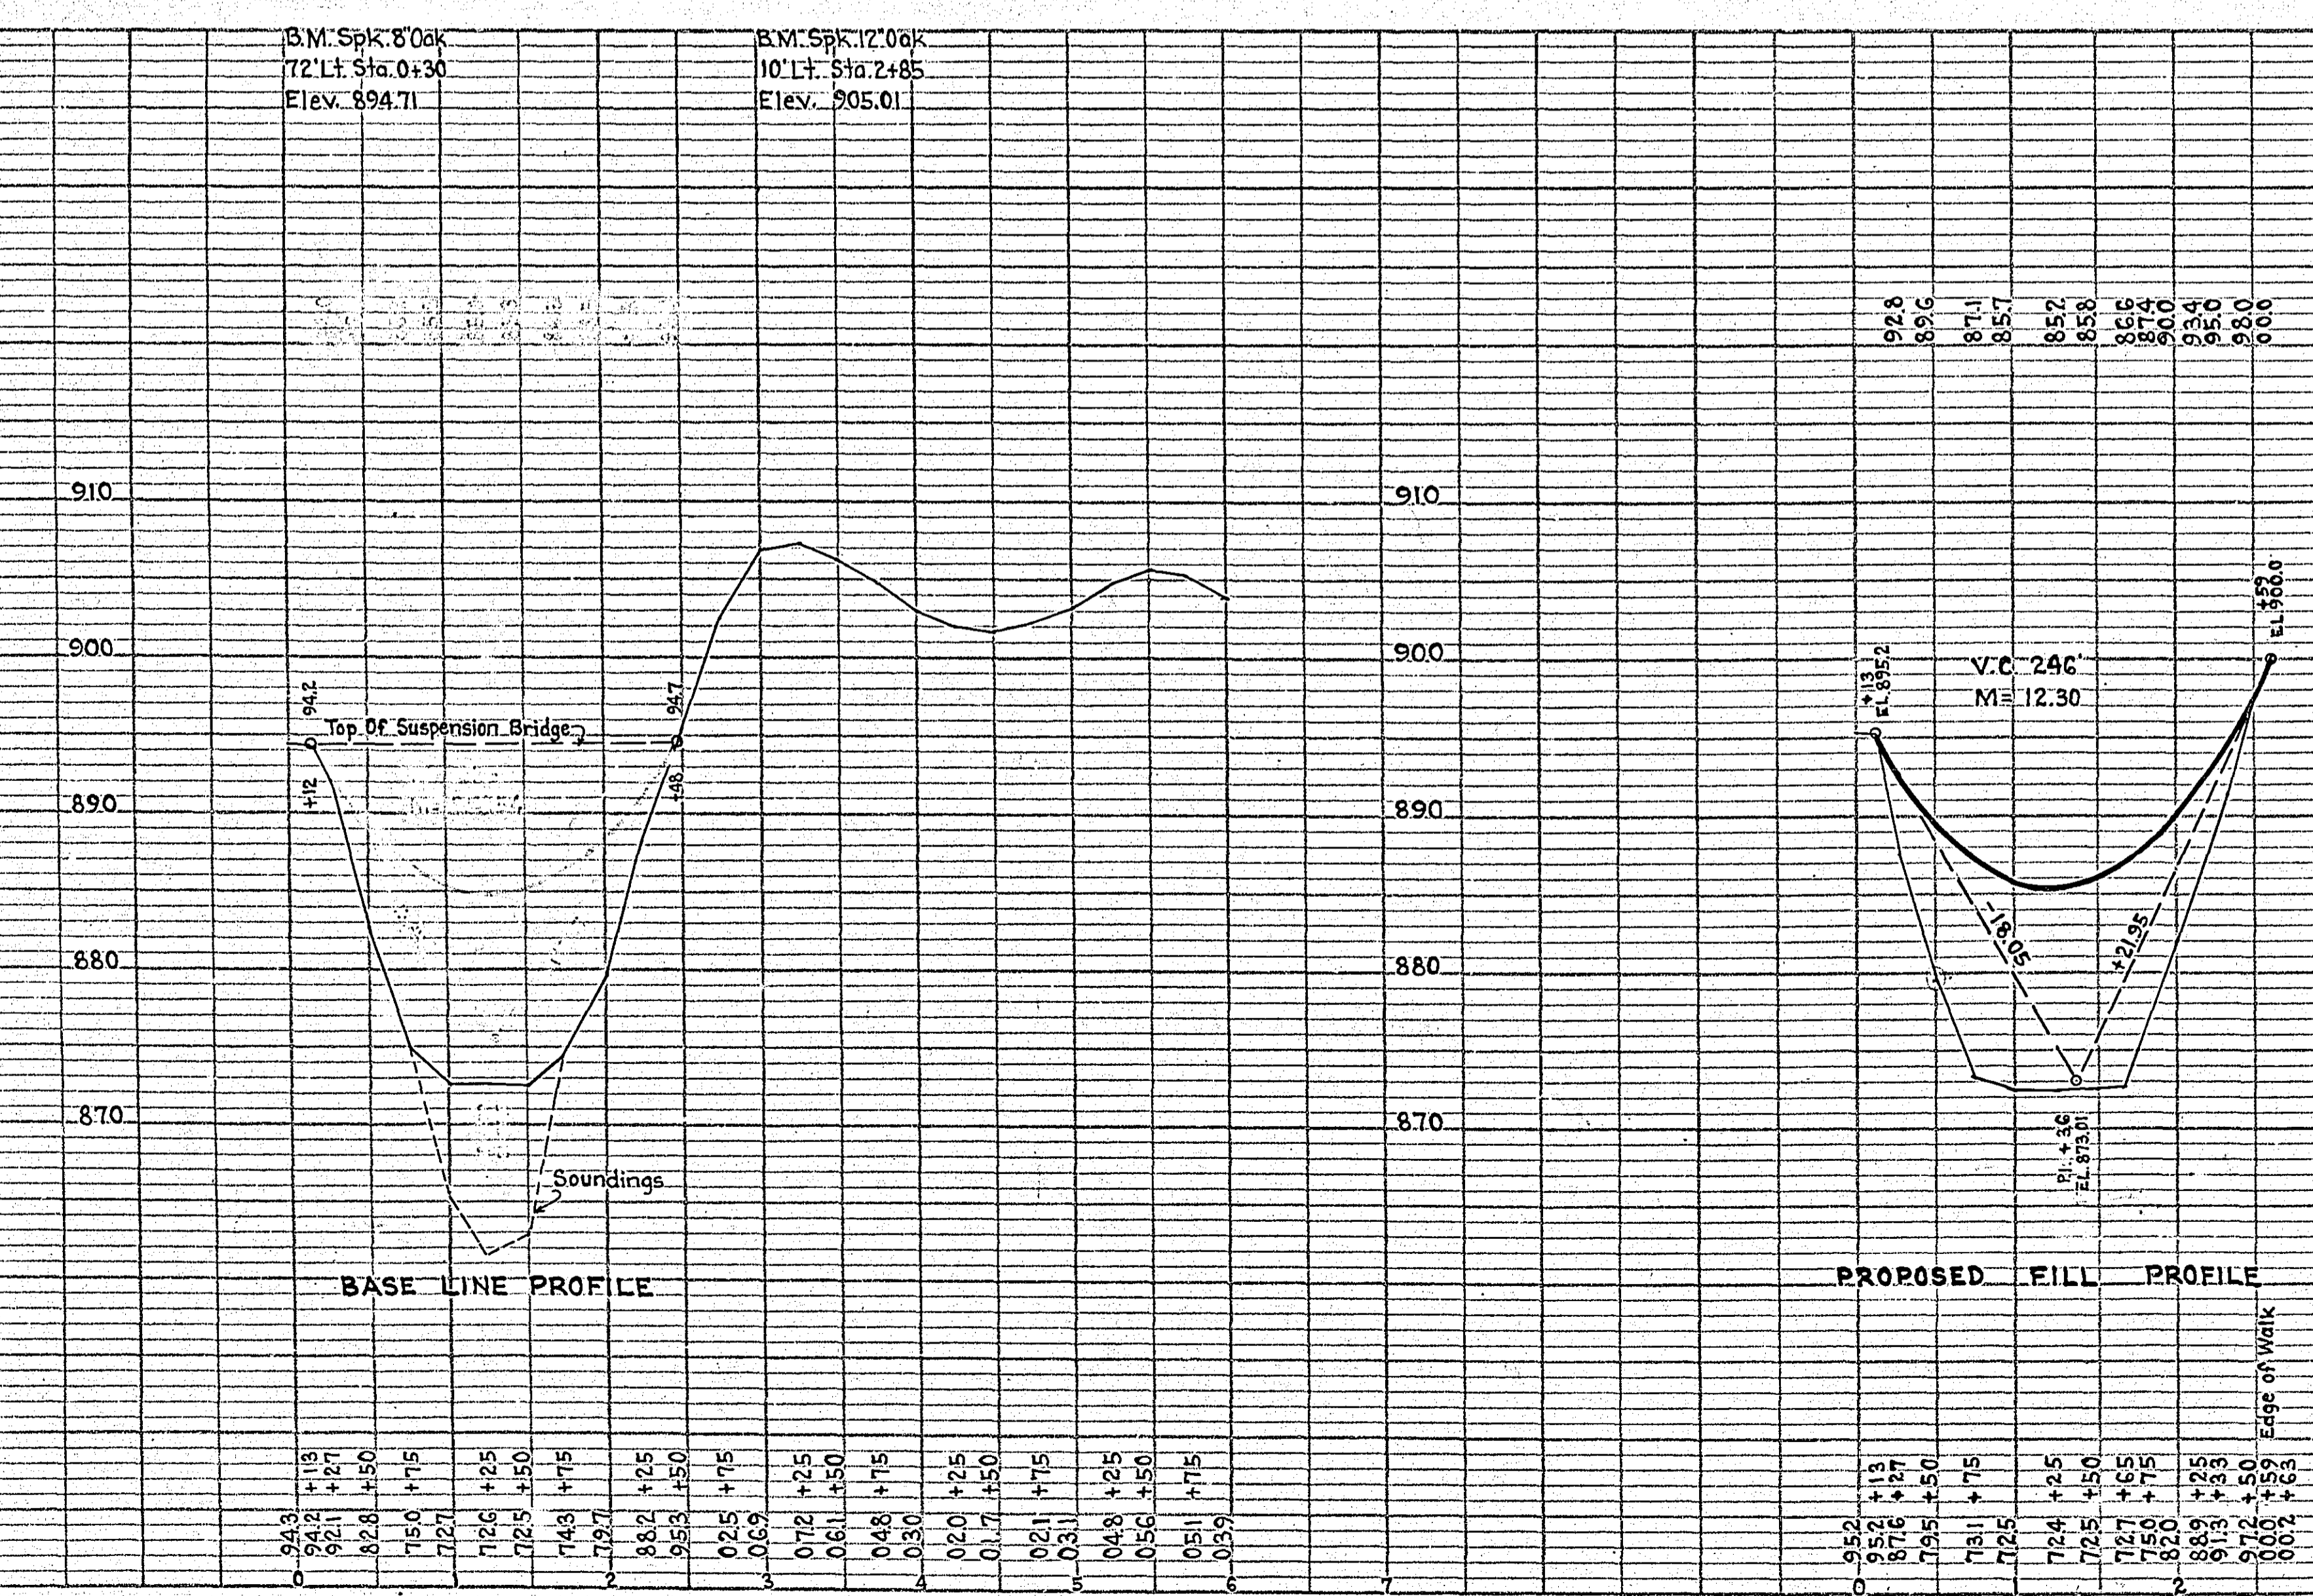

ESTIMATED QUANTITIES		
Excavation	Cu. Yds.	4.679
Gravel	"	16
Blacktop	Sq. Yds.	170
Clearing Trees	Each	1
Grubbing Trees	"	1
Sodding	Sq. Yds.	1000
Remove & Salvage	Ca.	1
Suspension Bridge		1

OFFICE OF
 RAMSEY COUNTY SURVEYOR
 HARRY S. BRONSON
 GRADING PLAN
KELLER GOLF COURSE
 FILL AT SUSPENSION BRIDGE
 APRIL 1940
 SCALE AS SHOWN
 PLANS APPROVED 4/19 1940
Harry S. Bronson
 COUNTY SURVEYOR