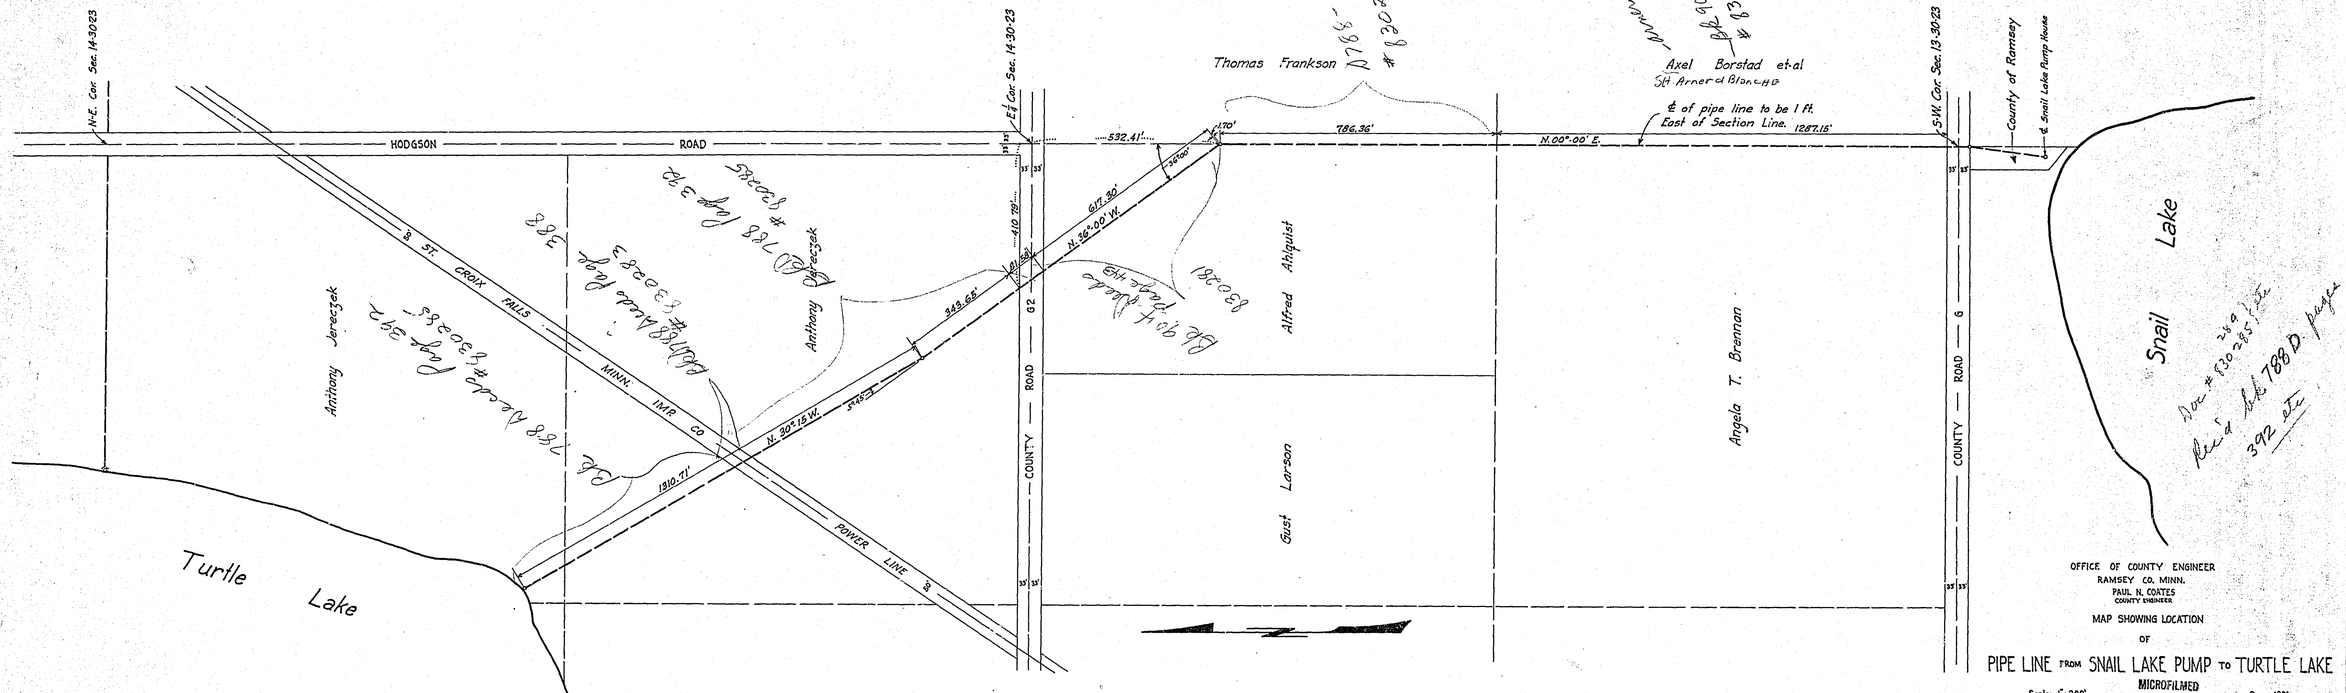

OFFICE OF COUNTY ENGINEER
RAMSEY CO. MINN.
PAUL N. COATES
COUNTY ENGINEER

MAP SHOWING LOCATION
OF
PIPE LINE FROM SNAIL LAKE PUMP TO TURTLE LAKE

Scale: 1" = 200'

MICROFILMED
RAMSEY CO. ENGR.

Dec. 1931