
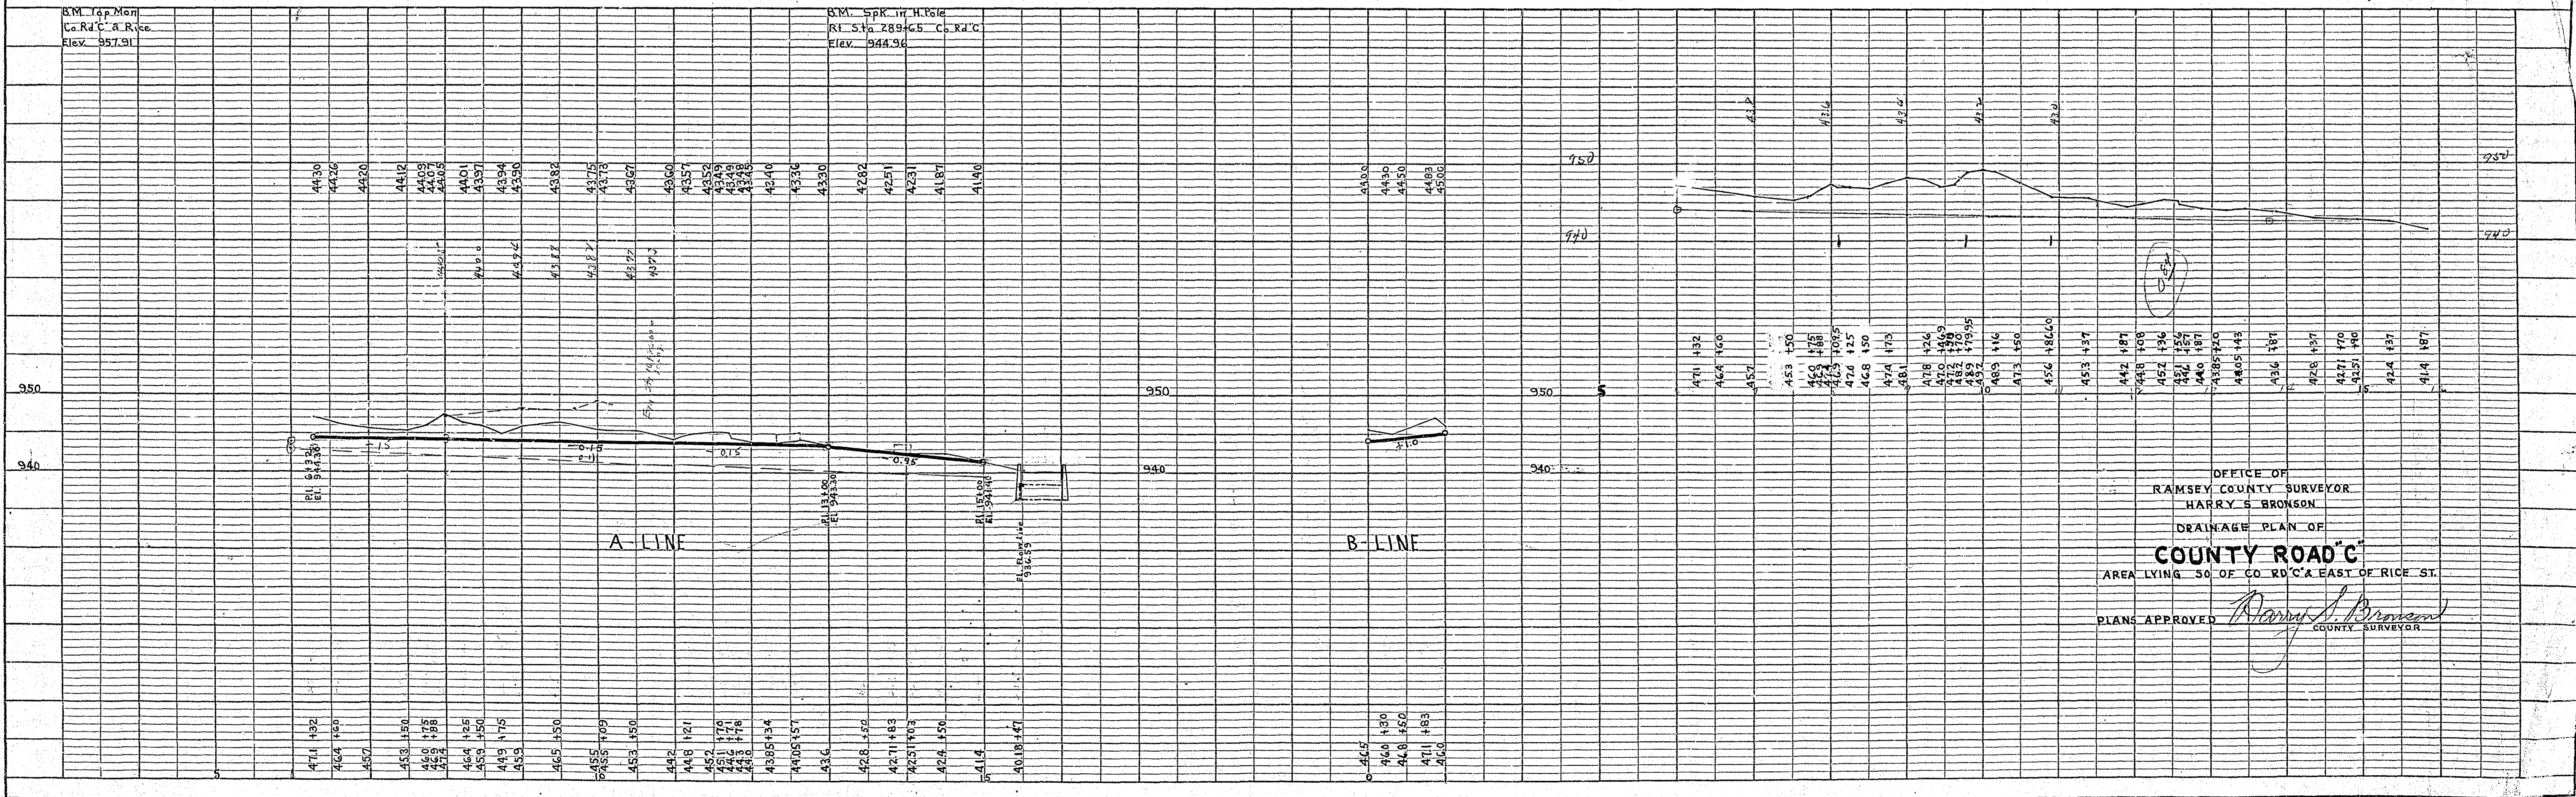


PLAN	DATE
BY	
REVISIONS	
PLOTTED	
ALIGNMENT CHECKED	
RT. OF WAY CHECKED	
NOTE BOOK	
NO.	

PROFILE	DATE
BY	
REVISIONS	
PLOTTED	
GRADES CHECKED	
E. M. S. NOTED	
CONTRIBUTOR NOTED (S. CHAD)	
NOTE BOOK	
NO.	

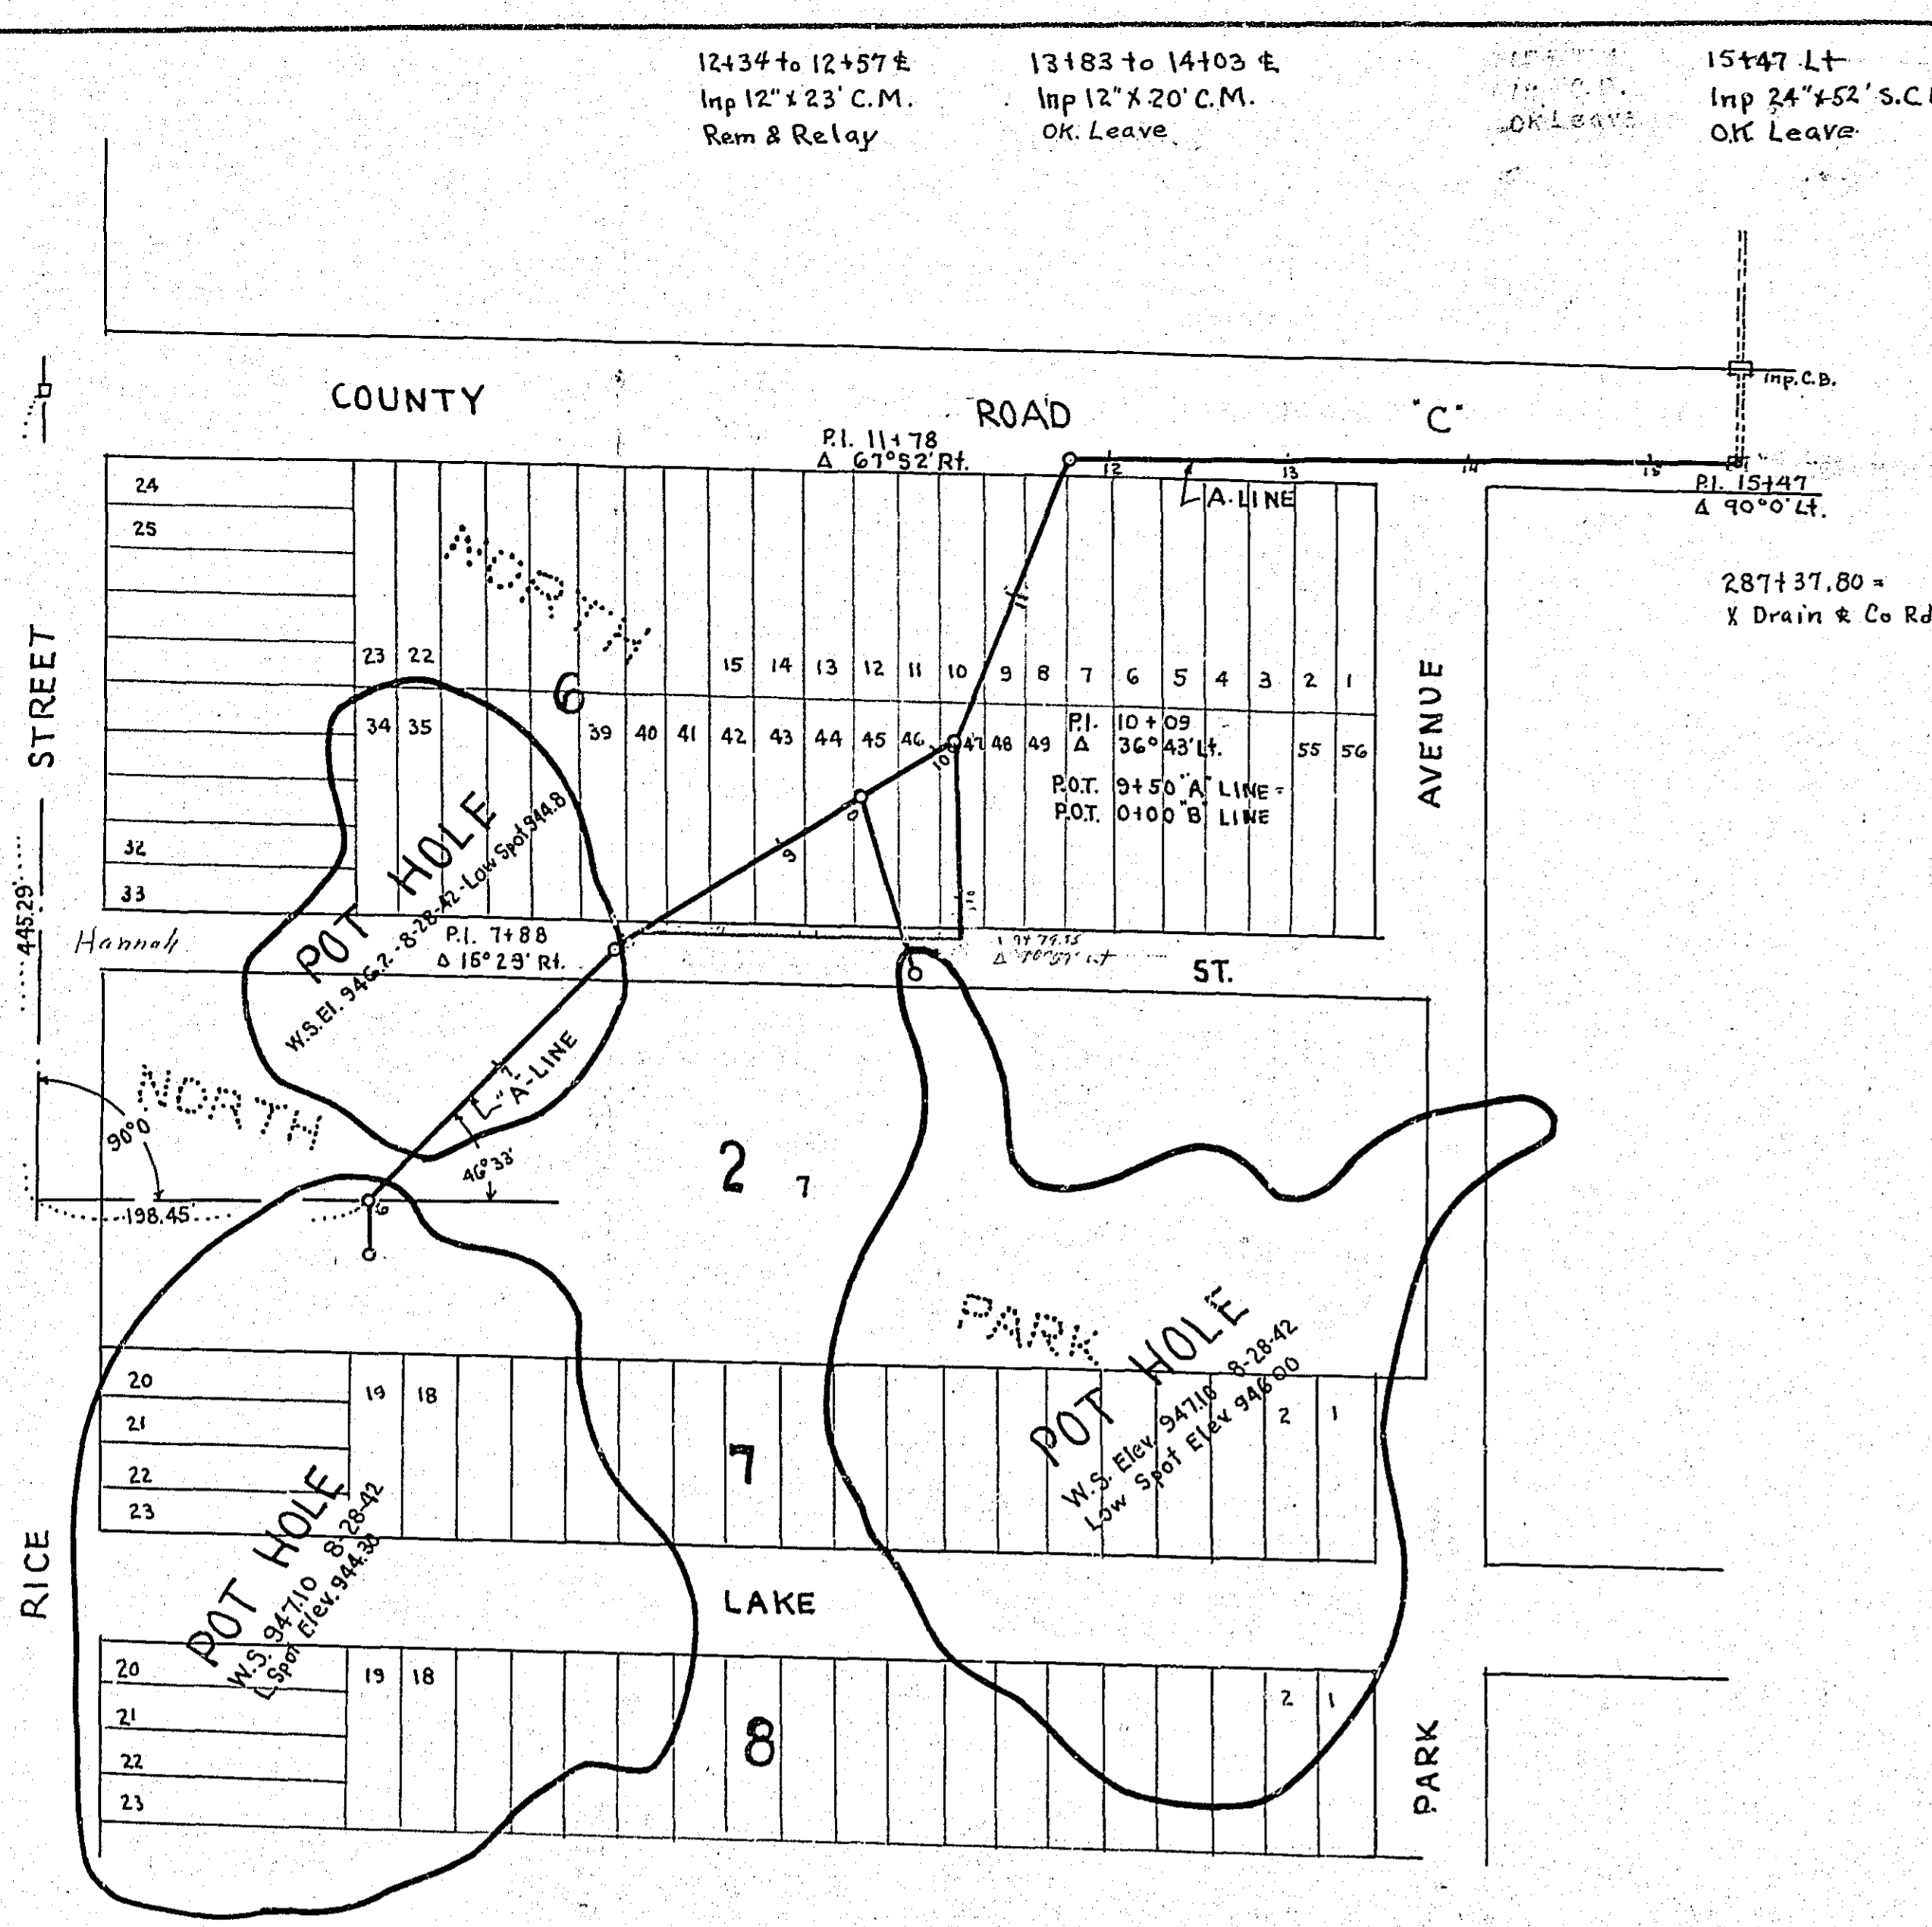

OFFICE OF
 RAMSEY COUNTY SURVEYOR
 HARRY S. BRONSON
 DRAINAGE PLAN OF
COUNTY ROAD C
 AREA LYING 50' OF CO. RD' C' EAST OF RICE ST.
 PLANS APPROVED *Harry S. Bronson*
 COUNTY SURVEYOR