

126+23 & Approx. & Labore Road

127+38 & Labore Ave.

DITCH LEFT

DITCH RIGHT

160+41.22 & Co. Rd. 110

3504

194

PLAN	DATE
SURVEYED	BY
PLOTTED	BY
NOTE BOOK	NO.
ALLOTTED	NO.
CHECKED	NO.
RT. OF WAY CHECKED	NO.

PROFILE	DATE
SURVEYED	BY
PLOTTED	BY
NOTE BOOK	NO.
ALLOTTED	NO.
CHECKED	NO.
STRUCTURE NOTATION CHYD	NO.

Place stake in E of existing ditch Rt. & Lt.

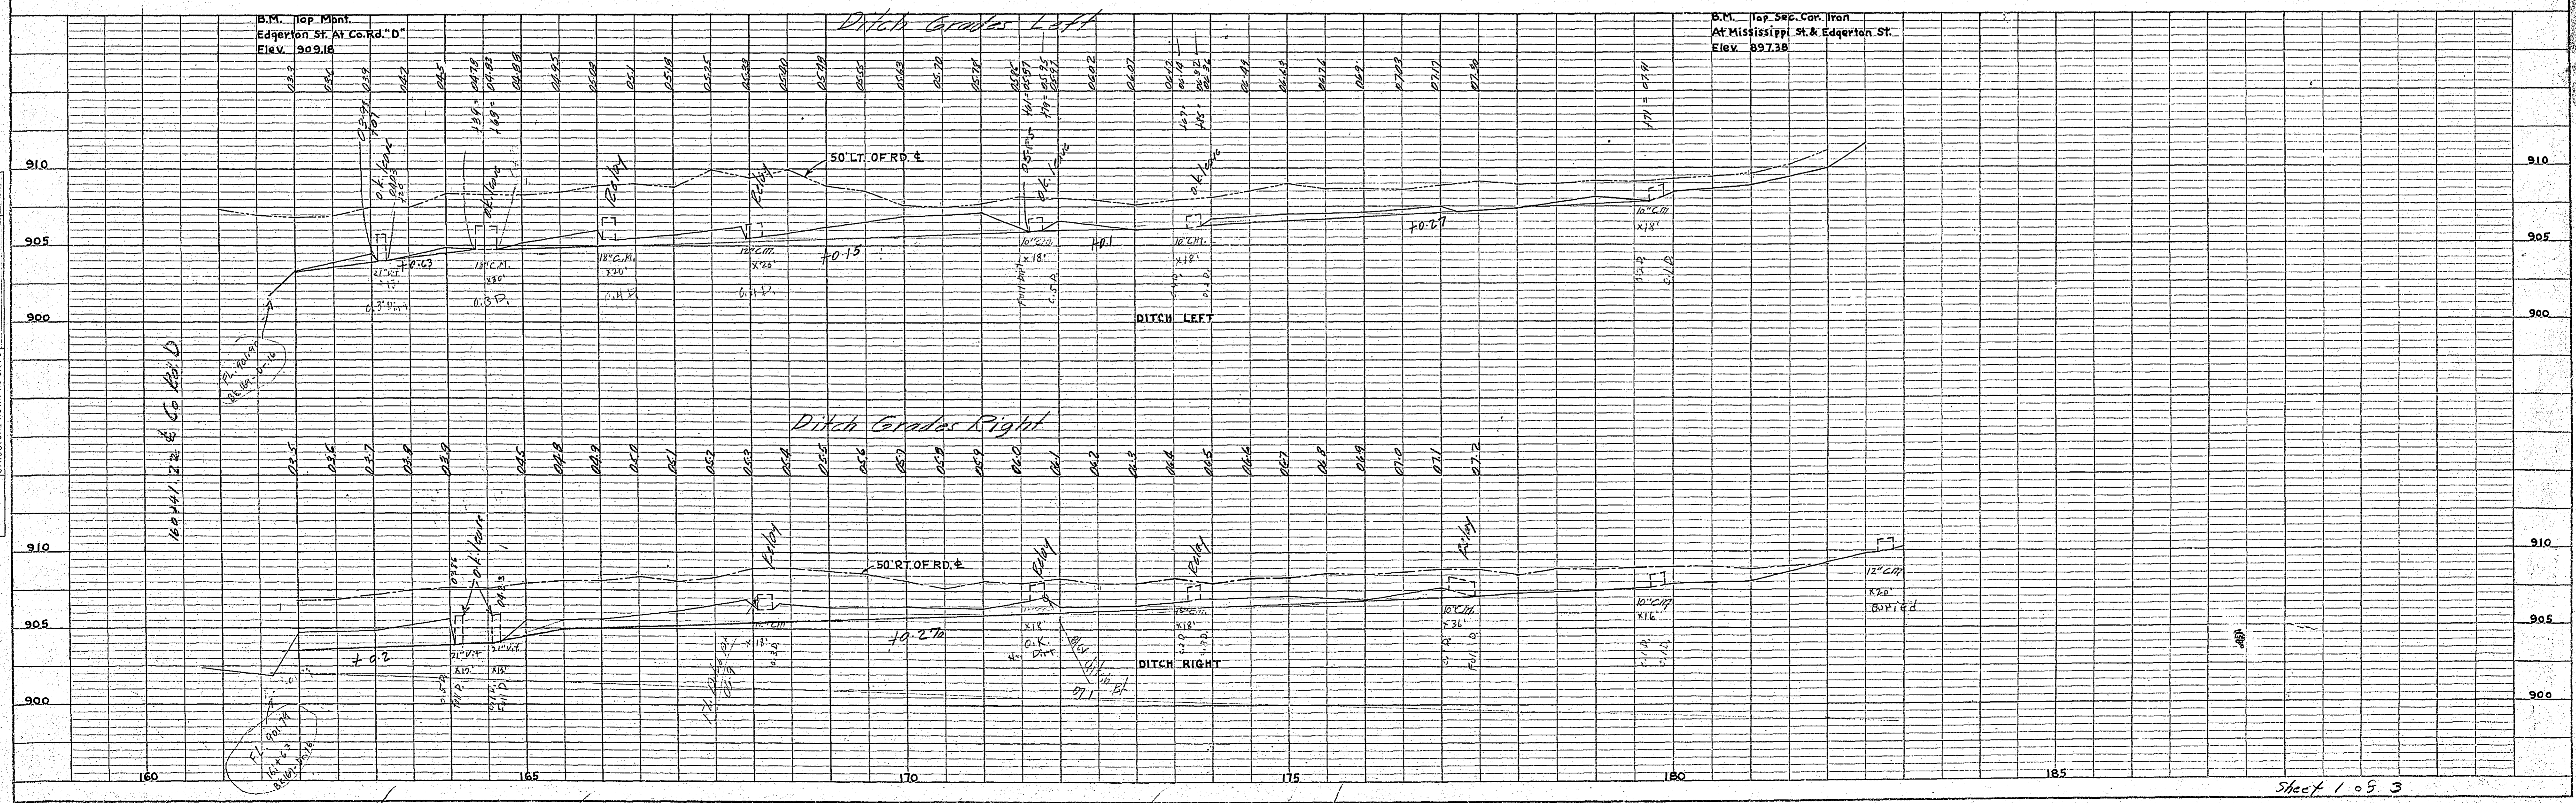
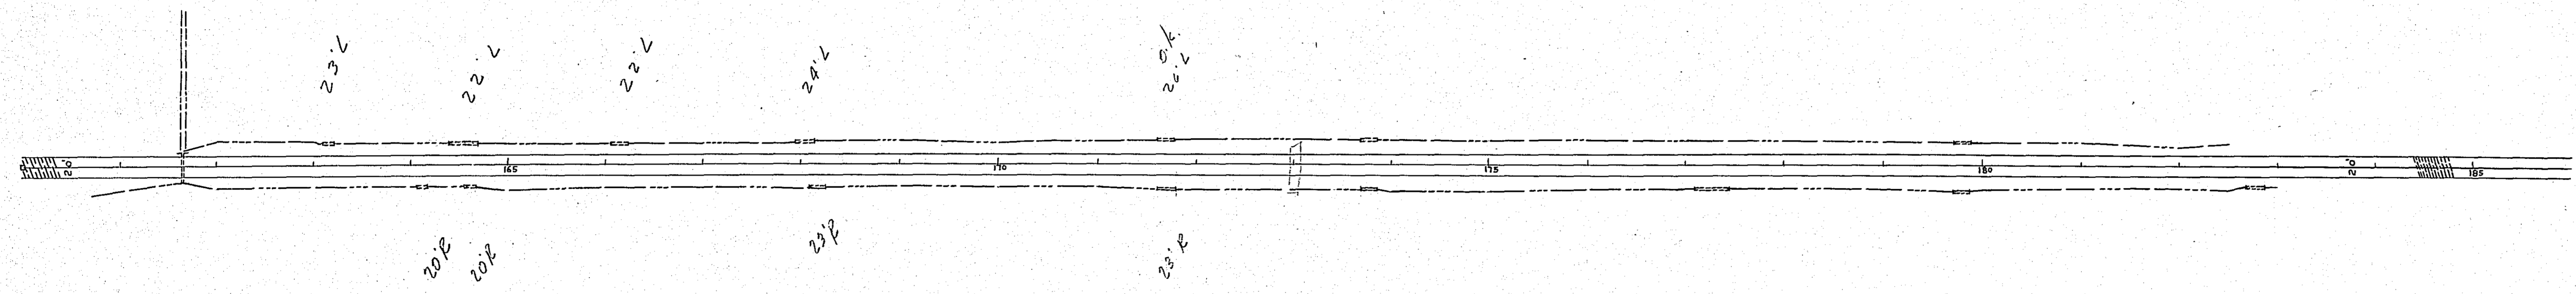


PLATE I - PLAN - PROFILE O. P. & R. E. STANGARD KEUFFEL & ESSER COMPANY NEW YORK

K & E CO. No. 345-1

Sheet 1 of 3

Edgerton St. Co. Rd. "D" - North