

Sta. 66+39 Rt. 33'
In P. 15" x 22' C.M.

GERVAIS LAKE
Water Surface Elev. 858.30 9/11/48



P.I. 67+92.55
Δ 4° 17' Lt.
D 2° 00'
T 107.15'
L 214.17'

P.I. 64+33.97
D 23° 12' Rt.
T 138.50'
L 272.94'



PLAN SURVEYED BY DATE
PLOTTED BY
NOTE BOOK NO. CHECKED BY
FT. OF ANY CHECKED BY

PROFILE SURVEYED BY DATE
PLOTTED BY
NOTE BOOK NO. CHECKED BY
FT. OF ANY CHECKED BY

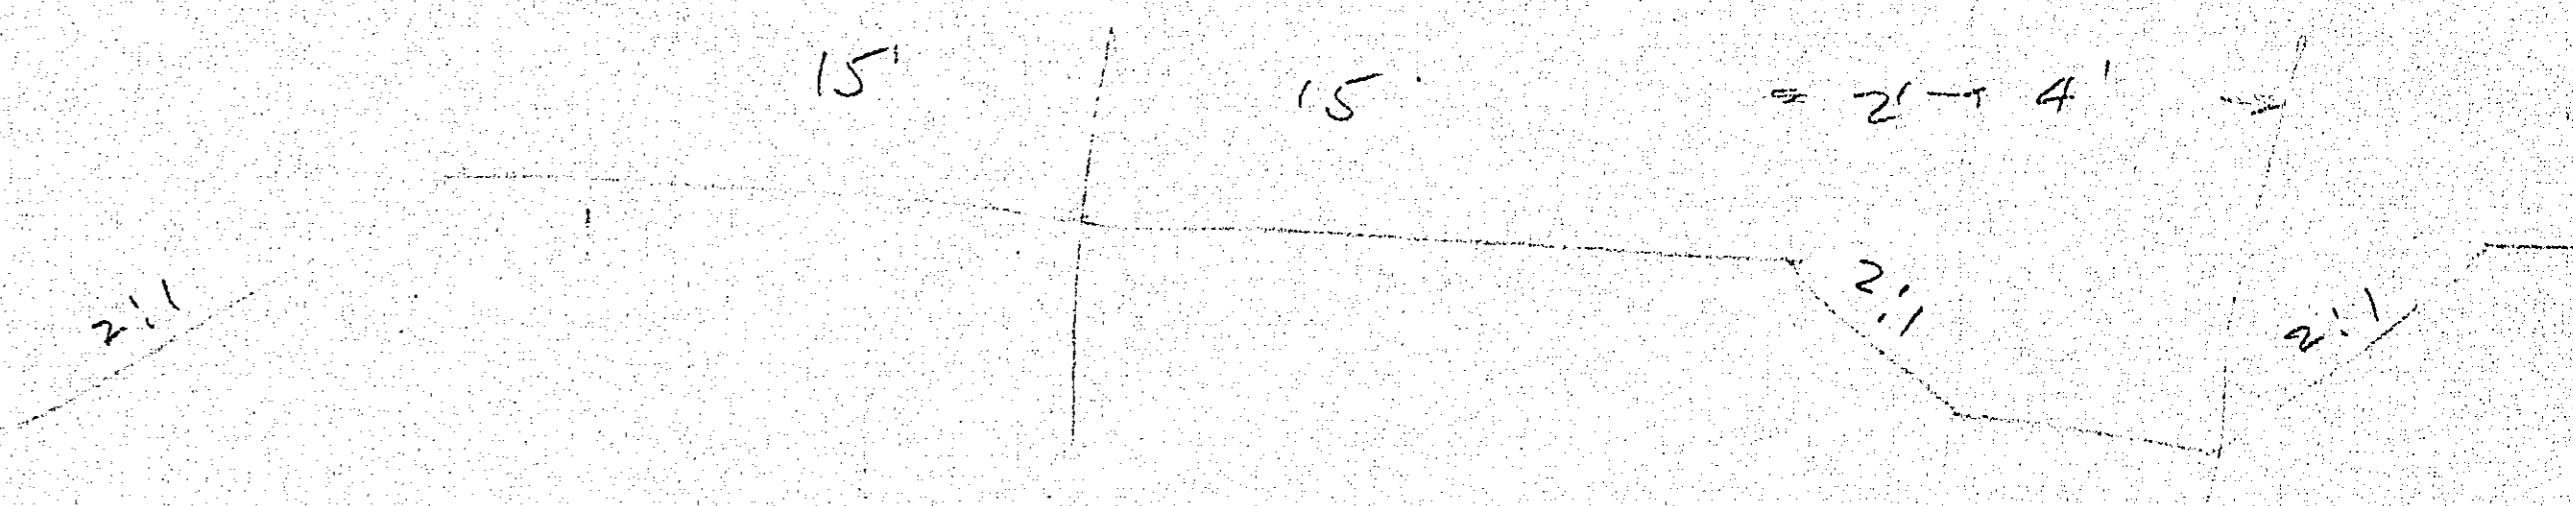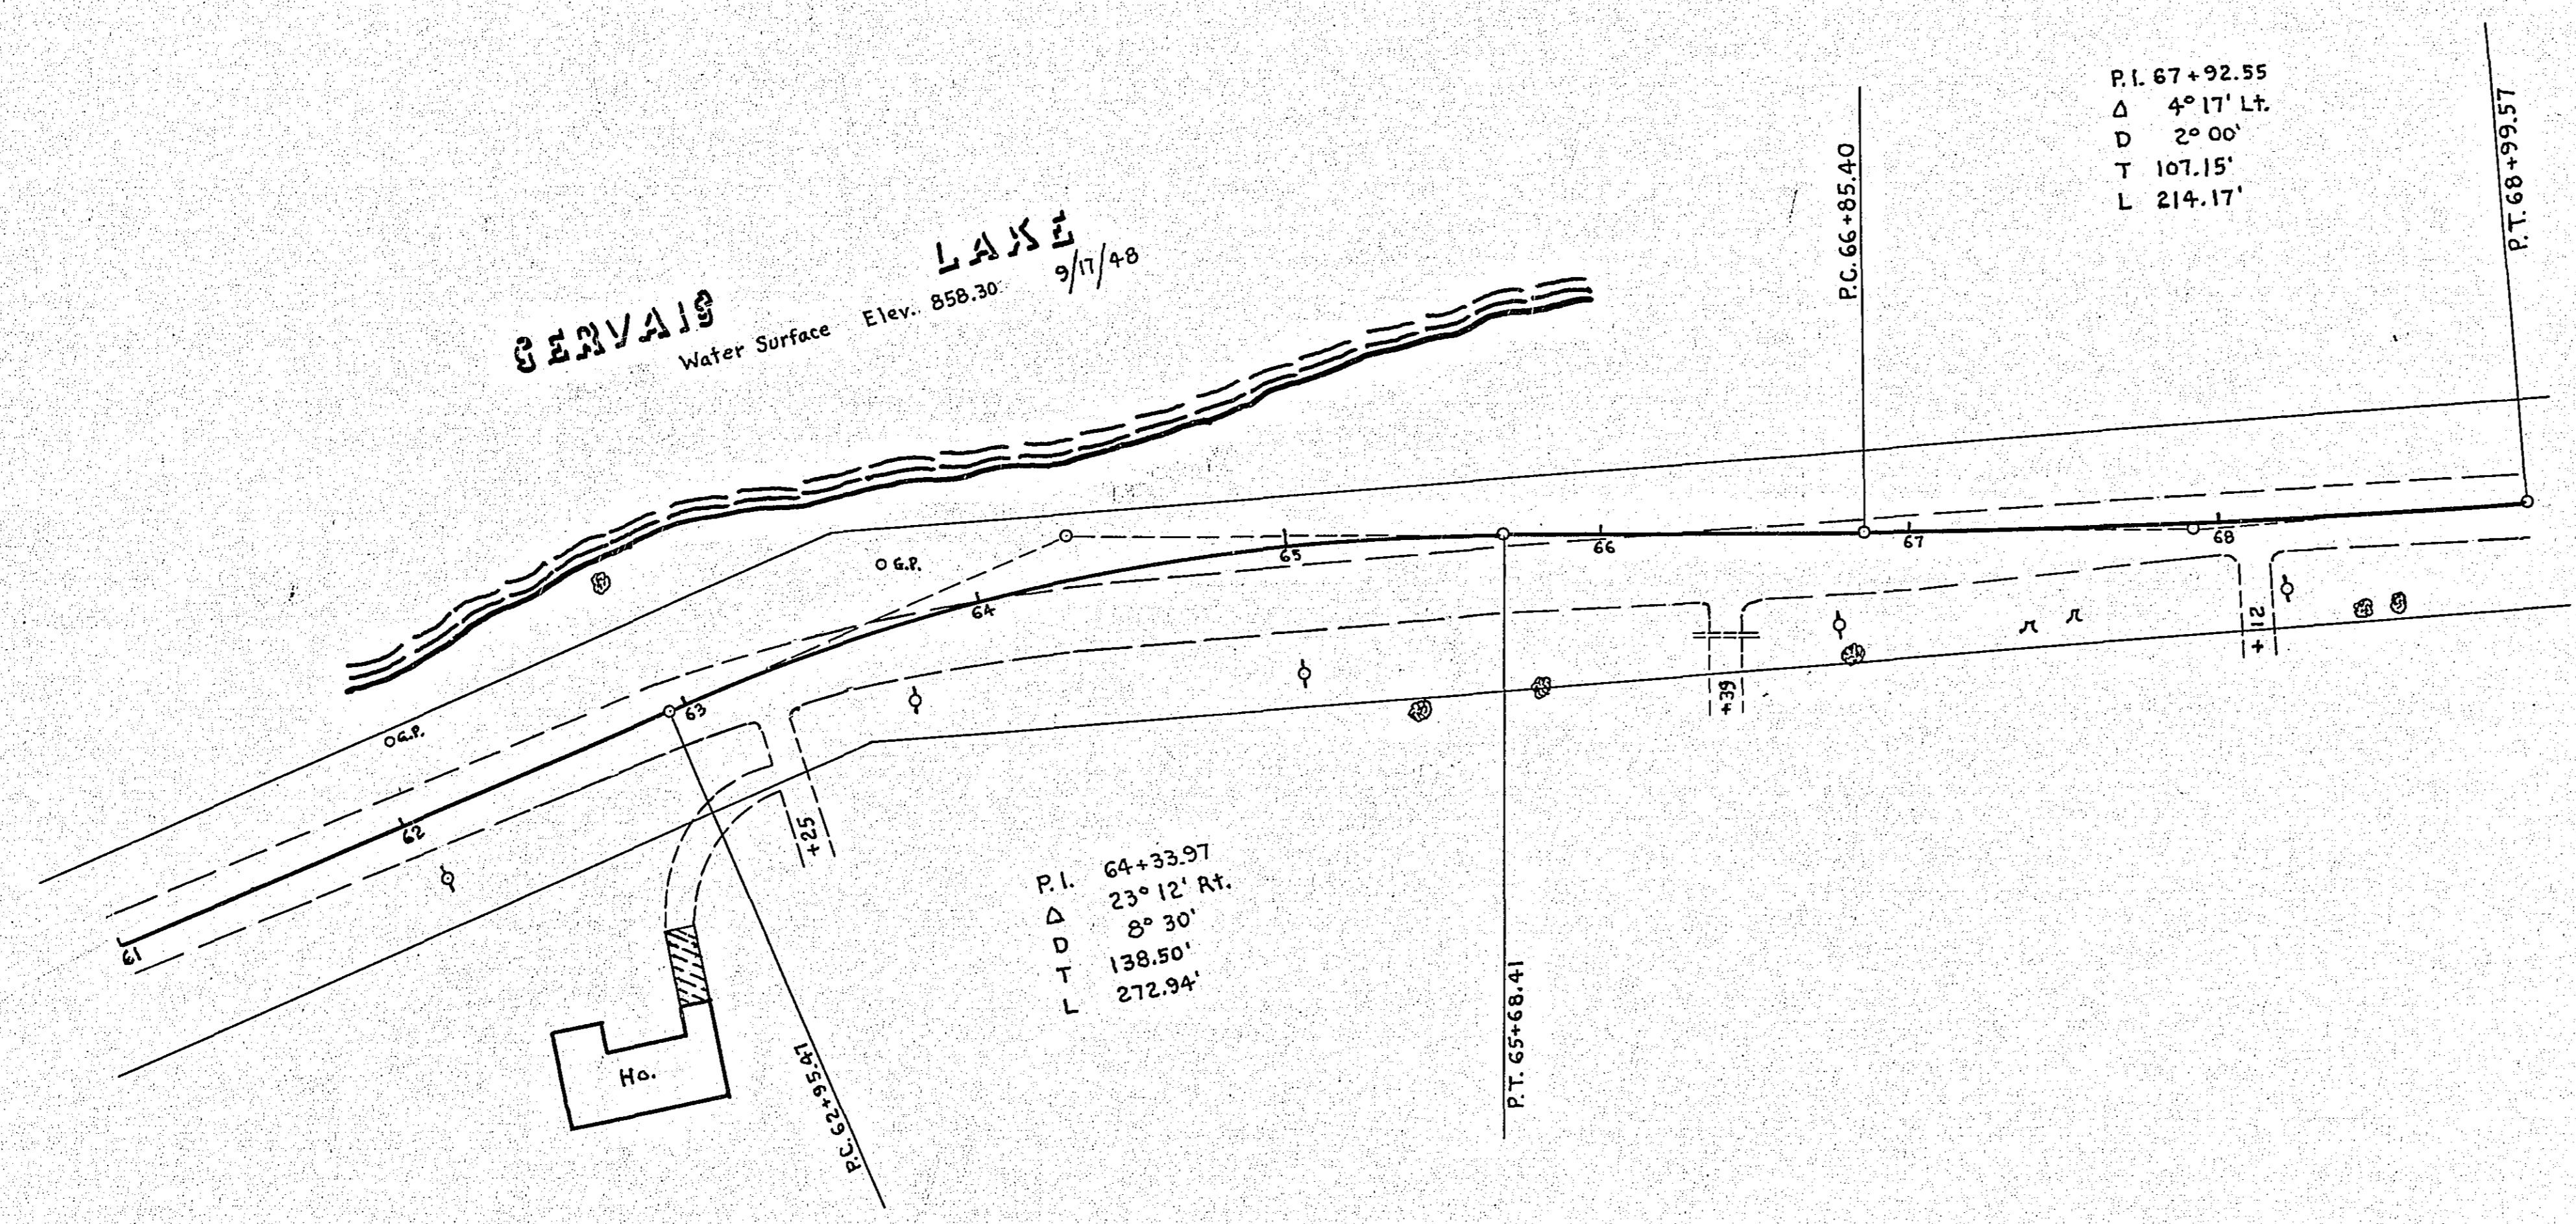

B.M. Top Conc. Footing
At Cor. Fc. Post 33' Lt. Sta. 68+92
Elev. 864.28

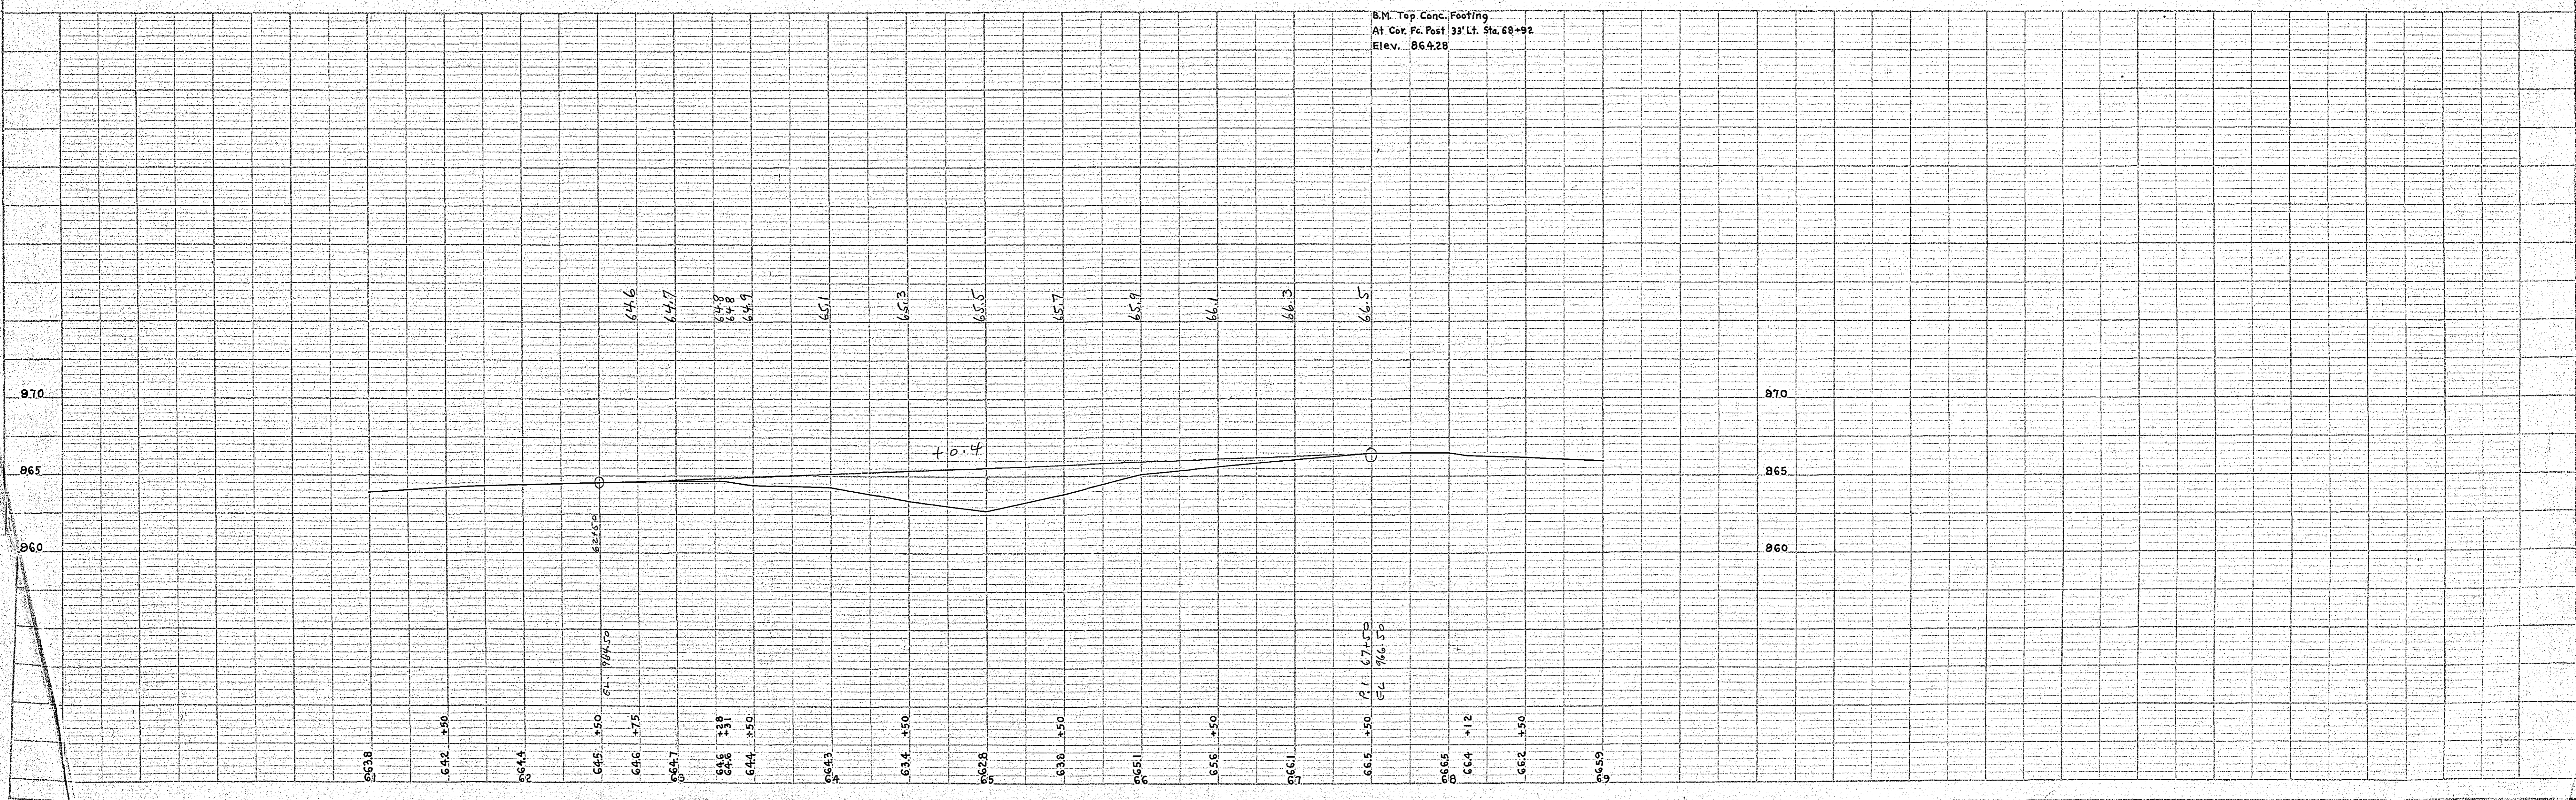


PLATE 1 - PLAN-PROFILE C. P. R. & E. STANDARD
JEFFERY & EISEN CO. NEW YORK.

K. & E. CO. No. 348-10A
"ARTHYGRAPH" Printing Co.

Keller PKWY.
1.06 Revision
Sta. 67+00 to Sta. 69+00