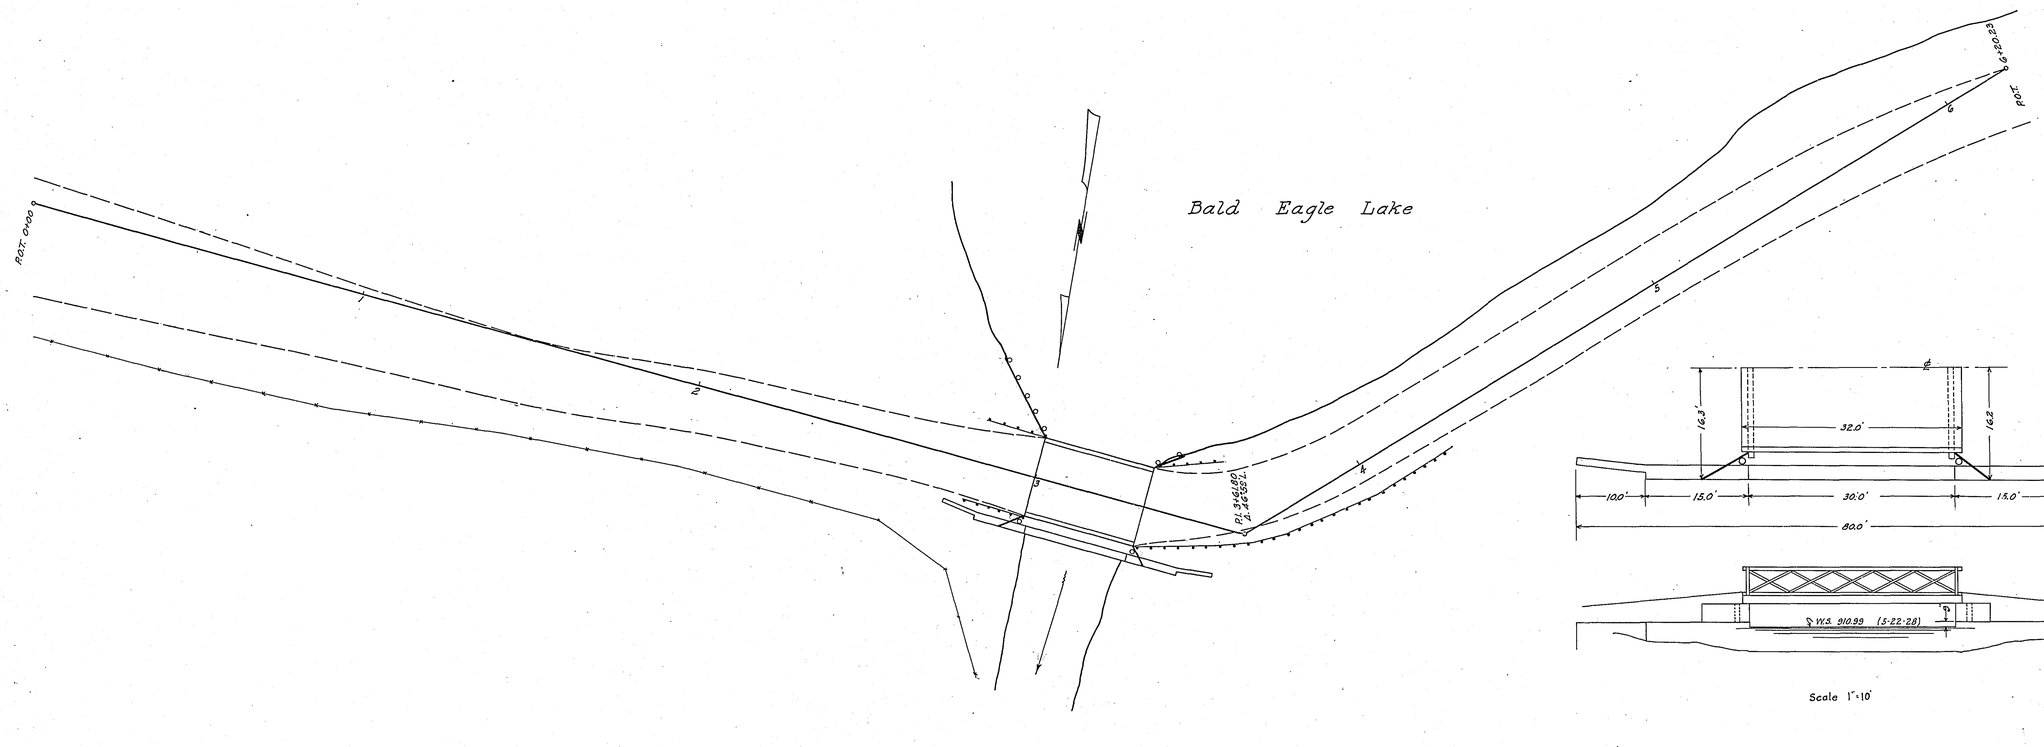


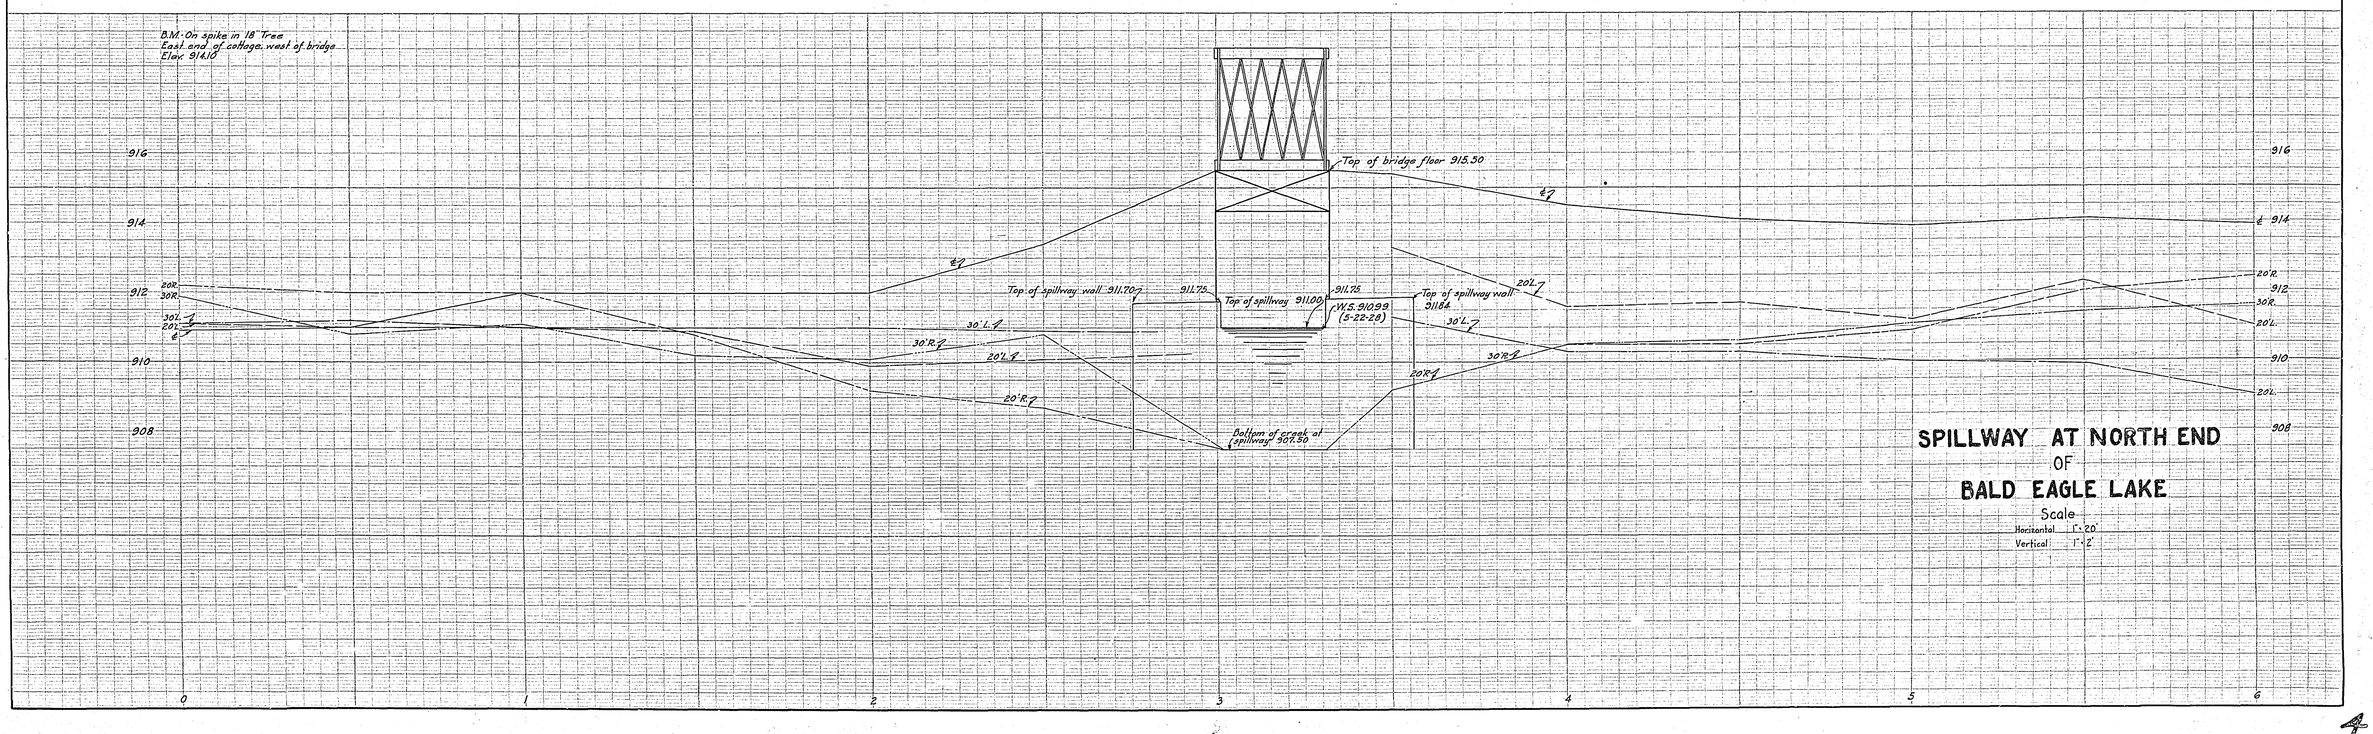


# SPILLWAY AT NORTH END OF BALD EAGLE LAKE

Scale
Horizontal 1"=20'
Vertical 1"=2'