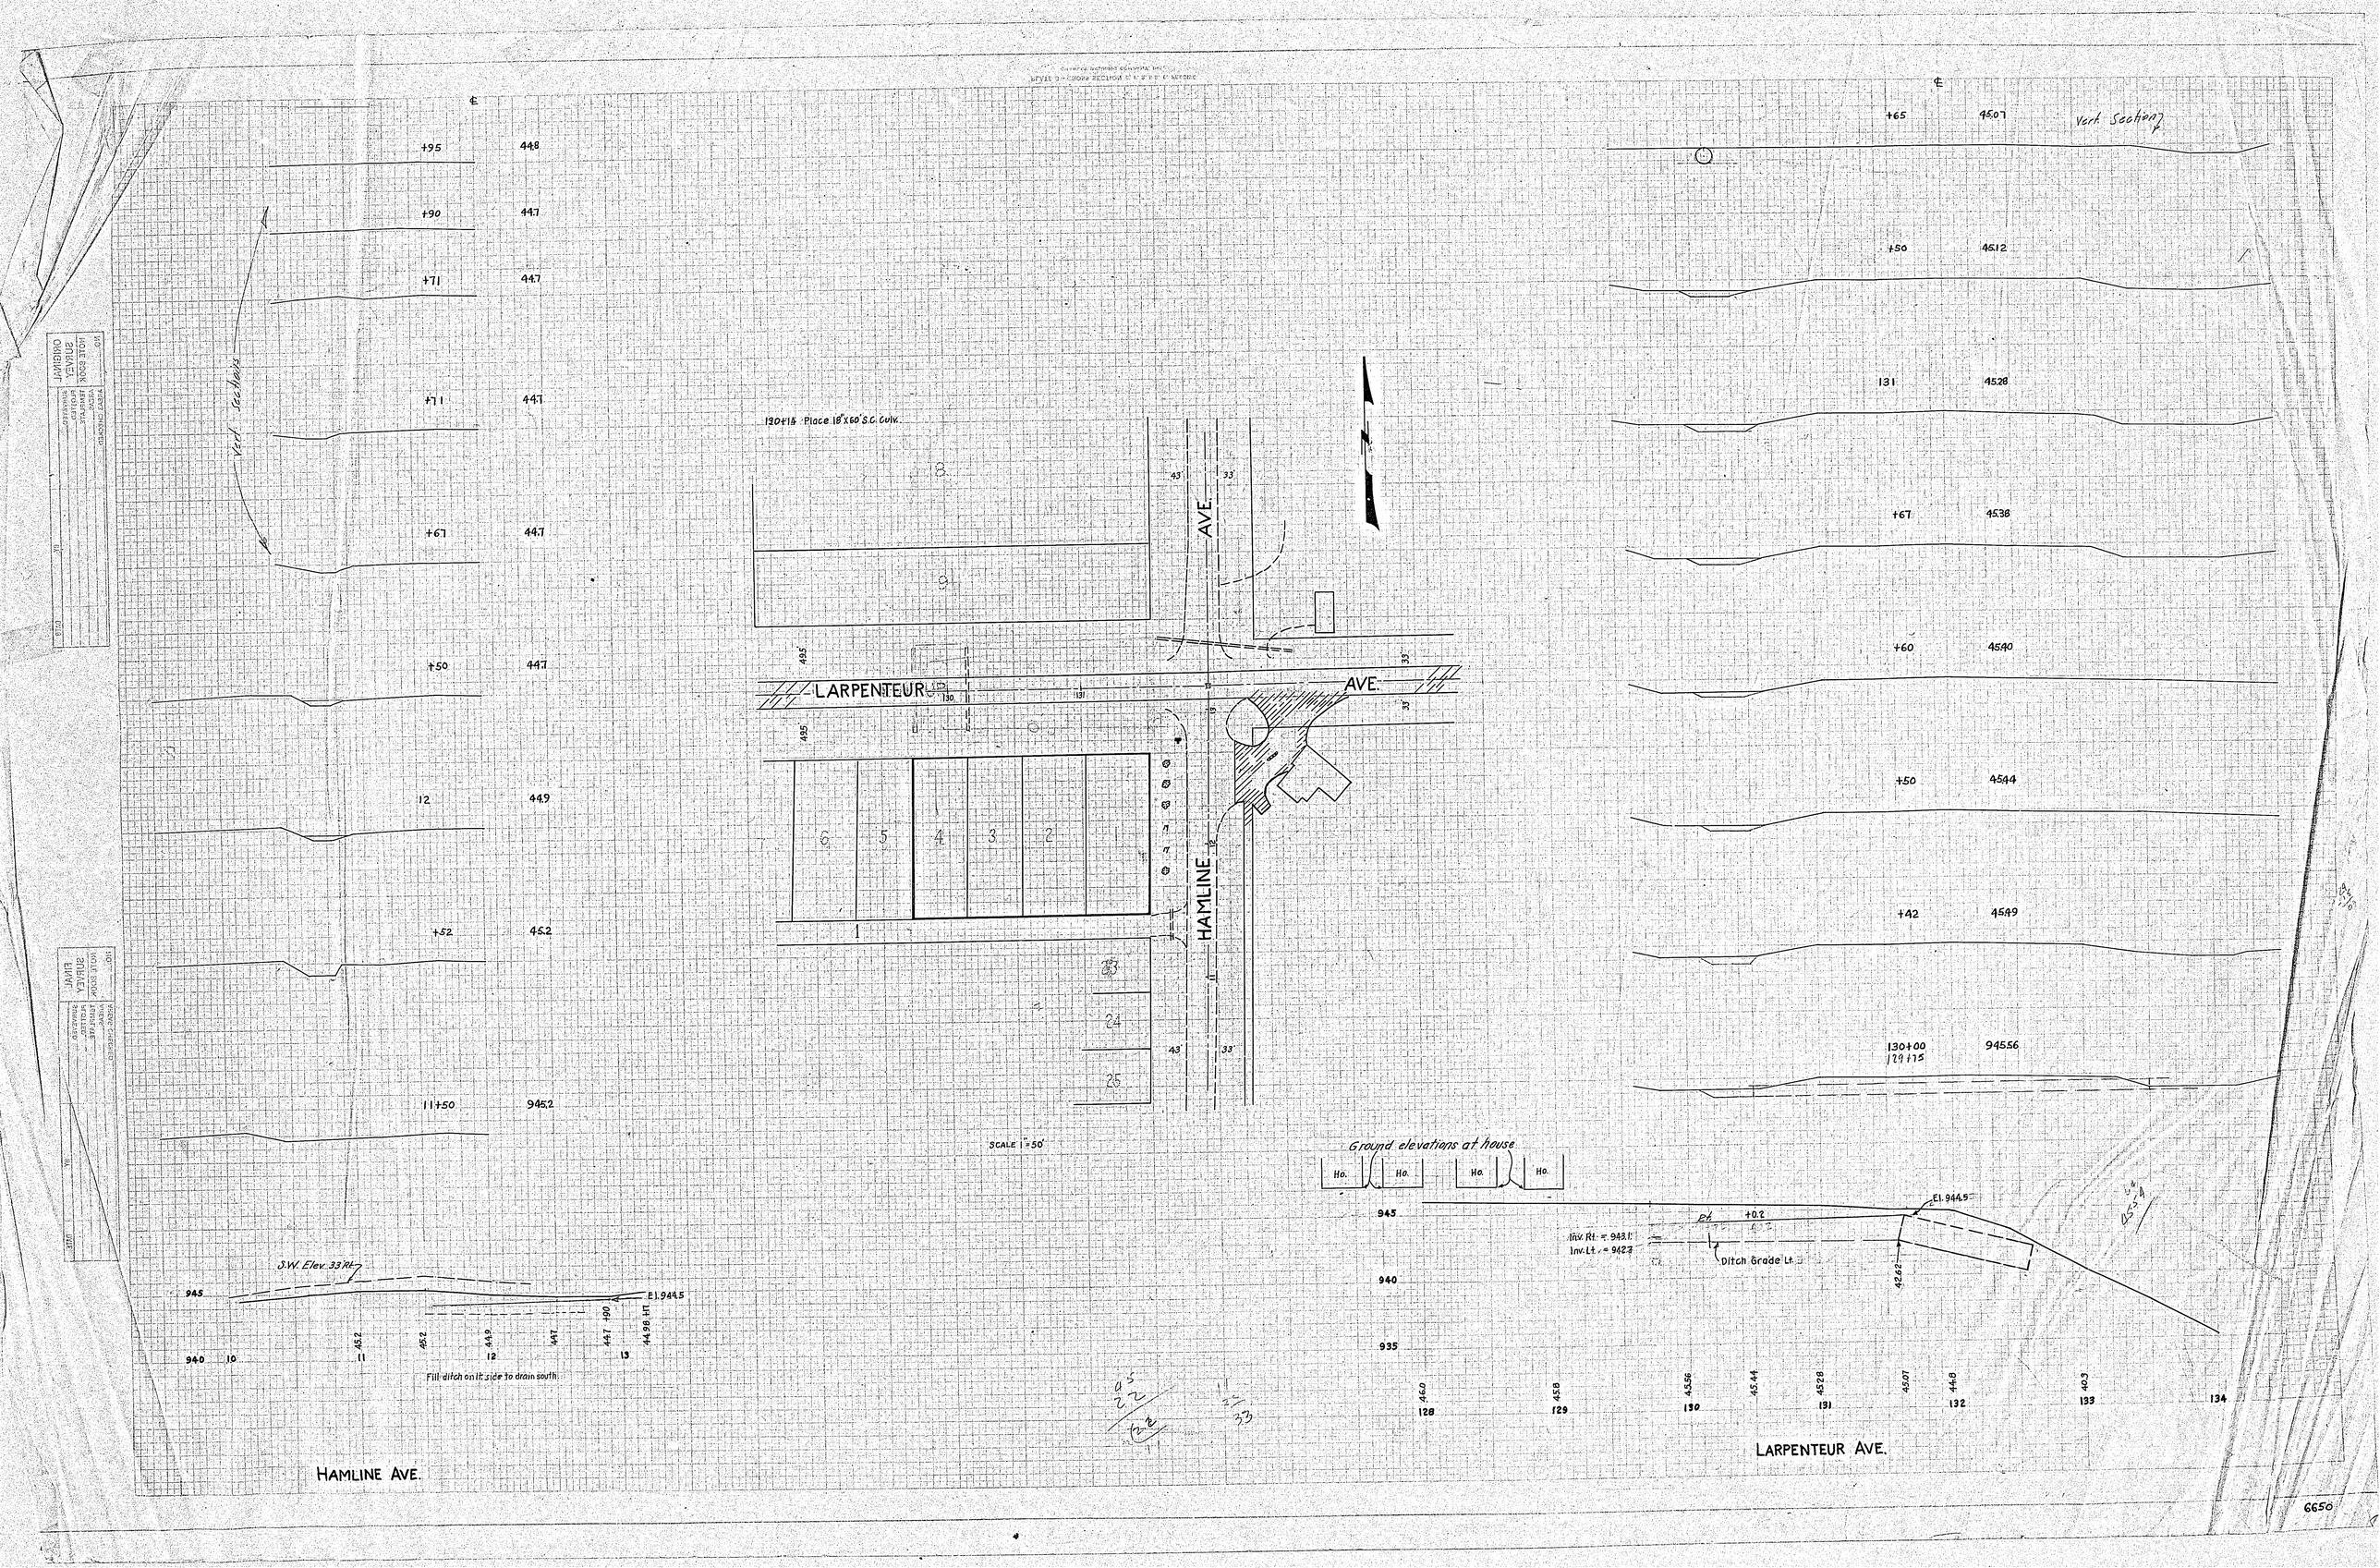

Vert. Sections
+95 44.8
+90 44.7
+71 44.7
+71 44.7
+67 44.7
+50 44.7
12 44.9
+52 45.2
11+50 945.2
130+15 Place 18"x60' S.C. Culv.
LARPENTEUR AVE.
HAMLINE AVE.
SCALE 1"=50'
+65 45.07
Vert. Section
+50 45.12
131 45.28
+67 45.38
+60 45.40
+50 45.44
+42 45.49
130+00 129+75 945.56
Ground elevations at house
Ho.
El. 944.5
Inv. Rt. = 943.1
Inv. Lt. = 942.7
Ditch Grade Lt.
S.W. Elev. 33 Rt.
El. 944.5
Fill ditch on lt. side to drain south
HAMLINE AVE.
LARPENTEUR AVE.
6650