ORIGINAL

NO	DATE	BY

DESIGNED	
DRAWN	
TRACED	
CHECKED	
QUANTITIES	
SURVEY	FINAL
HOLE BOOK NO.	
USER CHECKED	

℄

+67 488

24"X 43' C.M

+50 489

151 494

+50 504

150 509

+78 512

+50 515

149 516

+50 519

148+00 520

℄

+50 477

155 477

+50 478

154 480

+50 480

153 482

+50 483

152 486

+87 487

151+77 487

℄

+73 482

+56 482

+3695 ℄ Lex. Ave 484

+12 482

158 481

+50 477

157 478

+75 478

+67 478

+50 478

156+00 478

4/49

Cont. "B" (Drainage)

6655

151467 Rt 24'40
Lt 18' Inp 24'X 42'
C.M. Culv.

156+45 Ent. Rt. 22°
Inp. 12'X 24' V.C.P.
Stone H. Walls

157+31 Rt. 22°
Inp. 12'X 16' V.C.P.
Stone & Conc. H. Walls

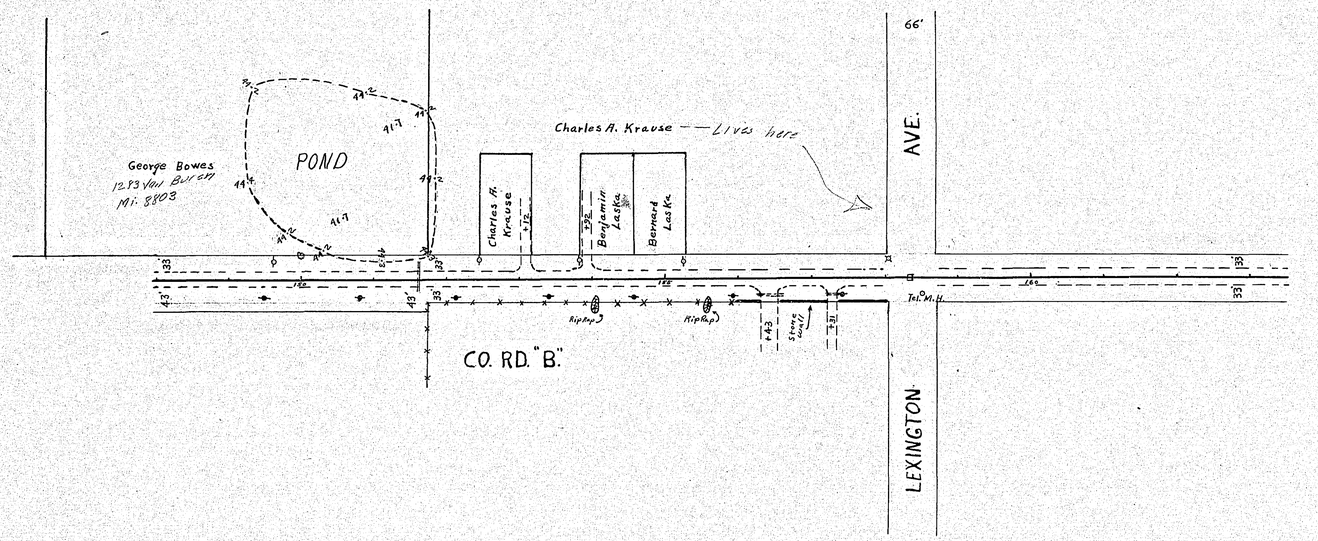

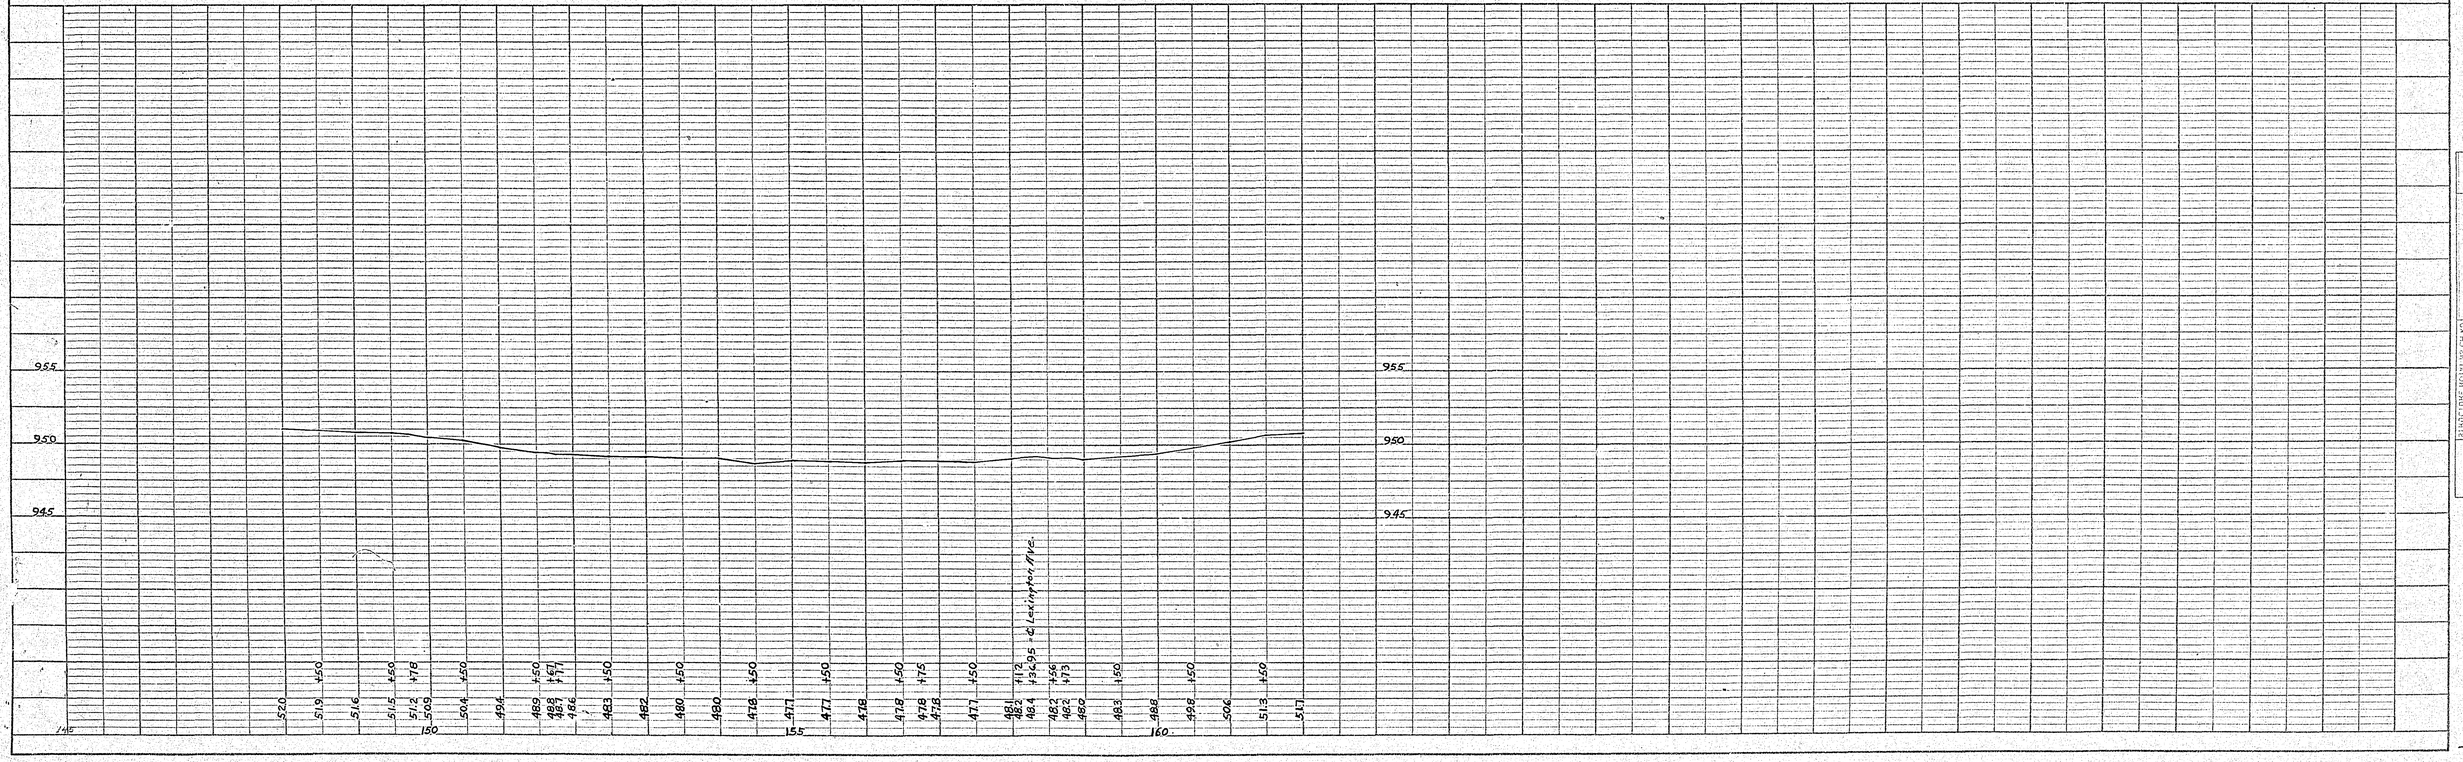
955
950
945
520
519
516
515
512
509
504
496
489
488
486
483
482
480
480
478
477
477
478
478
478
477
481
481
484
482
482
482
483
486
498
506
513
517
+50
+78
+67
+71
+50
+50
+50