

Sta 0+12.4 MH 9'4"

Sta 1+44.4 MH 15'11"

Sta 5+45 MH 15'2"

Sta 9+24 MH 8'

Sta 11+51 MH 1'8"

Sta 12+12 MH 1'11"








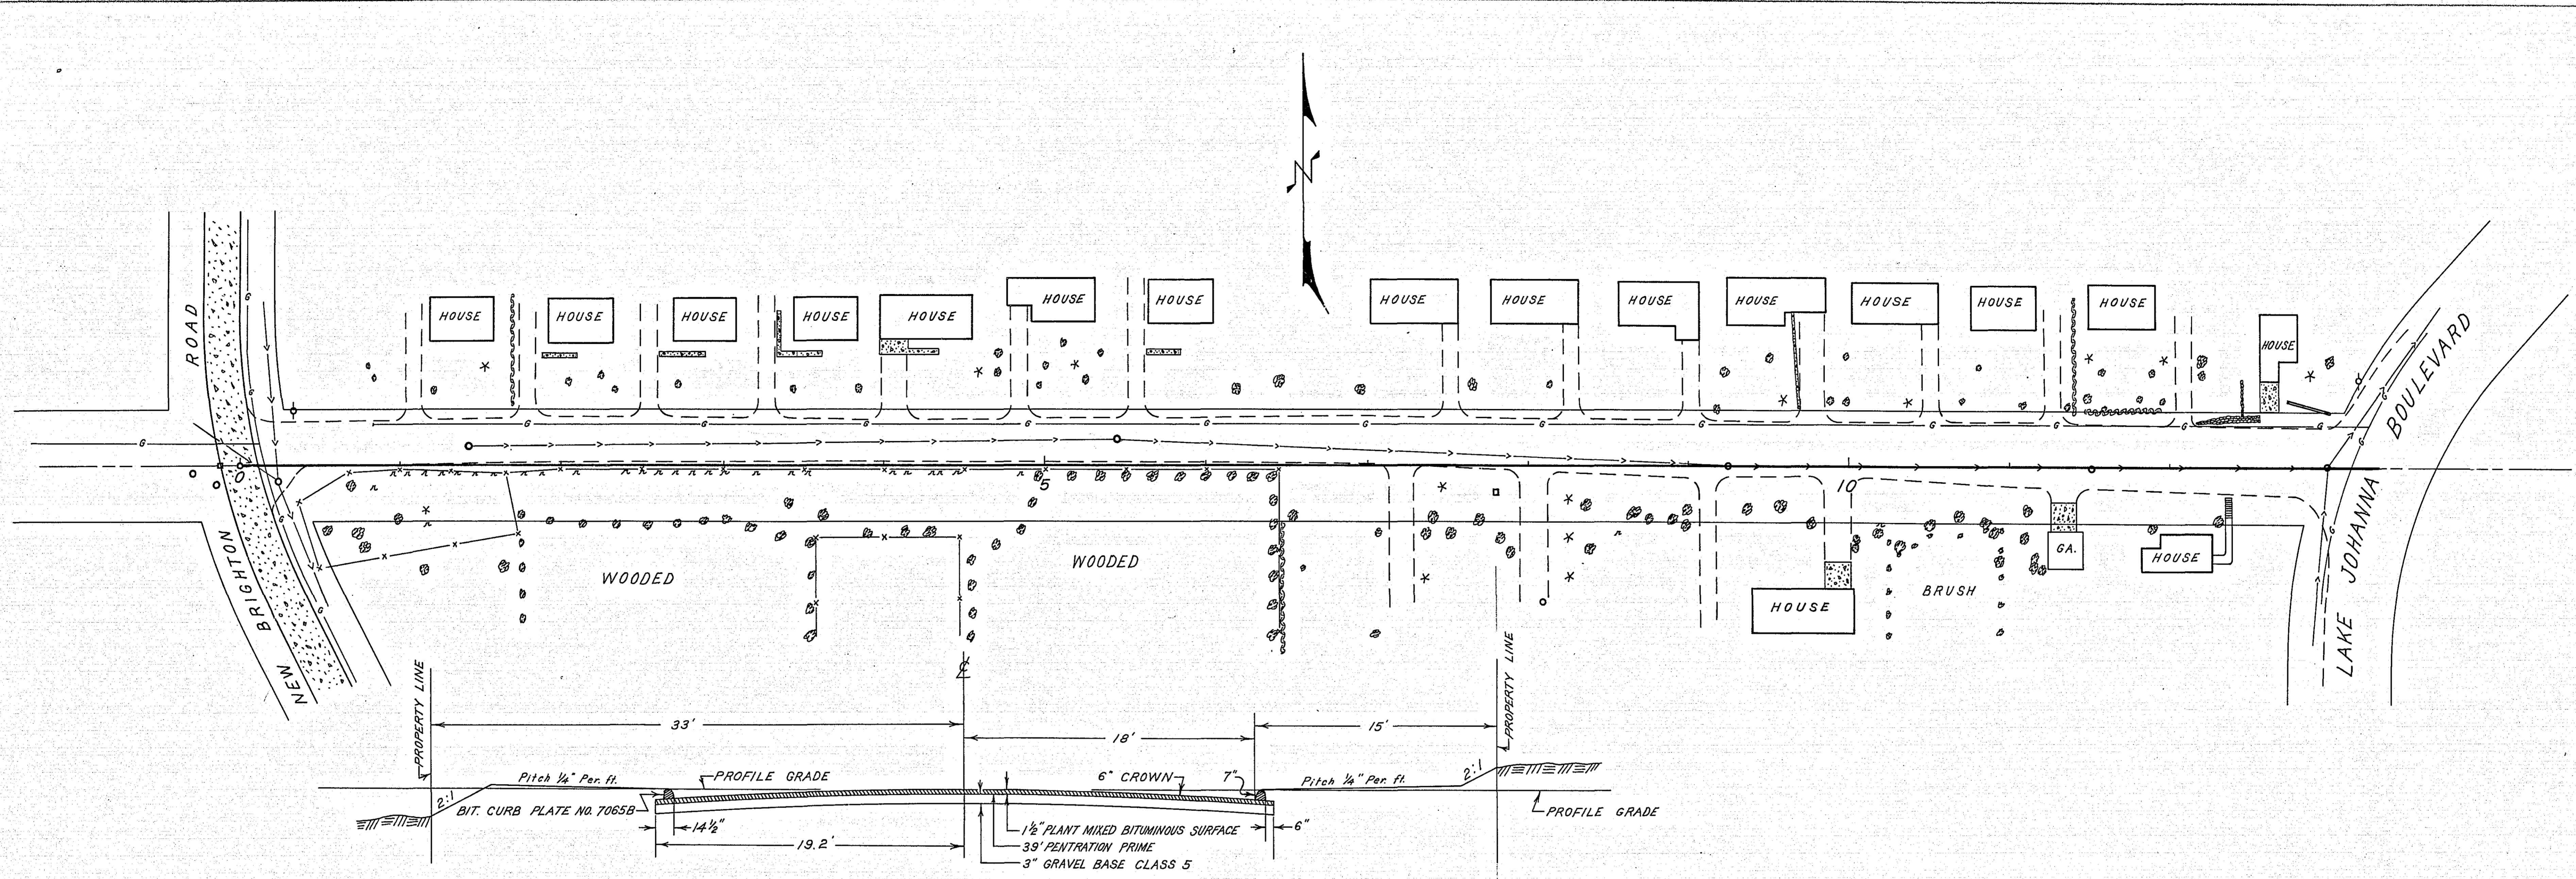










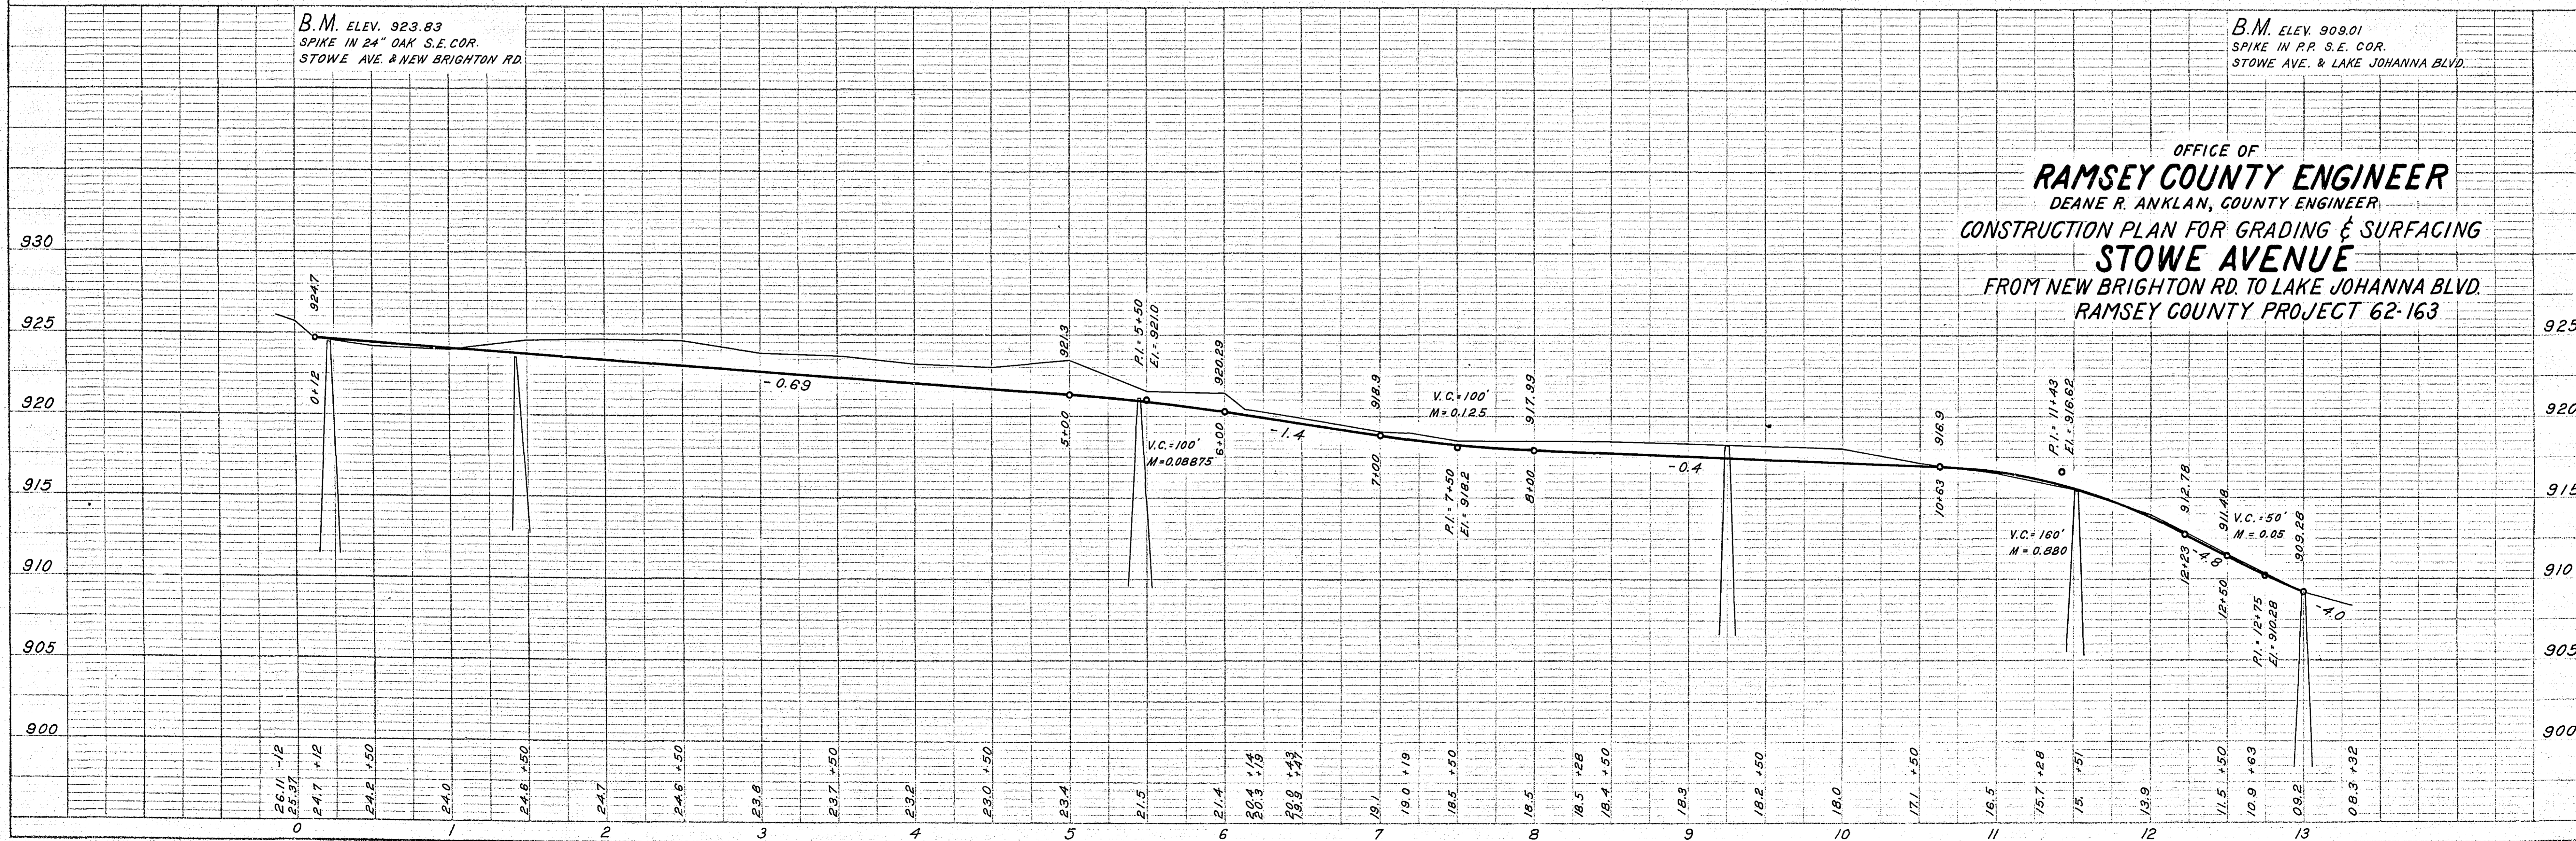

OFFICE OF  
**RAMSEY COUNTY ENGINEER**  
 DEANE R. ANKLAN, COUNTY ENGINEER  
 CONSTRUCTION PLAN FOR GRADING & SURFACING  
**STOWE AVENUE**  
 FROM NEW BRIGHTON RD. TO LAKE JOHANNA BLVD.  
 RAMSEY COUNTY PROJECT 62-163



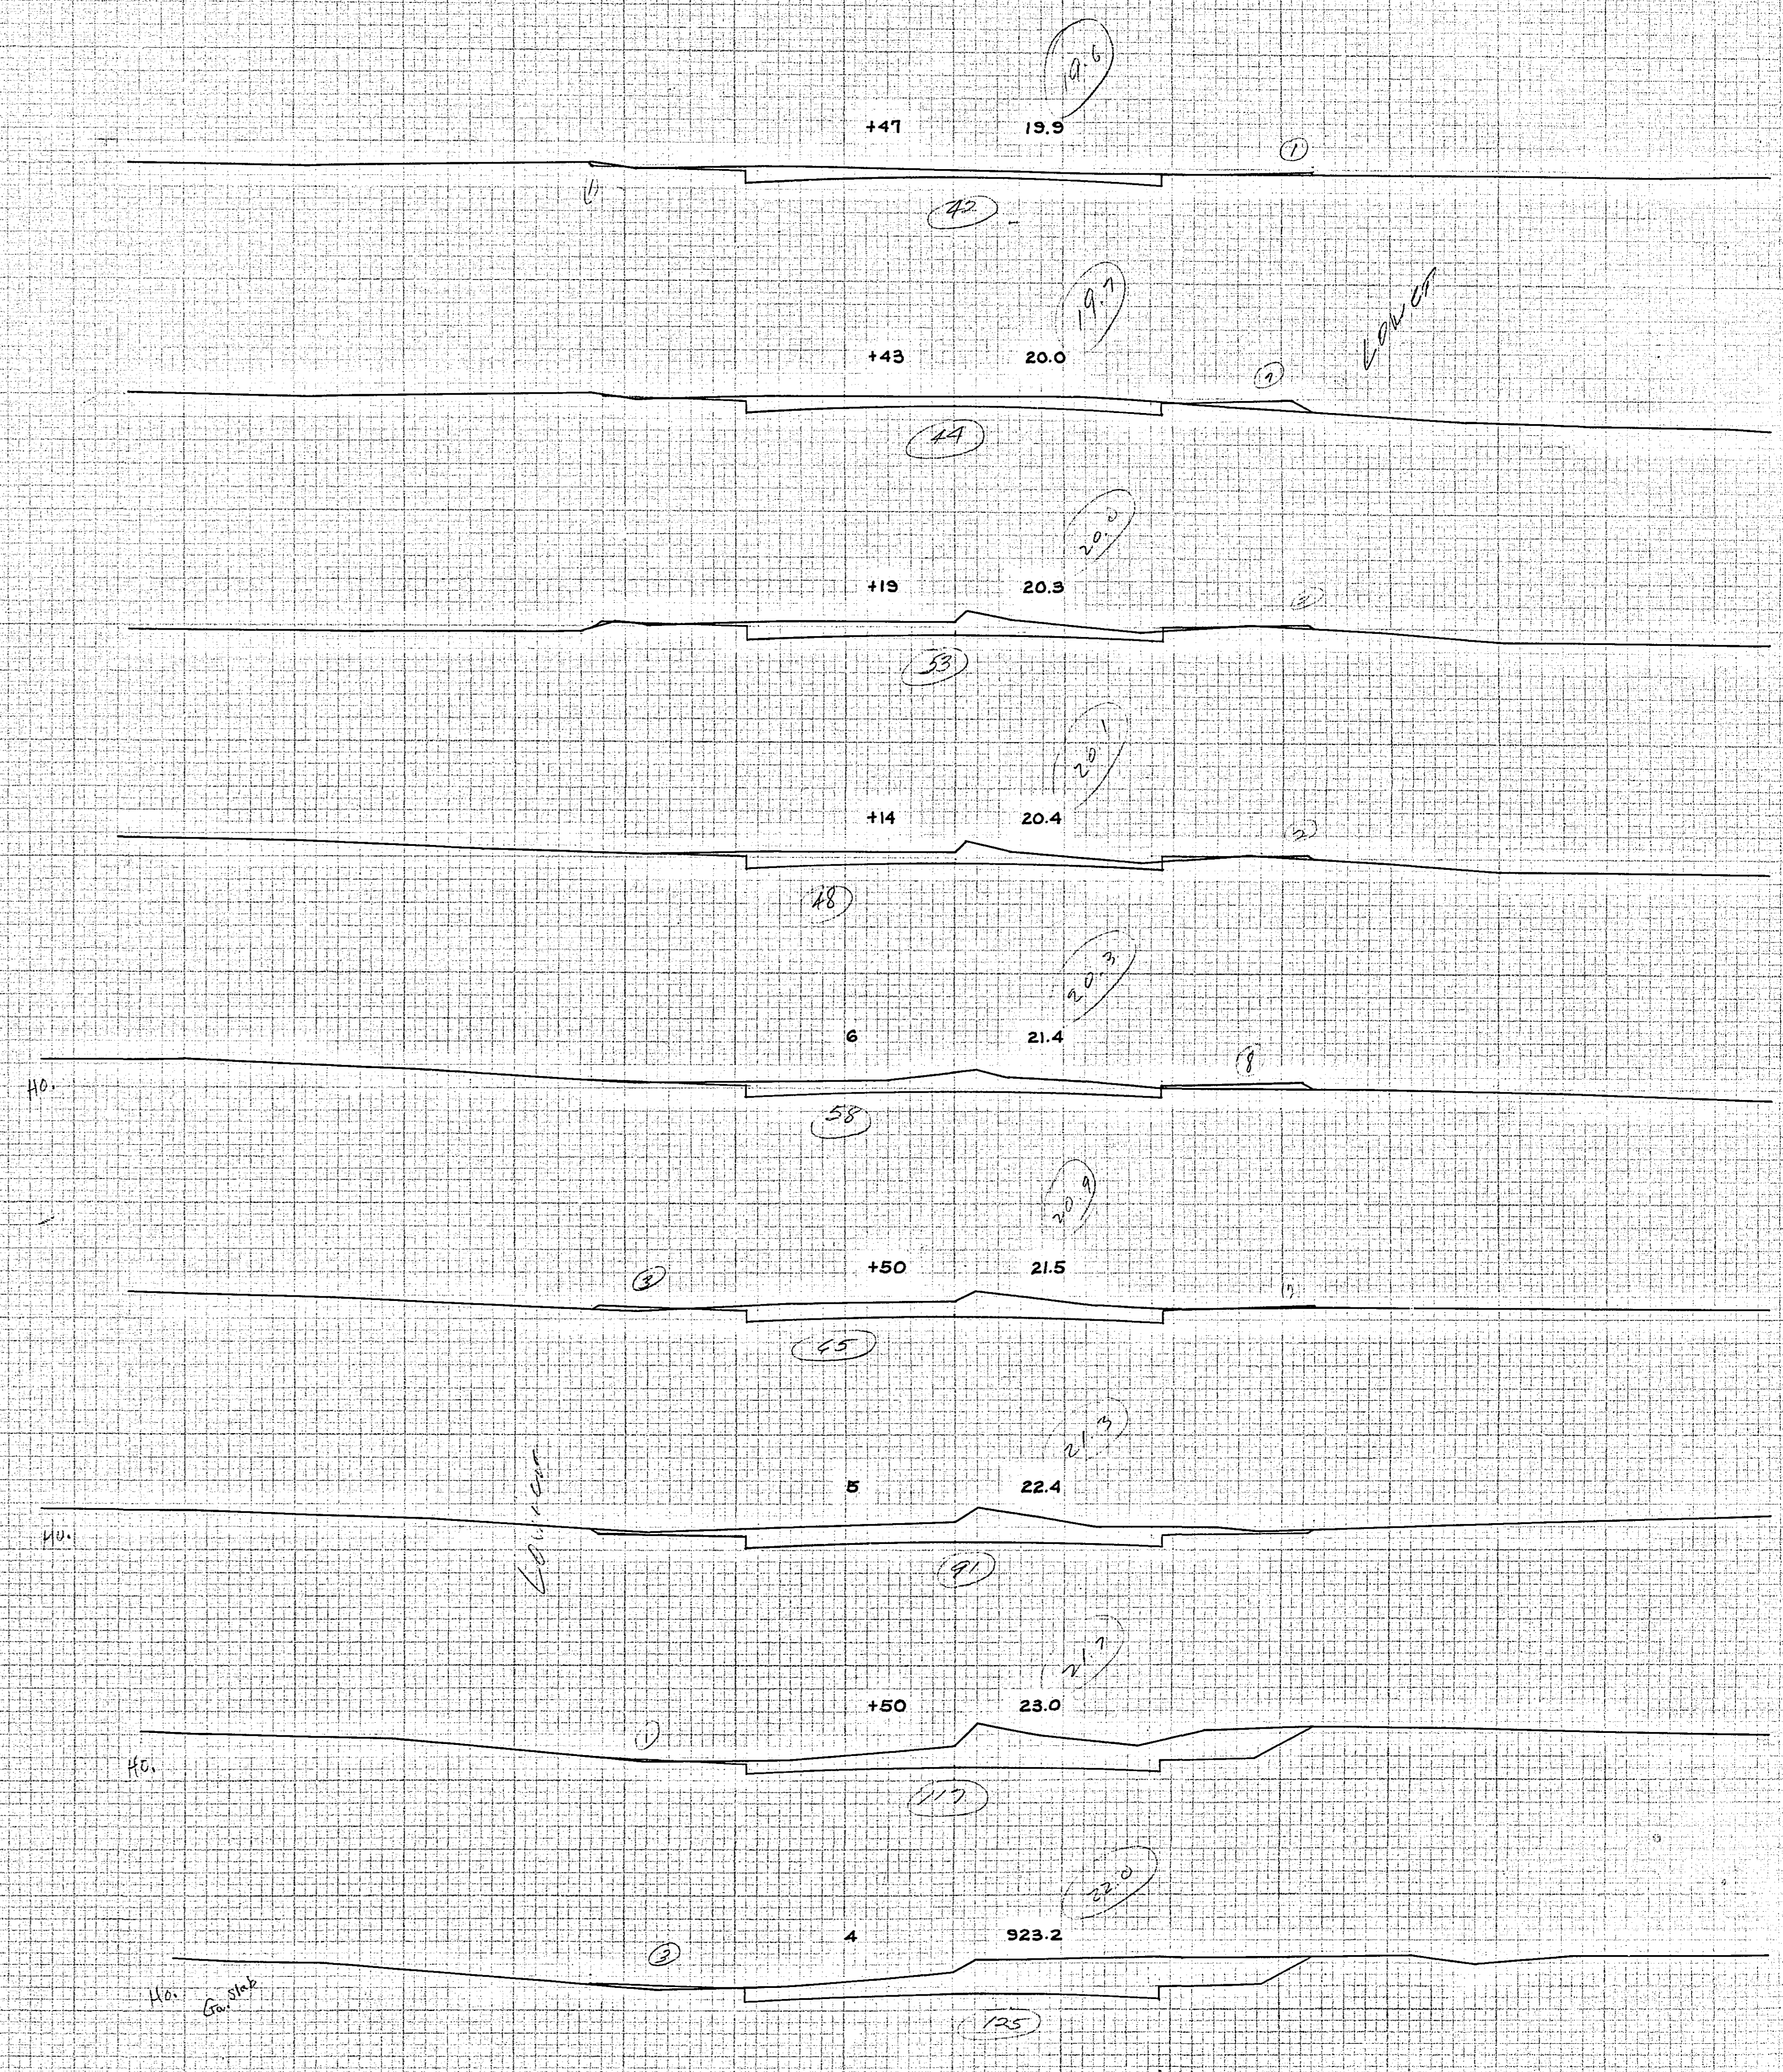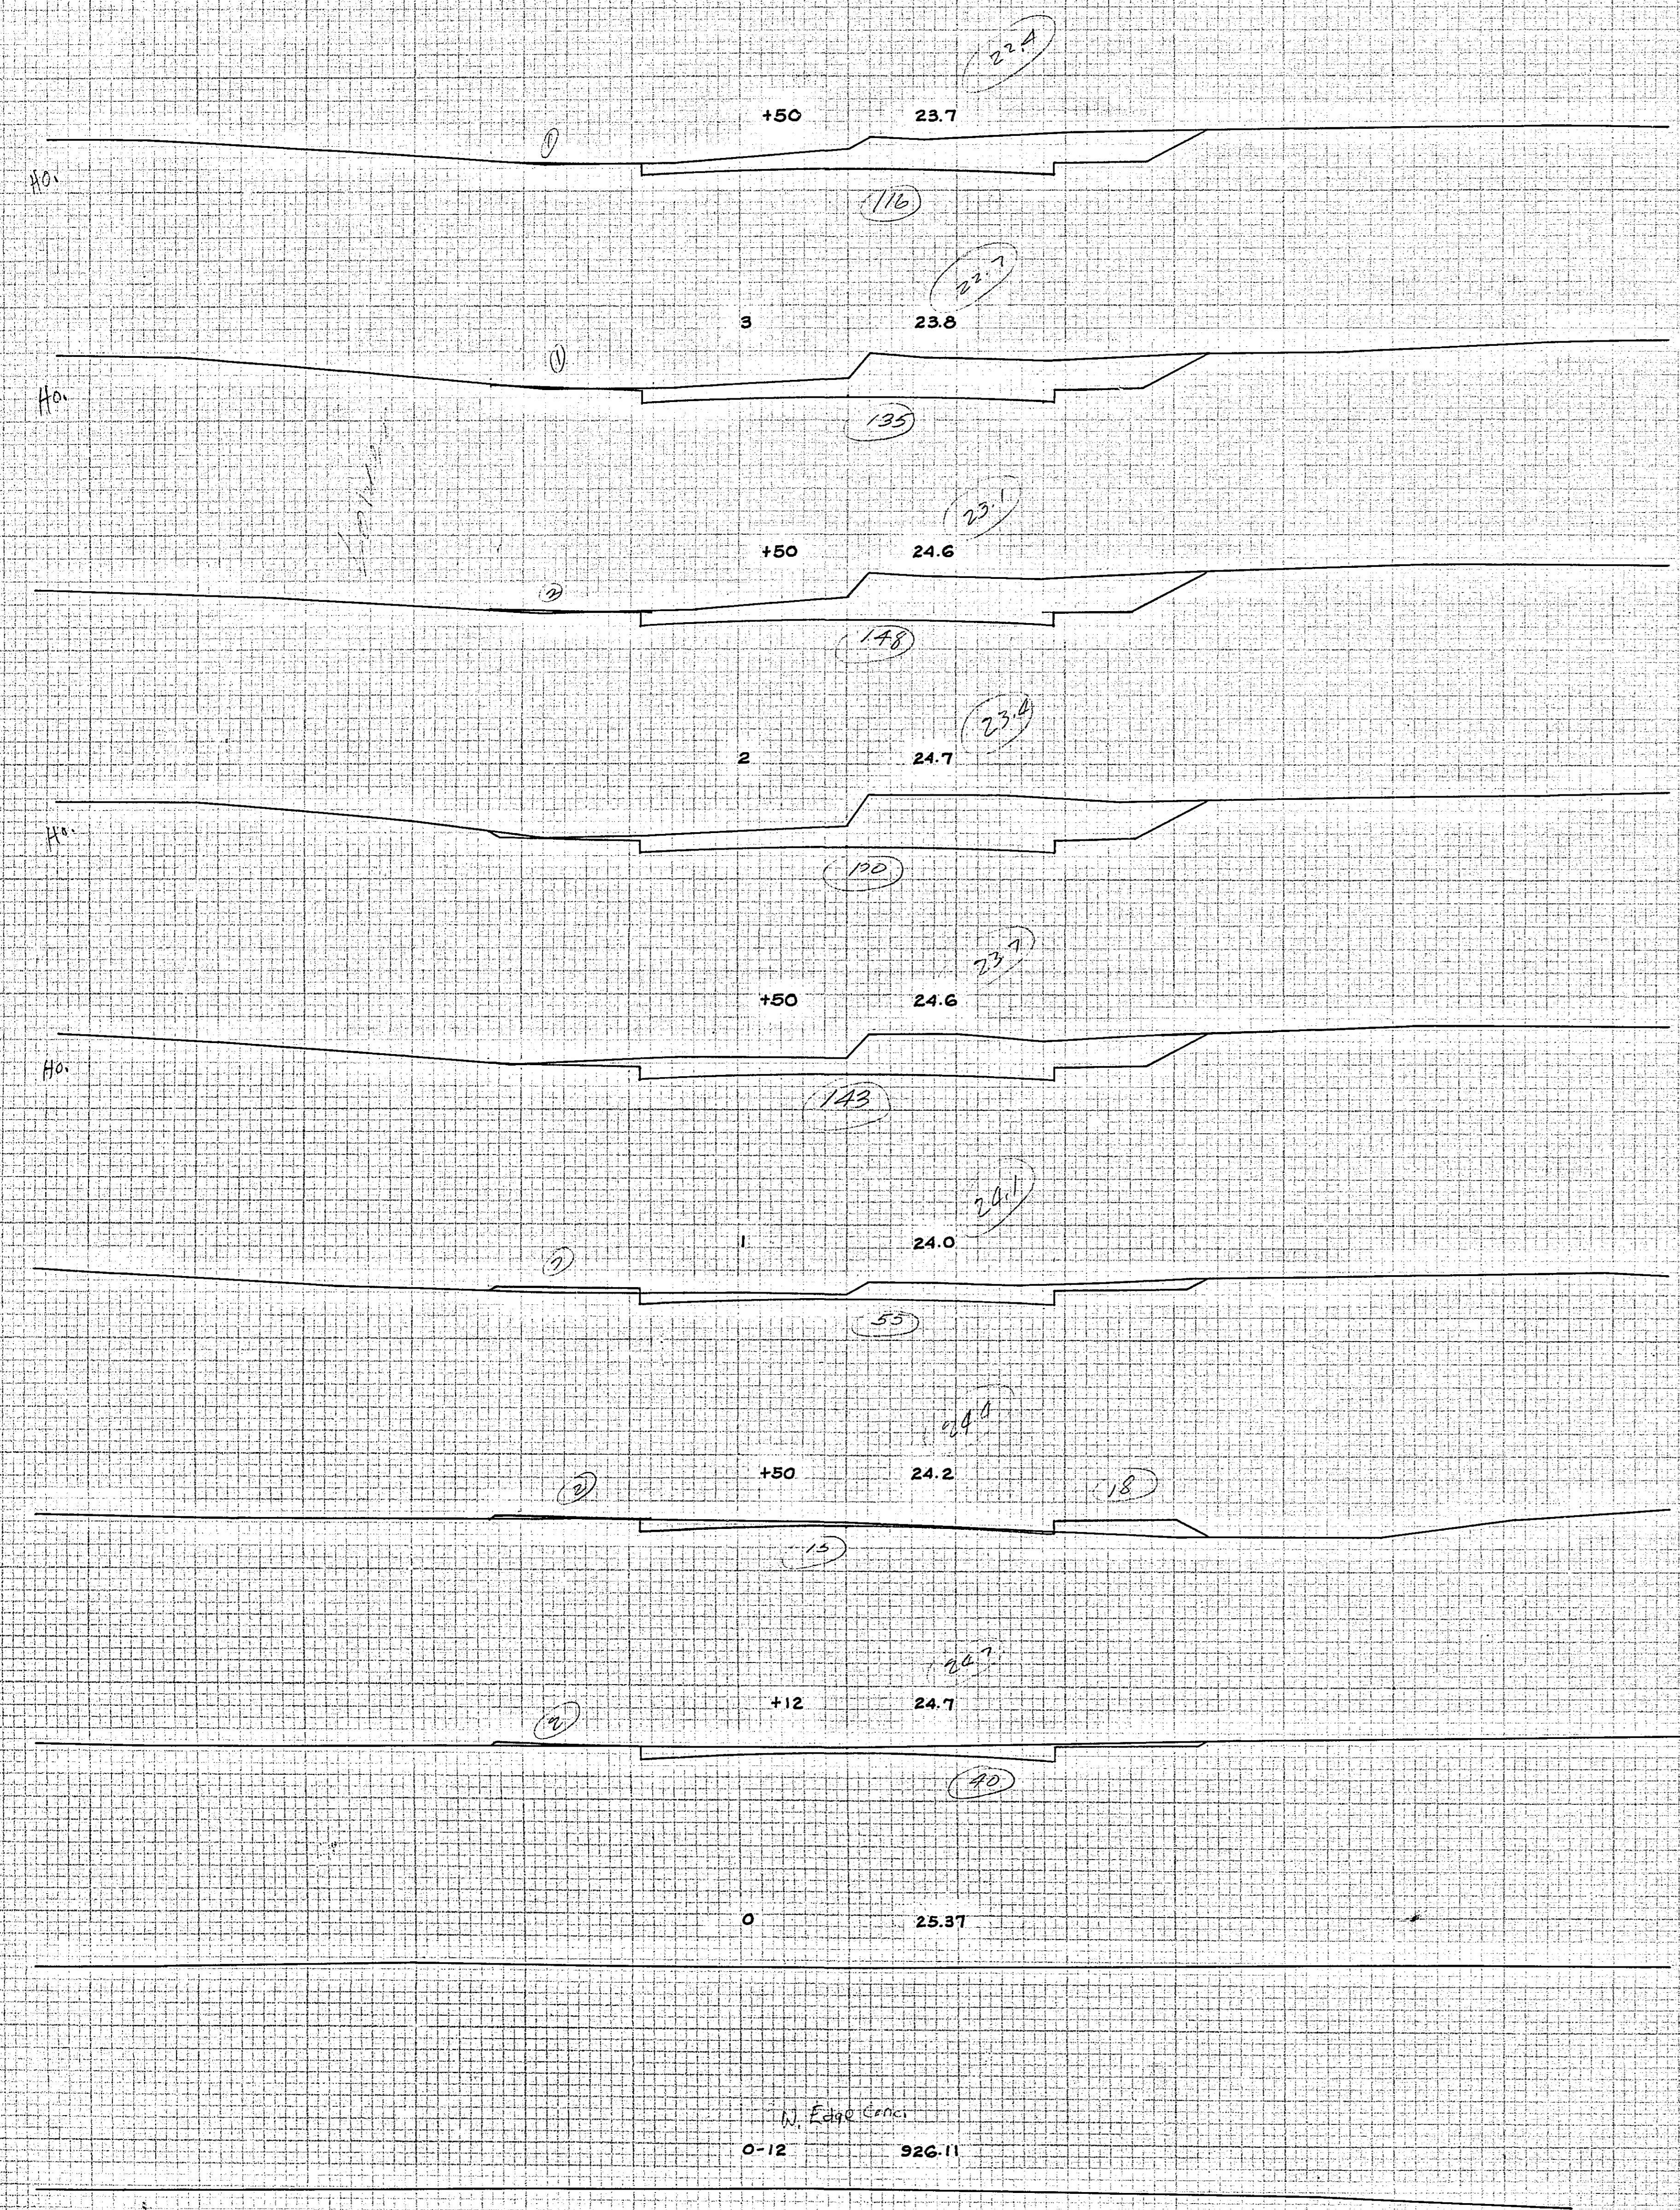

NO. 1  
DATE BOOKED  
BY  
CHECKED  
DATE

NO. 2  
DATE BOOKED  
BY  
CHECKED  
DATE

