


NORTH OWASSO BLVD.

OFFICE OF COUNTY ENGINEER
RAMSEY CO. MINN.
Paul H. Coates, County Surveyor

PLAT SHOWING
TOPOGRAPHY AND CONTOURS
— OF GROUNDS —
CHILDREN'S PREVENTORIUM
— RAMSEY CO. MINN. —

As of October 1933.

Scale 1 in. = 50 ft.

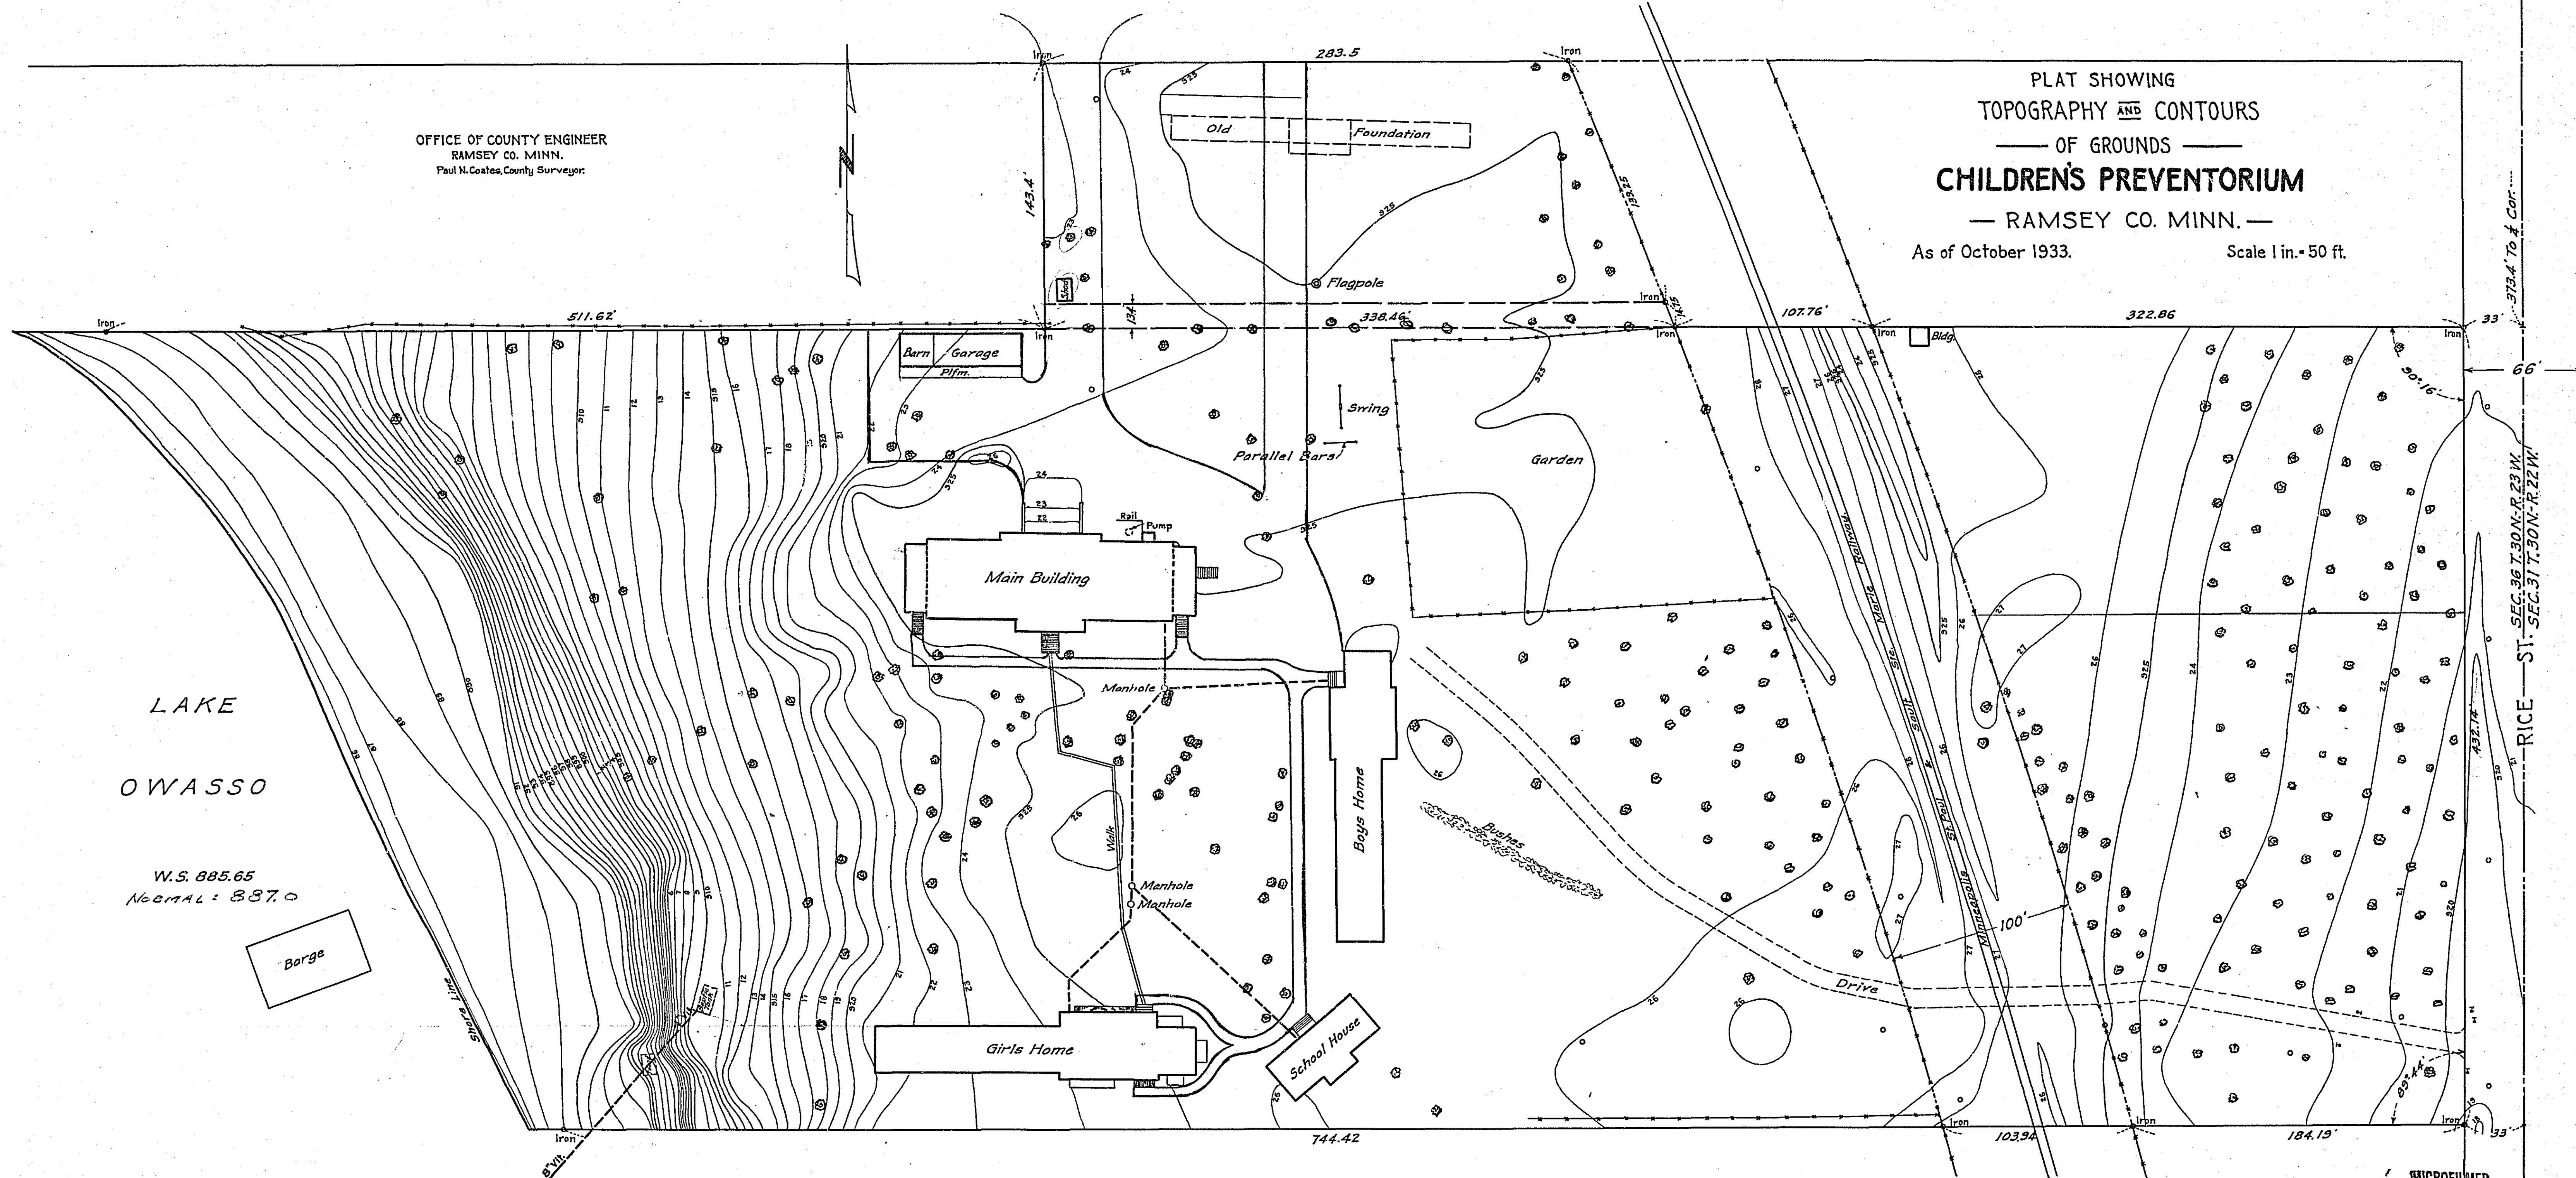

LAKE
OWASSO

W.S. 885.65
Normal: 887.0

Barge

ST. SEC. 36 T. 30 N. R. 23 W.
ST. SEC. 31 T. 30 N. R. 22 W.

MICROFILMED
RAMSEY CO. ENGR.

689

With 689

With 689