OFFICE OF COUNTY ENGINEER
RAMSEY COUNTY
MINN.

PAUL N. COATES
COUNTY ENGINEER
Scale 1" = 30 ft.

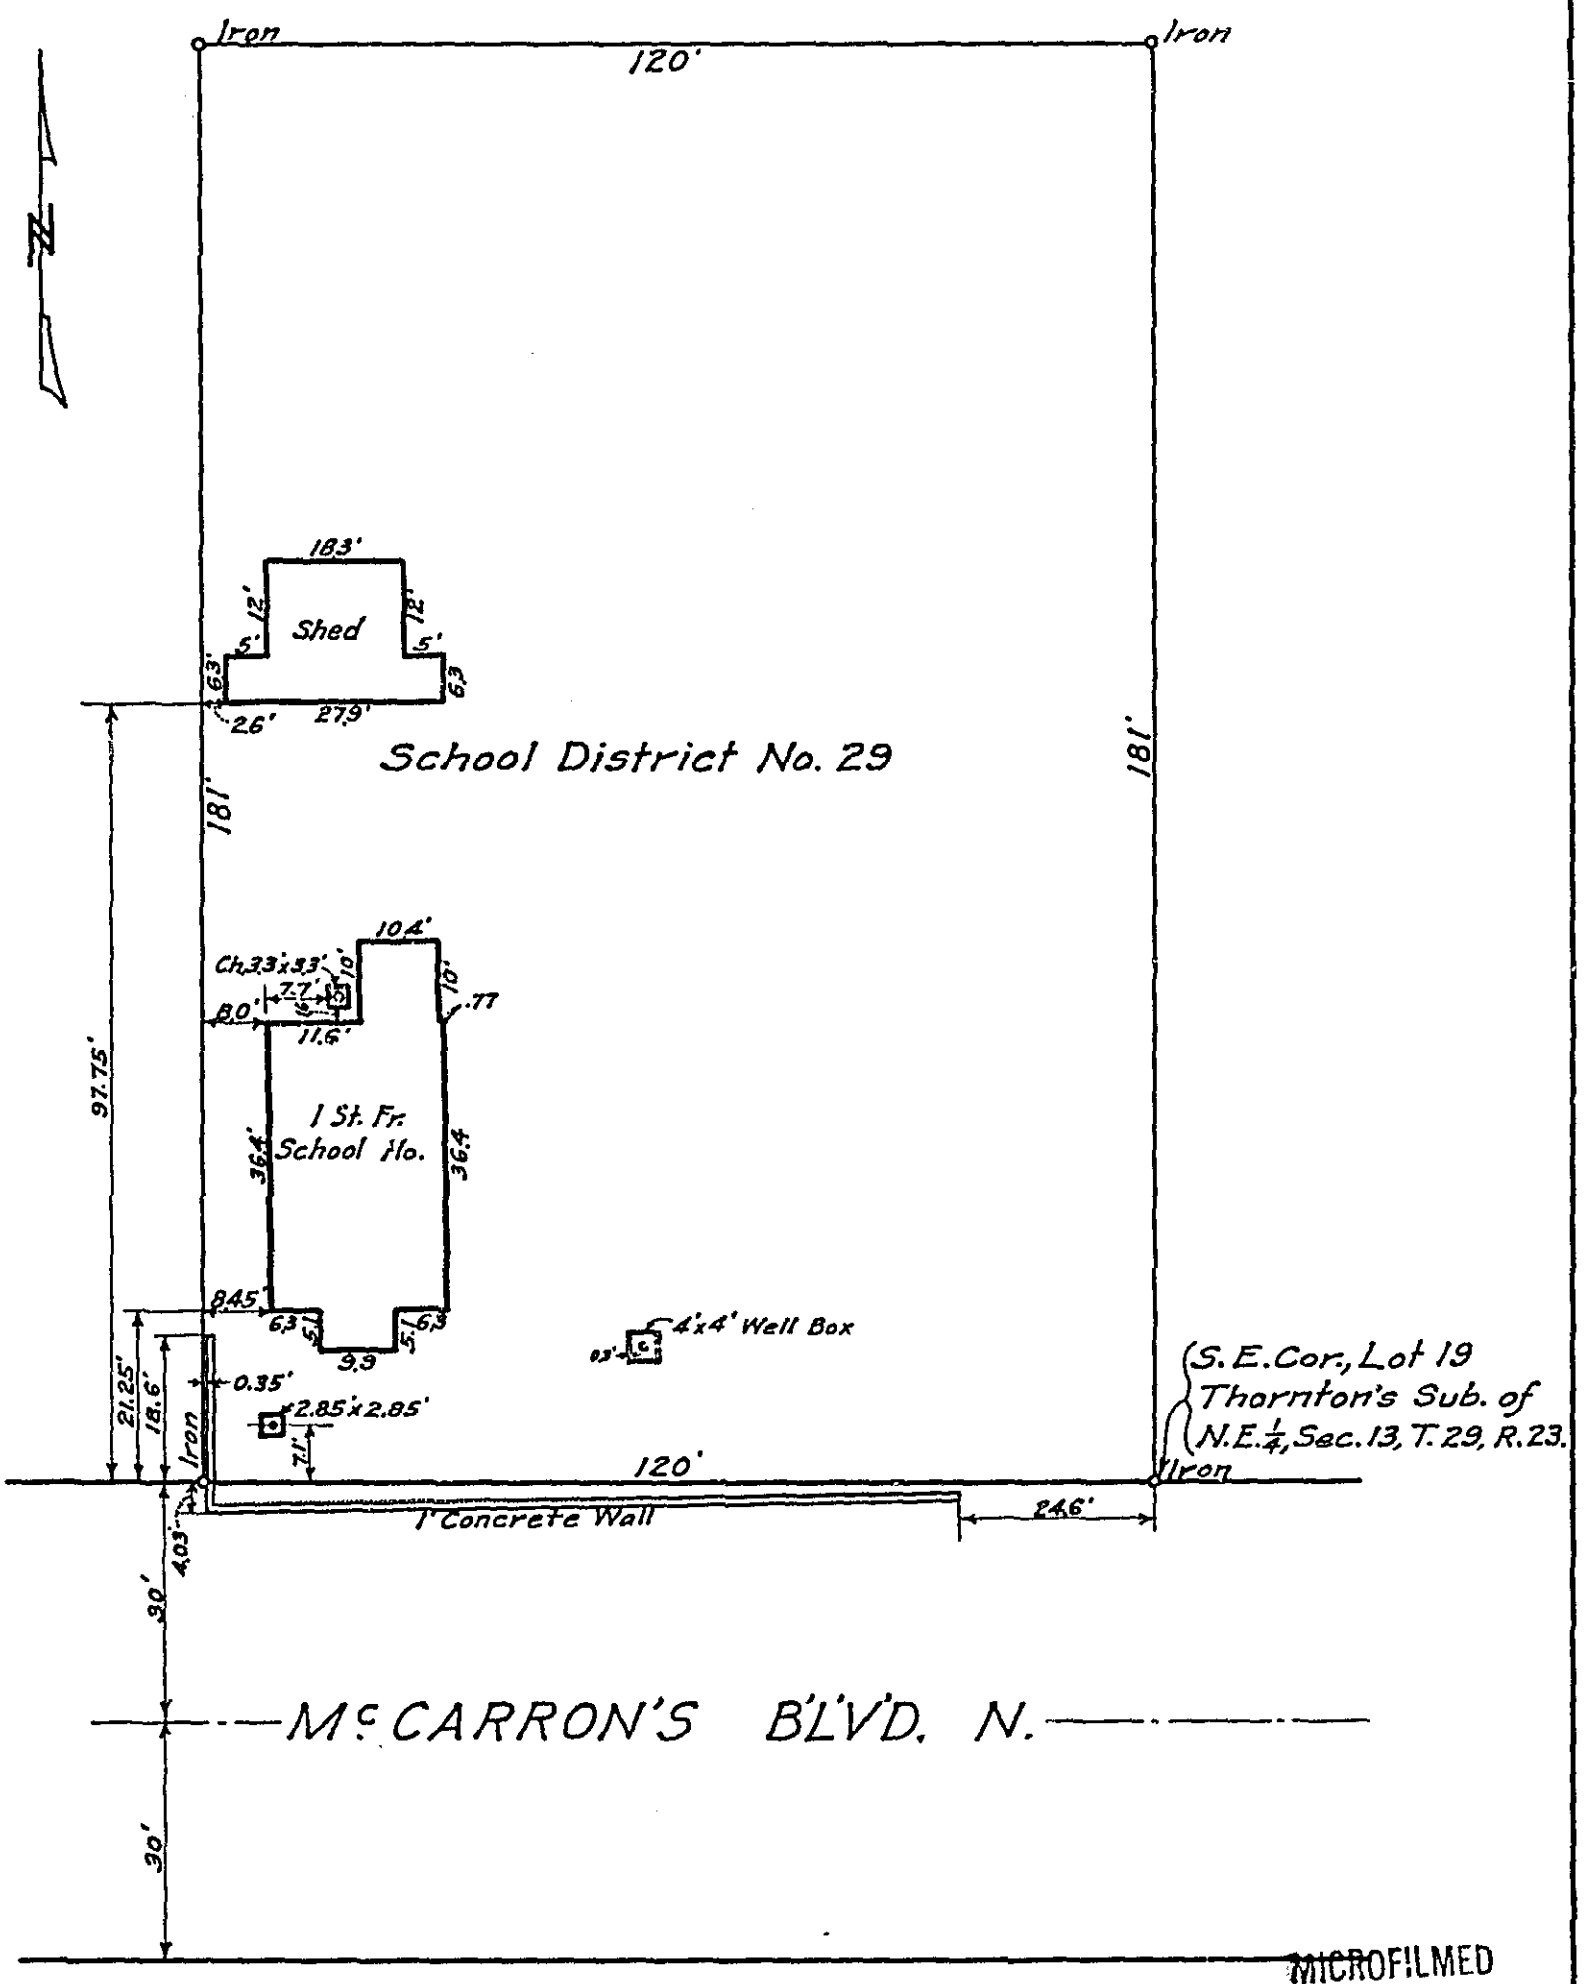

MICROFILMED
RAMSEY CO. ENGR.

Aug. 6, 1934

694