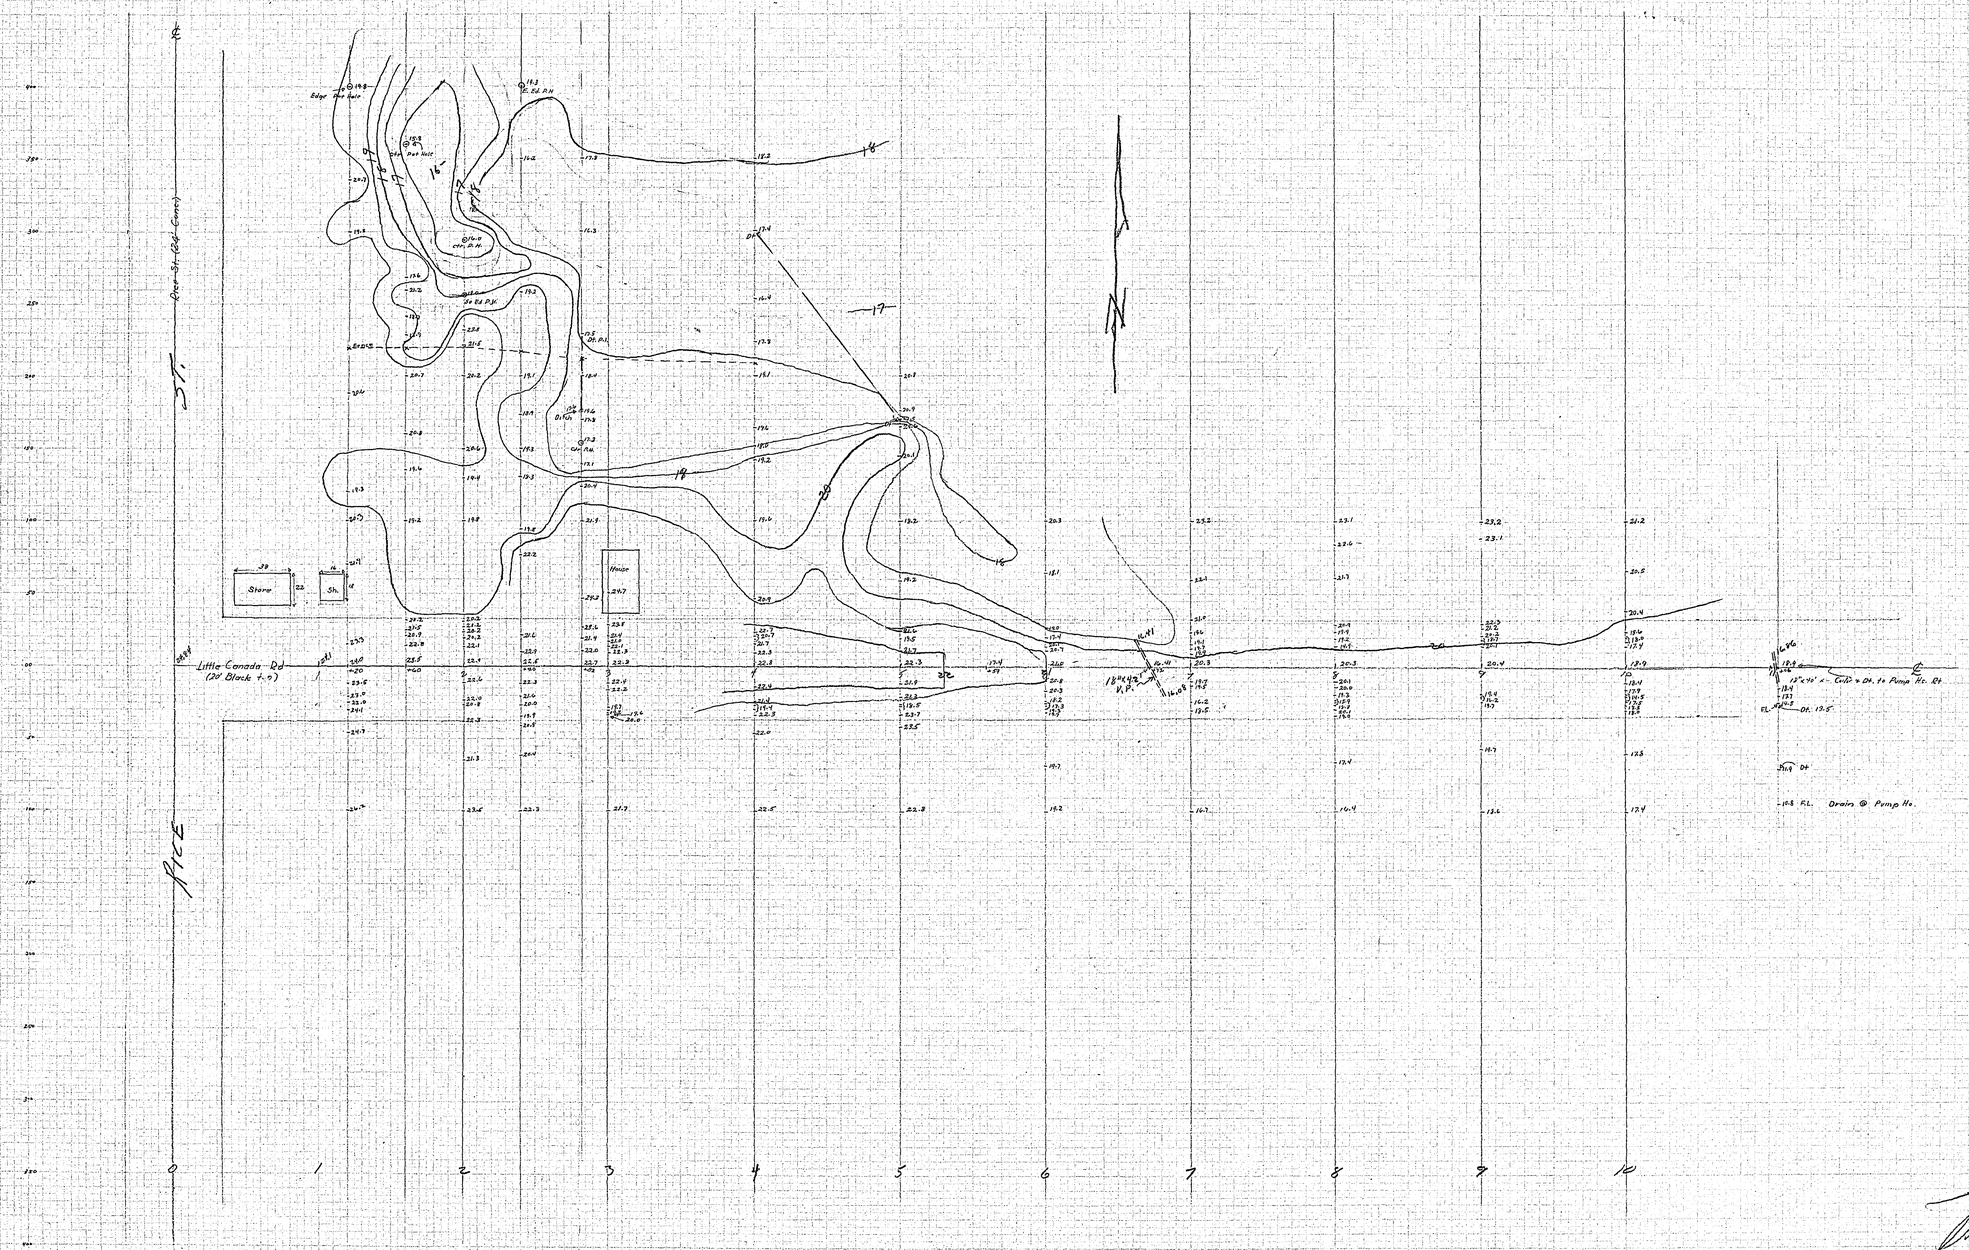

Drainage condition at Rice St. and Little Canada Rd.