



SE 1/4 SEC. 24, T. 30, R. 23.

NE 1/4 SEC. 24, T. 30, R. 23

NE 1/4 SEC. 24, T. 30, R. 23

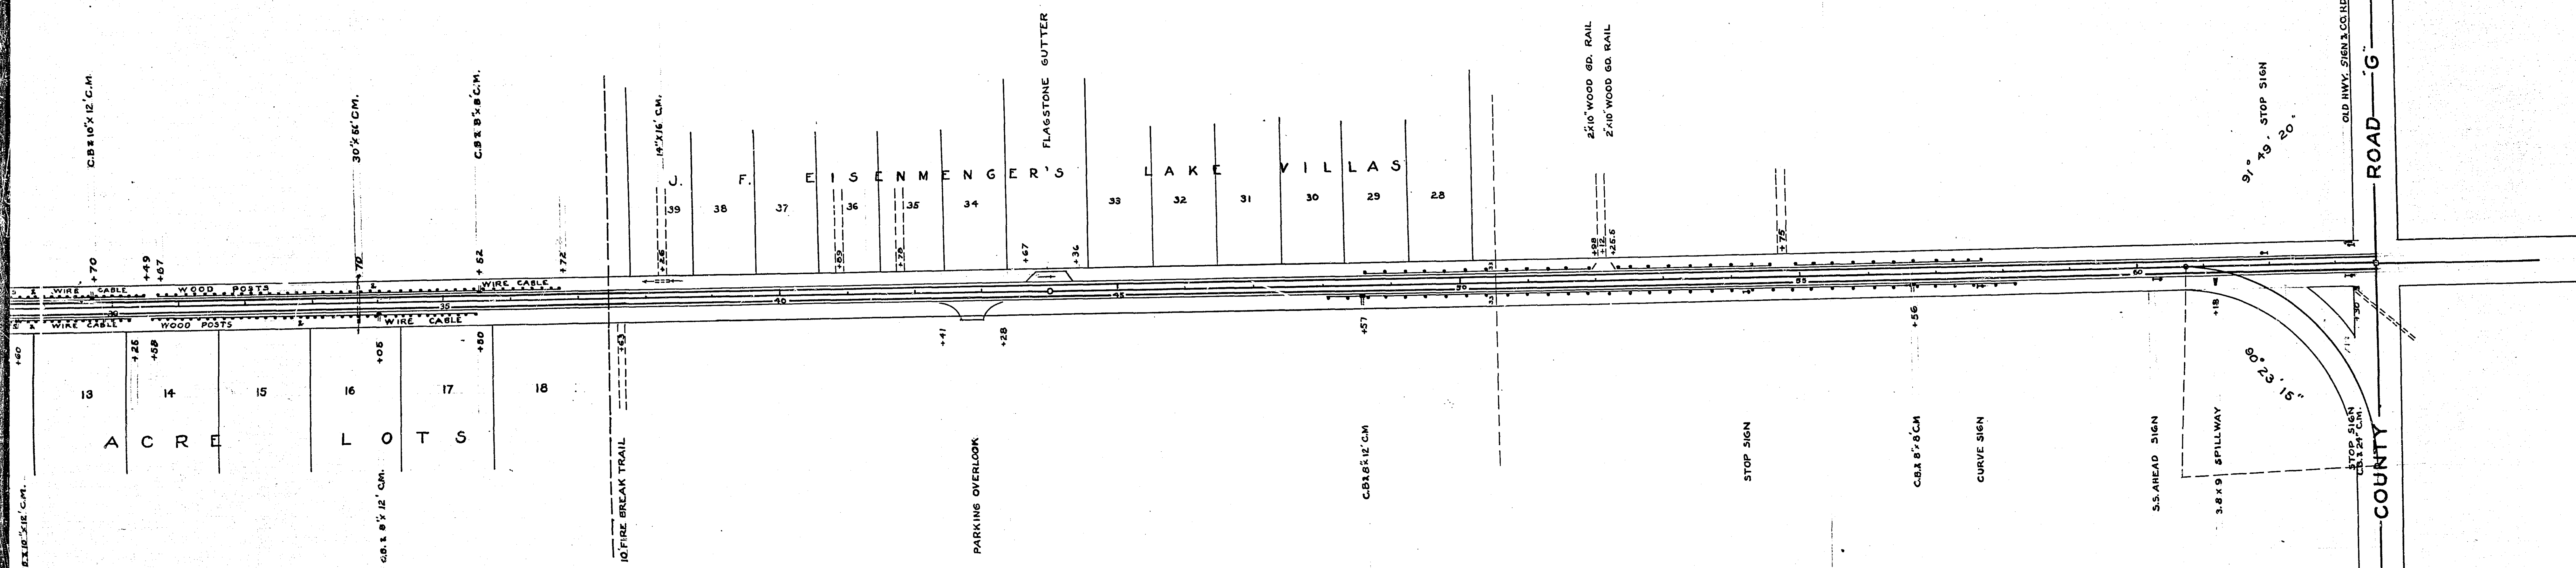
SE 1/4 SEC. 13, T. 30, R. 23

SW 1/4 SEC. 19, T. 30, R. 22

NW 1/4 SEC. 19, T. 30, R. 22

NW 1/4 SEC. 19, T. 30, R. 22

SW 1/4 SEC. 18, T. 30, R. 22



P.O.T. 31+85.99
HOLE IN PAVE.

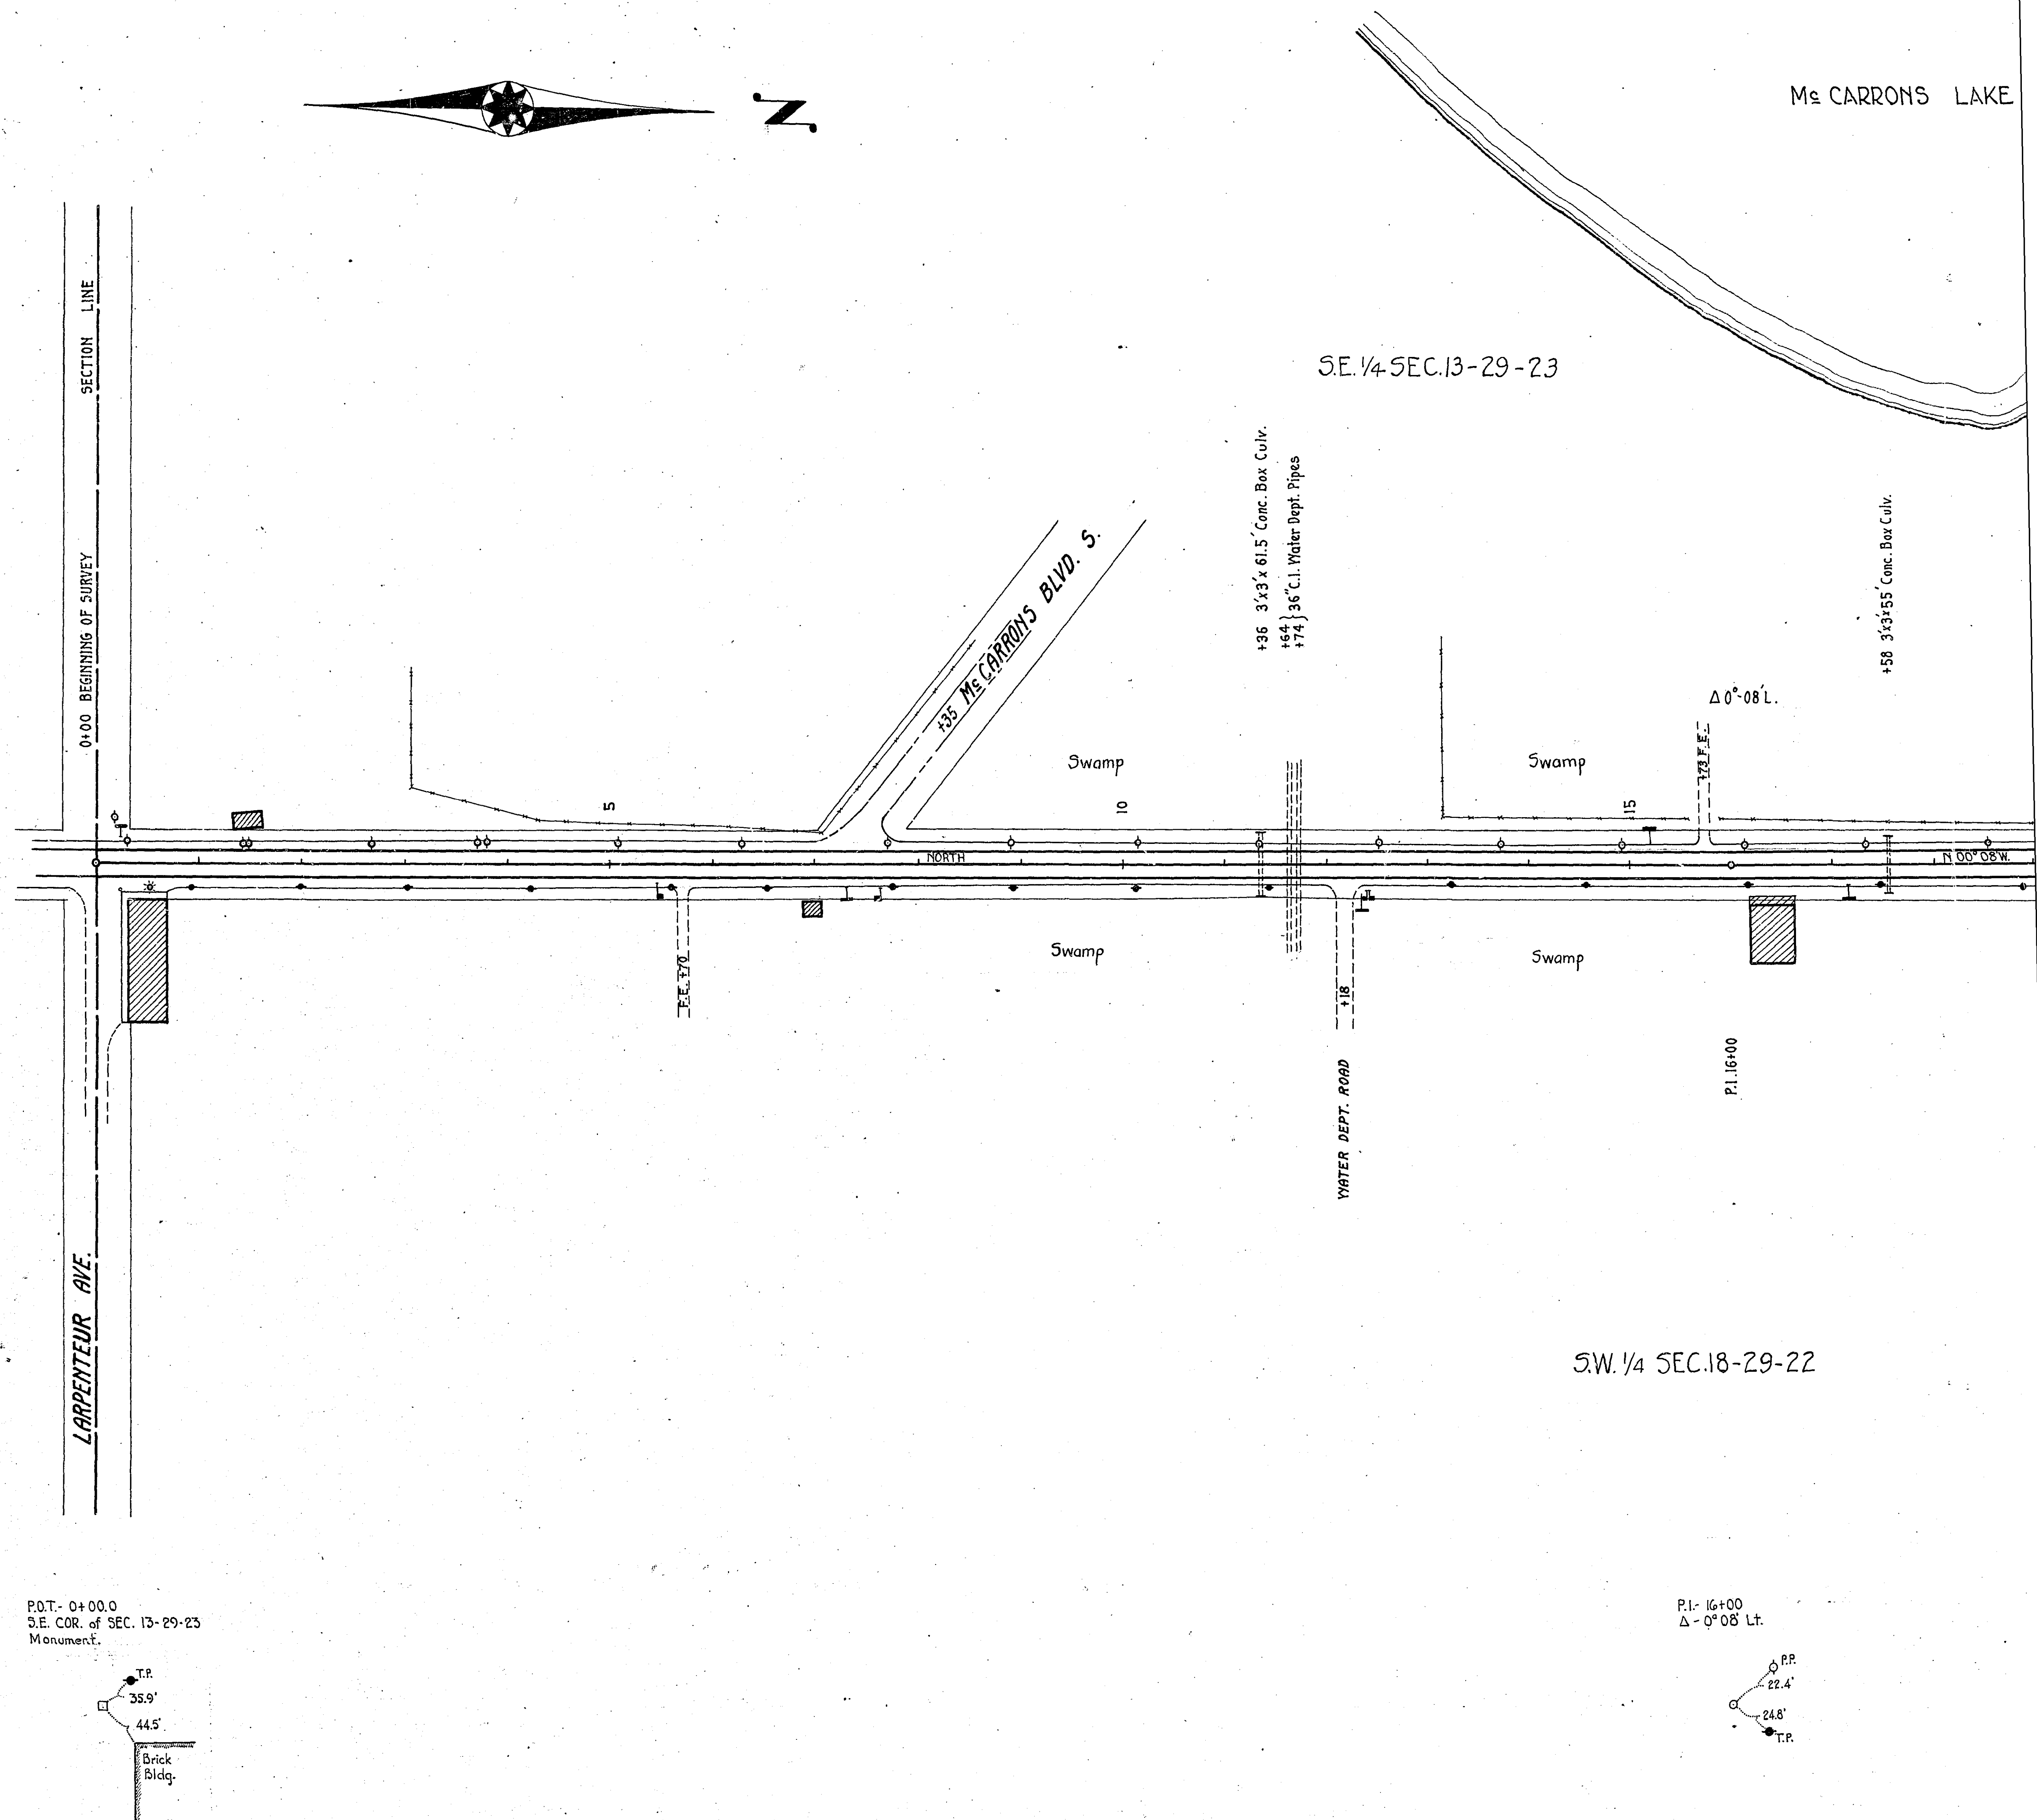
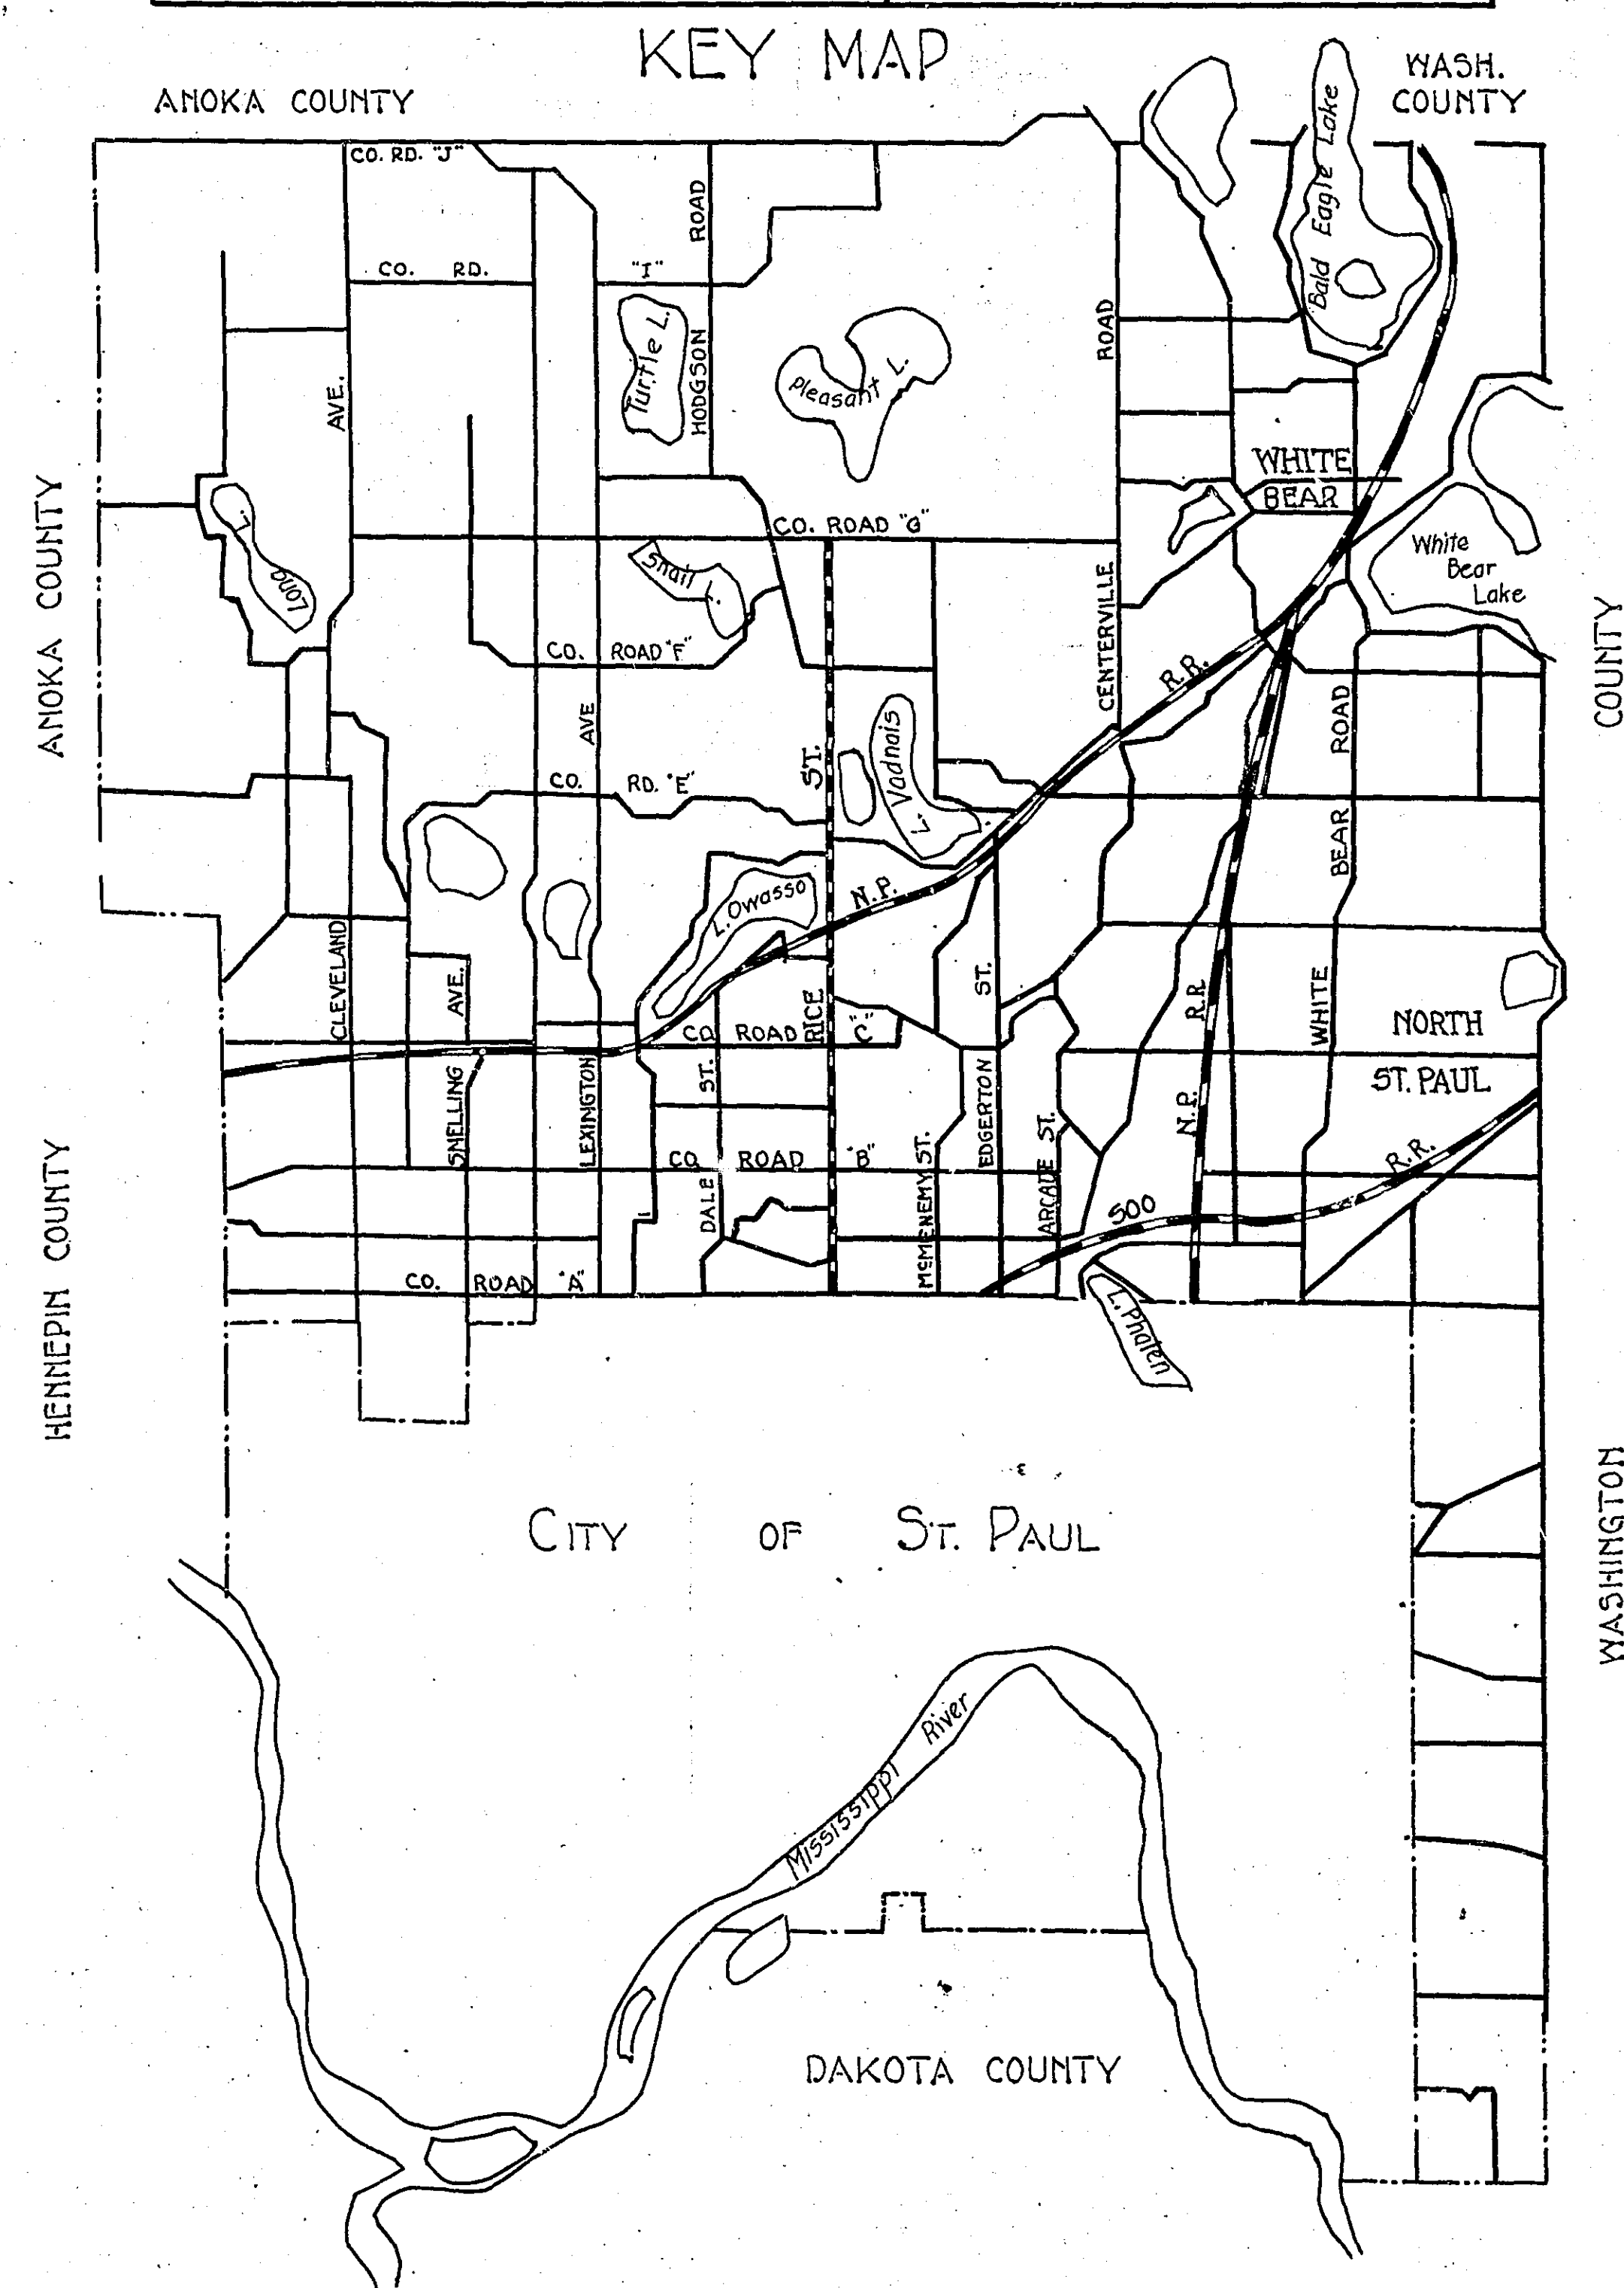
47.49
53.20

38.50 CONG. POST.
39.41
67.62 CONG. POST.
WATER DEPT. MONT. Δ









ROAD MAP
RICE ST.
FROM HODGSON ROAD TO CO. RD. G
ROAD NO. ~~1~~ 1

OFFICE OF COUNTY ENGINEER
RAMSEY COUNTY
PROGRESSIVE ROAD MAP
OF
RICE ST.
FROM NORTH CITY LIMITS TO CO. RD. "G".


TOTAL LENGTH 31,821.25 FT. = 6.03 MI.
Scale - 1 in. = 100 ft.

[illegible]

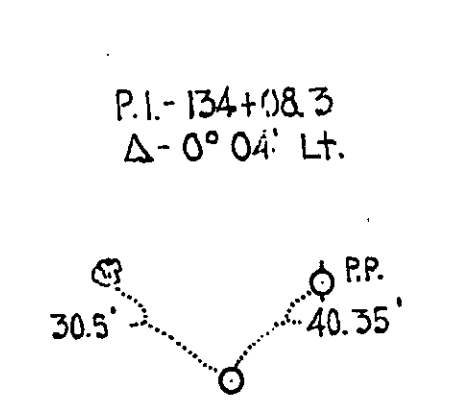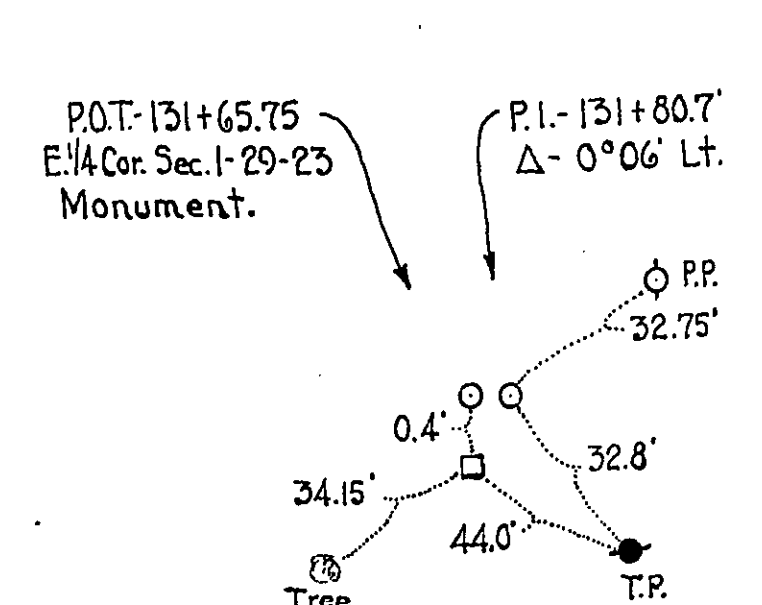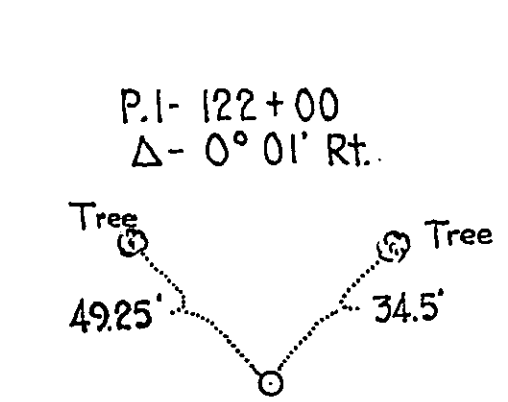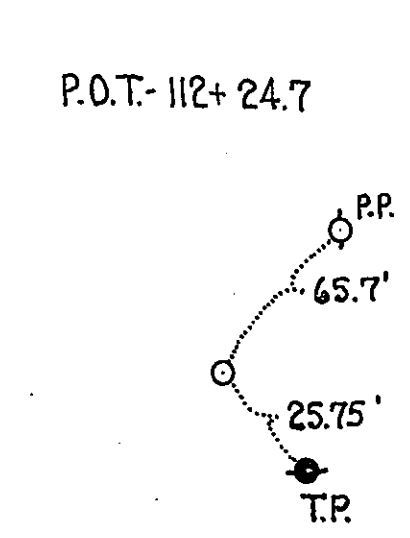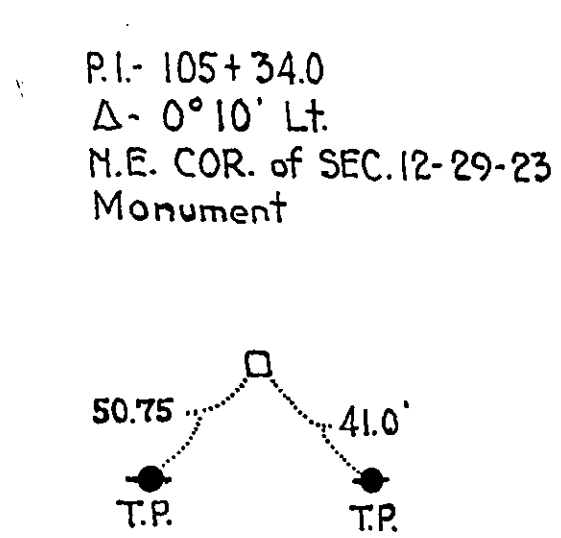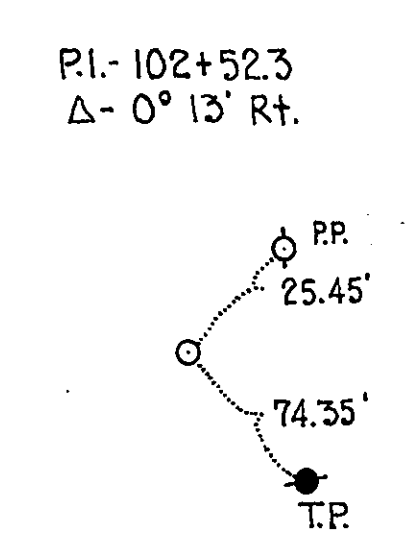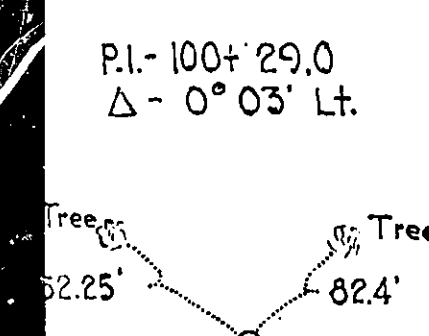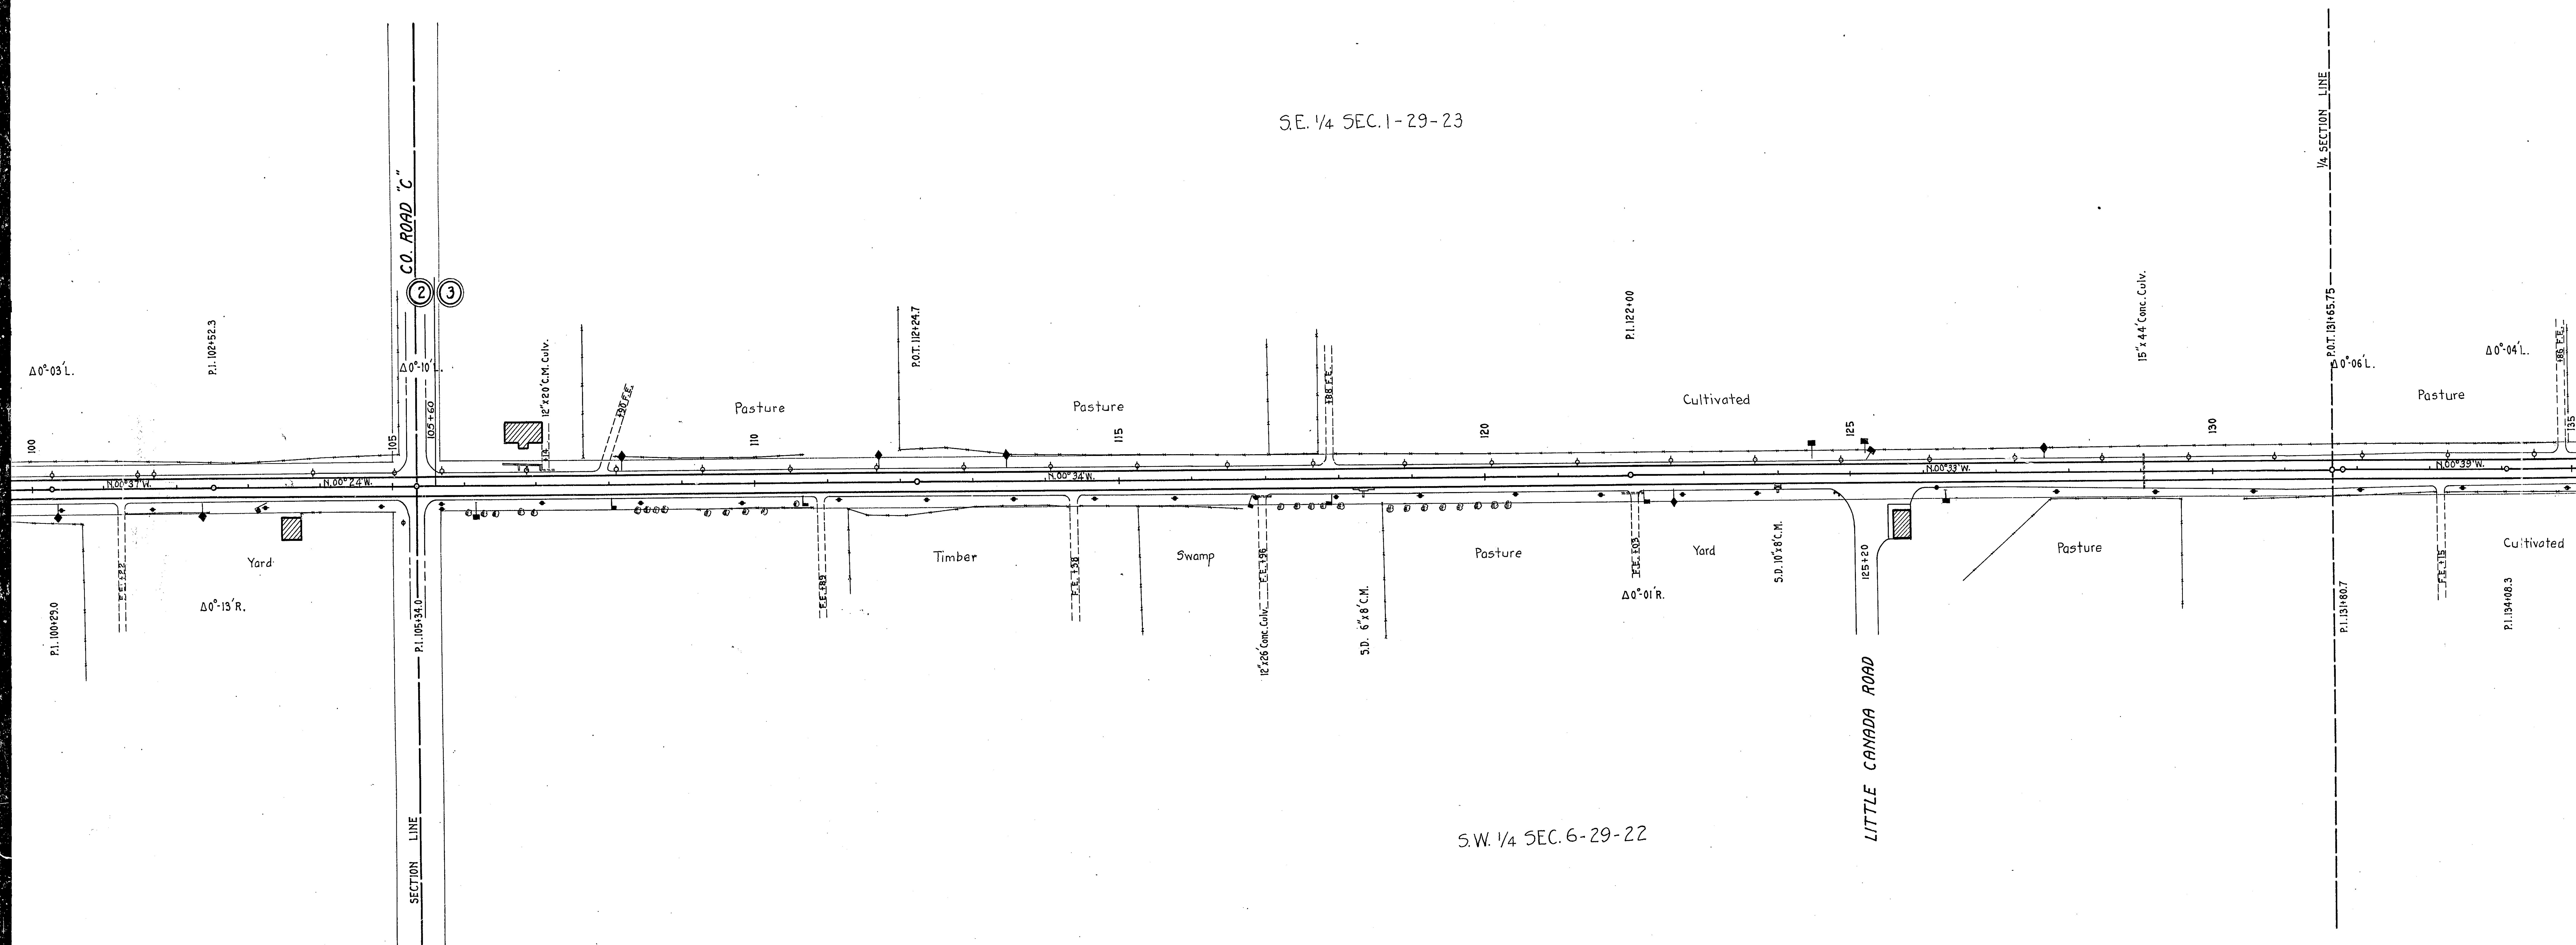20X F/12

[illegible]

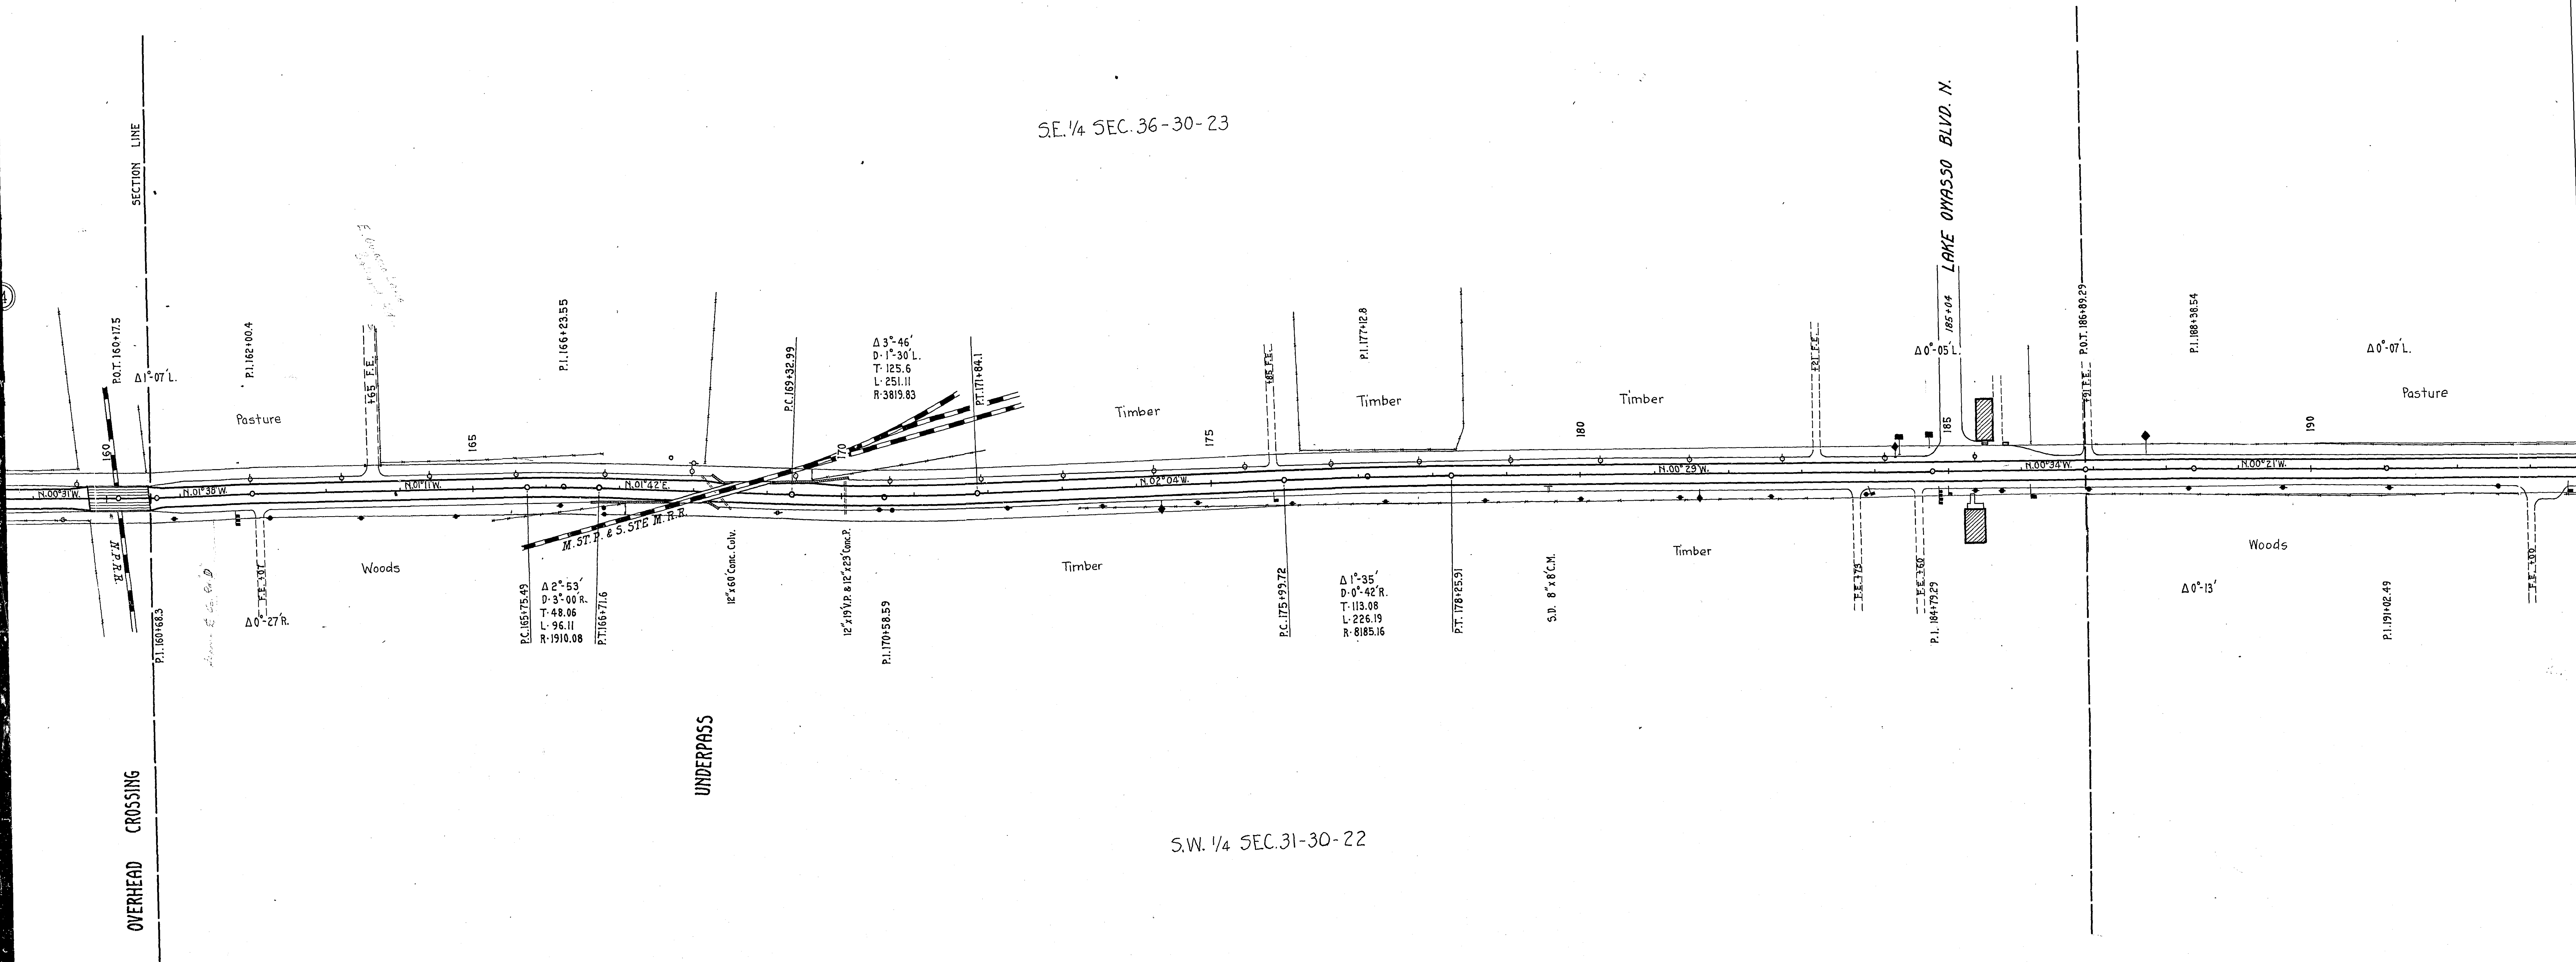F-5 / 1 2



S.W. 1/4 SEC. 31-30-22

P.O.T. 160+17.5
N.P.R. Xing.

P.I. 160+68.3
 $\Delta - 1^\circ 07' L.$

P.I. 162+100.4
 $\Delta - 0^\circ 27' R.$

P.I. 166+23.55
 $\Delta - 2^\circ 53' R.$

P.I. 170+58.59
 $\Delta - 3^\circ 46' L.$

P.I. 177+12.8
 $\Delta - 1^\circ 35' R.$

P.I. 184+79.29
 $\Delta - 0^\circ 05' L.$

P.O.T. 186+89.29
E. 1/4 COR. of SEC. 36-30-23
Monument.

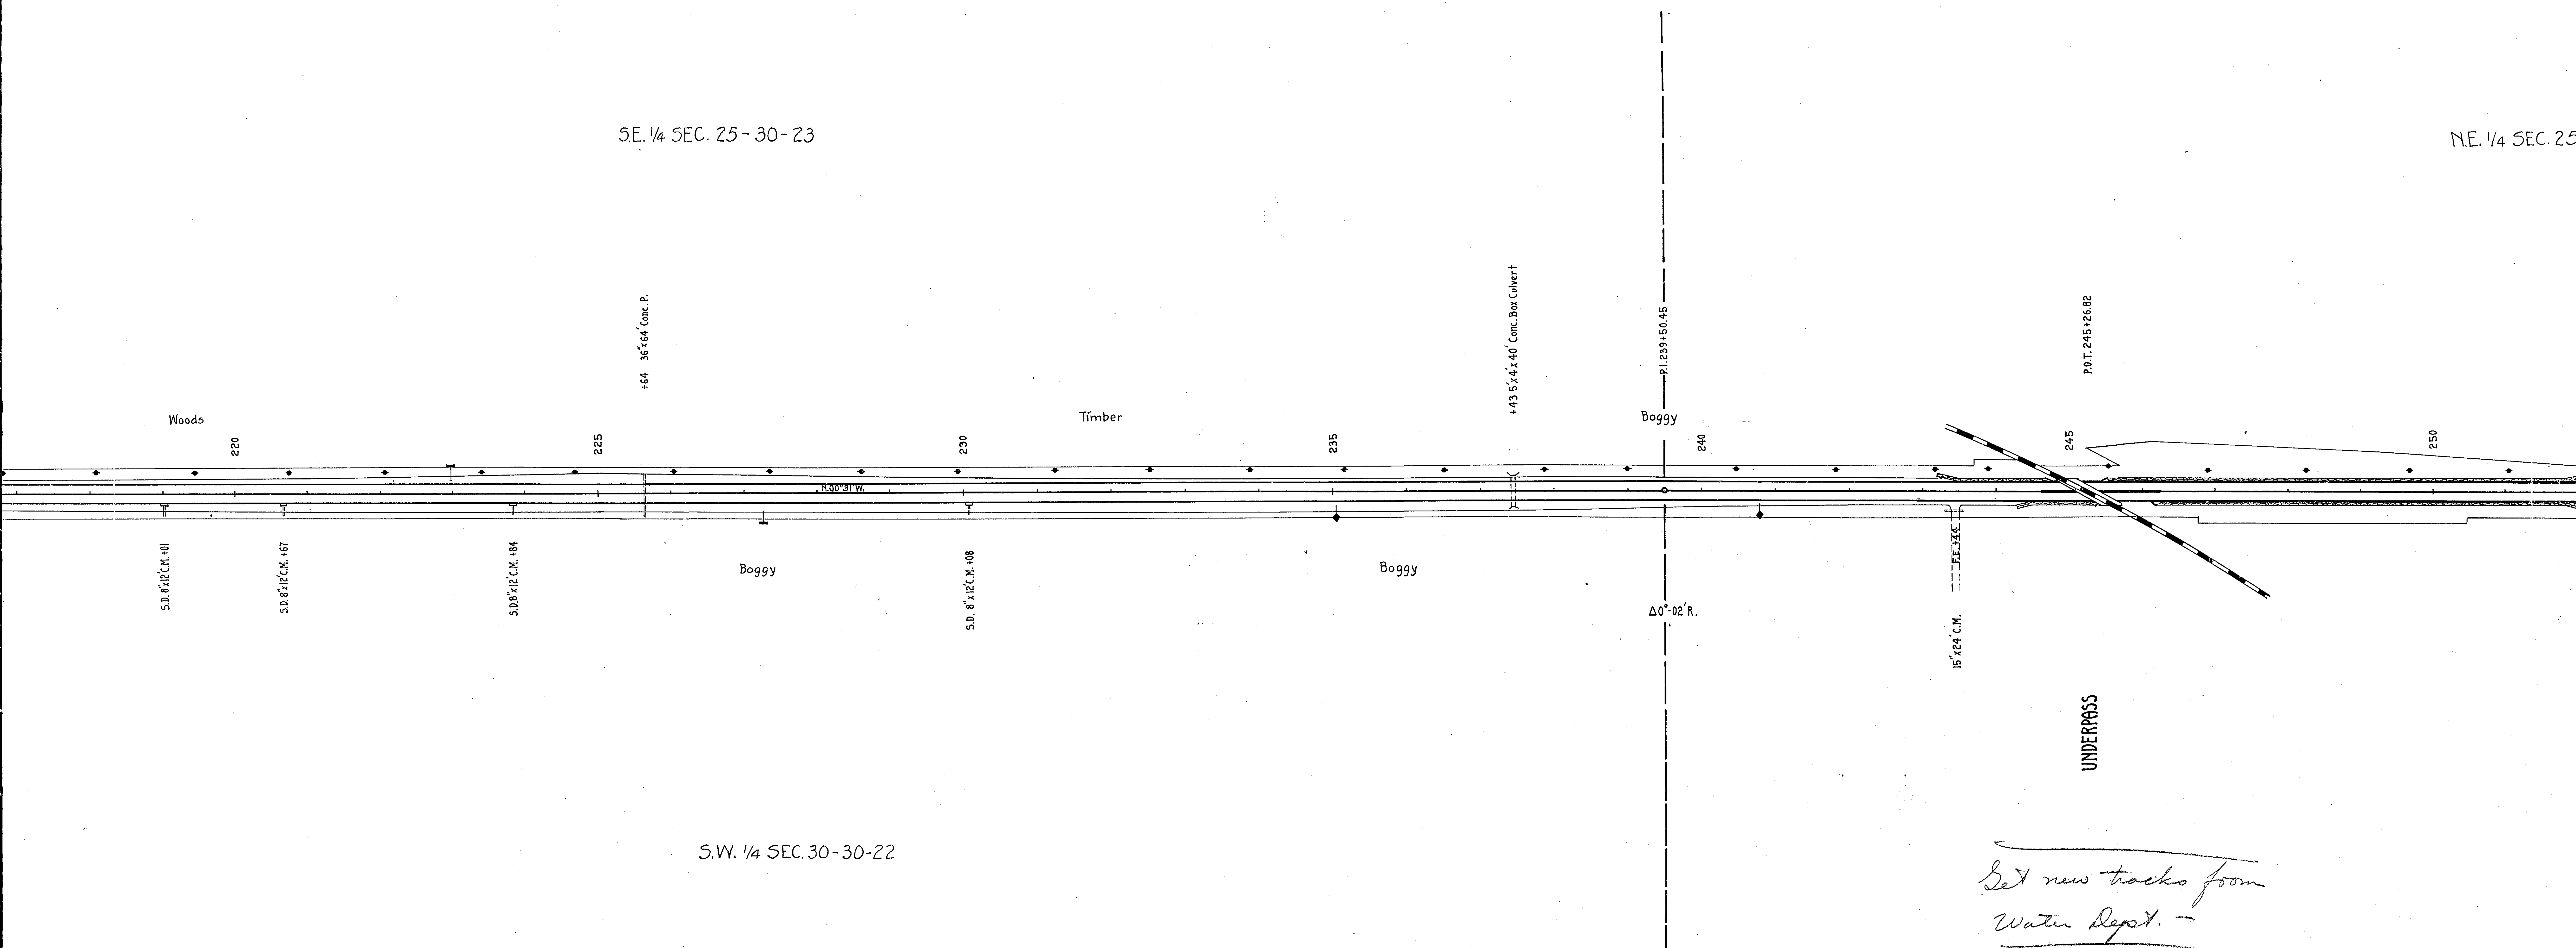
P.I. 188+38.54
 $\Delta - 0^\circ 13' R.$

P.I. 191+02.49
 $\Delta - 0^\circ 07' L.$


F 7 / 1 2

SE 1/4 SEC. 25-30-23

NE 1/4 SEC. 25-




S.W. 1/4 SEC. 30-30-22

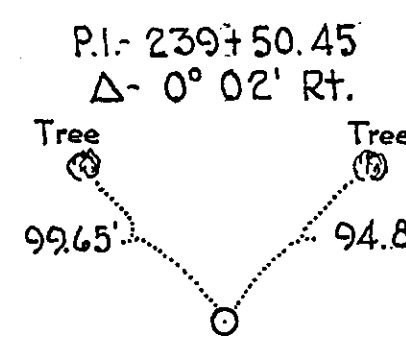

SUMMARY									
DRAINS		CULVERTS							
TYPE	NO.	C.M.	P ₁	P ₂	V.P.	C.I.P.	SE		
		4-8x12	15+38	30+56					
		3-8x16	15+25	30+64					
		15x20							

S.E. 1/4 SEC. 24-30-23

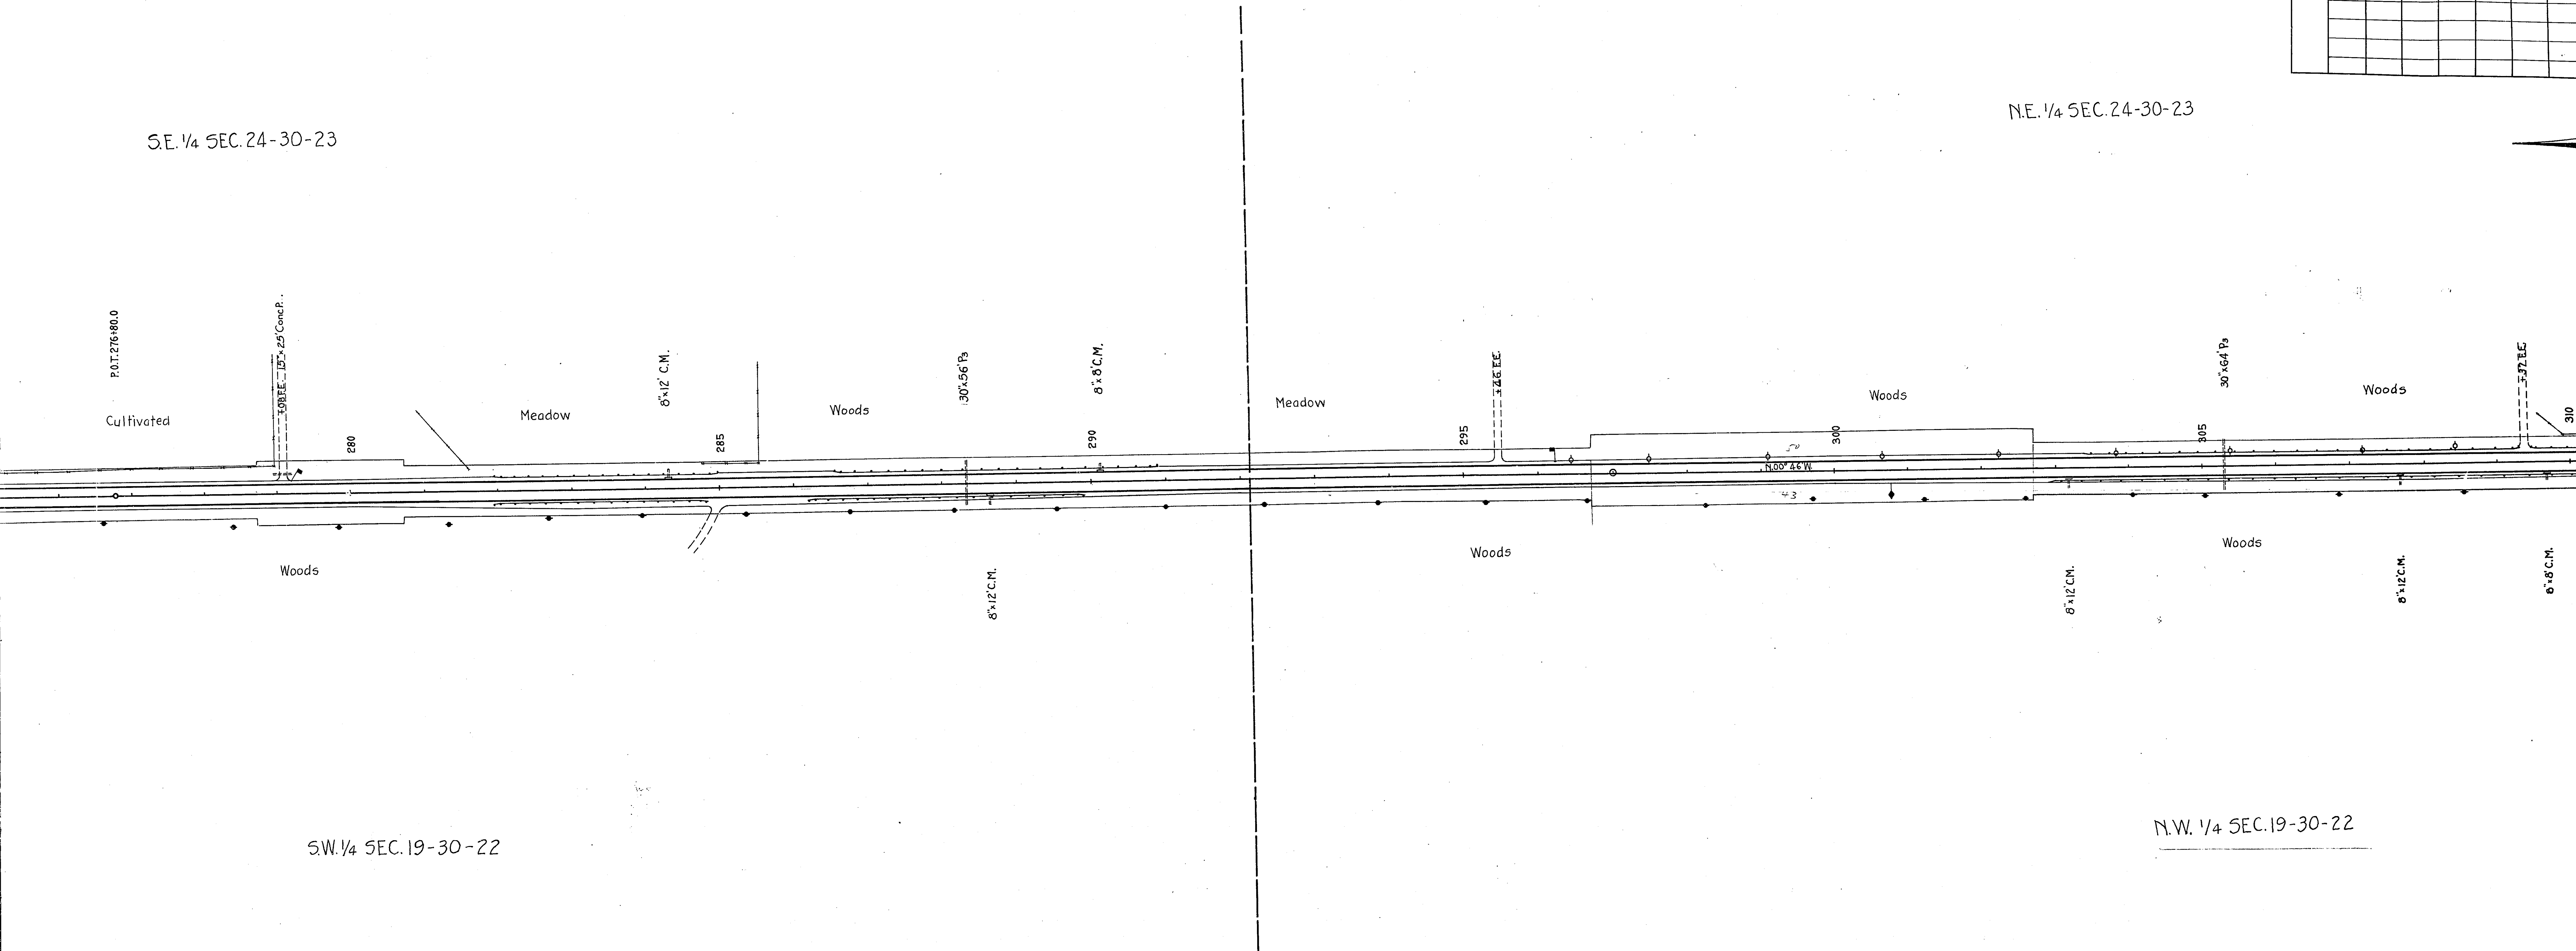
N.E. 1/4 SEC. 24-30-23



S.W. 1/4 SEC. 19-30-22

N.W. 1/4 SEC. 19-30-22

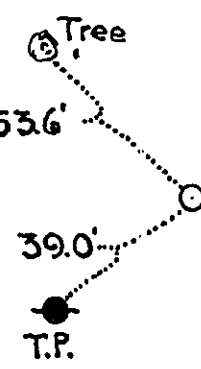P.O.T. 276+80.0



P.O.T. 297+00

