


NE 1/4 SEC. 16, T.30, R.22

SE 1/4 SEC. 16, T.30, R.22

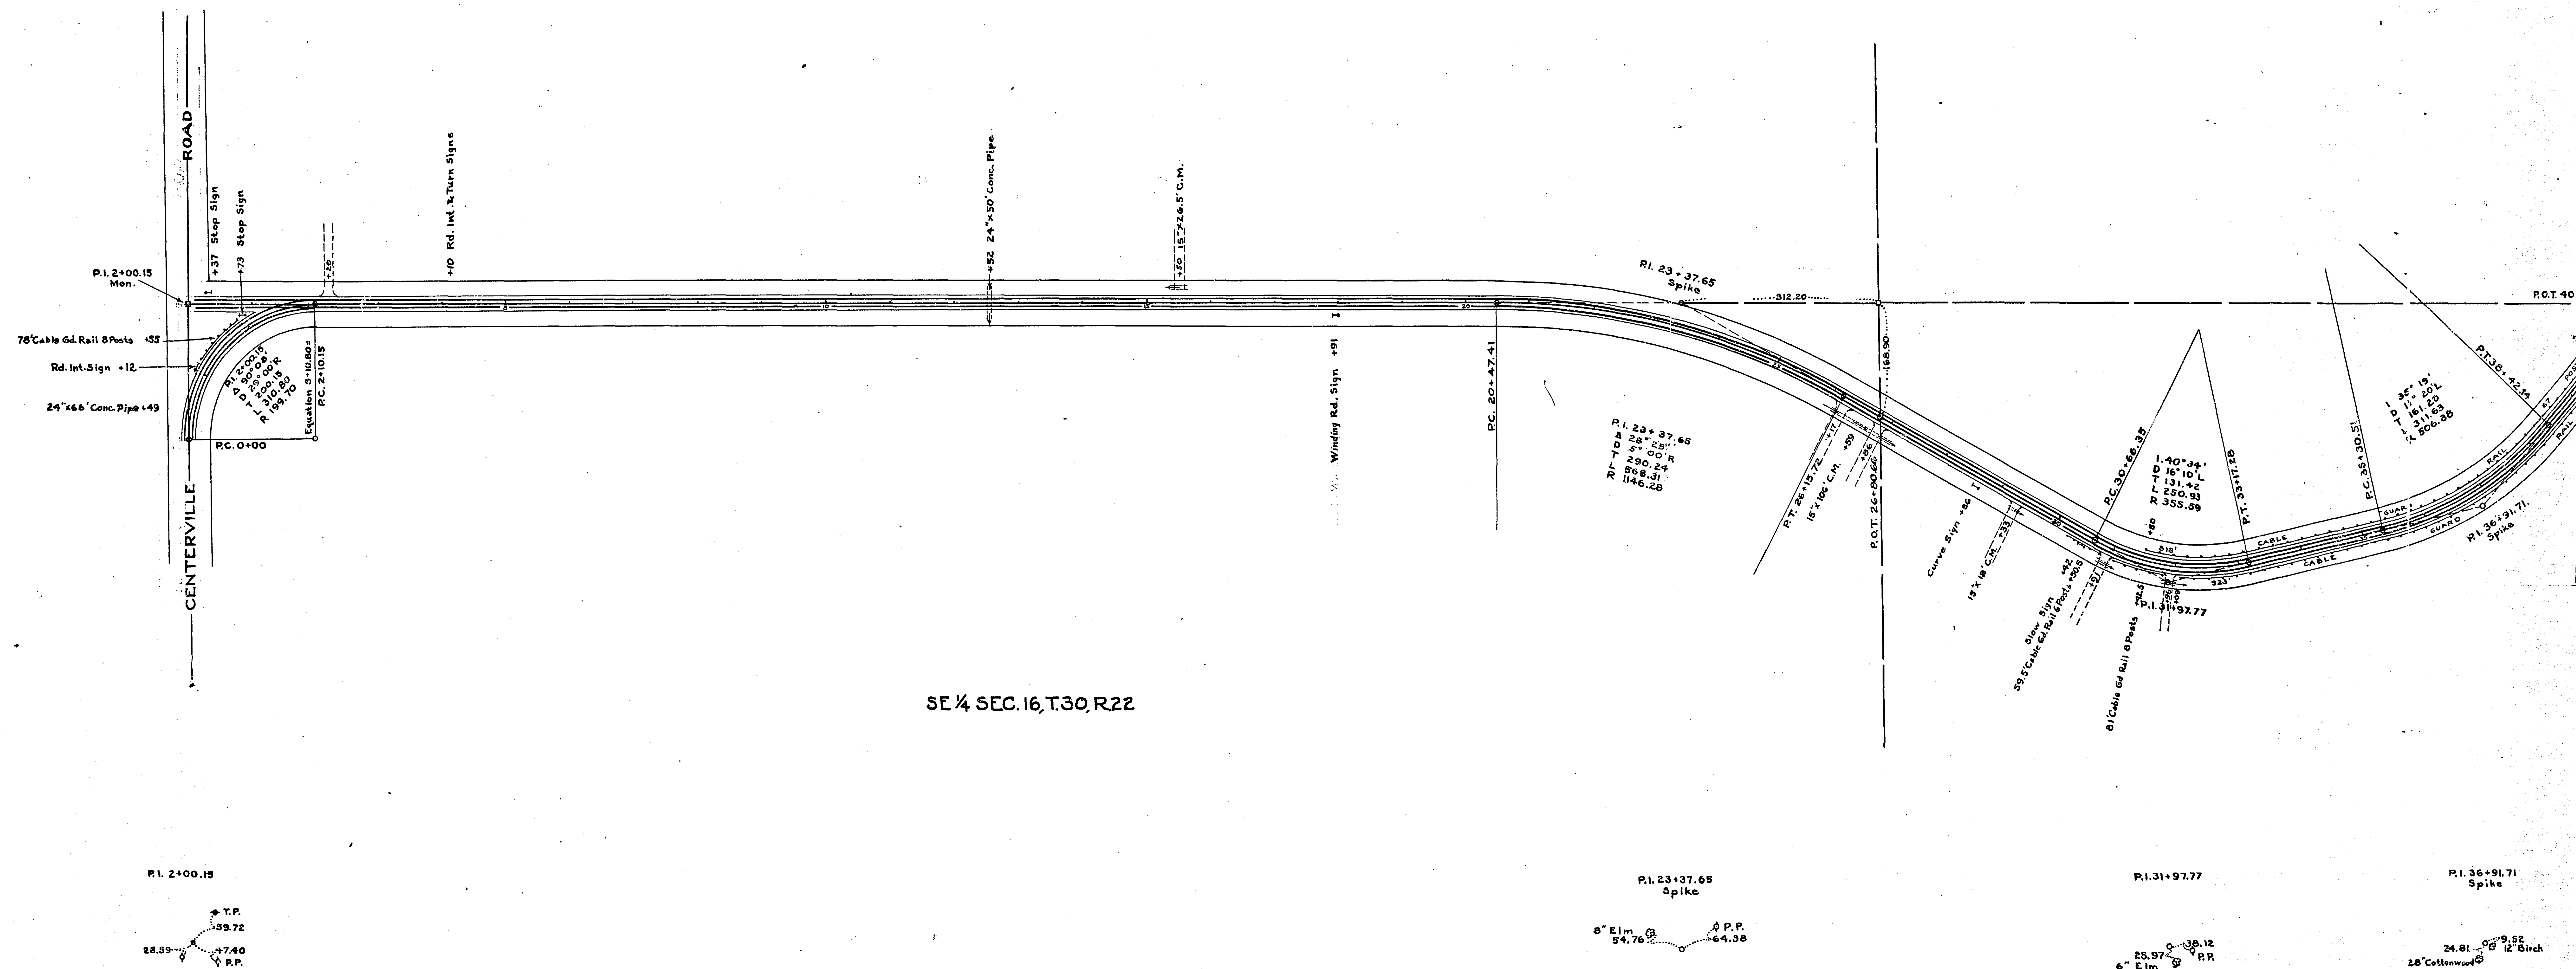

ROAD MAP
 BIRCH LAKE BLVD. NO.
 ROAD NO. 11

NW 1/4 SEC. 15, T. 30, R. 22

NE 1/4 SEC. 15, T. 30, R. 22

SW 1/4 SEC. 15, T. 30, R. 22


SE 1/4 SEC. 15, T. 30, R. 22

P.I. 63+76.20

30.52' P.P.
39.60' 8" Tree

P.I. 80+68.60

6.66' Edge Cent.
121.18' Fence Post

 

ROAD MAP
Birch Lake Blvd. No.
From Centerville Rd. to Bald Eagle Ave
Road No. 11


P.I. 80+68.60
Edge Conc.
121.15
Fence Post

P.I. 84+76.87
Drill Hole
Hyd.
142.98
92.05
4" Pop.

P.O.T. 112+23.12
End of Survey

32.81
L.P.
33.34
G.P.

NW 1/4 SEC. 14, T. 30, R. 22

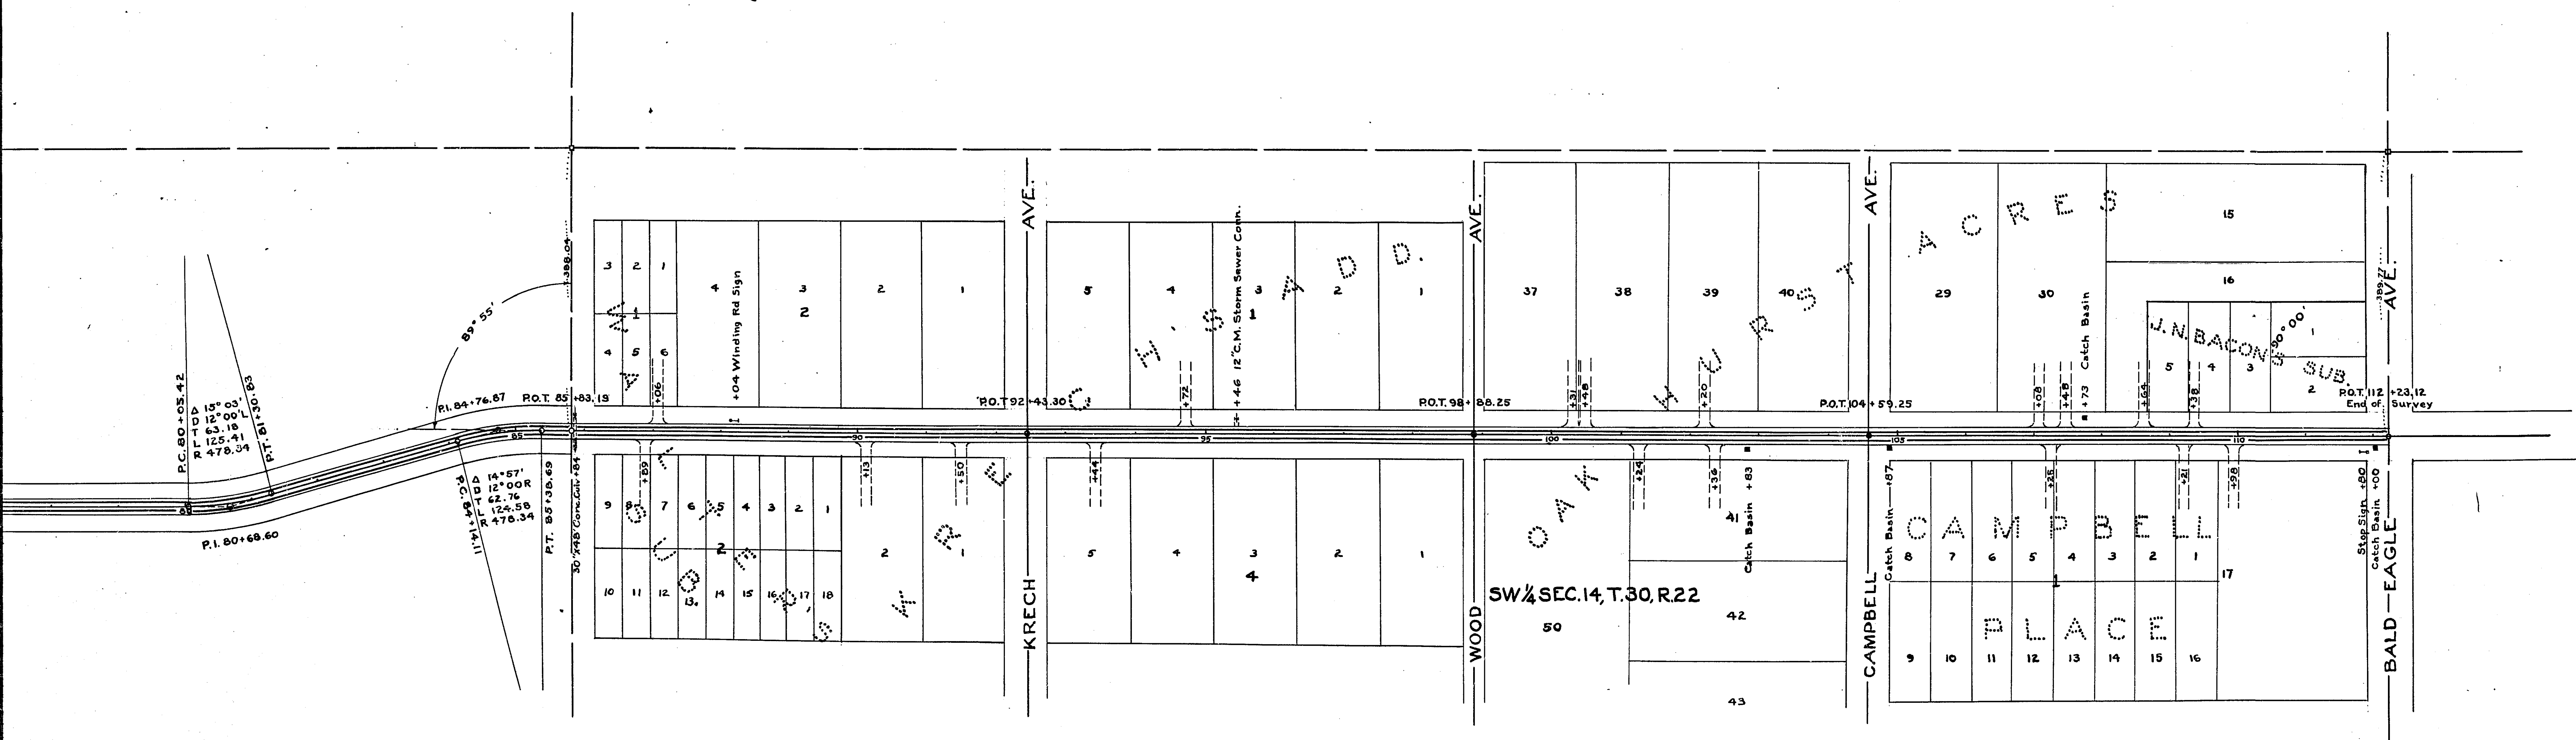

ROAD MAP
Birch Lake Blvd. No.
From Centerville Rd. to Bald Eagle Ave
Road No. 11