

NW 1/4 SEC. 32, T. 30 R. 23

SE 1/4 SEC. 29, T. 30 R. 23

$\Delta 20^{\circ} 27'$
D. 2° 00'
T. 516.8
L. 1022.5
R. 2864.9

$\Delta 33^{\circ} 33'$
D. 6° 00'
T. 288.0
L. 559.1
R. 955.4

6	7	8	9	10	6	7	8	9	10	6	7	8	9	10
5	4	3	2	1	5	4	3	2	1	5	4	3	2	1

6	7	8	9	10	6	7	8	9	10	6	7	8	9	10
5	4	3	2	1	5	4	3	2	1	5	4	3	2	1

6	7	8	9	10
5	4	3	2	1

NE 1/4 SEC. 32, T. 30 R. 23

SE 1/4 SEC. 29, T. 30 R. 23

NEW BRIGHTON

0+00 Spike
T.P.
54.75
50.60
P.R.


14+42.61
Mon.
T.P.
25.63
27.63
P.R.

25+19.10 Spike
63.15
65.8
14" O.K.
12" O.K.


ROAD MAP
LONG LAKE ROAD

FROM STA. 0+00 ON S.T.H. #8 TO STA. 25+19.10 ON
S.T.H. #8
AND FROM 603.2 N. OF CENTER SEC. 29-23-30 TO
N. COUNTY LINE





ROAD NO. 12

 

N.W. 1/4 SEC. 29 T. 30 N. R. 23 W.

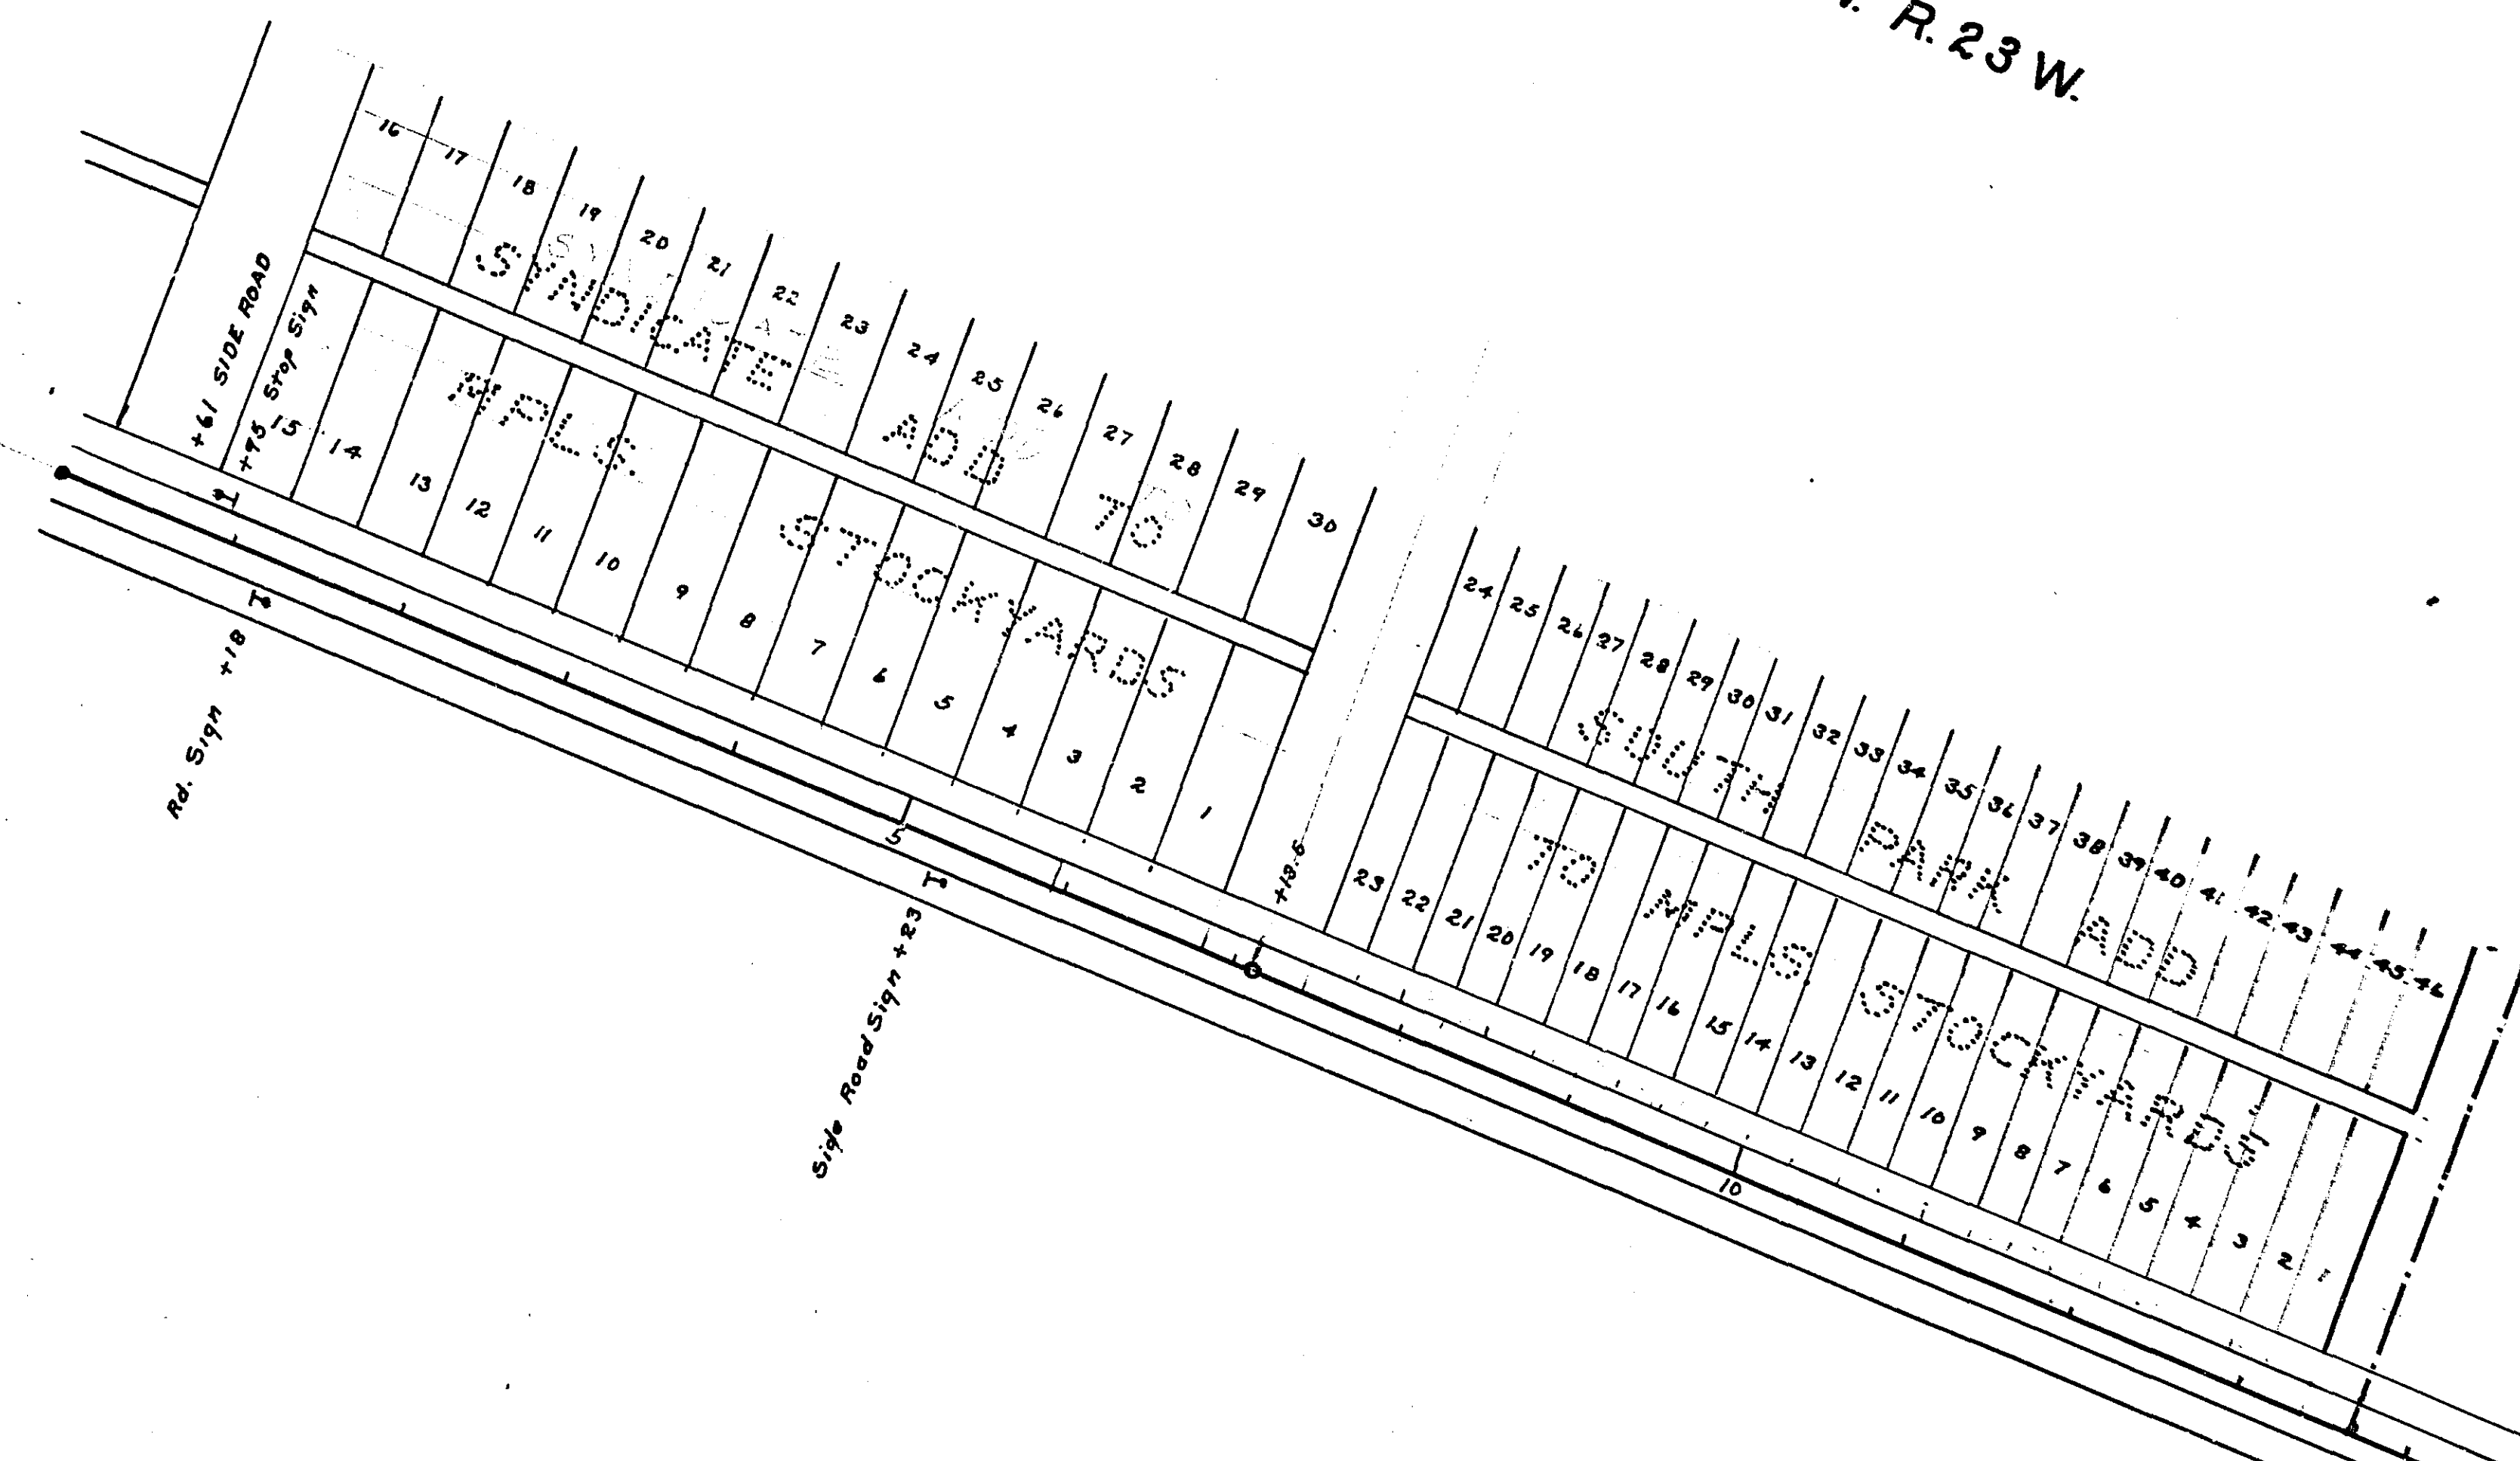

N.E. 1/4 SEC. 29 T. 30 N. R. 23 W.

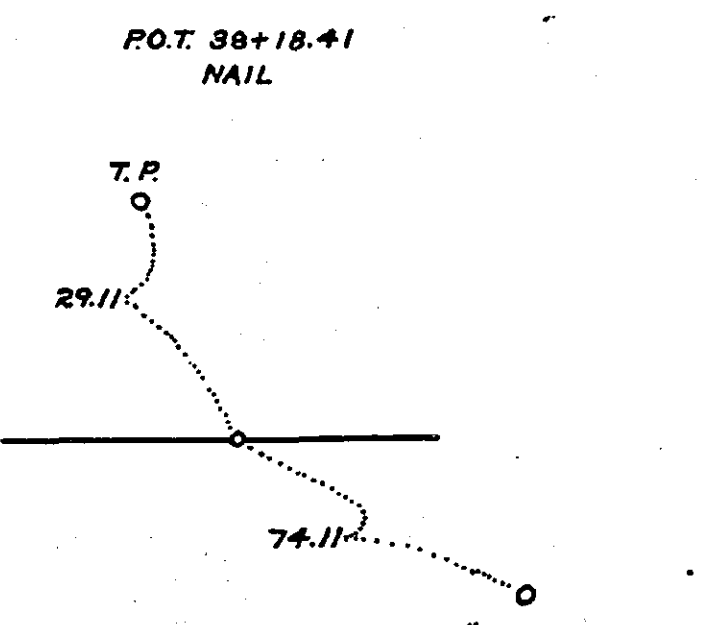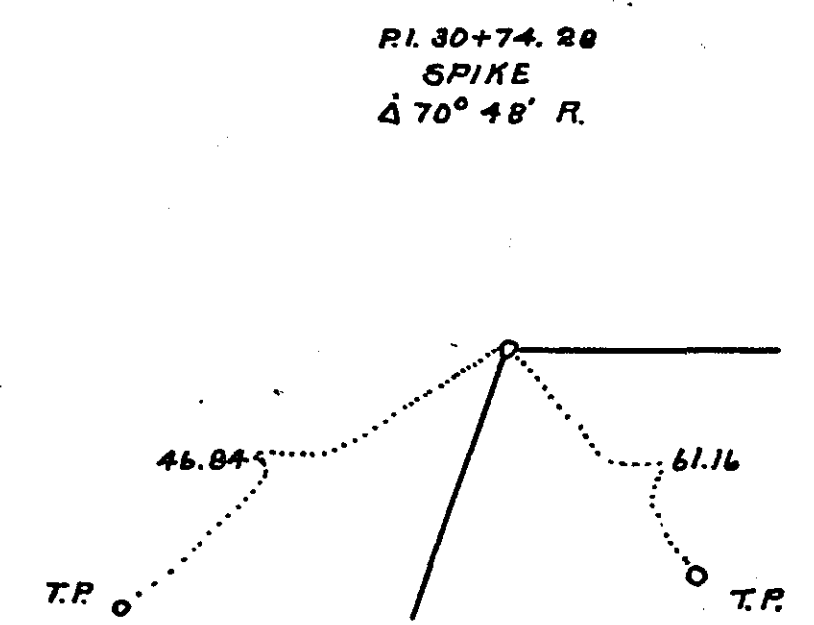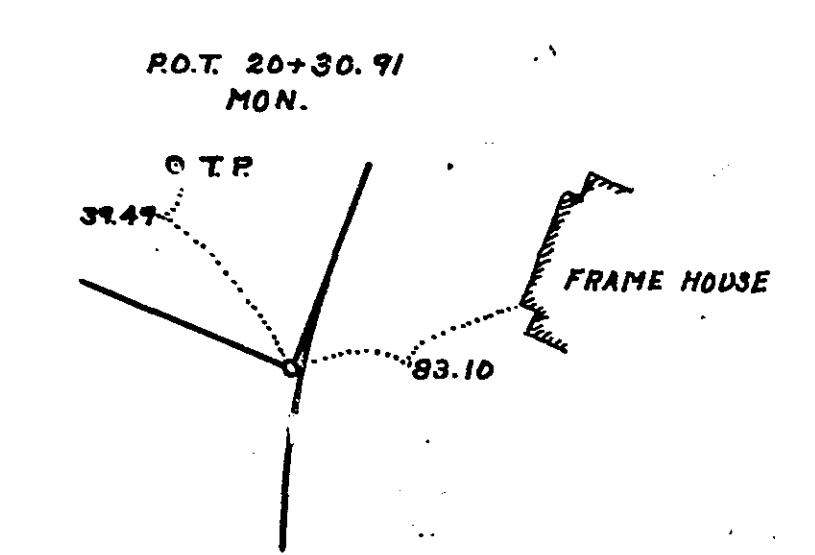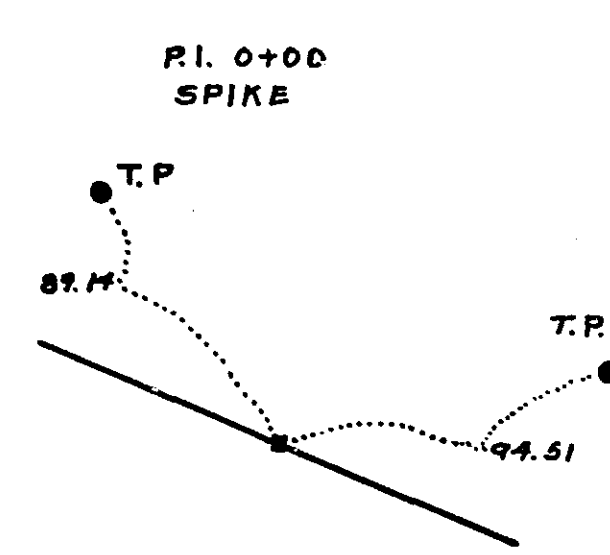

ROAD MAP
LONG LAKE ROAD
FROM STA. 0+00 ON S.T.H. #8 TO STA. 25+19.10 ON
S.T.H. #8
AND FROM 603.2 N. OF CENTER SEC. 29-23-30 TO
N. COUNTY LINE
ROAD NO. 12


N.E. 1/4 SEC. 19 T.30 N. R.23 W.




S.W. 1/4 SEC. 20 T.30 N. R.23 W.

N.W. 1/4 SEC. 20 T.30 N. R.23 W.

S.W. 1/4 SEC. 20 T.30 N. R.23 W.



ROAD MAP
LONG LAKE ROAD
FROM STA. 0+00 ON S.T.H. #8 TO STA. 25+19.10 ON
S.T.H. #8
AND FROM 603.2 N. OF CENTER SEC. 29-23-30 TO
N. COUNTY LINE
ROAD NO. 12

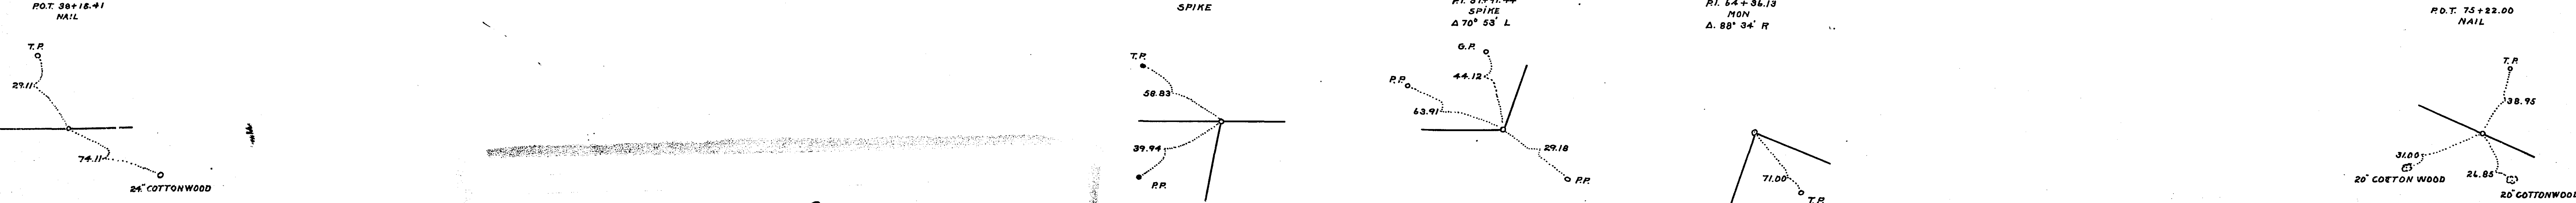

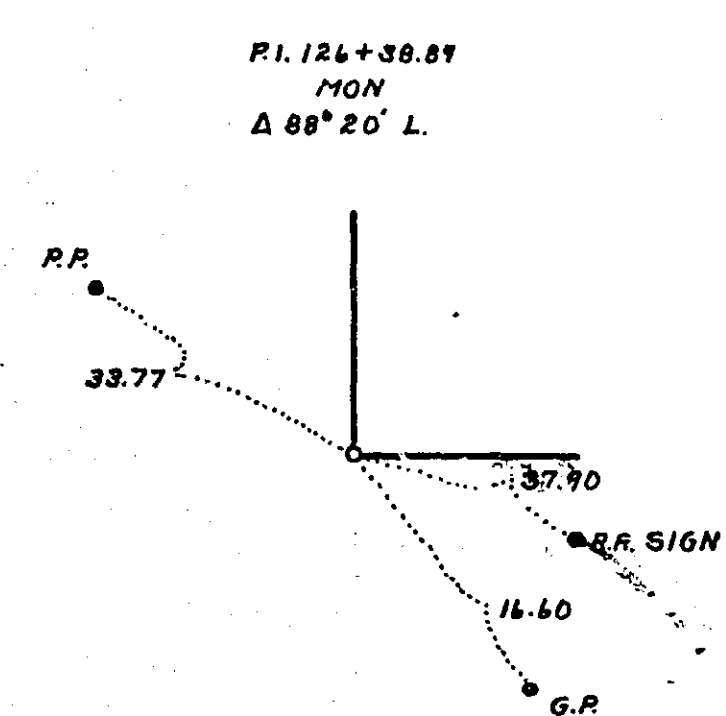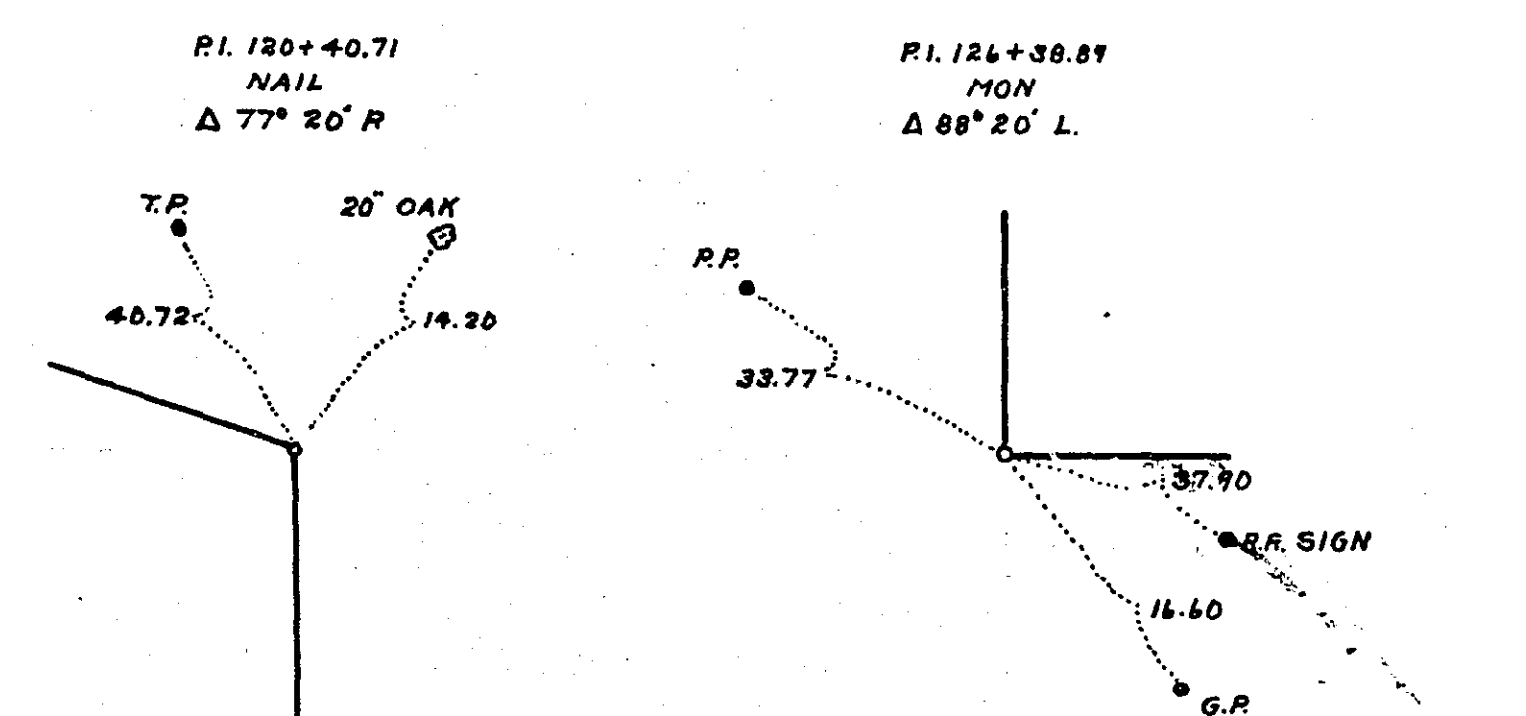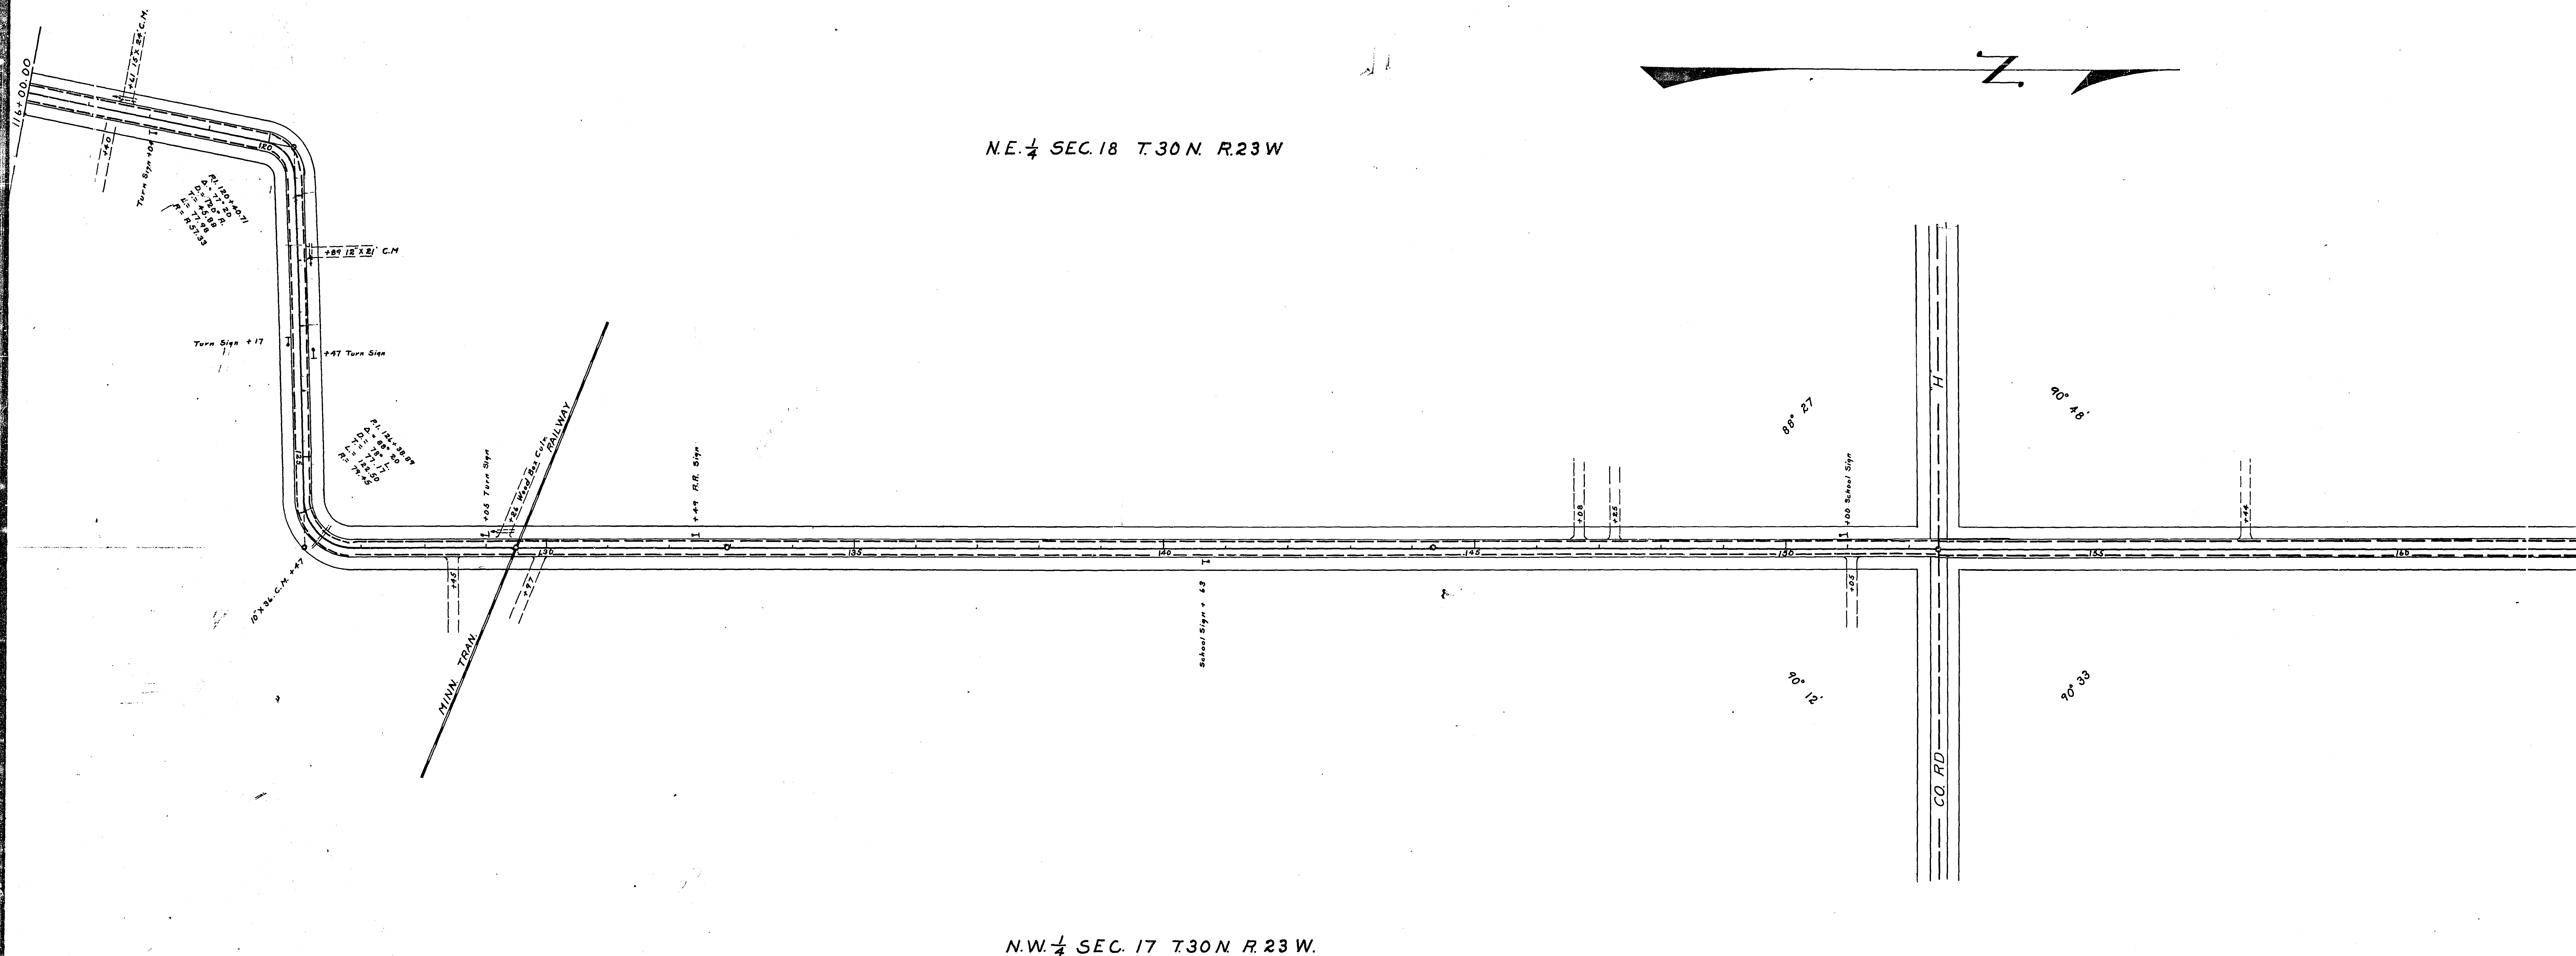

P.O.T. 129+50.90

P.O.T. 132+94.89
NAIL

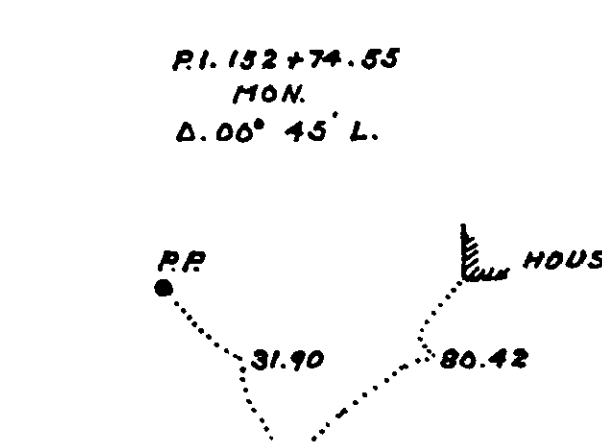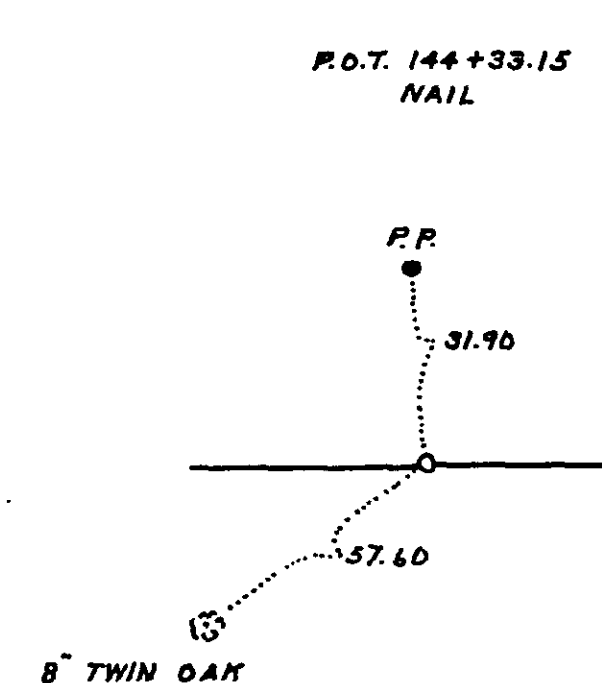

ROAD MAP
LONG LAKE ROAD
FROM STA. 0700 ON S.T.H. #8 TO STA. 25+19.10 ON
S.T.H. #8
AND FROM 603.2, N. of CENTER SEC. 29-23-30 TO
N. COUNTY LINE
ROAD NO. 12



S.E. $\frac{1}{4}$ SEC. 7 T. 30 N. R. 23 W.


N.E. $\frac{1}{4}$ SEC. 7 T. 30 N. R. 23 W.

S.W. $\frac{1}{4}$ SEC. 8 T. 30 N. R. 23 W.

N.W. $\frac{1}{4}$ SEC. 8 T. 30 N. R. 23 W.

ROAD MAP
LONG LAKE ROAD
FROM STA. 0700 ON S.T.H. #8 TO STA. 25+19.10 ON
S.T.H. #8
AND FROM 603.2 N. OF CENTER SEC. 29-23-30 TO
N. COUNTY LINE
ROAD NO. 12

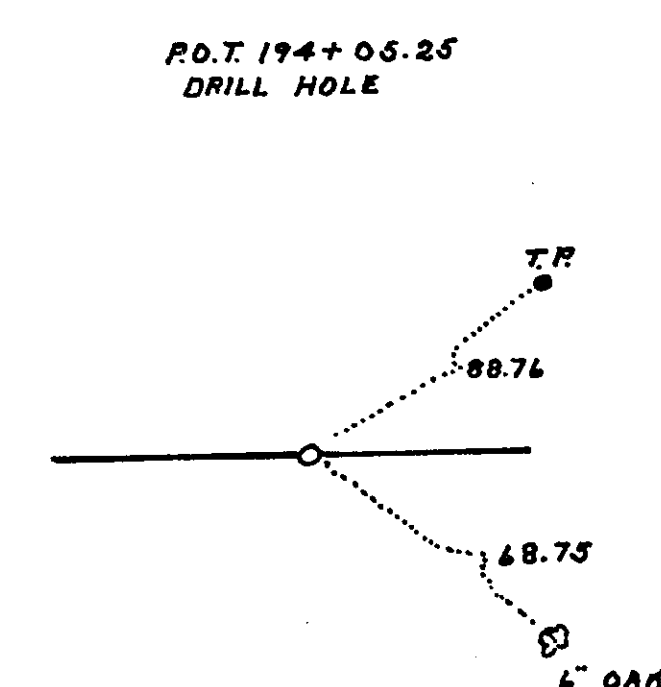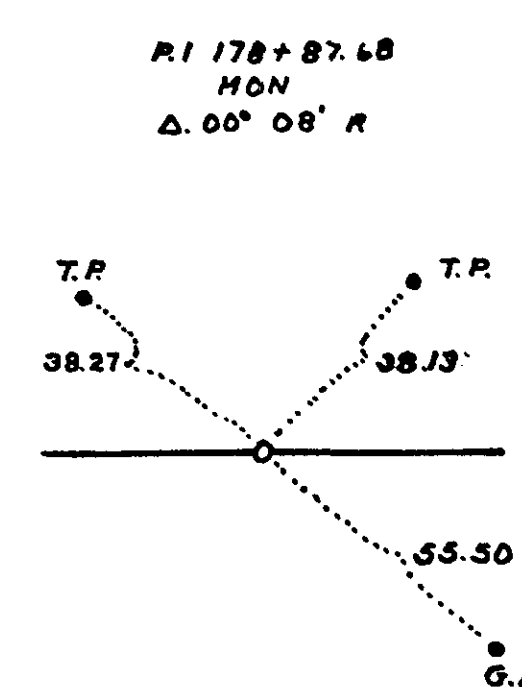

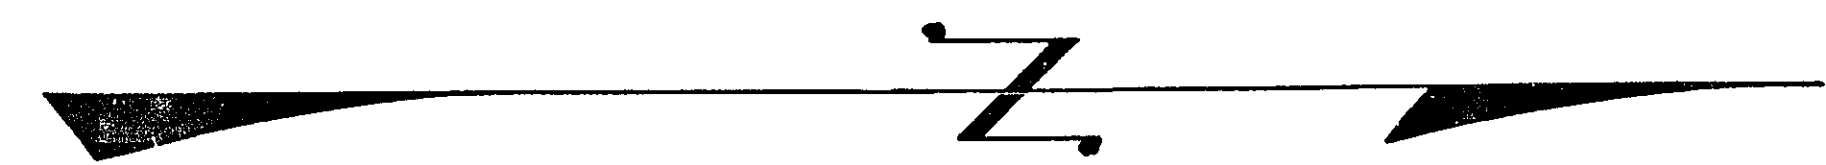

S.E. $\frac{1}{4}$ SEC. 6 T. 30 N. R. 23 W.

87° 08'

90° 52'

P.I. 205+36.74

157' 10" X 46' C.M.

87° 05'

90° 55'

P.O.T. 231+84.82

150' 10" X 46' C.M.

157' 10" X 46' C.M.

157' 10" X 46' C.M.

87° 22'

90° 06'

87° 20'

90° 40'

S.W. $\frac{1}{4}$ SEC. 5 T. 30 N. R. 23 W.

P.I. 205+36.74
MON.
Δ 00° 00' R

P.R.

14.24

107.2

HOUSE

P.O.T. 231+84.82
MON.

P.R.

43.36

47.17

37.00

8" OAK

14" OAK

ROAD MAP
LONG LAKE ROAD

FROM STA. 0+00 ON S.T.H. #8 TO STA. 25+19.10 ON
S.T.H. #8
AND FROM 603.2' N. OF CENTER SEC. 29-23-30 TO
N. COUNTY LINE

ROAD NO. 12

7

N.E. $\frac{1}{4}$ SEC. 6 T.30 N. R.23 W

COUNTY

ANOKA

N.W. $\frac{1}{4}$ SEC. 5 T.30 N R.23 W

ROAD MAP
LONG LAKE ROAD
FROM STA. 0+00 ON S.T.H. #8 TO STA. 25+19.10 ON
S.T.H. #8
AND FROM 603.2 N. OF CENTER SEC. 29-23-30 TO
N. COUNTY LINE
ROAD NO. 12