







S.W. 1/4 SEC. 17, T. 29 R. 23

SE 1/4 S

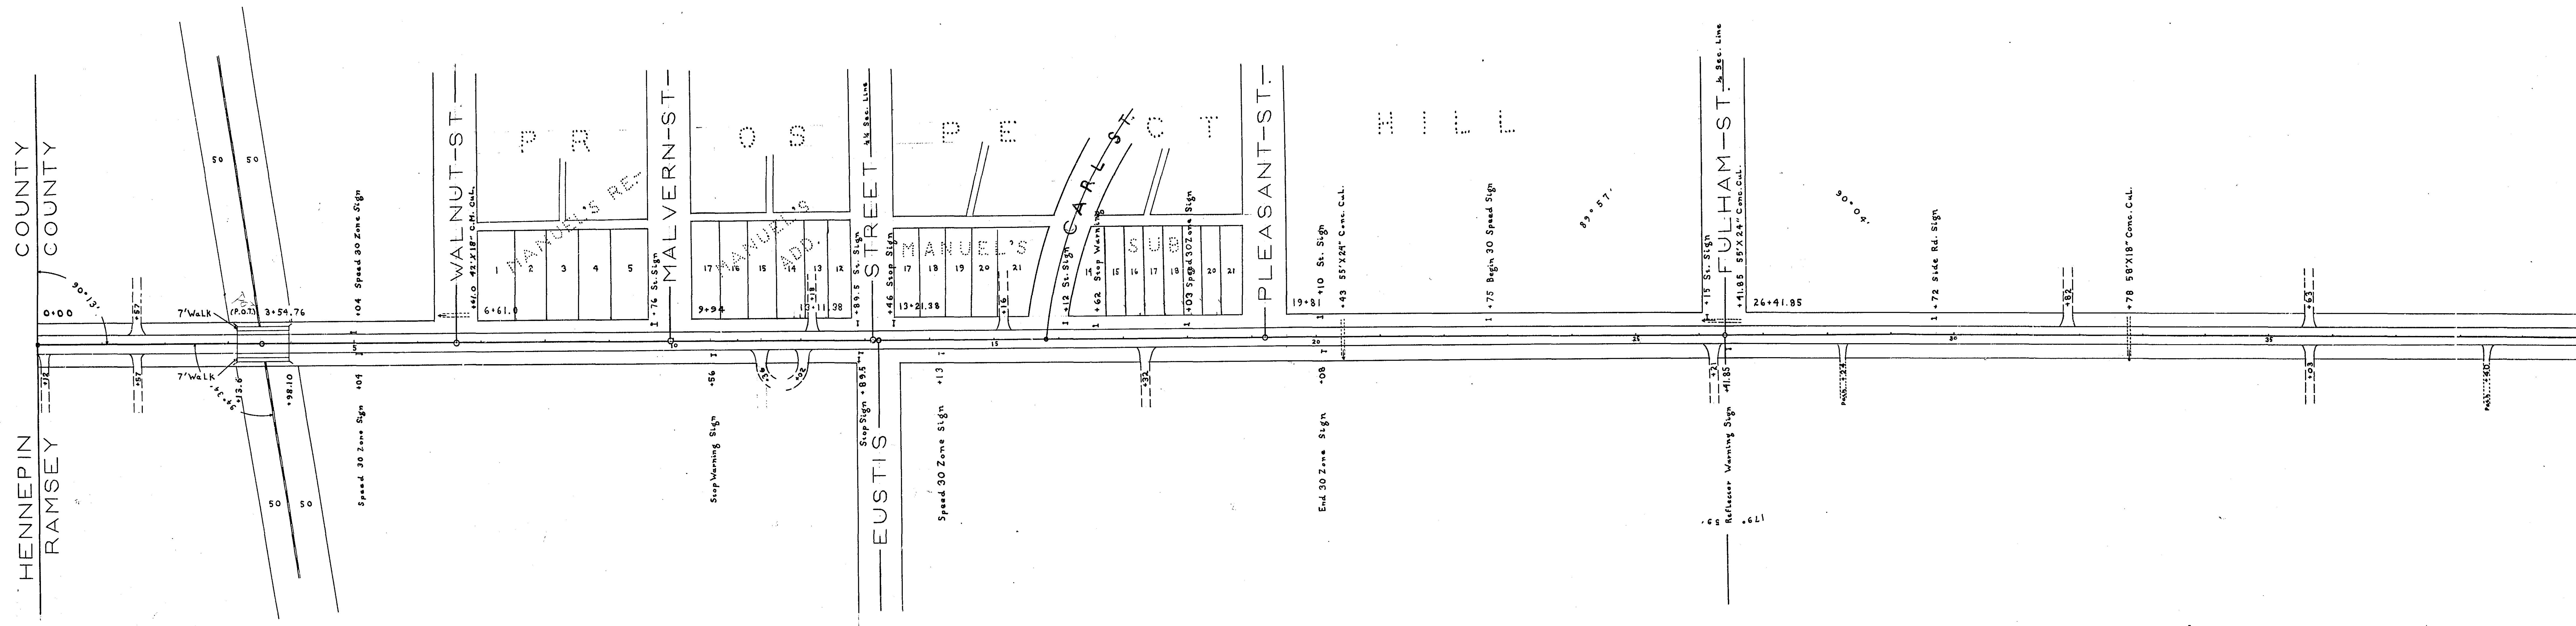


NW 1/4 SEC. 20, T. 29 R. 23


NE 1/4 S

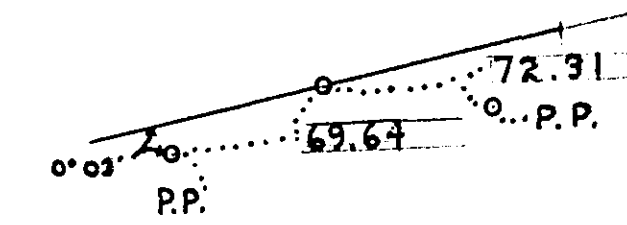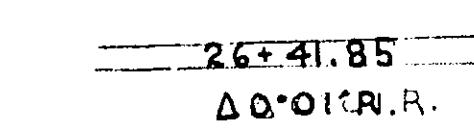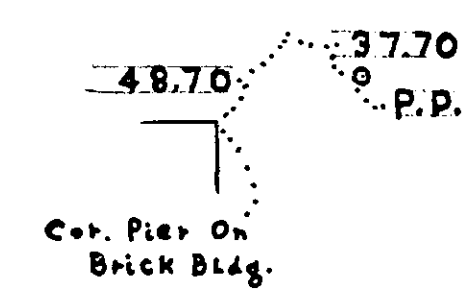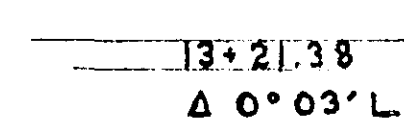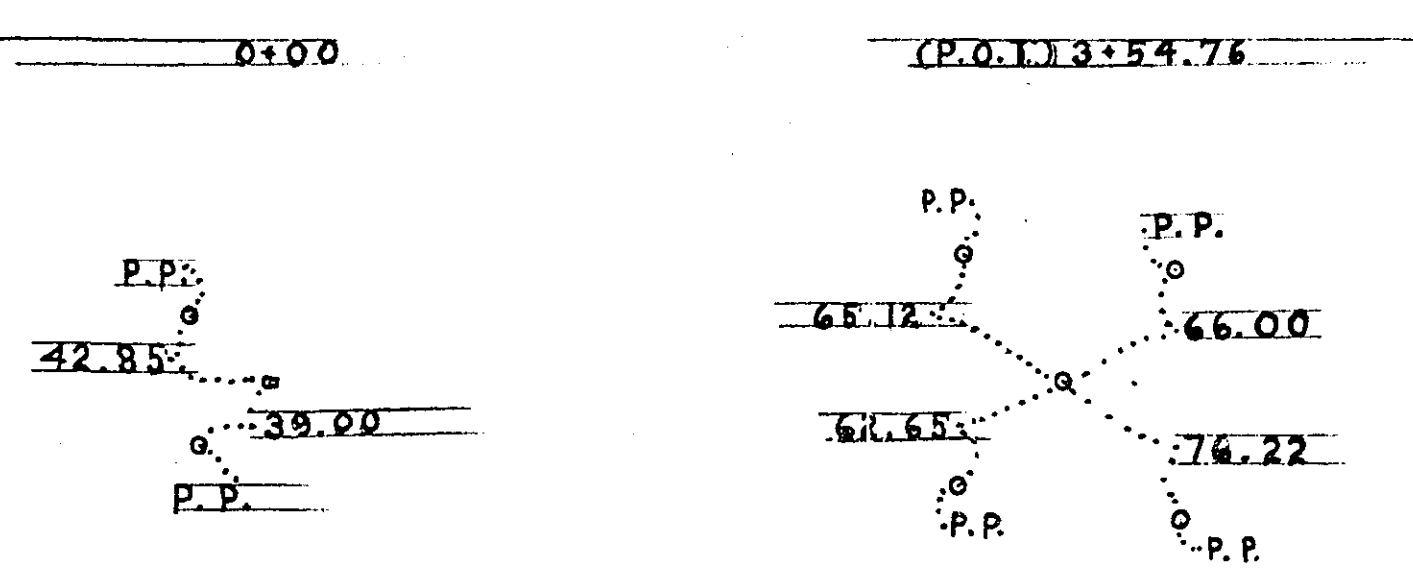




ROAD MAP
CARPENTEUR AVE.
FROM WEST COUNTY LINE TO HAMLINE
ROAD NO. 14

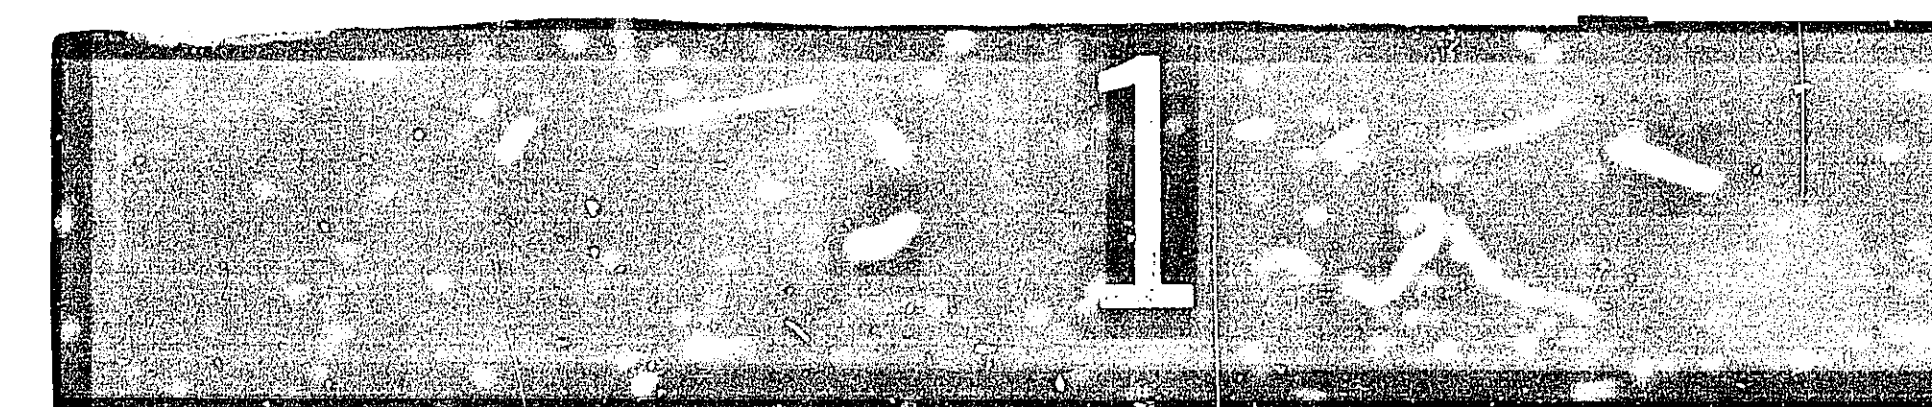

S.W. 1/4 SEC. 16, T. 29 R. 23

 

N.W. ¼ SEC. 21, T. 29 R. 23

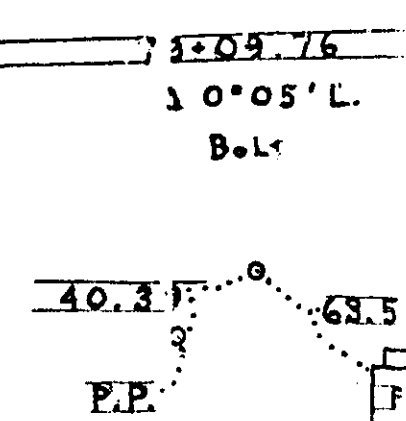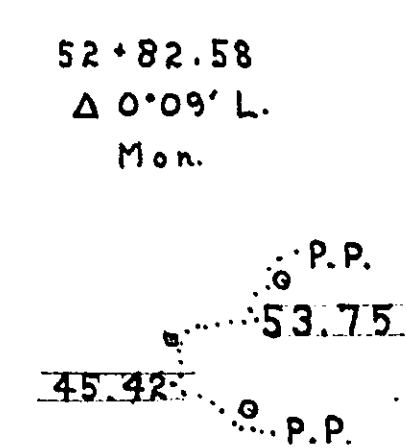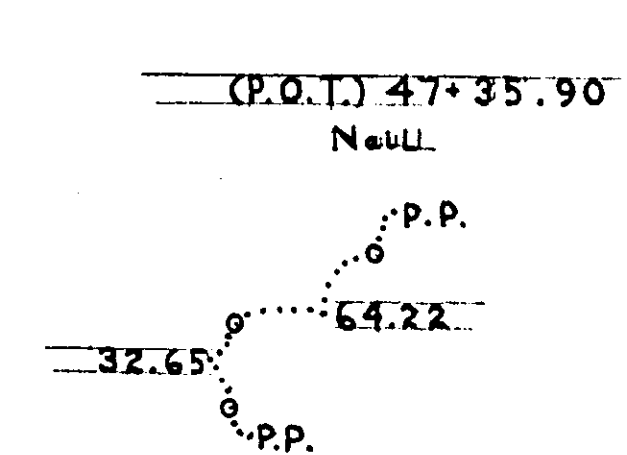

ROAD MAP
CARPENTEUR AVE.
FROM WEST COUNTY LINE TO HAMMINE
ROAD NO. 14

SE 1/4 SEC. 16, T. 29 R. 23

SE 1/4 SEC. 16, T. 29 R. 23

NE 1/4 SEC. 21, T. 29 R. 23


NW 1/4 SEC. 21, T. 29 R. 23

NEW-BRIGHTON RD. & Sec. Line


ST. MARYS AVE.


SNELLING-AVE.

ARONA-STREET

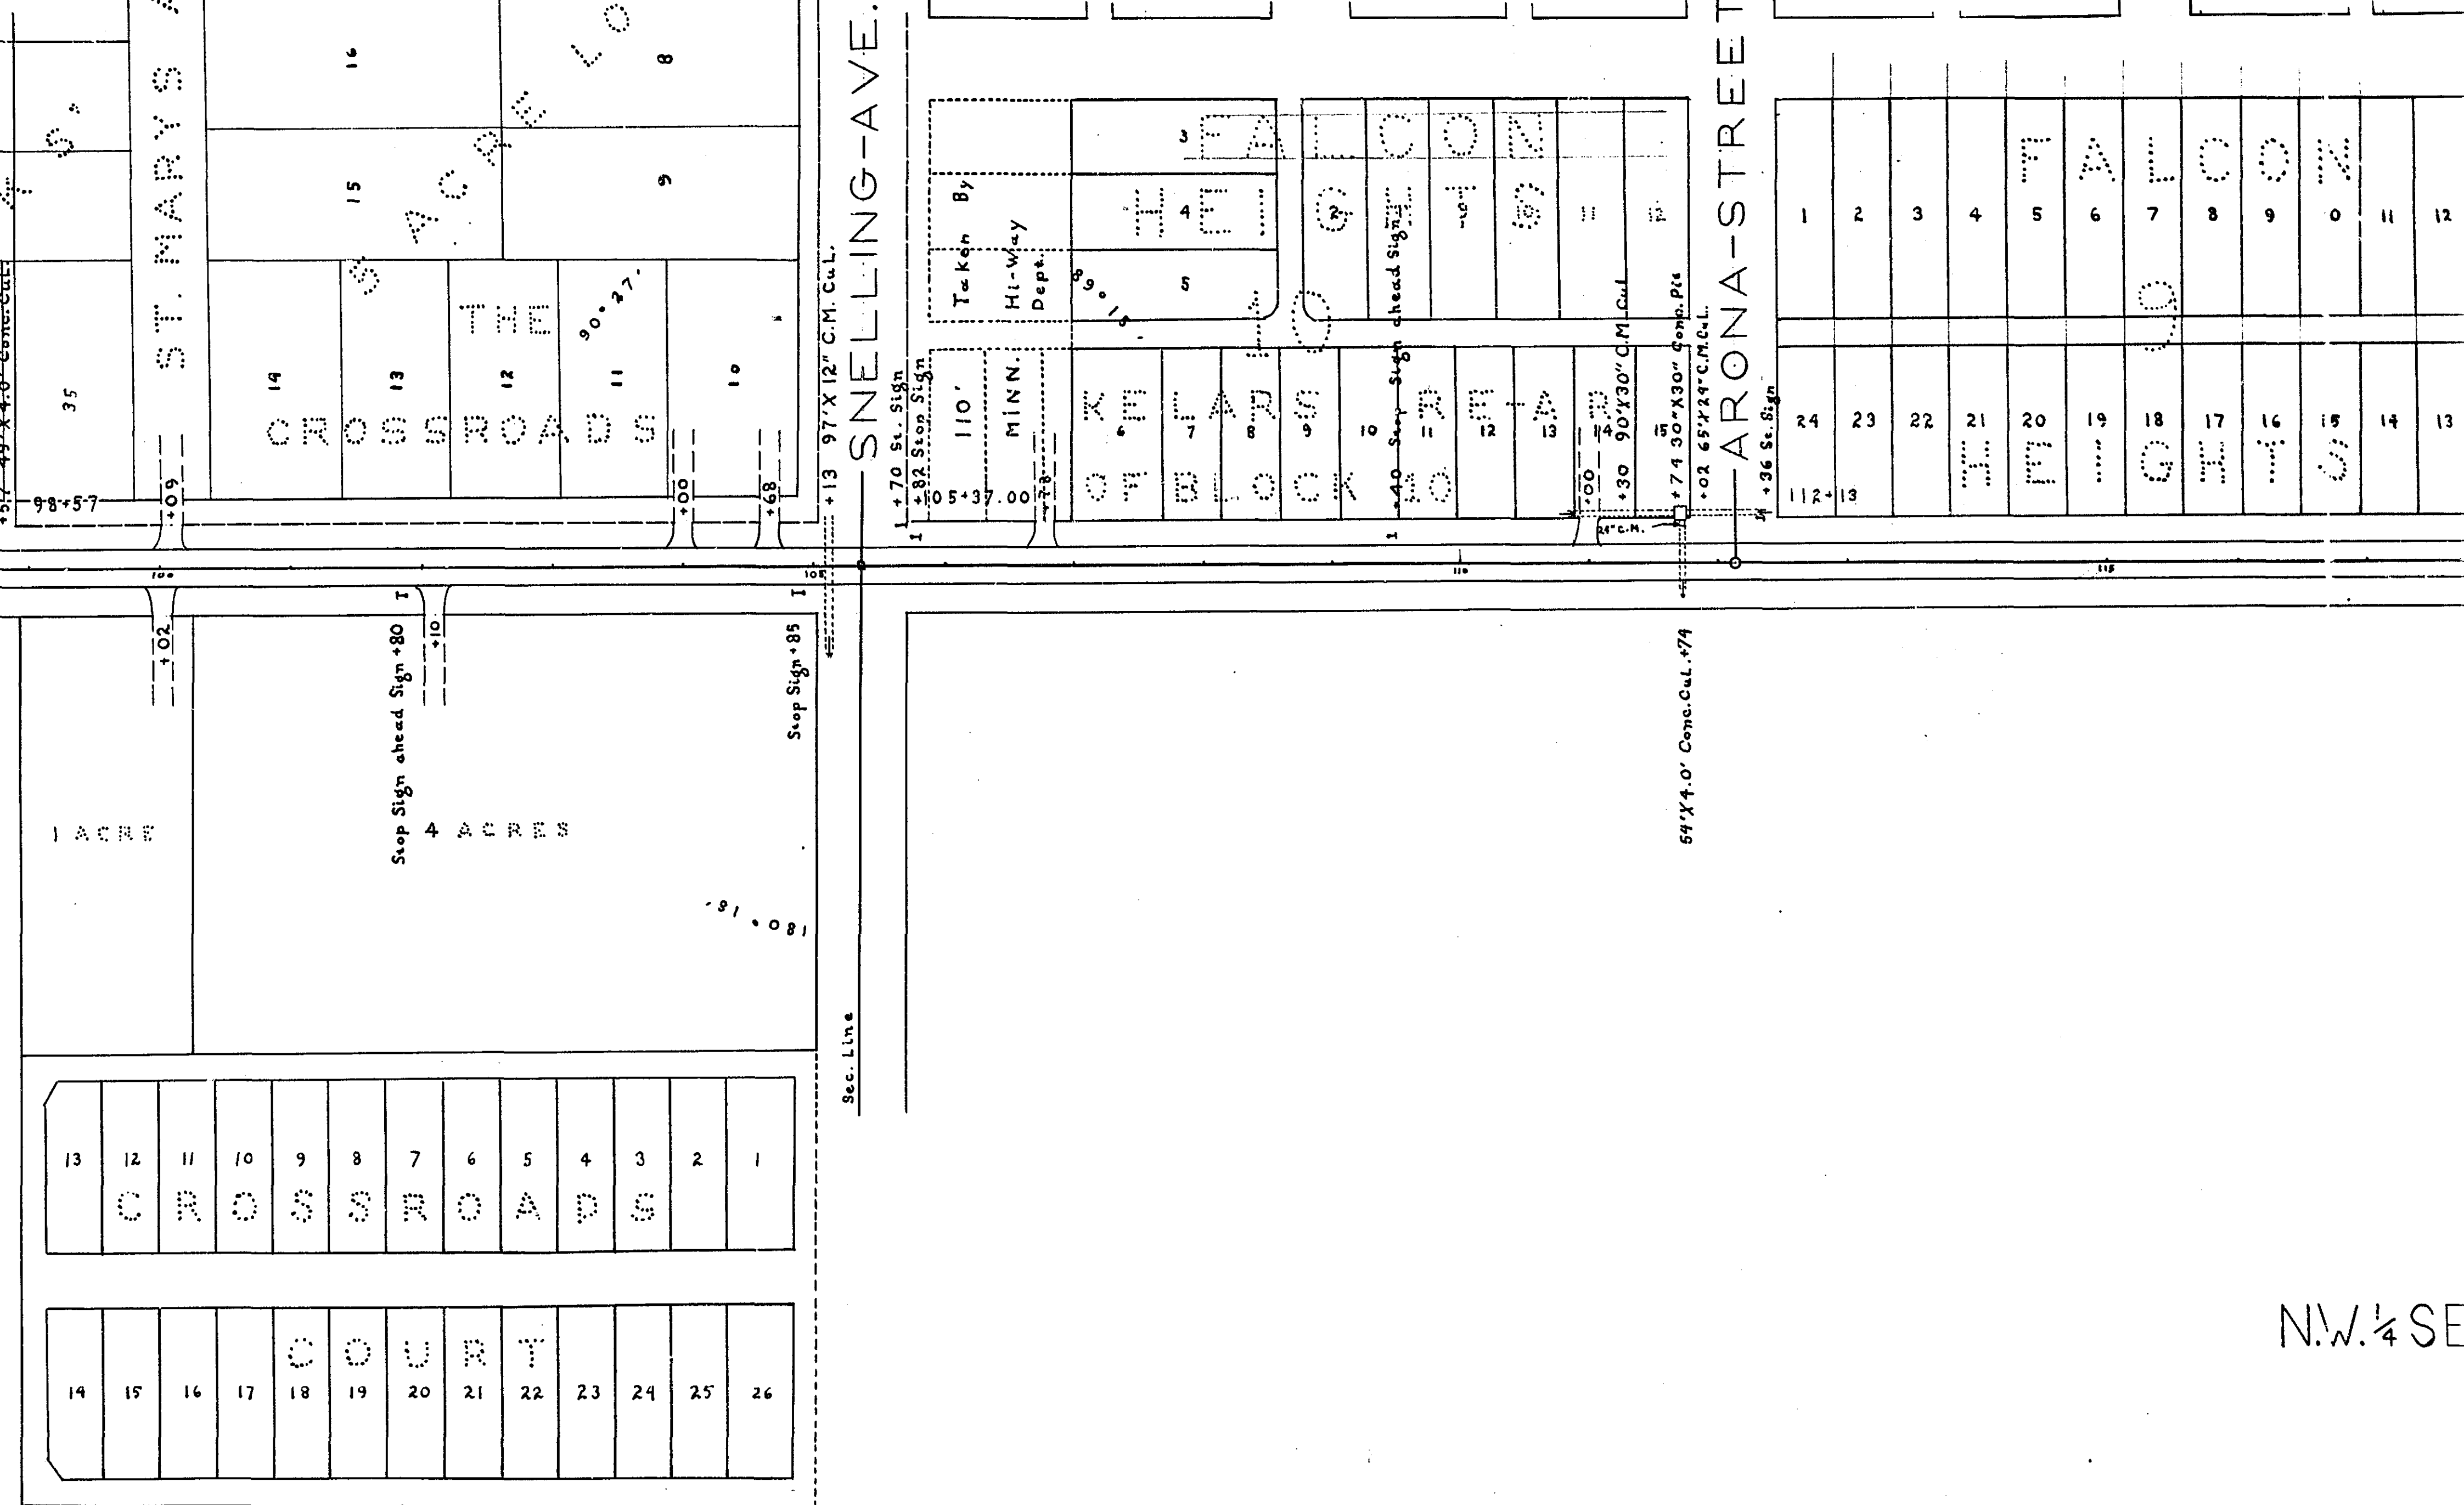

ROAD MAP
LARPENTEUR AVE.
FROM WEST COUNTY LINE TO HAMLINE
ROAD NO. 14

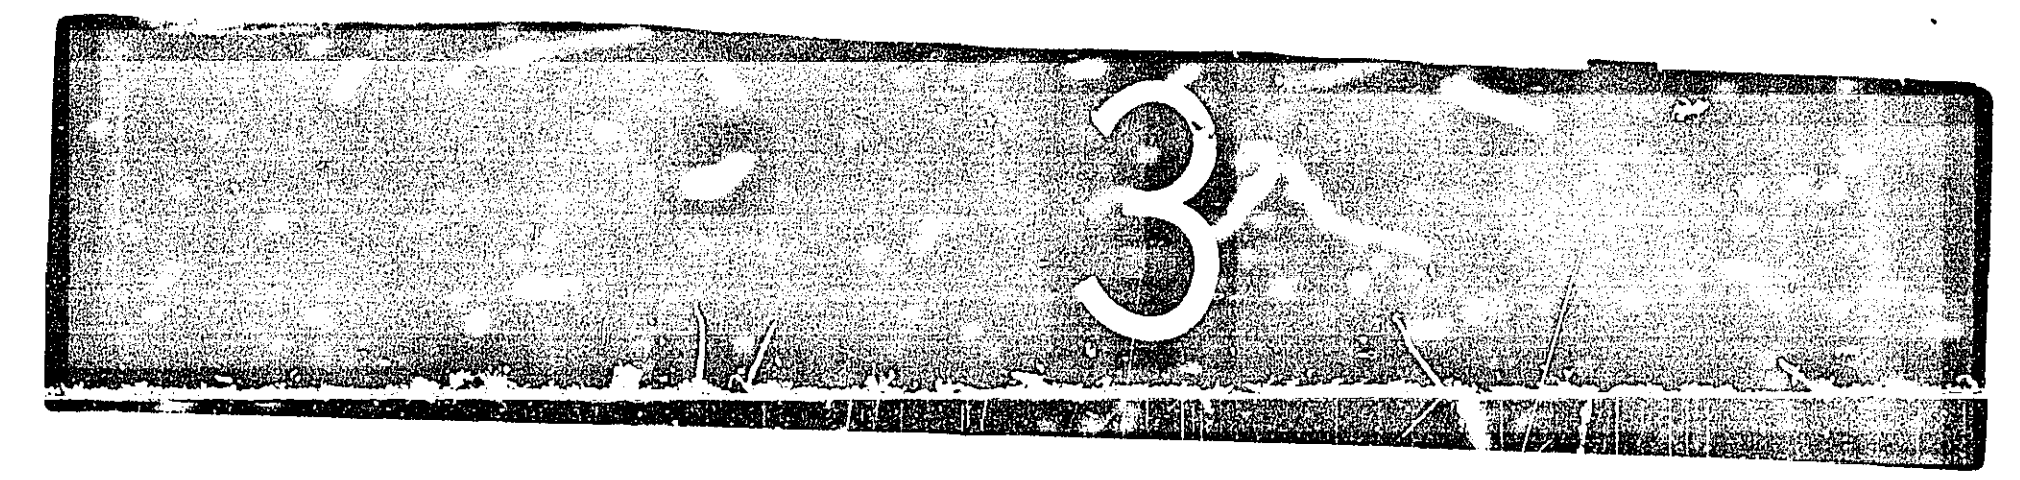

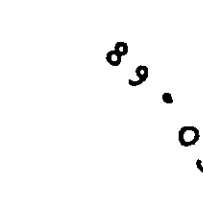


182.081

45.80 34.34
Hyd. P.P.

4




S.W. 1/4 SEC. 13, T. 29 R. 21

SE 1/4

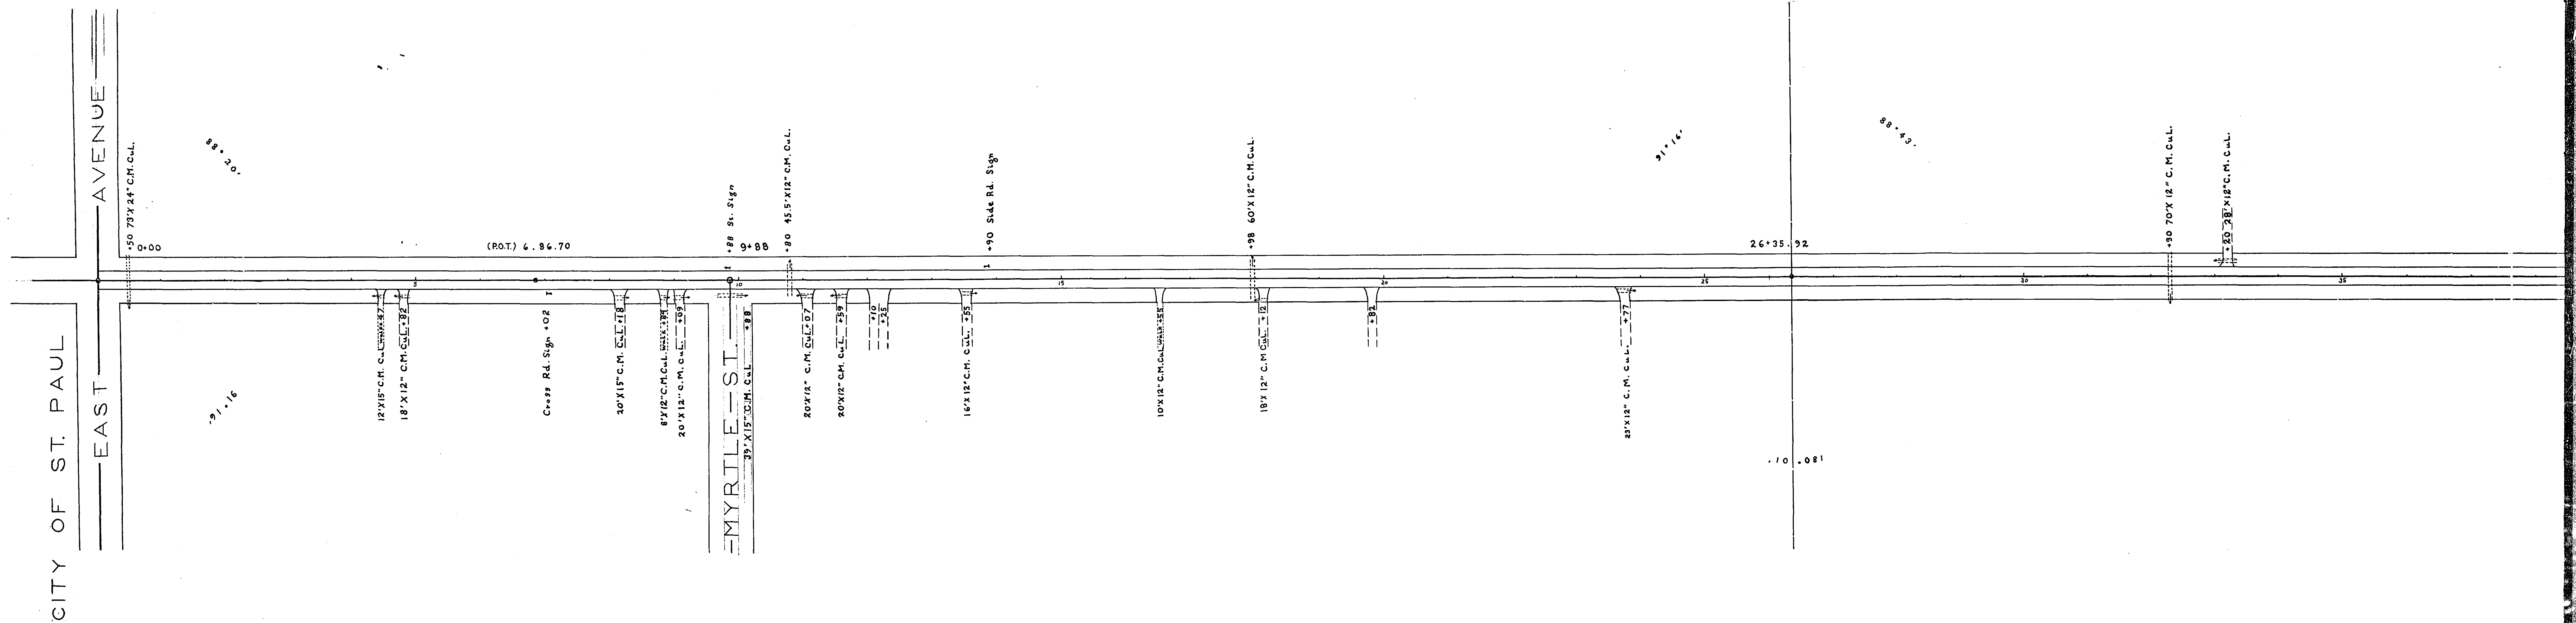

N.W. 1/4 SEC. 24, T. 29 R. 21

NE 1/4

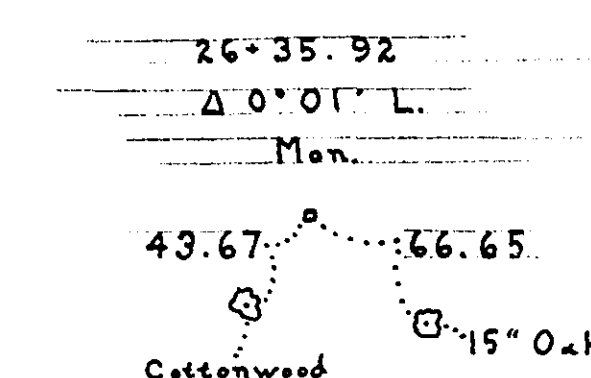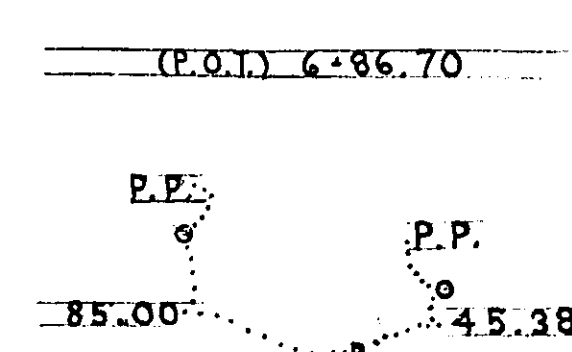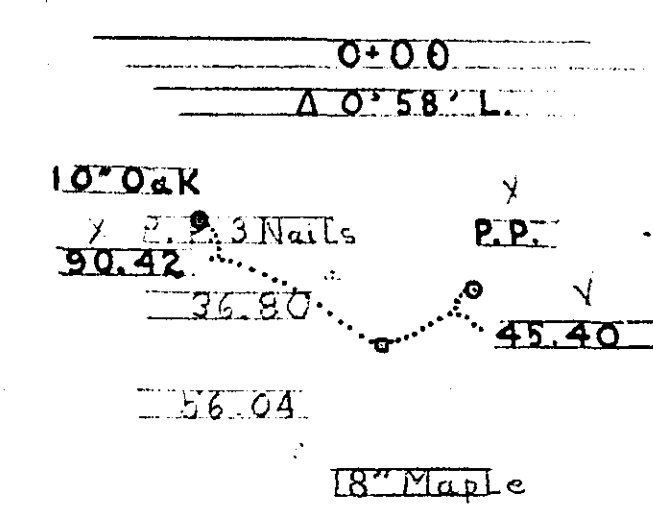

ROAD MAP
CARPENTEUR AVE.
FROM EAST AVE. TO WEST County Line
Road #14

SE 1/4 SEC. 13, T. 29 R. 2 E

NE 1/4 SEC. 24, T. 29 R. 2 E

LINE ROAD

NO. 100

COUNTY

S.T.H.

EAST COUNTY

WASHINGTON

ROAD MAP
CARPENTEUR AVE.
FROM EAST AVE. TO WEST County Line
Road # 14