


OFFICE OF COUNTY ENGINEER
 RAMSEY COUNTY
 PROGRESSIVE ROAD MAP
 OF
 STILLWATER STREET
 FROM OTTER LAKE RD TO DIVISION STREET


TOTAL LENGTH 6884.5 FT. 1.29 MILES
 Scale 1 in = 100 ft.

CONVENTIONAL SIGNS & ABBREVIATIONS					
ITEM	CONVENTION	ABBREV.	ITEM	CONVENTION	ABBREV.
State Line	---	---	Surfacing	---	S
County Line	---	---	Sectional Concrete Culy. (light type)	---	P3
Township Line	---	---	Sectional Concrete Culy. (heavy type)	---	P3
Section Line	---	---	Corrugated Metal Culverts	---	C.M.
City or Village	---	---	Vitrified Clay Pipe	---	V.P.
Fence	---	---	Cast Iron Pipe	---	C.I.P.
Right-of-Way Line	---	---	Private	---	Ph
Earth Road not Standard	---	---	Inplace	---	Imp.
Graveled on Grade not Standard	---	---	Right	---	RT
Graveled to Standard	---	---	Left	---	LT
Graded & Graveled to Standard	---	---	Intersection Angle	---	Δ
Paved	---	---	Radius	---	R.
Farm Entrance	---	---	Point of Curve	---	P.C.
Railroads	---	---	" " Tangent	---	P.T.
Retaining Walls	---	---	" " Intersection	---	P.I.
Guard Rail	---	---	" " on Curve	---	P.O.C.
Survey Line	---	---	" " Tangent	---	P.O.T.
Gravel Pit	---	---			
Sand Pit	---	---			
Clay Pit	---	---			
Rock Quarry	---	---			
Culverts	---	---			
Plain	---	---			
With Face Walls	---	---			
With Wing Walls	---	---			
Drop Inlets	---	---			
Electric Poles	---	---			
Telephone or Telegraph Poles	---	---			
Trolley Poles	---	---			
County Marking Signs	---	---			
" Guide	---	---			
" Caution	---	---			
" Reflector	---	---			
" Rail Crossing	---	---			
Railroad Crossing Sign	---	---			

KEY MAP

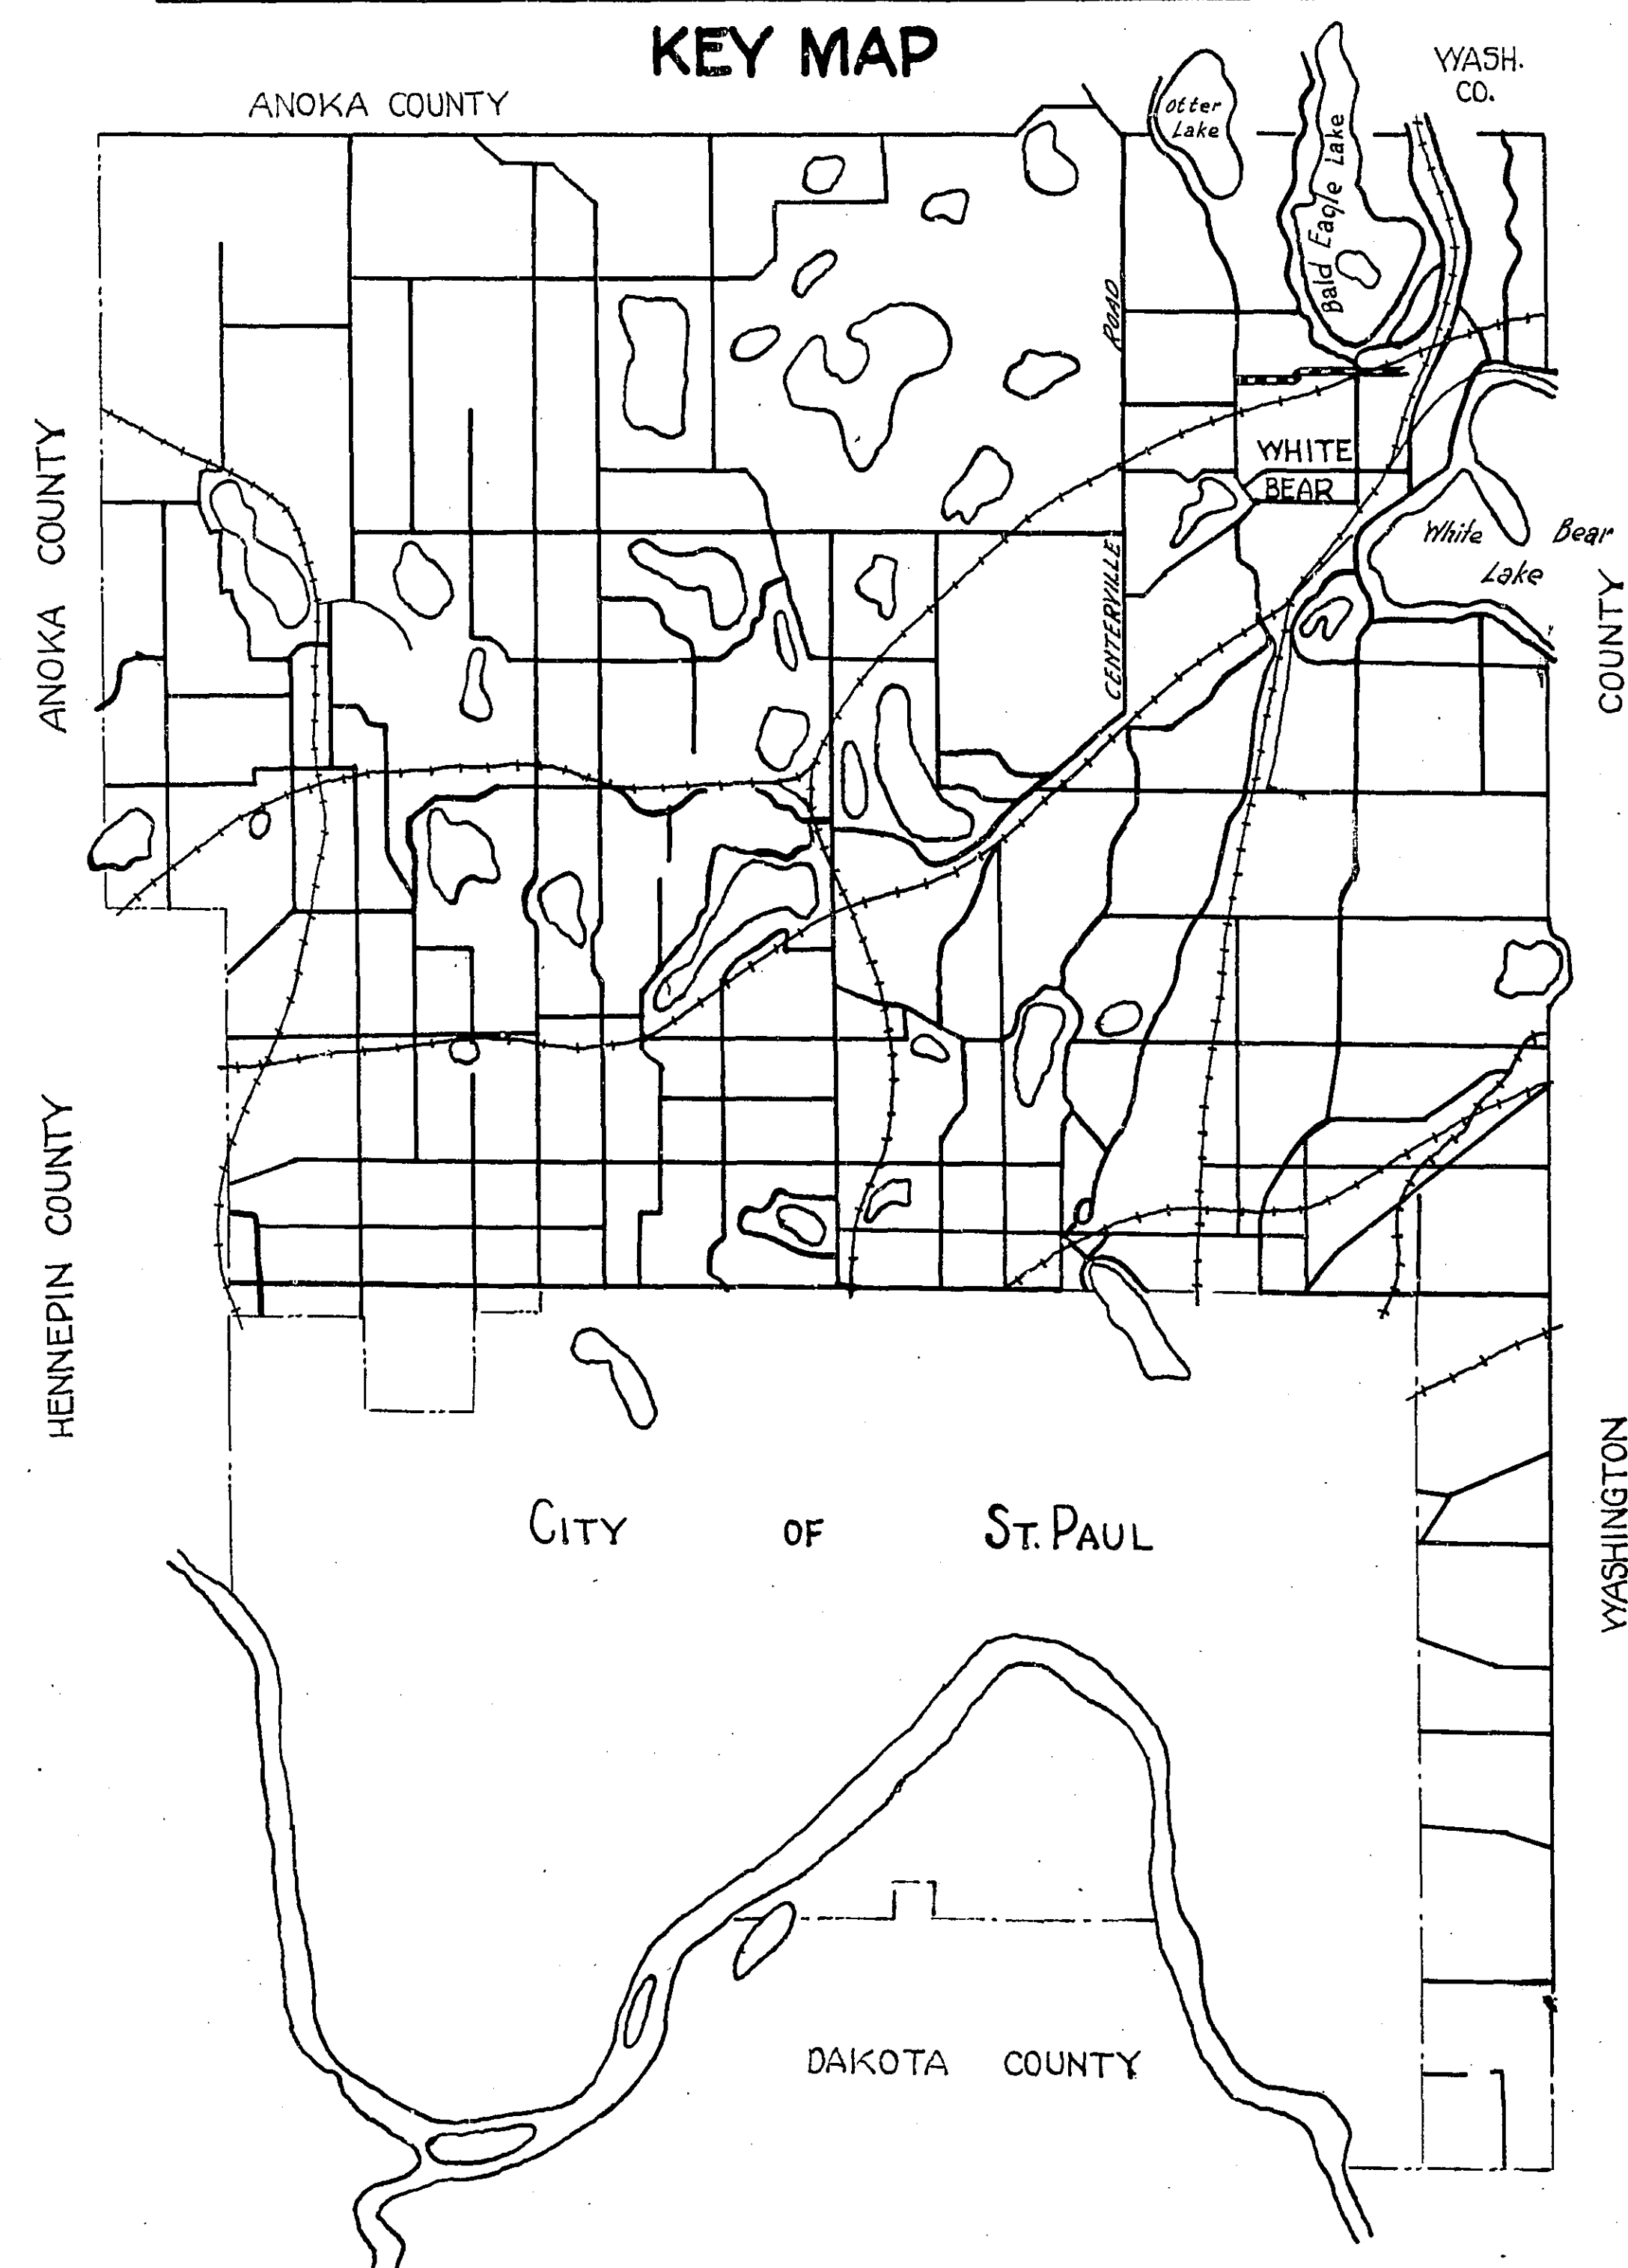

S.E. 1/4 SEC 10-30-22

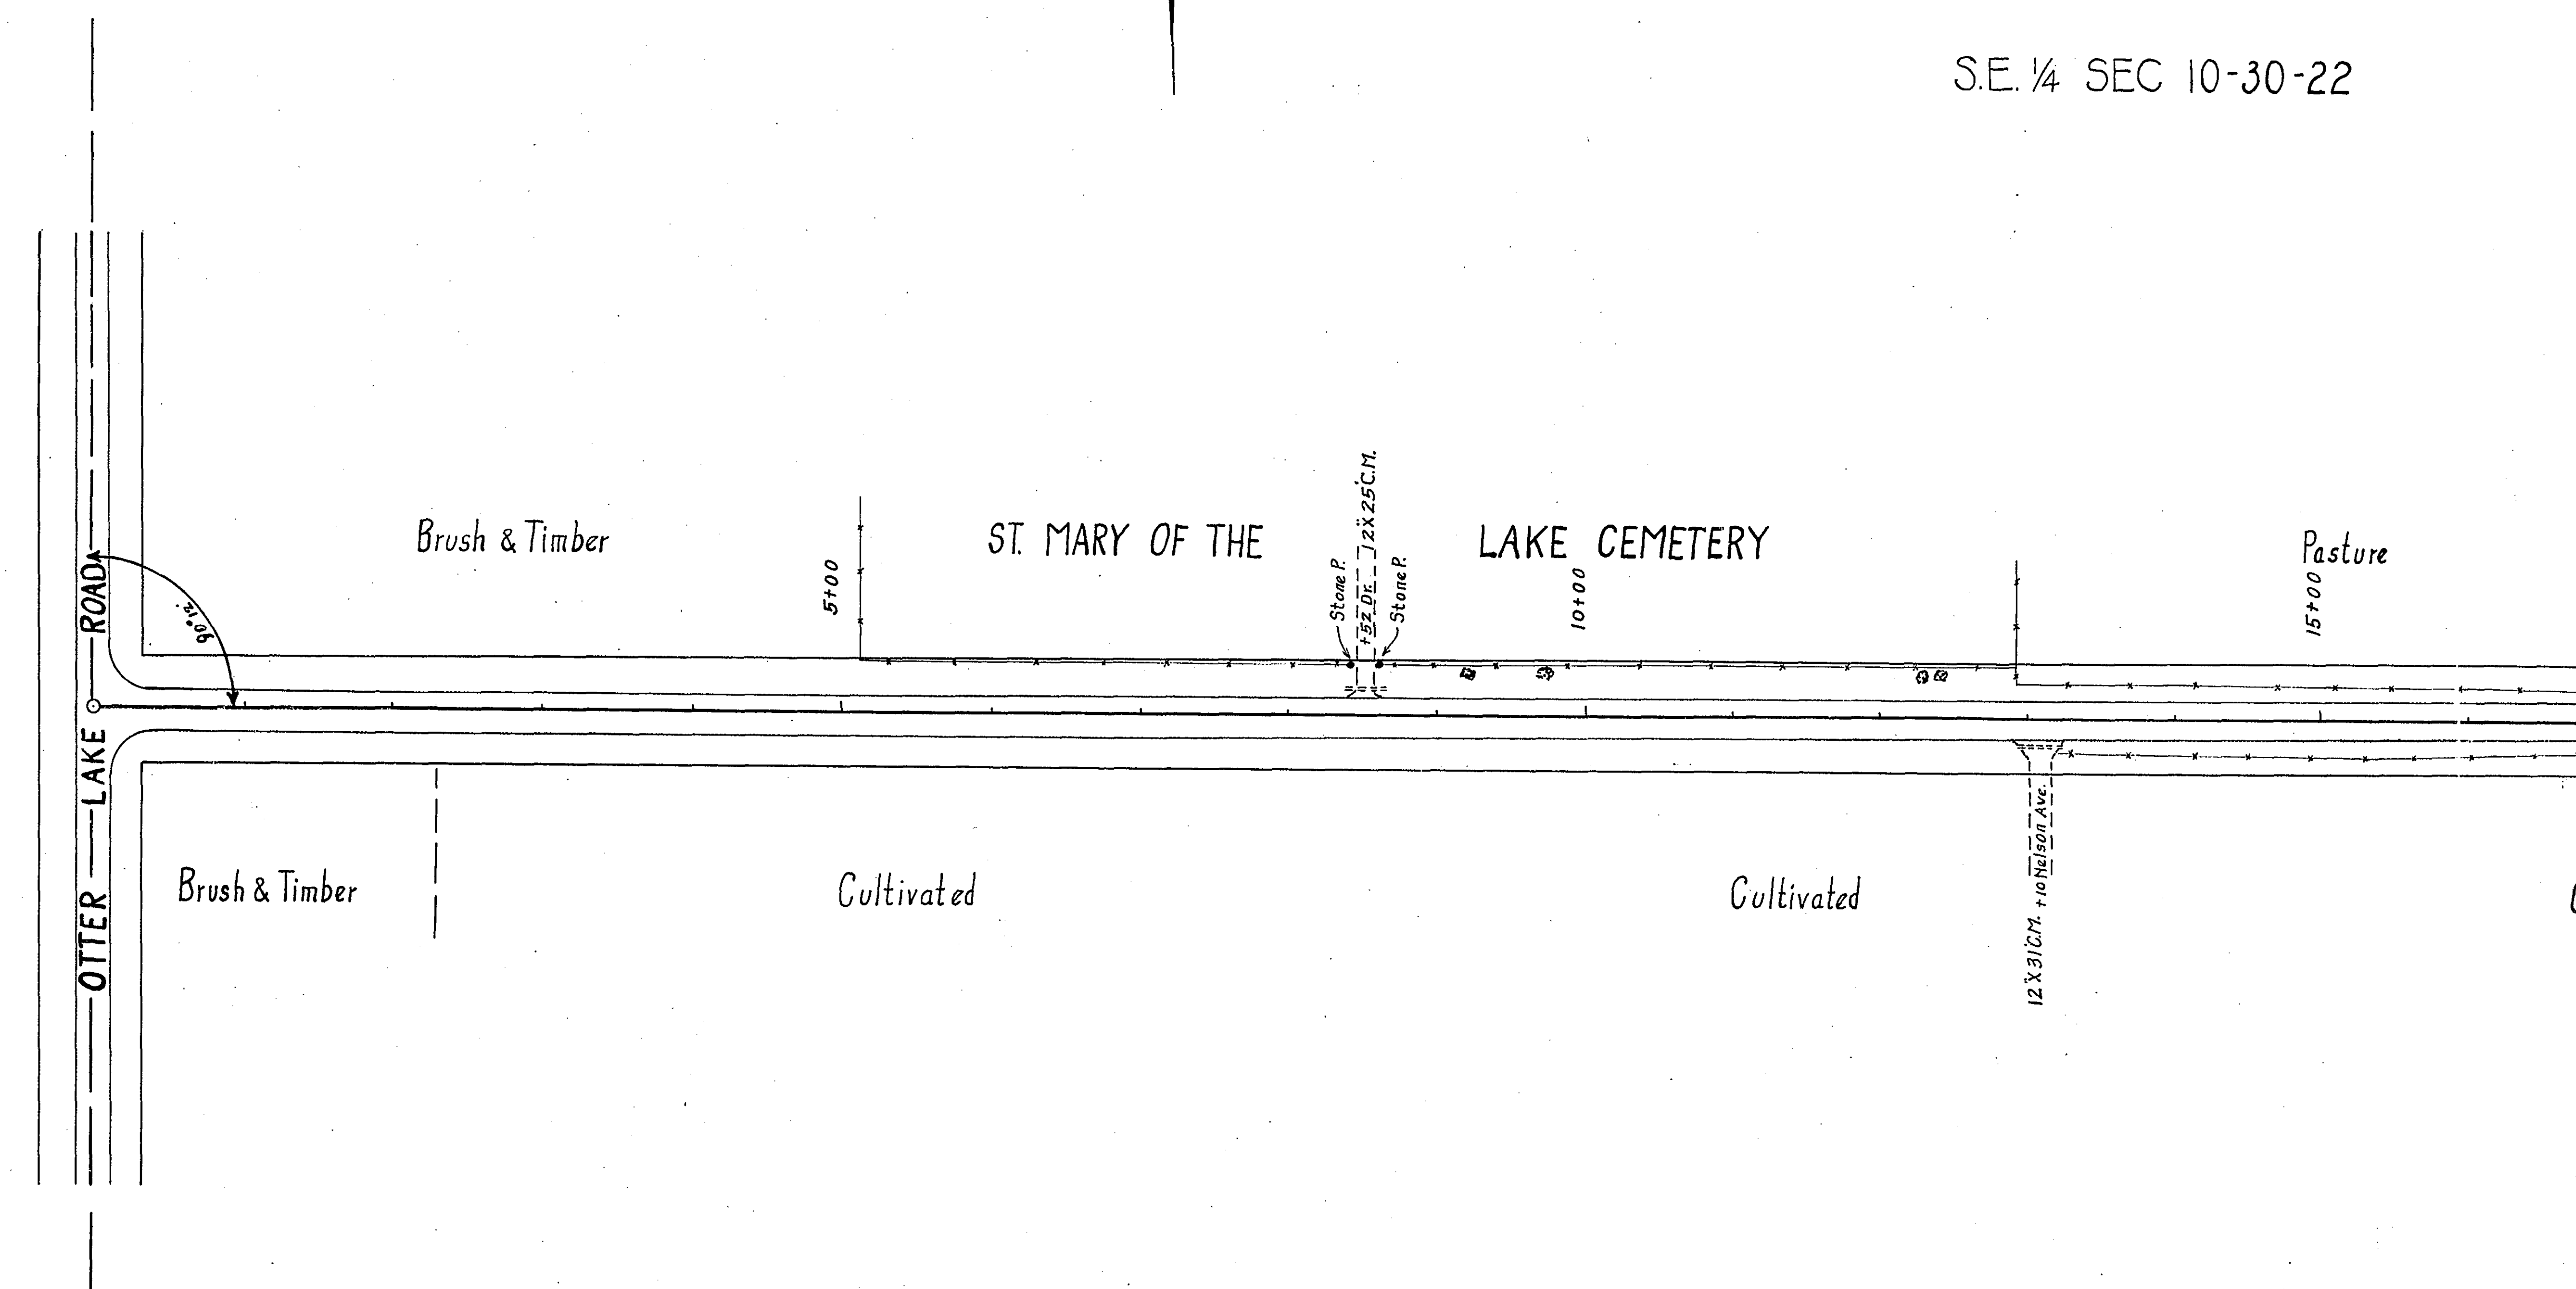

S.E. 1/4 SEC 10-30-22

20X F-1/3

[illegible]