


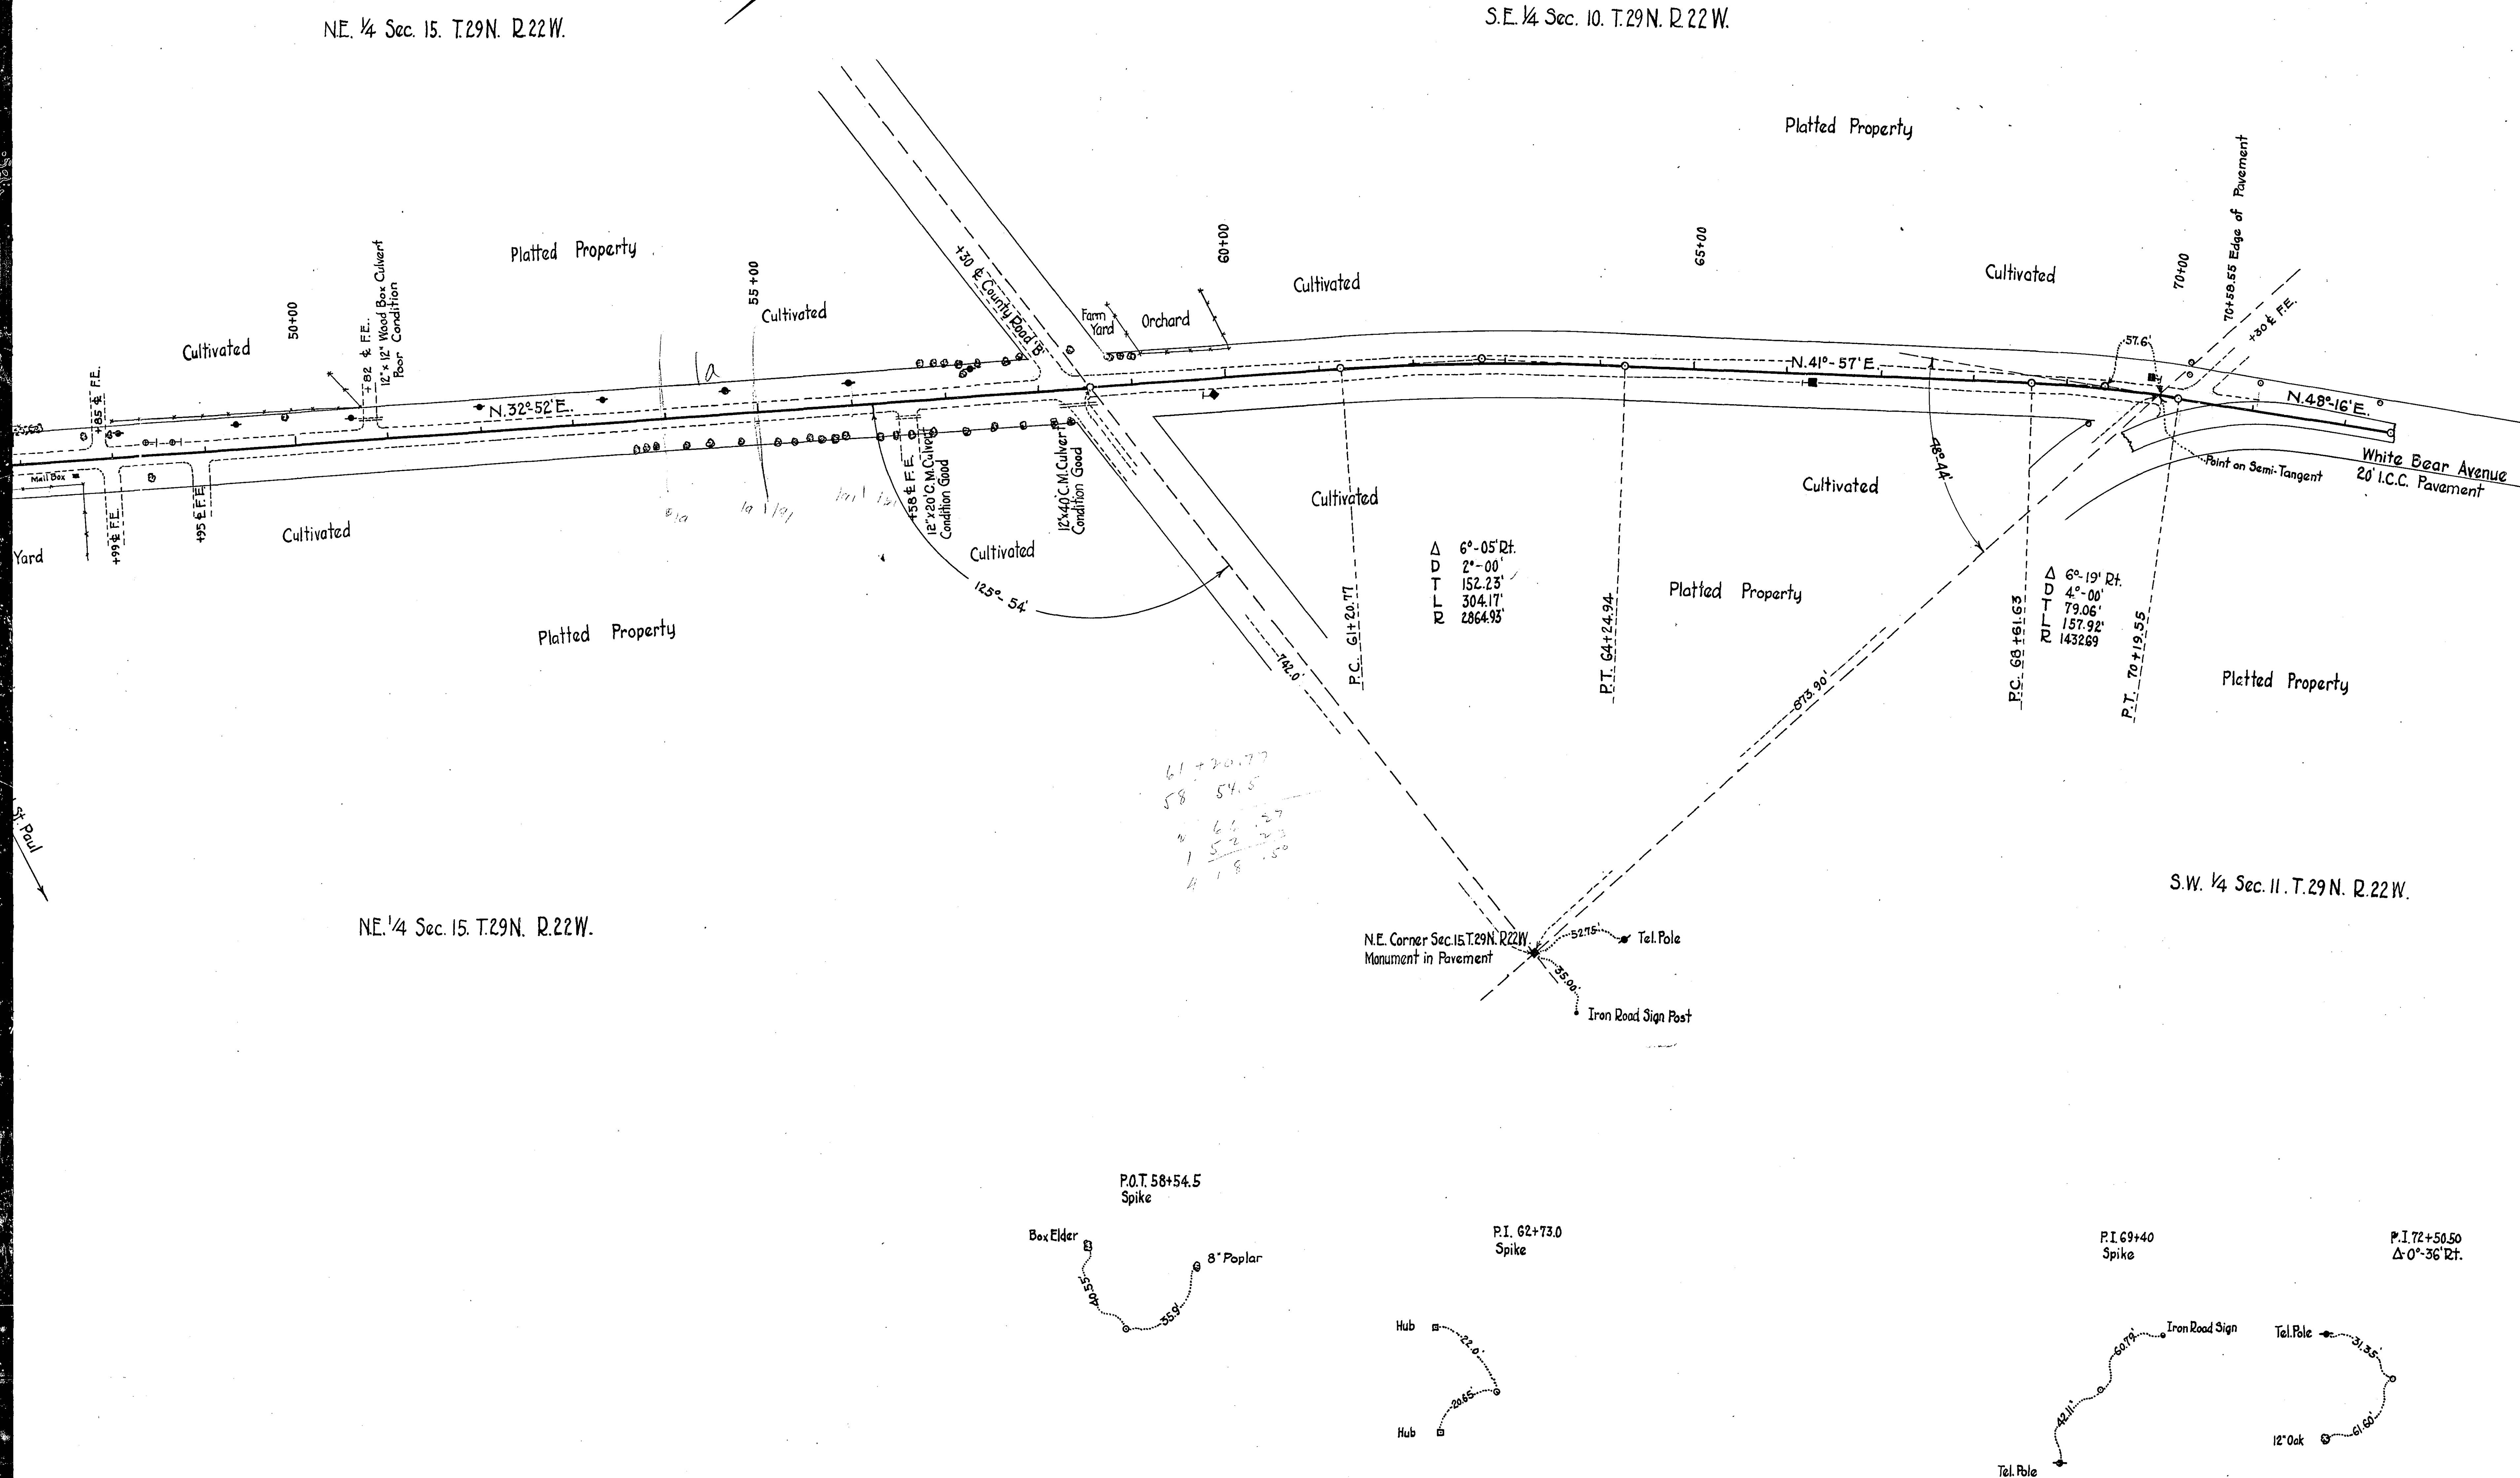

[illegible]

SUMMARY OF MILE 2													
CULVERTS					BRIDGES	SIGNS			GUARD RAIL		SURFACING		
C.M.	P1	P3	V.P.	C.P.	KIND	MARKER	CAUTION	GUIDE	R.R.	KIND	LN.FT.	KIND	SQ.YD.
12"x20'						1	2						Gravel
12"x40'													355



