

OFFICE OF COUNTY ENGINEER
 RAMSEY COUNTY
 PROGRESSIVE ROAD MAP
 OF
LABORE ROAD
 FROM EDGERTON ST. TO CENTERVILLE ROAD

TOTAL LENGTH 15925.2 FT. 3.016 MILES
 SCALE: 1" = 100'



CONVENTIONAL SIGNS & ABBREVIATIONS

ITEM	CONVENTION	ABBREV.
State Line	=====	
County Line	=====	
Township Line	=====	
Section Line	=====	
City or Village	=====	
Fence	=====	
Right-of-way Line	=====	R-O-W
Earth Road - not standard	=====	Rd.
Graveled on Grade not stand.	=====	G.
Graded to Standard	=====	Gr.
Graded & Graveled to stand.	=====	Gr & G.
Paved	=====	Pvd.
Farm Entrance	=====	F.E.
Railroads	=====	R.R.
Retaining walls	=====	R.W.
Guard Rail	=====	G.R.
Survey Line	=====	S
Gravel Pit	=====	G.P.
Sand Pit	=====	S.P.
Clay Pit	=====	C.P.
Rock Quarry	=====	R.Q.
Culverts	=====	C.
Plain	=====	
With face walls	=====	
With wing walls	=====	
Drop Inlets	=====	D.I.
Electric Poles	=====	E.P.
Telephone or Telegraph Poles	=====	T.P.
Trolley Poles	=====	T.P.
County Marking Signs	=====	M.s.g.n.
Guide	=====	G.s.g.n.
Caution	=====	C.s.g.n.
Reflector	=====	R.s.g.n.
Rail Crossing	=====	R.R.s.g.n.
Railroad - Crossing Sign	=====	X.s.g.n.

ITEM	ABBREV.
Surfacing	S
Sectional Conc. Culv. (light type)	P1
Sectional Conc. Culv. (heavy type)	P3
Corrugated Metal Culvert	C.M.
Vitrified Clay Pipe	V.P.
Cast Iron Pipe	C.I.P.
Private	Pri.
In place	Imp.
Right	Rt.
Left	Lt.
Intersection Angle	Δ
Radius	R
Point of Curve	P.C.
Tangent	P.T.
Intersection	P.I.
on Curve	P.O.C.
Tangent	P.O.T.

Surveyed by	Dates
<i>R.E. AUSTIN</i>	<i>4-20-23 5-1-23</i>
Mapped by	Dates
<i>A. M. LINDAHL</i>	<i>2-25-23 3-16-25</i>
Revised by	Date

KEY MAP

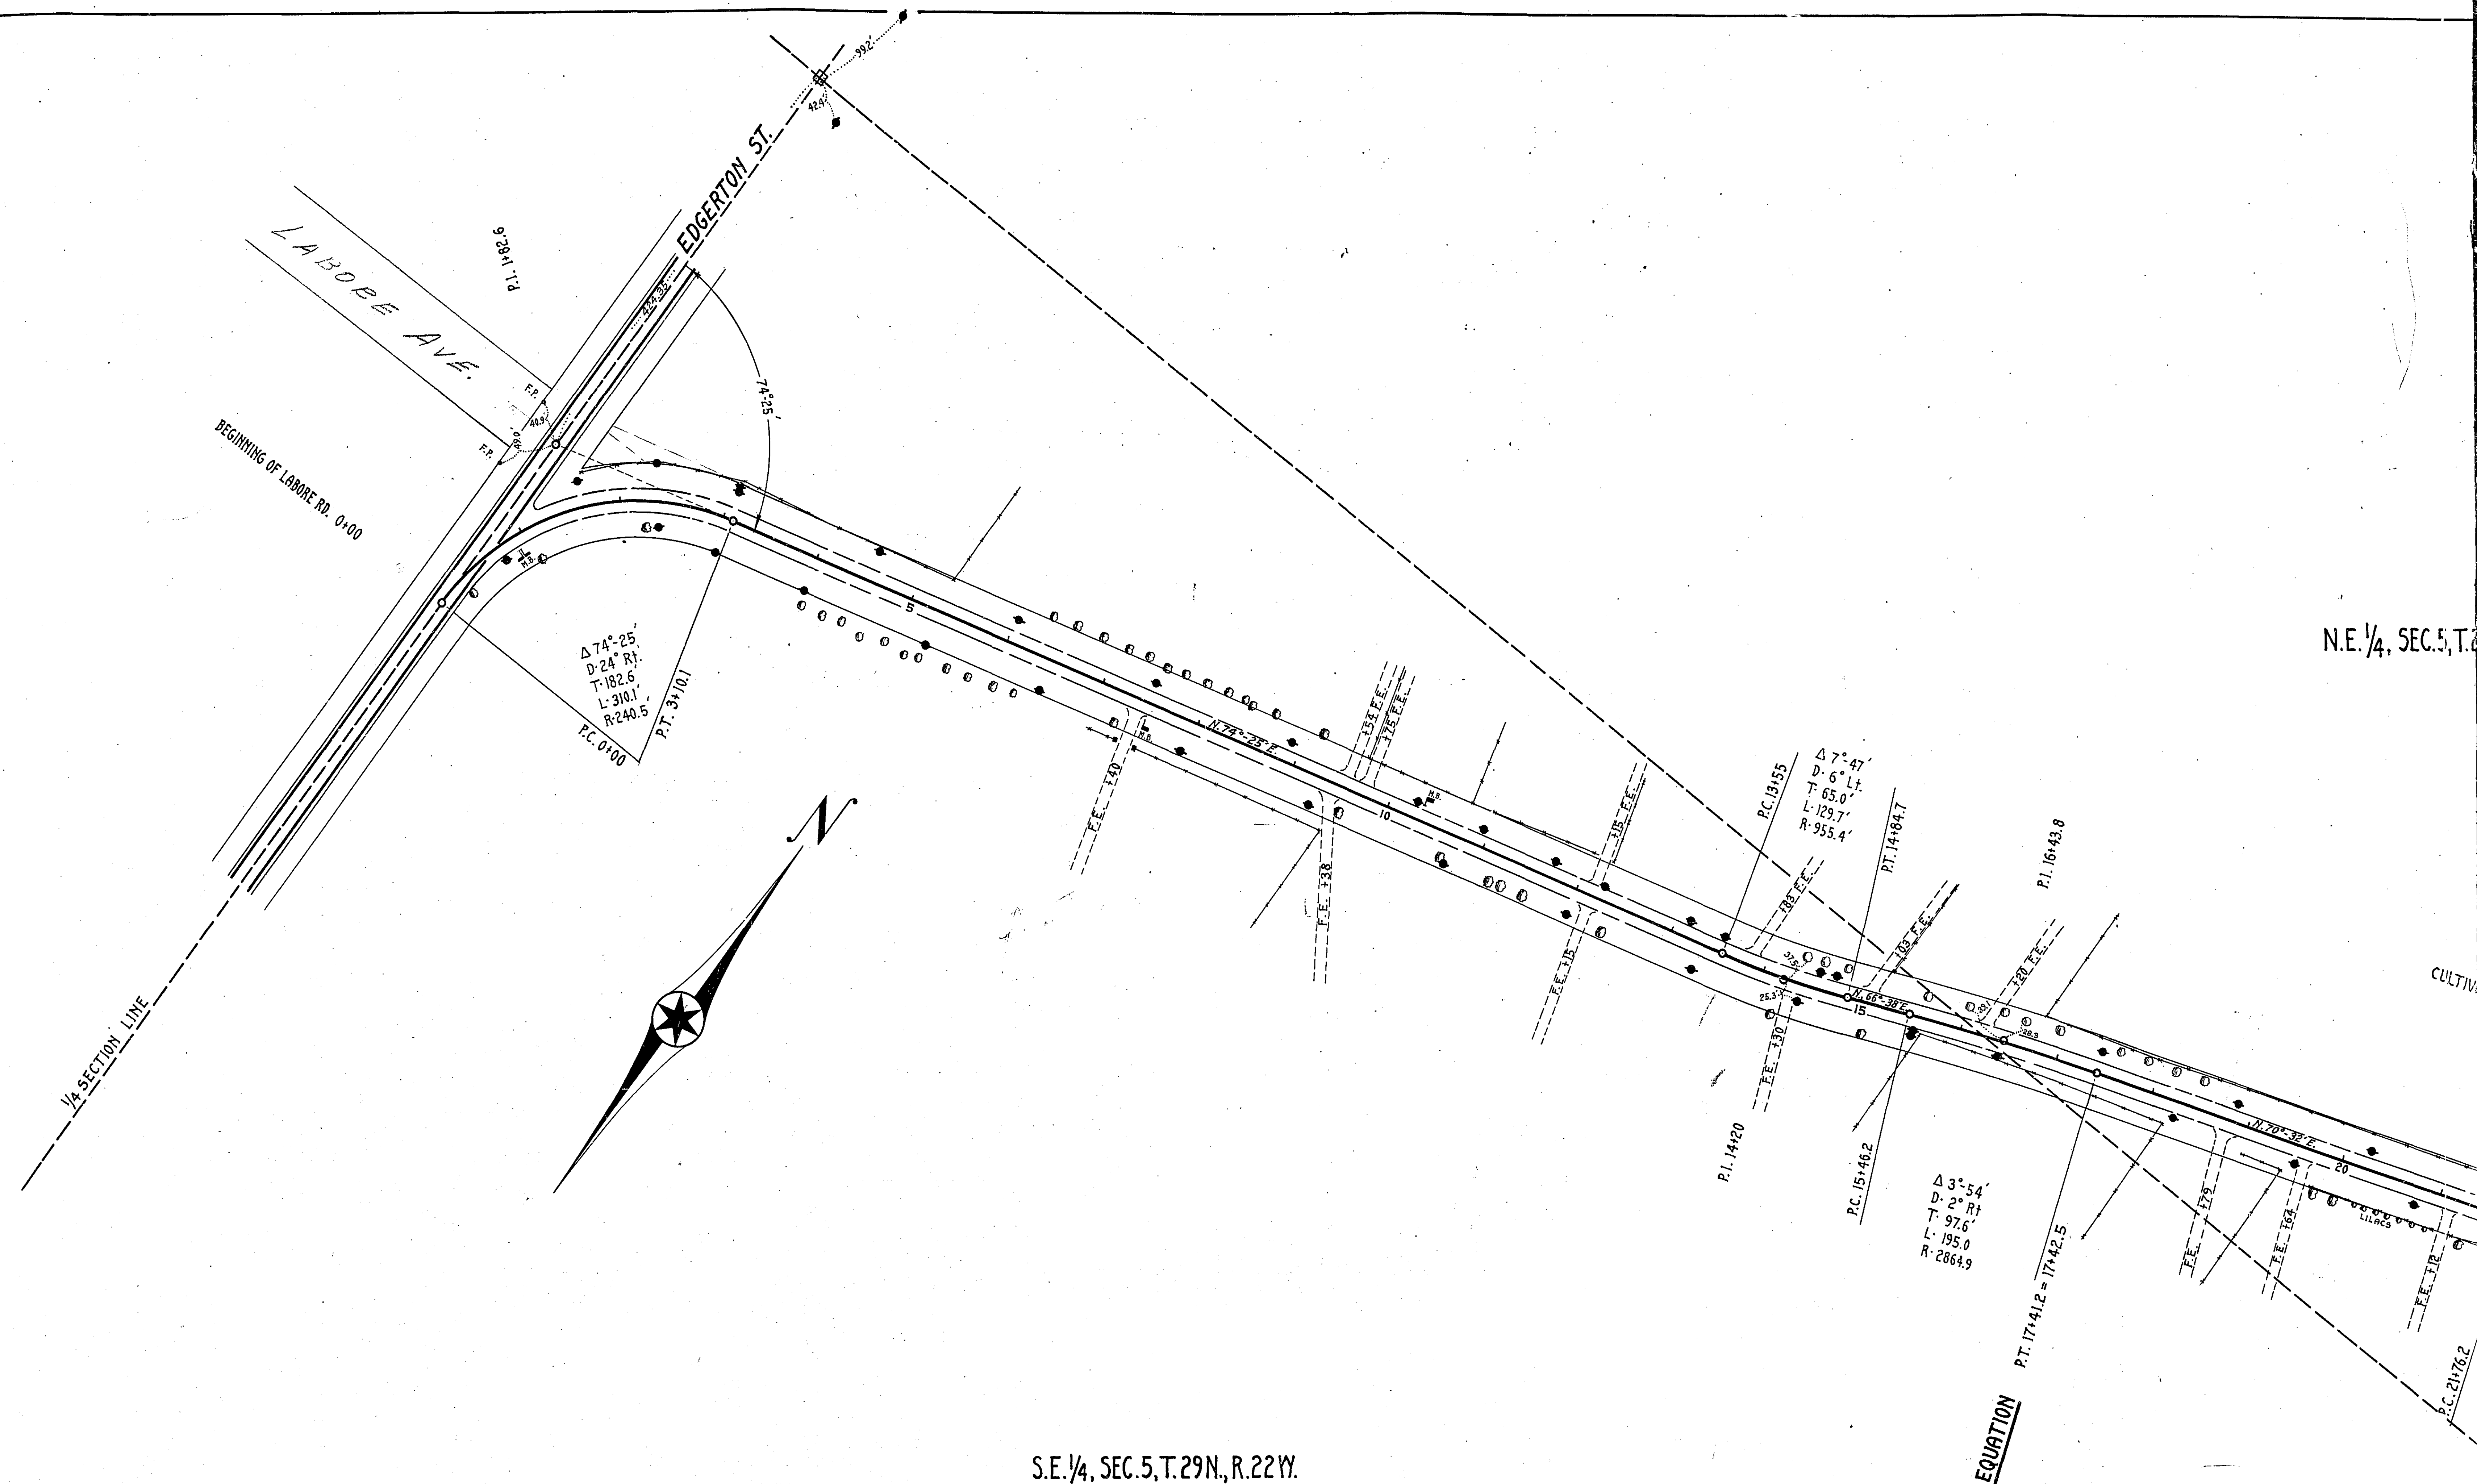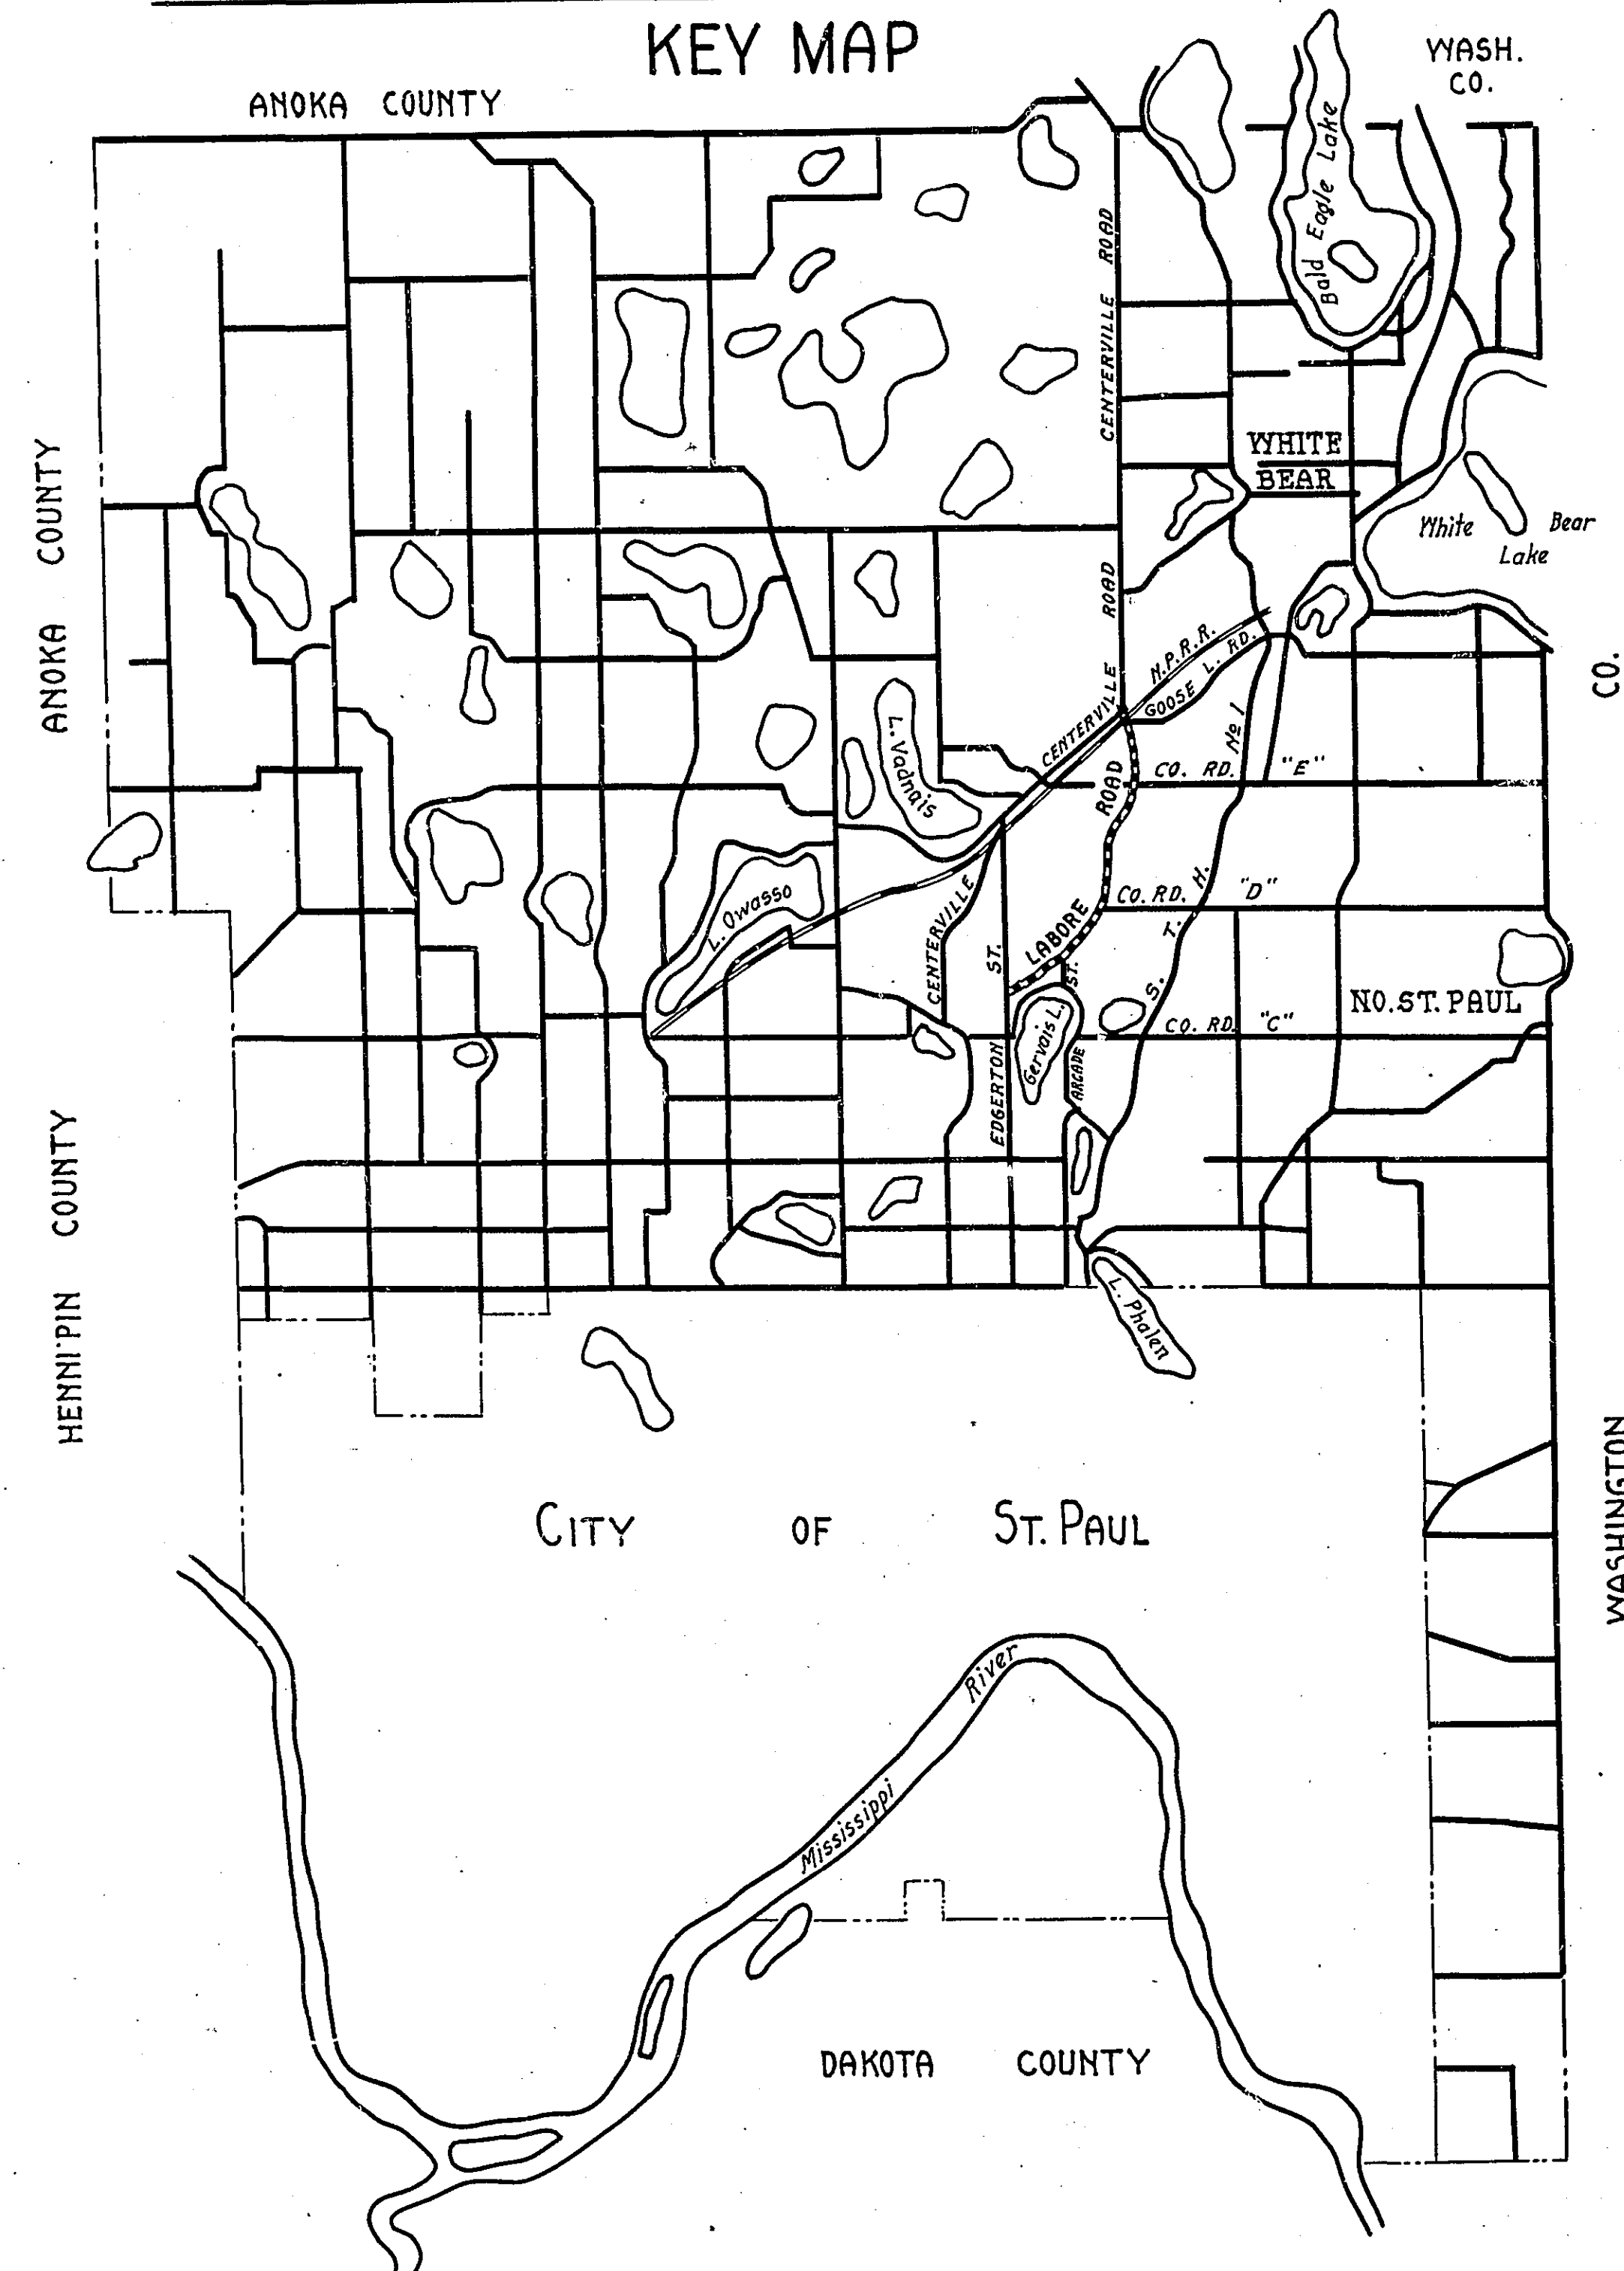

S.E. 1/4, SEC. 5, T. 29N., R. 22W.

N.E. 1/4, SEC. 5, T. 29 N., R. 22 W.


N.W. 1/4, SEC. 4, T. 29N., R. 22W.

[illegible]

20XF2/6

4, T.29N, R.22W.

SURFACING		
FT.	KIND	SQ. YDS.
Gravel		11,555.8

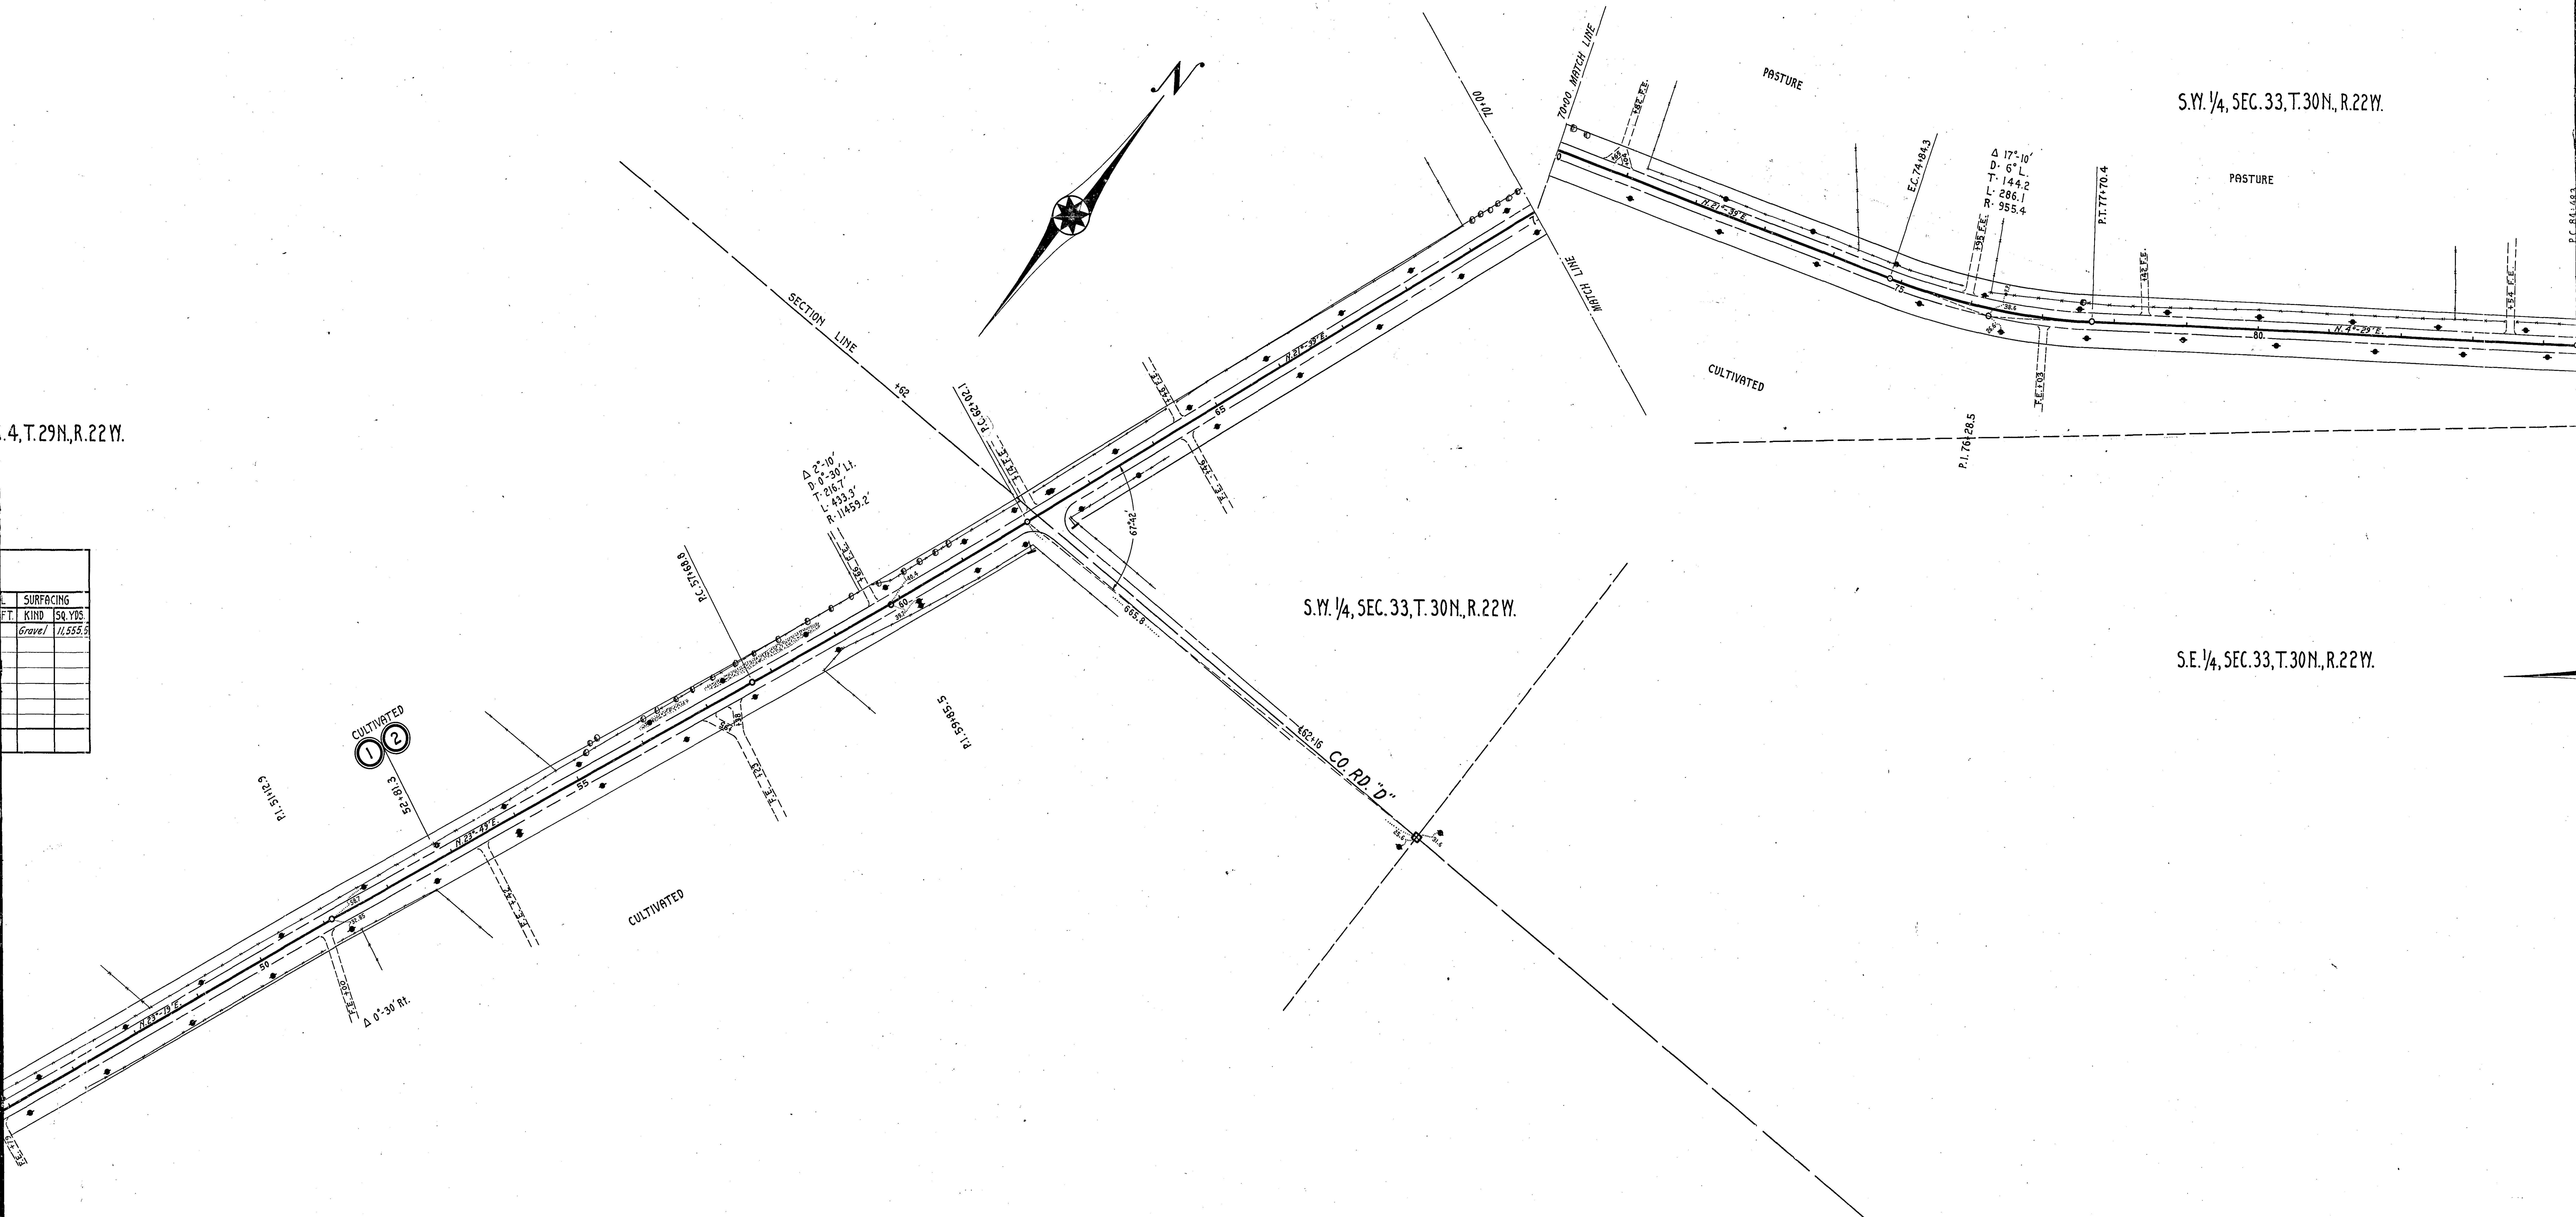

PASTURE

SECTION LINE 89+30



[illegible]

N.W. 1/4, SEC. 33, T. 30 N., R. 22 W.

N.E. 1/4, SEC. 33, T. 30N., R. 22W.

20X F-4/6

S.E. 1/4, SEC. 28, T. 30 N., R. 22 W.

 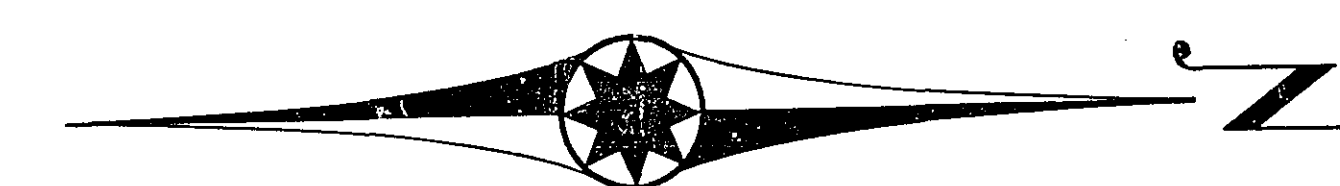


20X F5/6

S.W. 1/4, SEC. 28, T. 30 N., R. 22 W.

N.W. 1/4, SEC. 28, T. 30 N., R. 22 W.

N.E. 1/4, SEC. 28, T. 30 N., R. 22 W.

S.E. 1/4, SEC. 28, T. 30 N., R. 22 W.

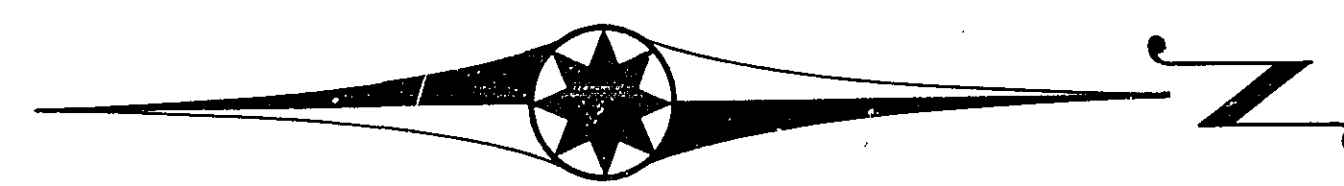

CENTERVILLE RD.

GOOSE LAKE RD.

Δ 16° 30'
D - 6° 50' Rt.
T - 166.2
L - 330.0
R - 1146.3

3 4

MEADOW

PASTURE

CULTIVATED

CULTIVATED

CULTIVATED

CULTIVATED

CULTIVATED

MEADOW

1/4 SECTION LINE

SUMMARY OF MILE 3

C.M.	CULVERTS				BRIDGES		SIGNS			GUARD RAIL	SURFACING	
	P 1	P 3	V.P.	C.I.P.	KIND	MARKING	CAUTION	GUIDE	R.R.		KIND	SQ. YDS.
							1	3			Gravel	11,733.3
TOTAL												

SUMMARY OF MILE 4

C.M.	CULVERTS				BRIDGES		SIGNS			GUARD RAIL	SURFACING	
	P 1	P 3	V.P.	C.I.P.	KIND	MARKING	CAUTION	GUIDE	R.R.		KIND	SQ. YDS.
											Gravel	10
TOTAL												

20X-F-6/6