




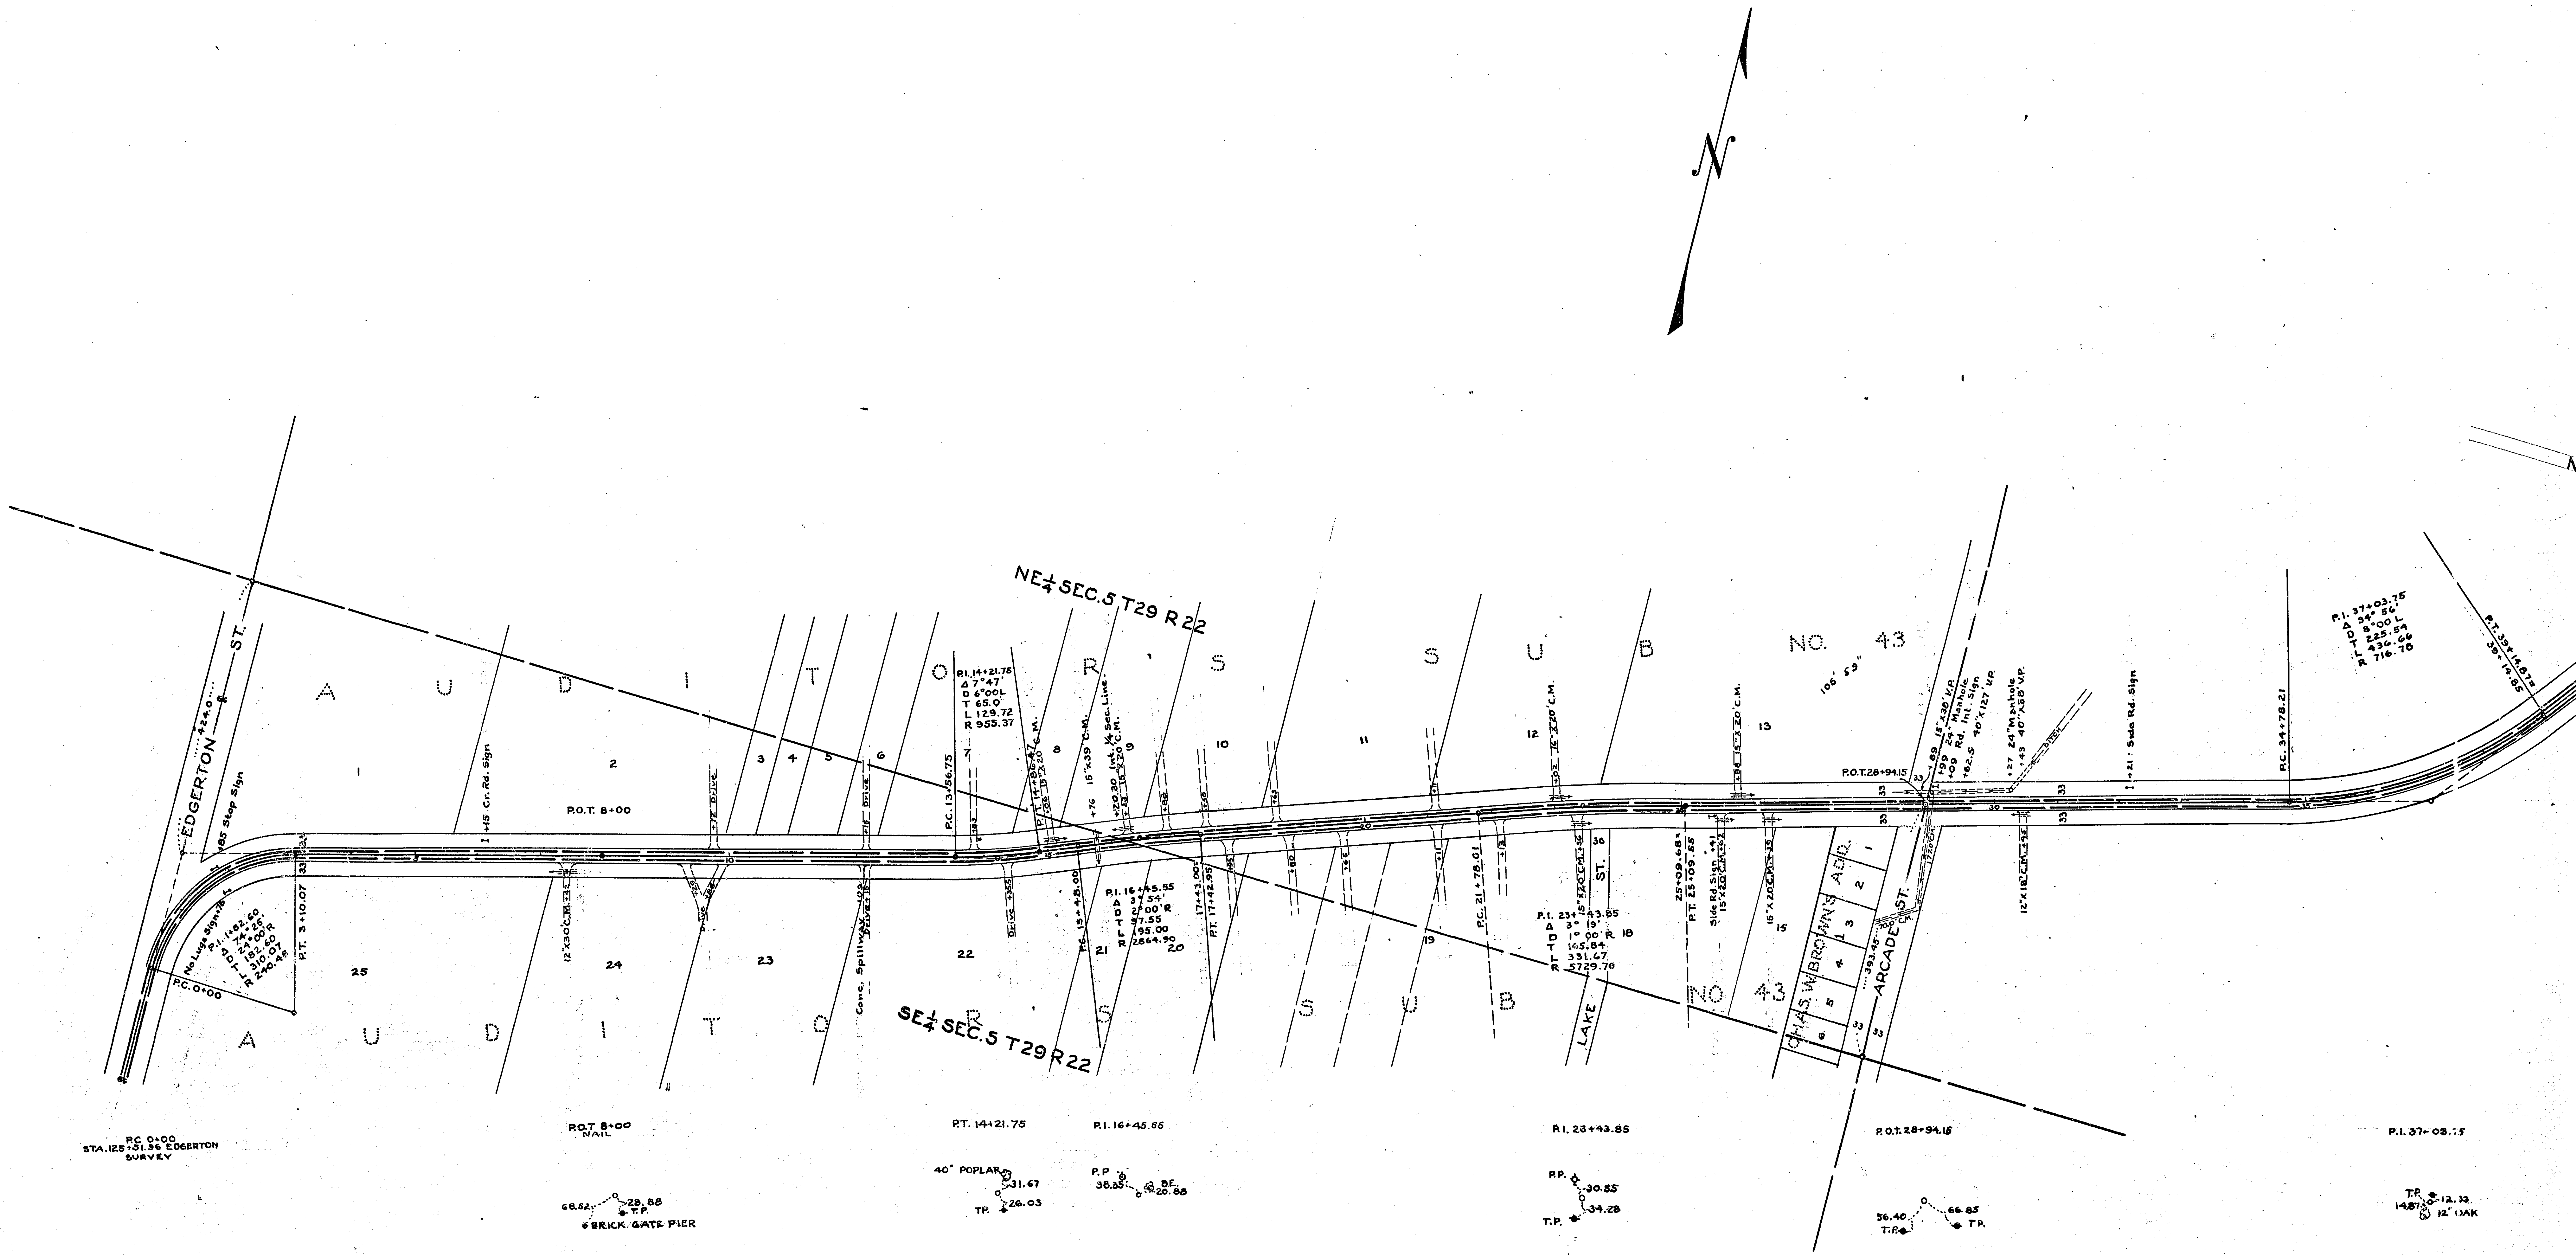

ROAD MAP
LABORE ROAD
FROM: EDGERTON TO CENTERVILLE RD.
ROAD NO. 4

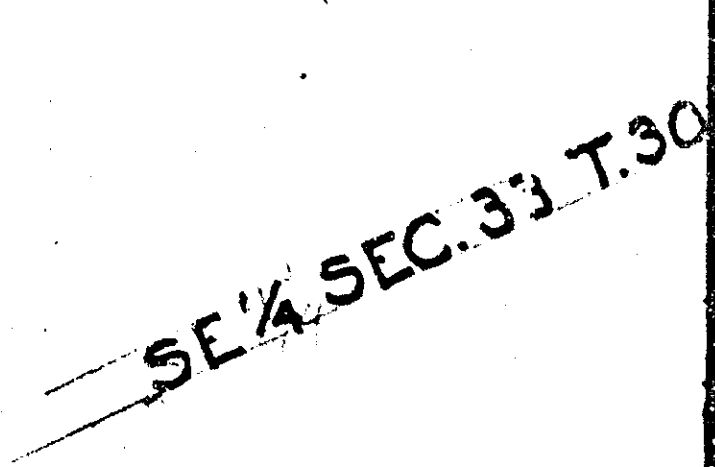

2

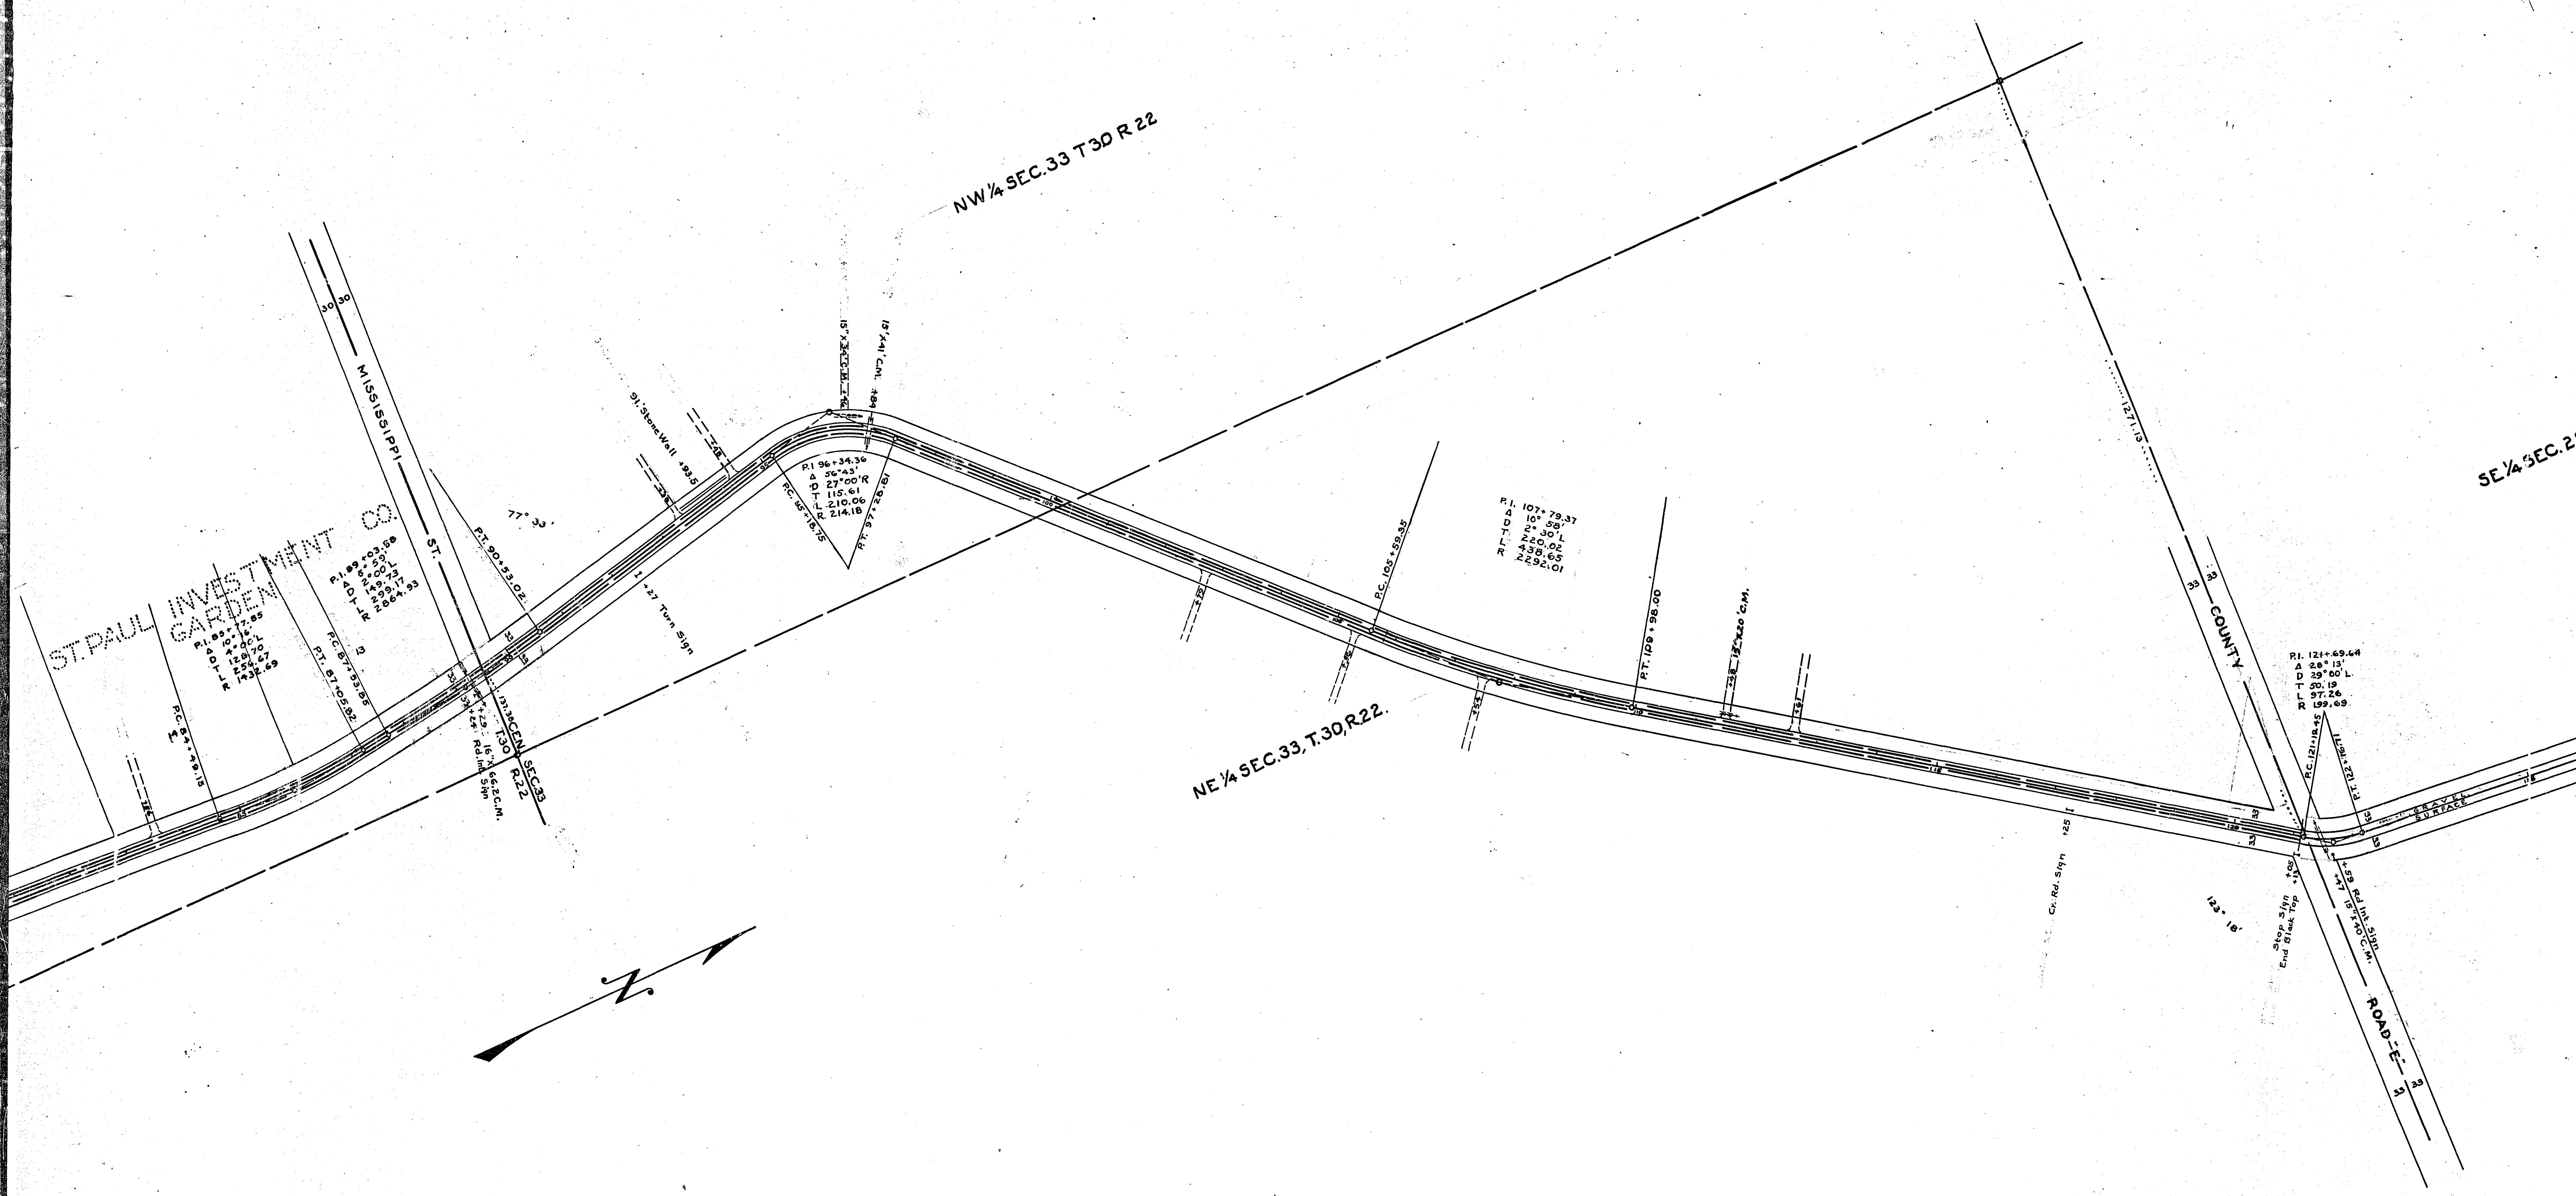

P.I. 85+77.85 P.I. 89+03.55 P.I. 96+34.35 P.I. 107+79.35 P.I. 121+69.65

35.97' BOX ELDER 37.95' T.P. 43.95' P.P. 29.6' T.P. 12" BOX ELDER 69.8' 28.41' 8" BOX ELDER 65.97' T.P. 18.42' 65.97' P.P.

ROAD MAP
 LABORE ROAD
 FROM: EDGERTON TO CENTERVILLE RD.
 ROAD NO. 4

