

OFFICE OF COUNTY ENGINEER
RAMSEY COUNTY
PROGRESSIVE ROAD MAP

BIRCH LAKE AVE.


FROM BIRCH LAKE BLVD. SOUTH TO BALD EAGLE AVE.

TOTAL LENGTH 4994.69 FT. 0.946 MILES


Scale 1 in. = 100 ft.

CONVENTIONAL SIGNS & ABBREVIATIONS			
ITEM	CONVENTION	ITEM	ABBREV.
State Line	---	Surfacing	S
County Line	---	Sectional Conc. Culv. (light type)	P1
Township Line	---	Sectional Conc. Culv. (heavy type)	P3
Section Line	---	Corrugated Metal Culvert	C.M.
City or Village	---	Vitrified Clay Pipe	V.P.
Fence	---	Cast Iron Pipe	C.I.P.
Right of way Line	R.O.W.	Private	Pri.
Earth Road - not standard	Rd.	In place	Imp.
Graveled on Grade not stand.	G.	Right	RT
Graded to Standard	Gt.	Left	LT
Graded & Graveled to stand.	Gt. & G.	Intersection Angle	h
Paved	Pvd.	Radius	R
Farm Entrance	EF	Point of Curve	P.C.
Railroads	RR	" Tangent	P.T.
Retaining walls	R.W.	" Intersection	P.I.
Guard Rail	G.R.	" on Curve	P.O.C.
Survey line	S.	" Tangent	P.O.T.
Gravel Pit	⊙		
Sand Pit	⊙		
Clay Pit	⊙		
Rock Quarry	⊙		
Culverts:			
Plain	---	Surveyed by	Dates
With face walls	---	Paul J. Crane	5-14-25 9-17-25
With wing walls	---	Mapped by	Dates
Drop Inlets	CB	C. W. Soukup	2-17-26 2-24-26
Electric Poles	EP	Revised by	Date
Telephone or Telegraph Poles	TP		
Trolley Poles	Tr.P.		
County Marking Signs	M. sign		
Guide	G. sign		
Caution	C. sign		
Reflector	R. sign		
Rail Crossing	RR sign		
Railroad Crossing Sign	Xing. sign		

KEY MAP

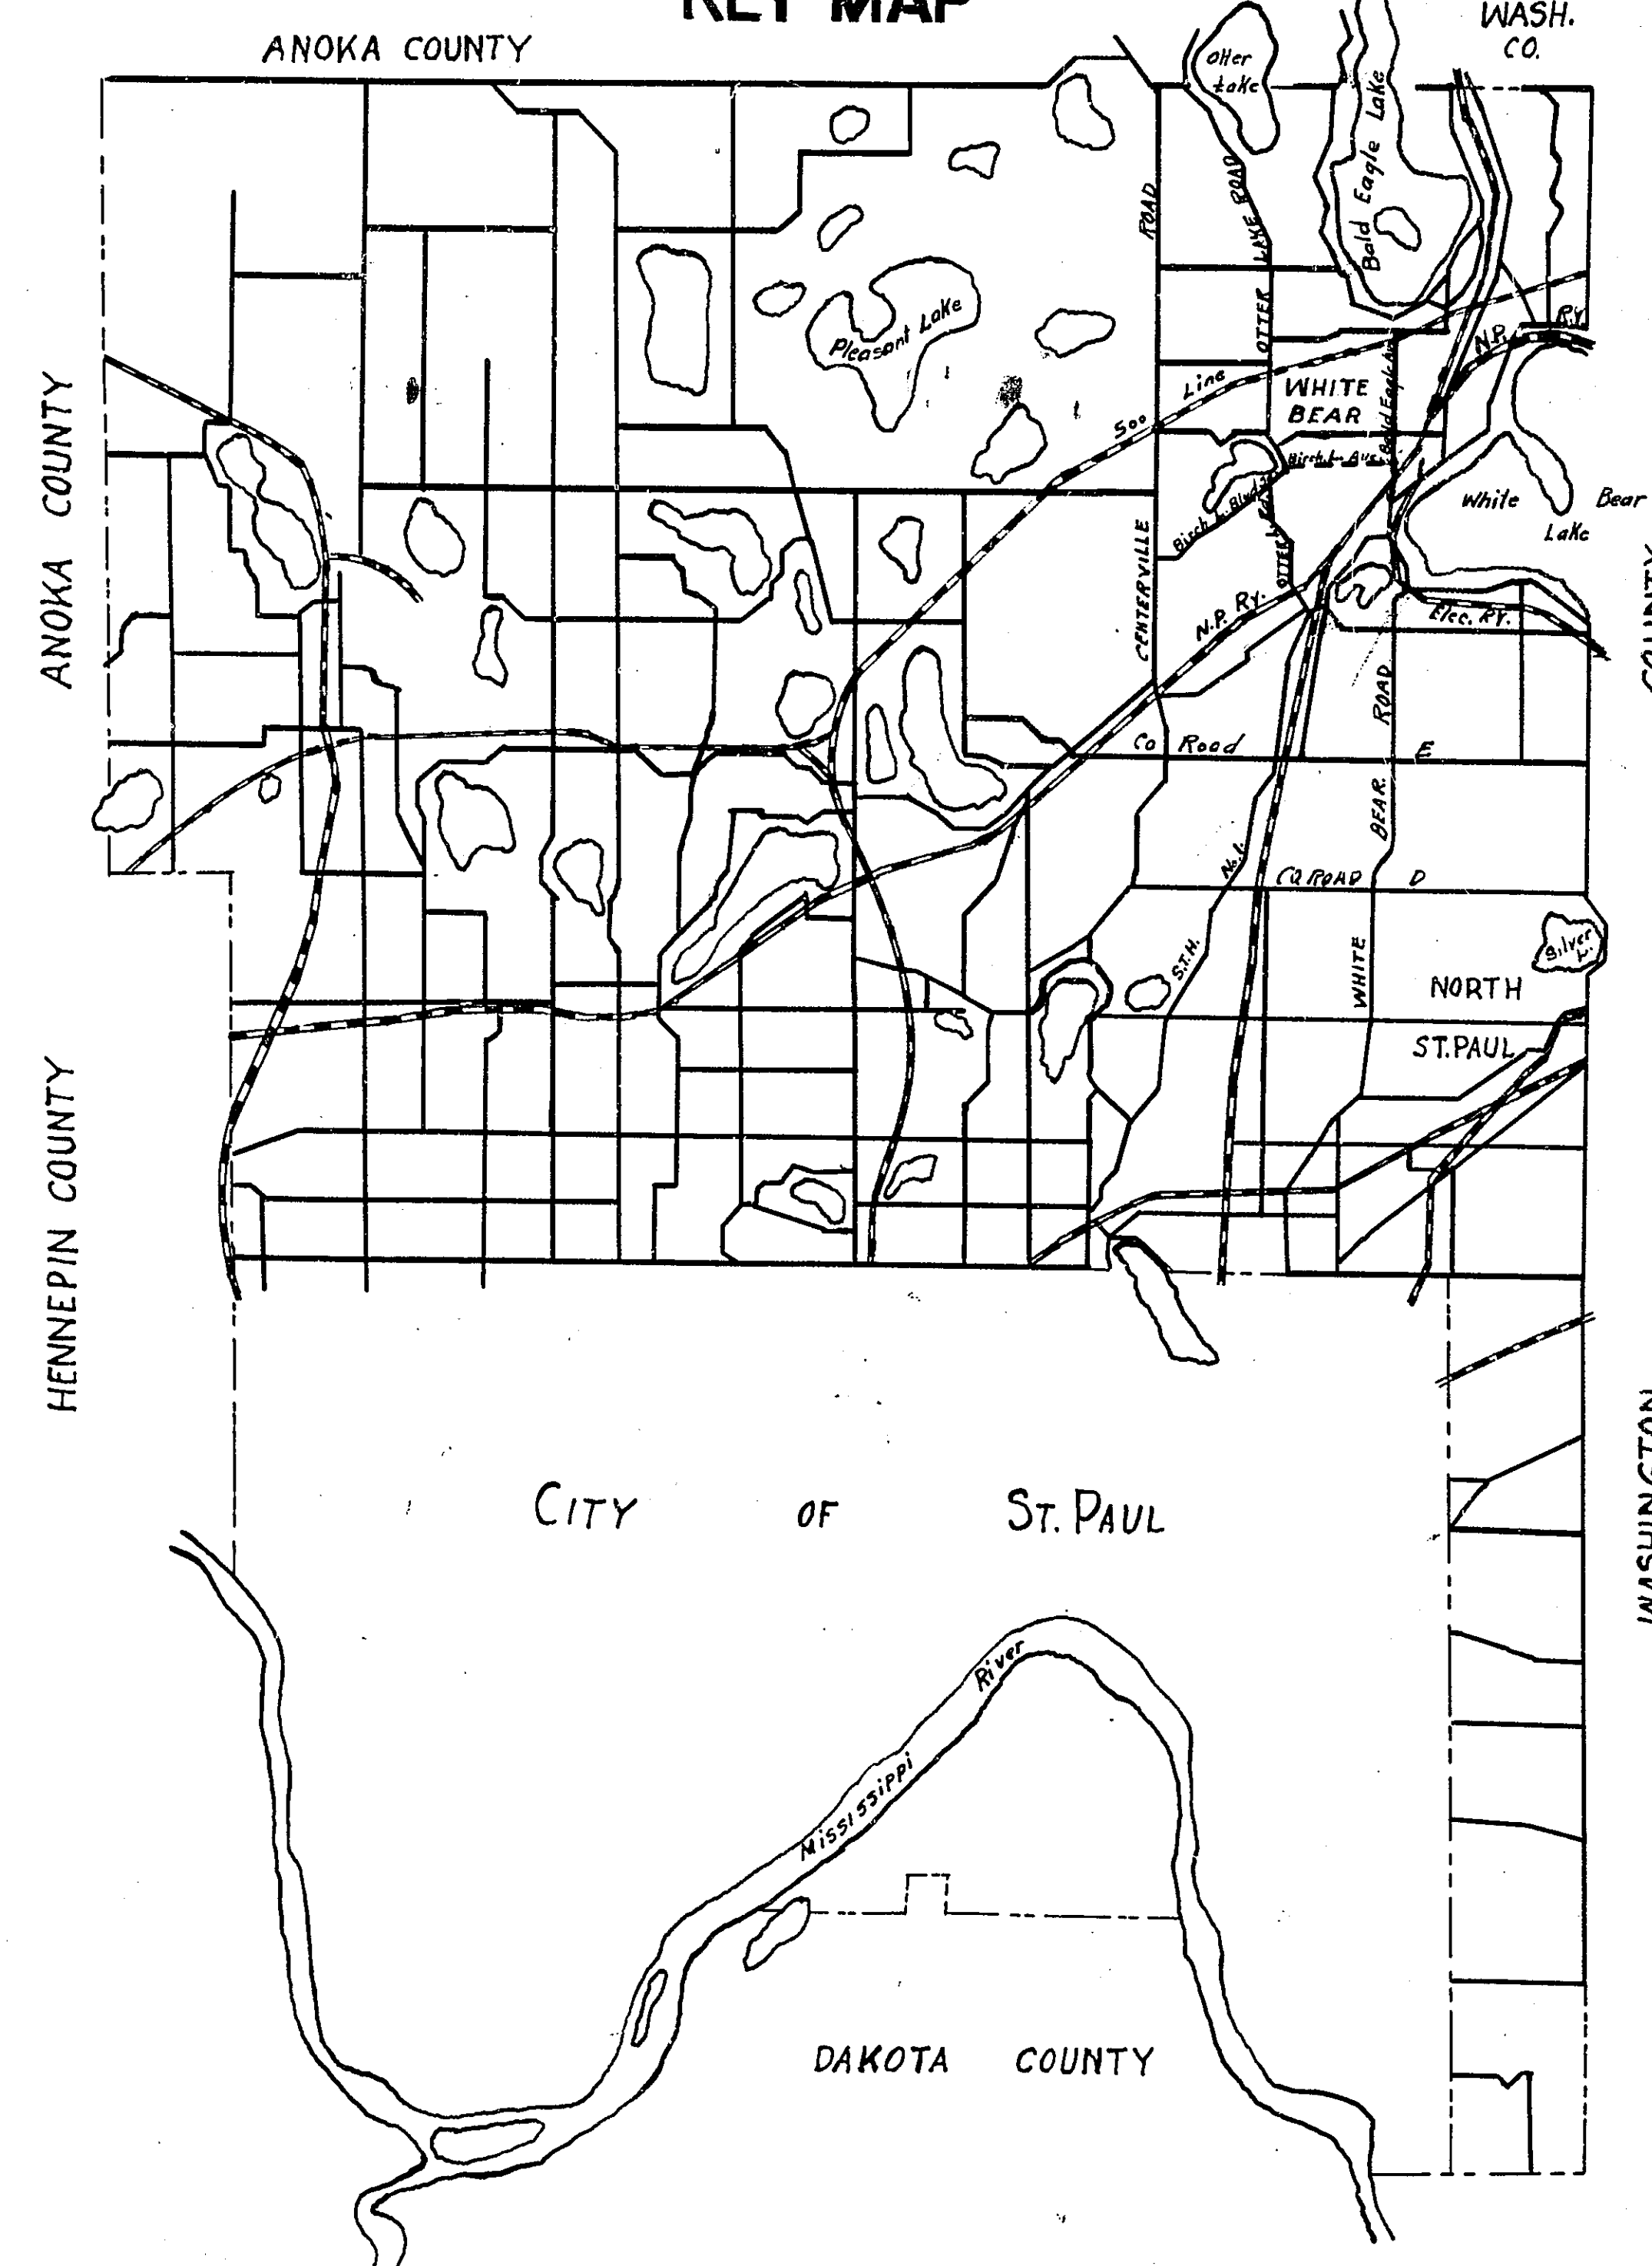

S.E. 1/4 SEC. 15-30-22

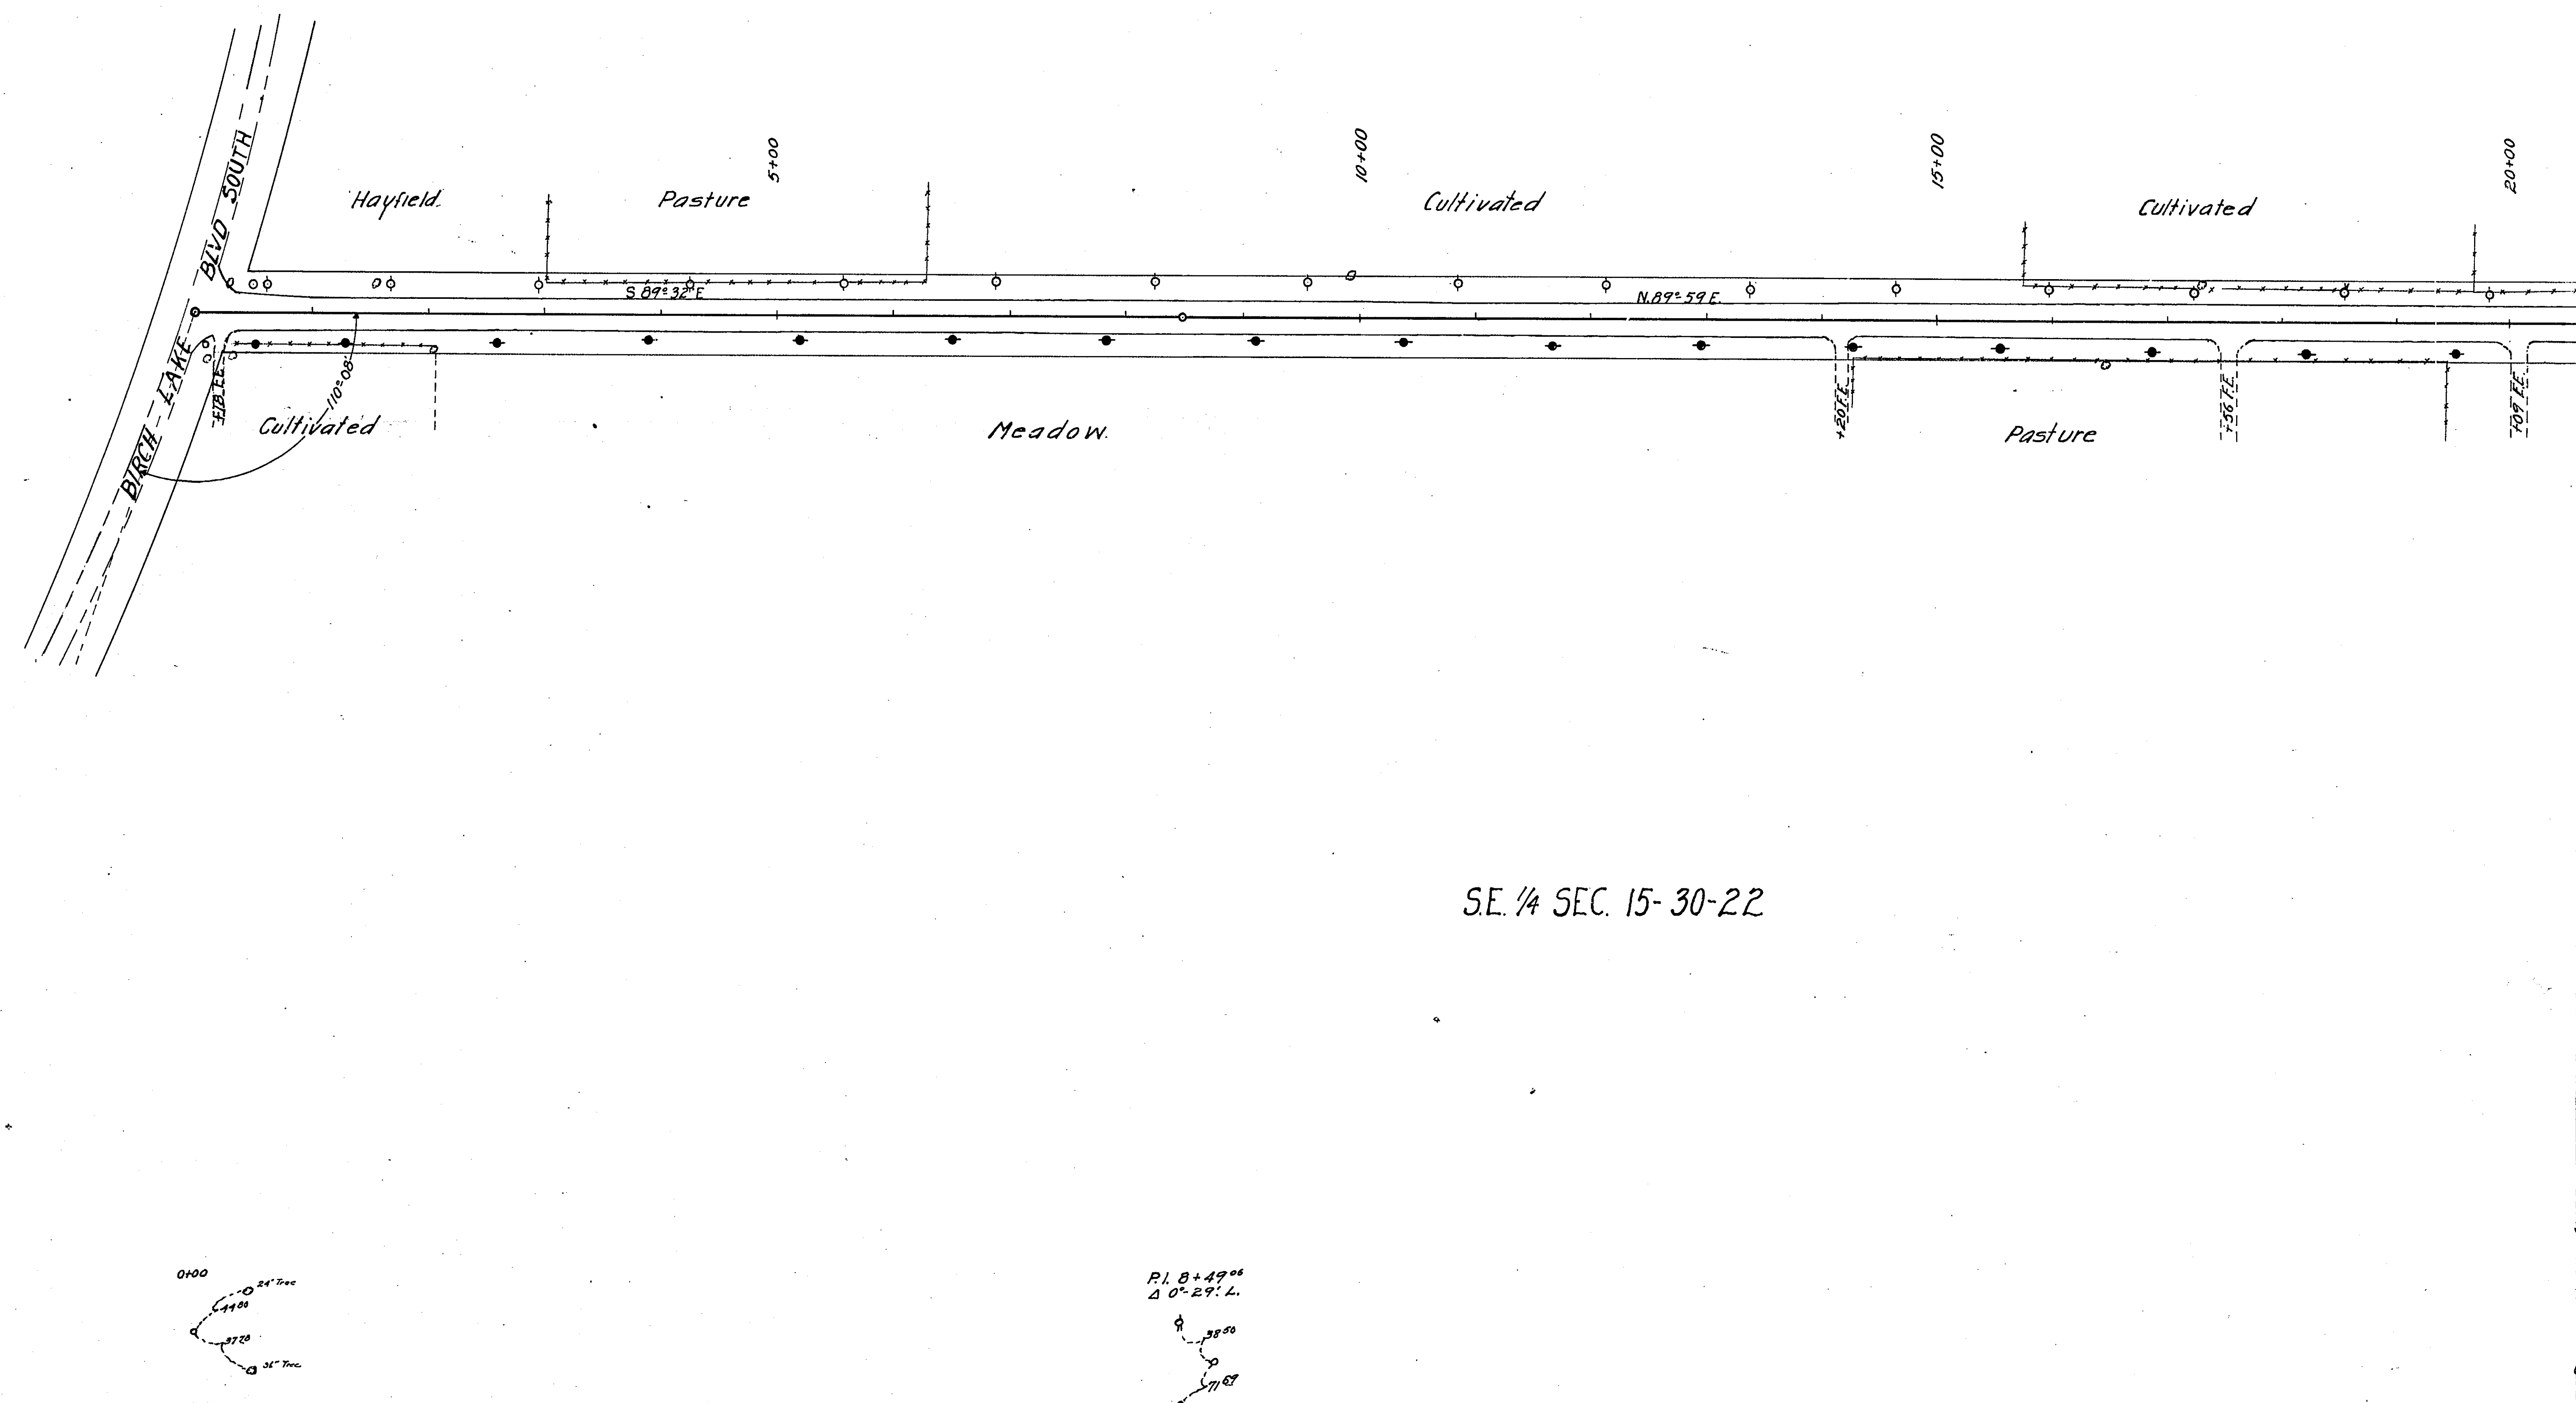

S.E. 1/4 SEC. 15-30-22

