

OFFICE OF COUNTY ENGINEER RAMSEY COUNTY PROGRESSIVE ROAD MAP

OF
COUNTY RD. "D"
JOHANNA BLVD.
COUNTY RD. "E"
MADNAIS BLVD.
FROM FAIRCHILD AV. TO E.CO. LINE

TOTAL LENGTH 64,619.53 FT. 12.24 MILES
SCALE: 1" = 100'



CONVENTIONAL SIGNS & ABBREVIATIONS

ITEM	CONVENTION	ABBREV.
County Line	---	
Township Line	---	
Section Line	---	
City or Village	---	
Fence	---	
Right-of-Way Line	---	R.O.W.
Earth Road - not standard	---	Rd.
Graveled on Grade not standard	---	G.
Graveled to Standard	---	Gr.
Graveled & Graveled to Stand.	---	Gr. & G.
Bituminous Treated	---	Bit.Tr.
Paved	---	Pvd.
Farm Entrance	---	F.E.
Railroads	---	R.R.
Retaining Walls	---	R.W.
Guard Rail	---	G.R.
Survey Line	---	S
Gravel Pit	---	GP
Sand Pit	---	SP
Clay Pit	---	CP
Culverts	---	
" Plain	---	
" With Headwalls	---	
Manhole	---	M.H.
Catch Basin	---	C.B.
Electric Poles	---	E.P.
Telephone or Telegraph Poles	---	T.P.
Trolley Poles	---	T.P.
Road Lamps	---	R.L.
County Marking Signs	---	
" Guide	---	M. sign
" Caution	---	C. sign
" Reflector	---	R. sign
" Rail Crossing	---	R.R. sign
Railroad - Crossing Sign	---	Xing sign

ITEM	ABBREV.
Surfacing	S
Sectional Conc. Culu. (light type)	P-1
Sectional Conc. Culu. (heavy type)	P-3
Corrugated Metal Culvert	C.M.
Vitrified Clay Pipe	V.P.
Cast Iron Pipe	C.I.P.
Private	Pri.
In place	Imp.
Right	RT.
Left	LT.
Intersection Angle	Δ
Radius	R
Point of Curve	P.C.
" Tangent	P-T
" Intersection	P-I
" on Curve	P-O-C
" Tangent	P-O-T

Surveyed by	Dates
BUCRANE A.W. LINDAHL	1926-27-28
Mapped by	Dates
ALBERT THAUME R. GRAHAM	1931
Revised by	Dates

KEY MAP

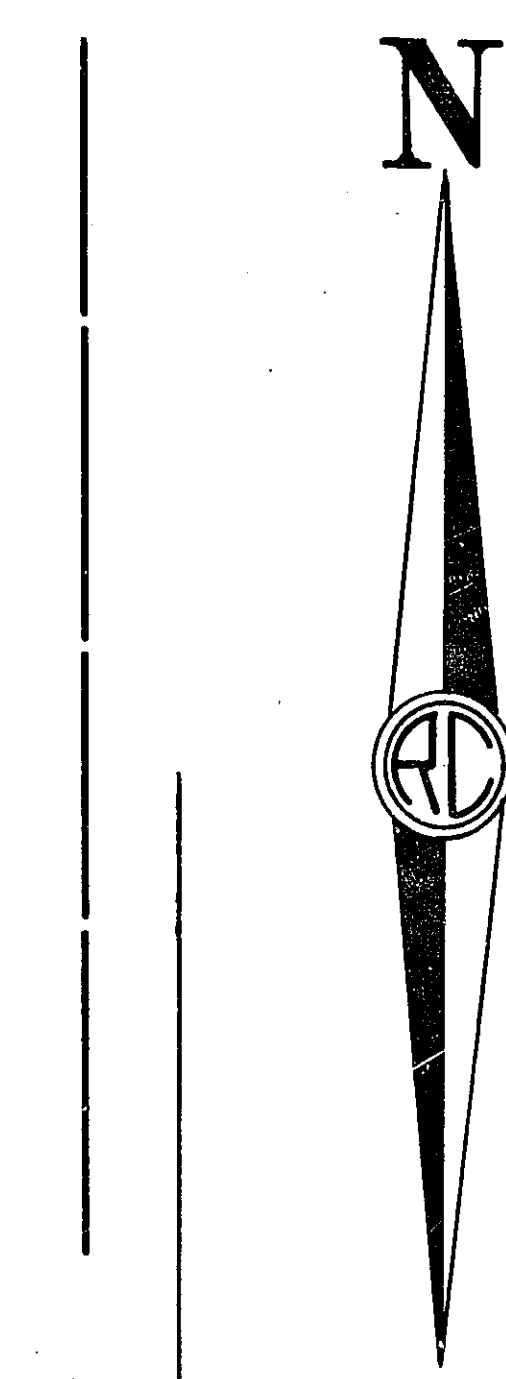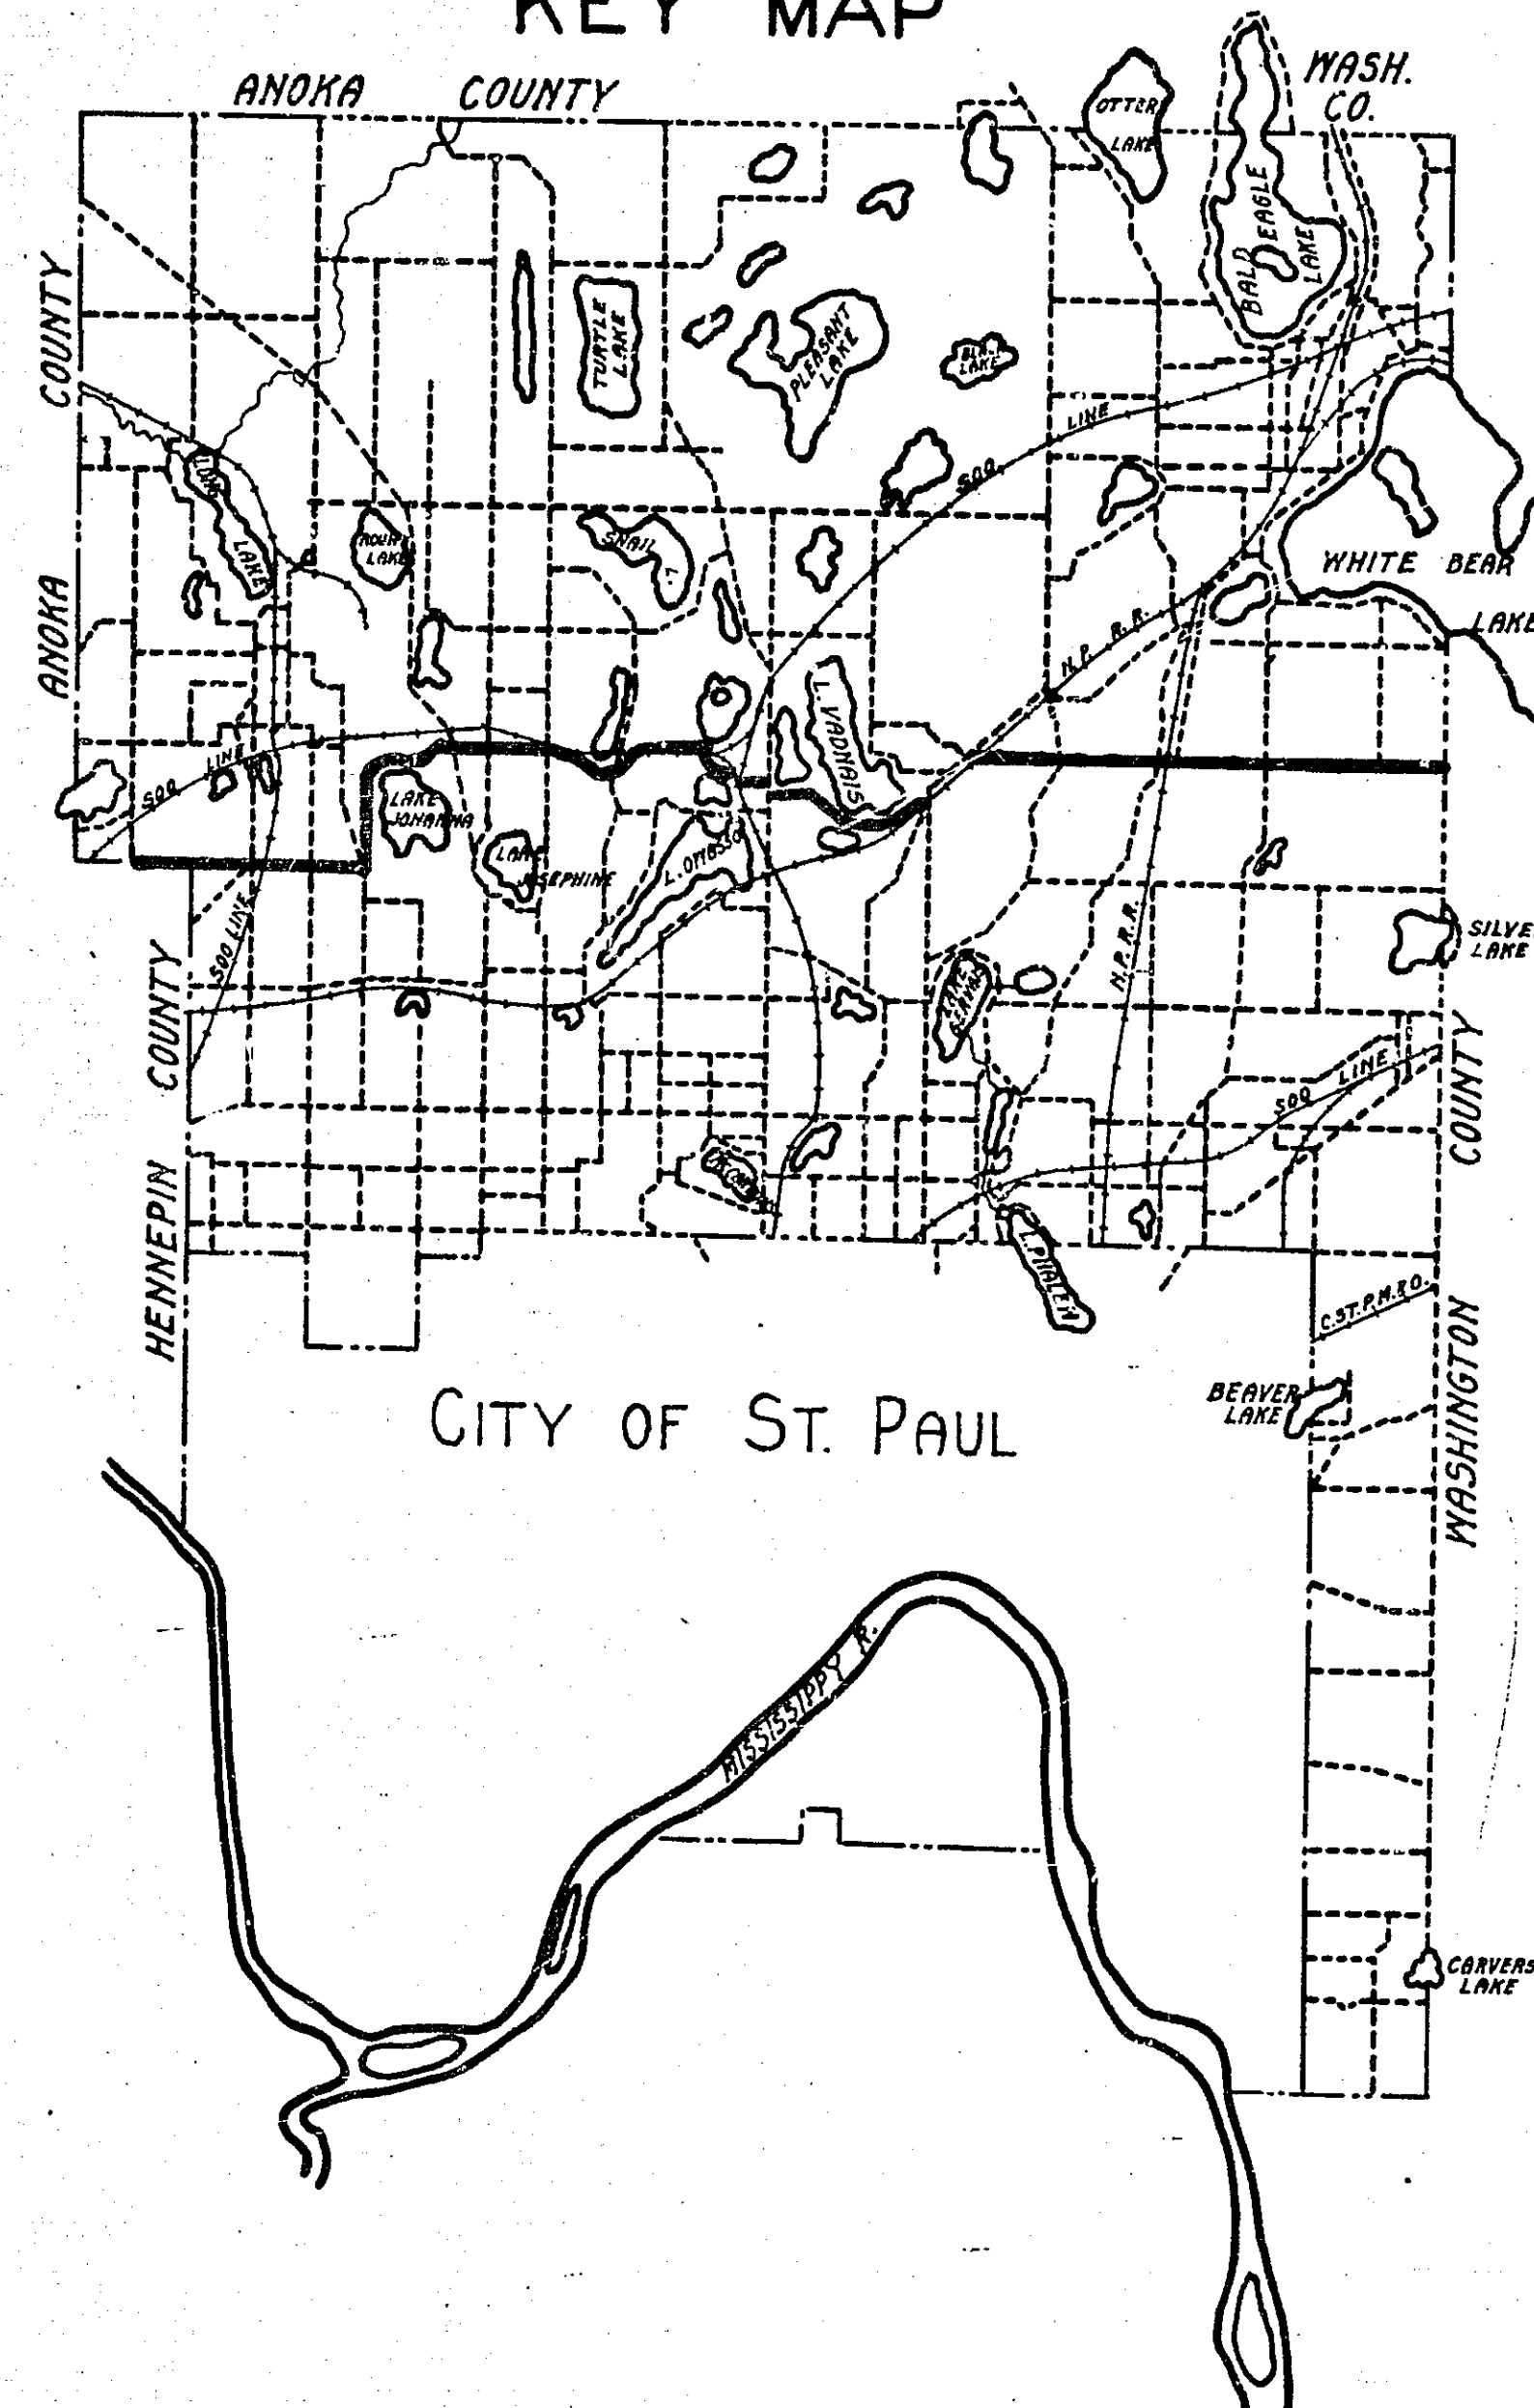

AVE

FAIRCHILD

0+00

S.E. 1/4 SEC. 31-30-23

FAIRFIELD DRIVE

VALLEY VIEW RD.

FOSS RD.

"D"

5+00

10+00

15+00

20+00

N.E. 1/4 SEC. 6-29-23

20XF1/11

SEC. 31-30-23

SW ¼ SEC. 32-30-23

VALLEY VIEW RD.

FOSS RD.

HIGHCREST RD.

15+00

20+00

25+00

30+00

35+00

40+00

45+00


30+15

SEC. 6-29-23

NW ¼ SEC. 5-29-23

PI. 26+30
Δ 27°R

F 2 / 1 1

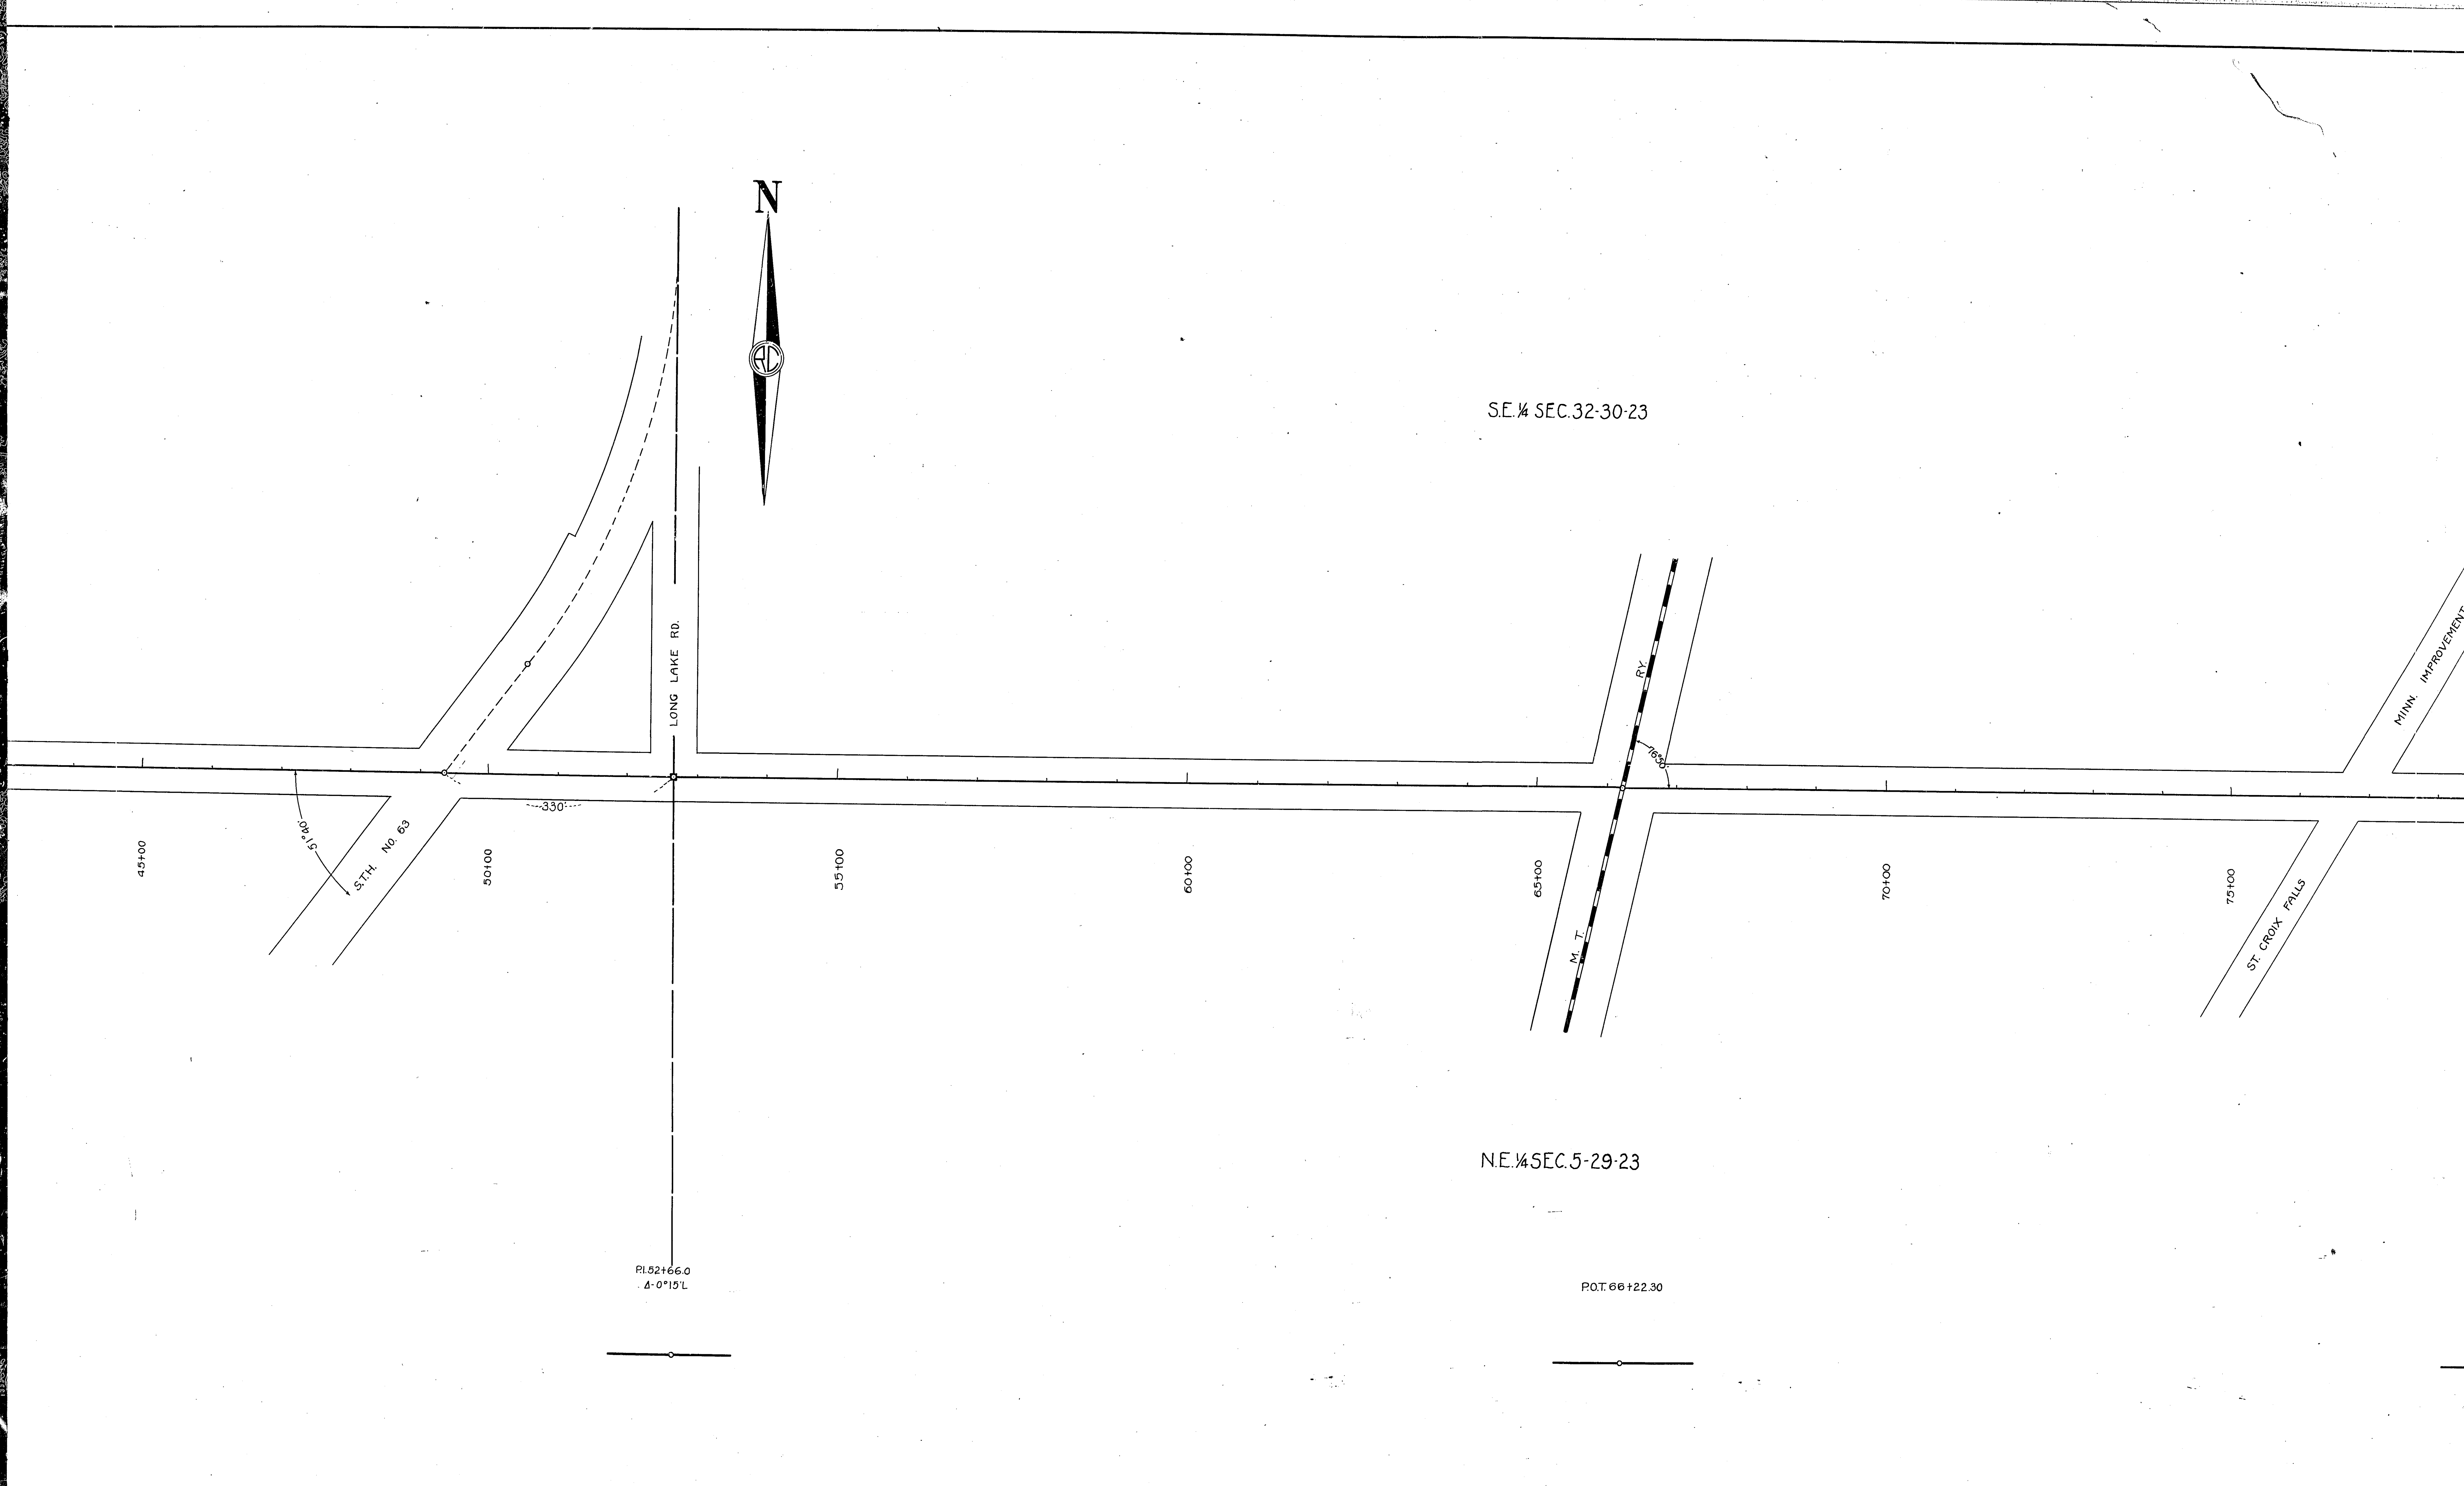

S.E. 1/4 SEC. 32-30-23

N.E. 1/4 SEC. 5-29-23

P.I. 52+66.0
4-0°15' L

P.O.T. 66+22.30

SW ¼ SEC. 33-30-23

NW ¼ SEC. 4-29-23



MINN. IMPROVEMENT

AVE

Co.

NEW BRITTON RD

EQUATION
STA. 105+40.40 =
STA. 0+00

5+00

0+00

75+00

ST. CROIX FALLS

80+00

85+00

90+00

95+00

100+00

105+00

P1.79+00.80
Δ=0°12'R

P1.105+40.40=0+00

F-4/11

SE 1/4 SEC. 31, T. 30, R. 23

RD. INT. SIGN
BLVD.
RAMSEY COUNTY

H E N N E P I N

C O U N T Y

NE $\frac{1}{4}$ SEC. 6 T29, R23

NW $\frac{1}{4}$ SEC. 6 T29 R23

COUNTRY ROAD "D"

FROM: WEST COUNTY LINE TO JOHANNA BLVD
ROAD NO. 6

SW 1/4 SEC. 32 T 30 R 23

NE 1/4 SEC. 5 T 29 R 23

ROAD MAP
COUNTY ROAD "D"
FROM: WEST COUNTY LINE TO JOHANNA BLVD
ROAD NO. 6

SE 1/4 SEC. 32 T 30 R 23

SW 1/4 SEC. 33 T 30 R 23

NE 1/4 SEC. 5 T 29 R 23

NW 1/4 SEC. 4 T 29 R 23

ROAD MAP
COUNTY ROAD "D"
FROM: WEST COUNTY LINE TO JOHANNA BLVD
ROAD NO. 6

SW 1/4 SEC 33 T30R23

NW 1/4 SEC 4 T29R23

ROAD MAP
COUNTY ROAD "D"
FROM: WEST COUNTY LINE TO JOHANNA BLVD
ROAD NO. 6