


OFFICE OF COUNTY ENGINEER
 RAMSEY COUNTY
 PROGRESSIVE ROAD MAP
 OF
COUNTY ROAD B₂
 FROM EDGERTON ST. TO ARCADE ST.

TOTAL LENGTH 2643.7 FT. 0.5 MILES

Scale 1 in. = 100 ft.


CONVENTIONAL SIGNS & ABBREVIATIONS		
ITEM	CONVENTION	ABBREV.
State Line	---	S
County Line	---	P ₁
Township Line	---	P ₂
Section Line	---	C.M.
City or Village	---	VP
Fence	---	C.I.P.
Right-of-way Line	R-O-W	Ph.
Earth Road - not standard	Rd.	Imp.
Graveled on grade not stand.	G.	Right
Graded to Standard	Gr. & G.	Left
Graded & Graveled to stand	Gr. & G.	Intersection Angle
Paved	Pvd.	Radius
Farm Entrance	F.E.	Point of Curve
Railroads	R.R.	" Tangent
Retaining walls	R.W.	" " Intersection
Guard Rail	G.R.	" on Curve
Survey Line	S	" Tangent
Gravel Pit	GP	
Sand Pit	SP	
Clay Pit	CP	
Rock Quarry	RQ	
Culverts	C	
Plain		
With face walls		
With wing walls		
Drop Inlets		
Electric Poles		
Telephone or Telegraph Poles		
Trolley Poles		
County Marking Signs		
" Guide		
" Caution		
" Reflector		
" Rail Crossing		
Railroad Crossing Signs		

KEY MAP

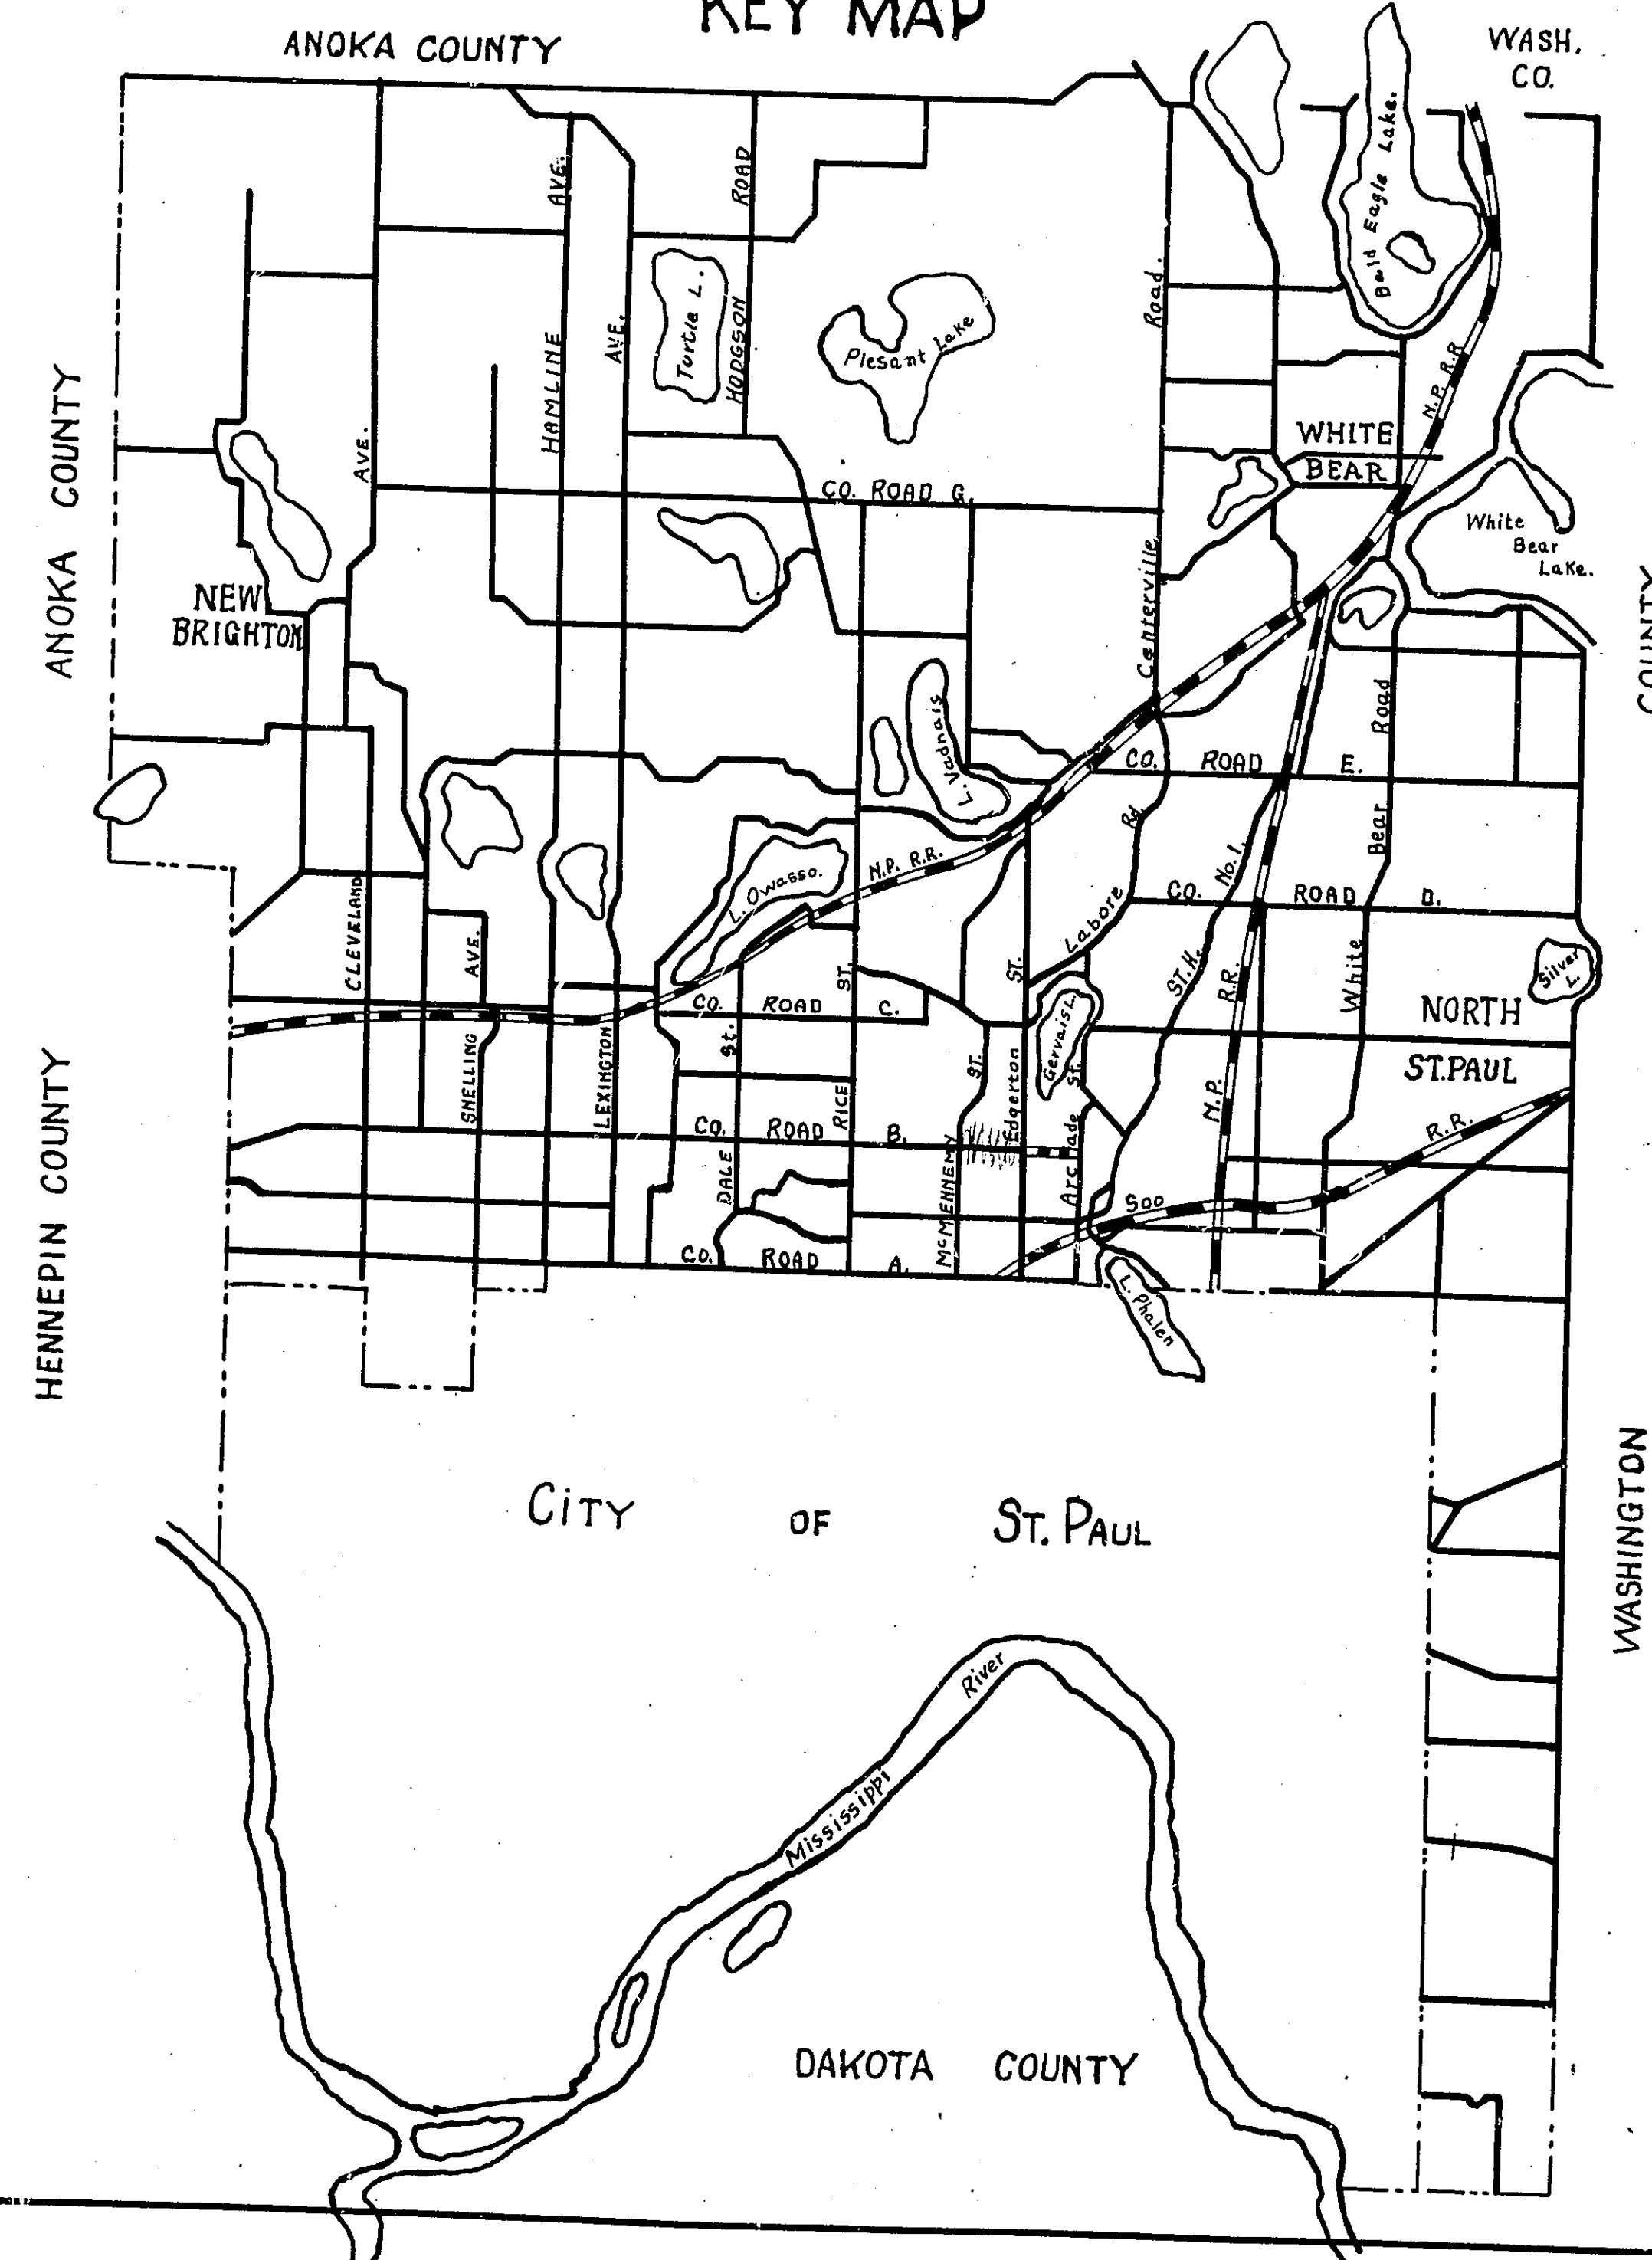

S.E. 1/4 Sec. 8-T29N-R22W

SUMMARY OF MILE									
STA. 0+00 TO STA. 26+43.7									
DRAIN	CULVERTS	BRIDGES		SIG.					
TYPE	C.M.	P ₁	P ₂	V.P.	C.I.P.	KIND	MARKING	CAUTION	
12x10									
18x132				12x92					1
24x40									

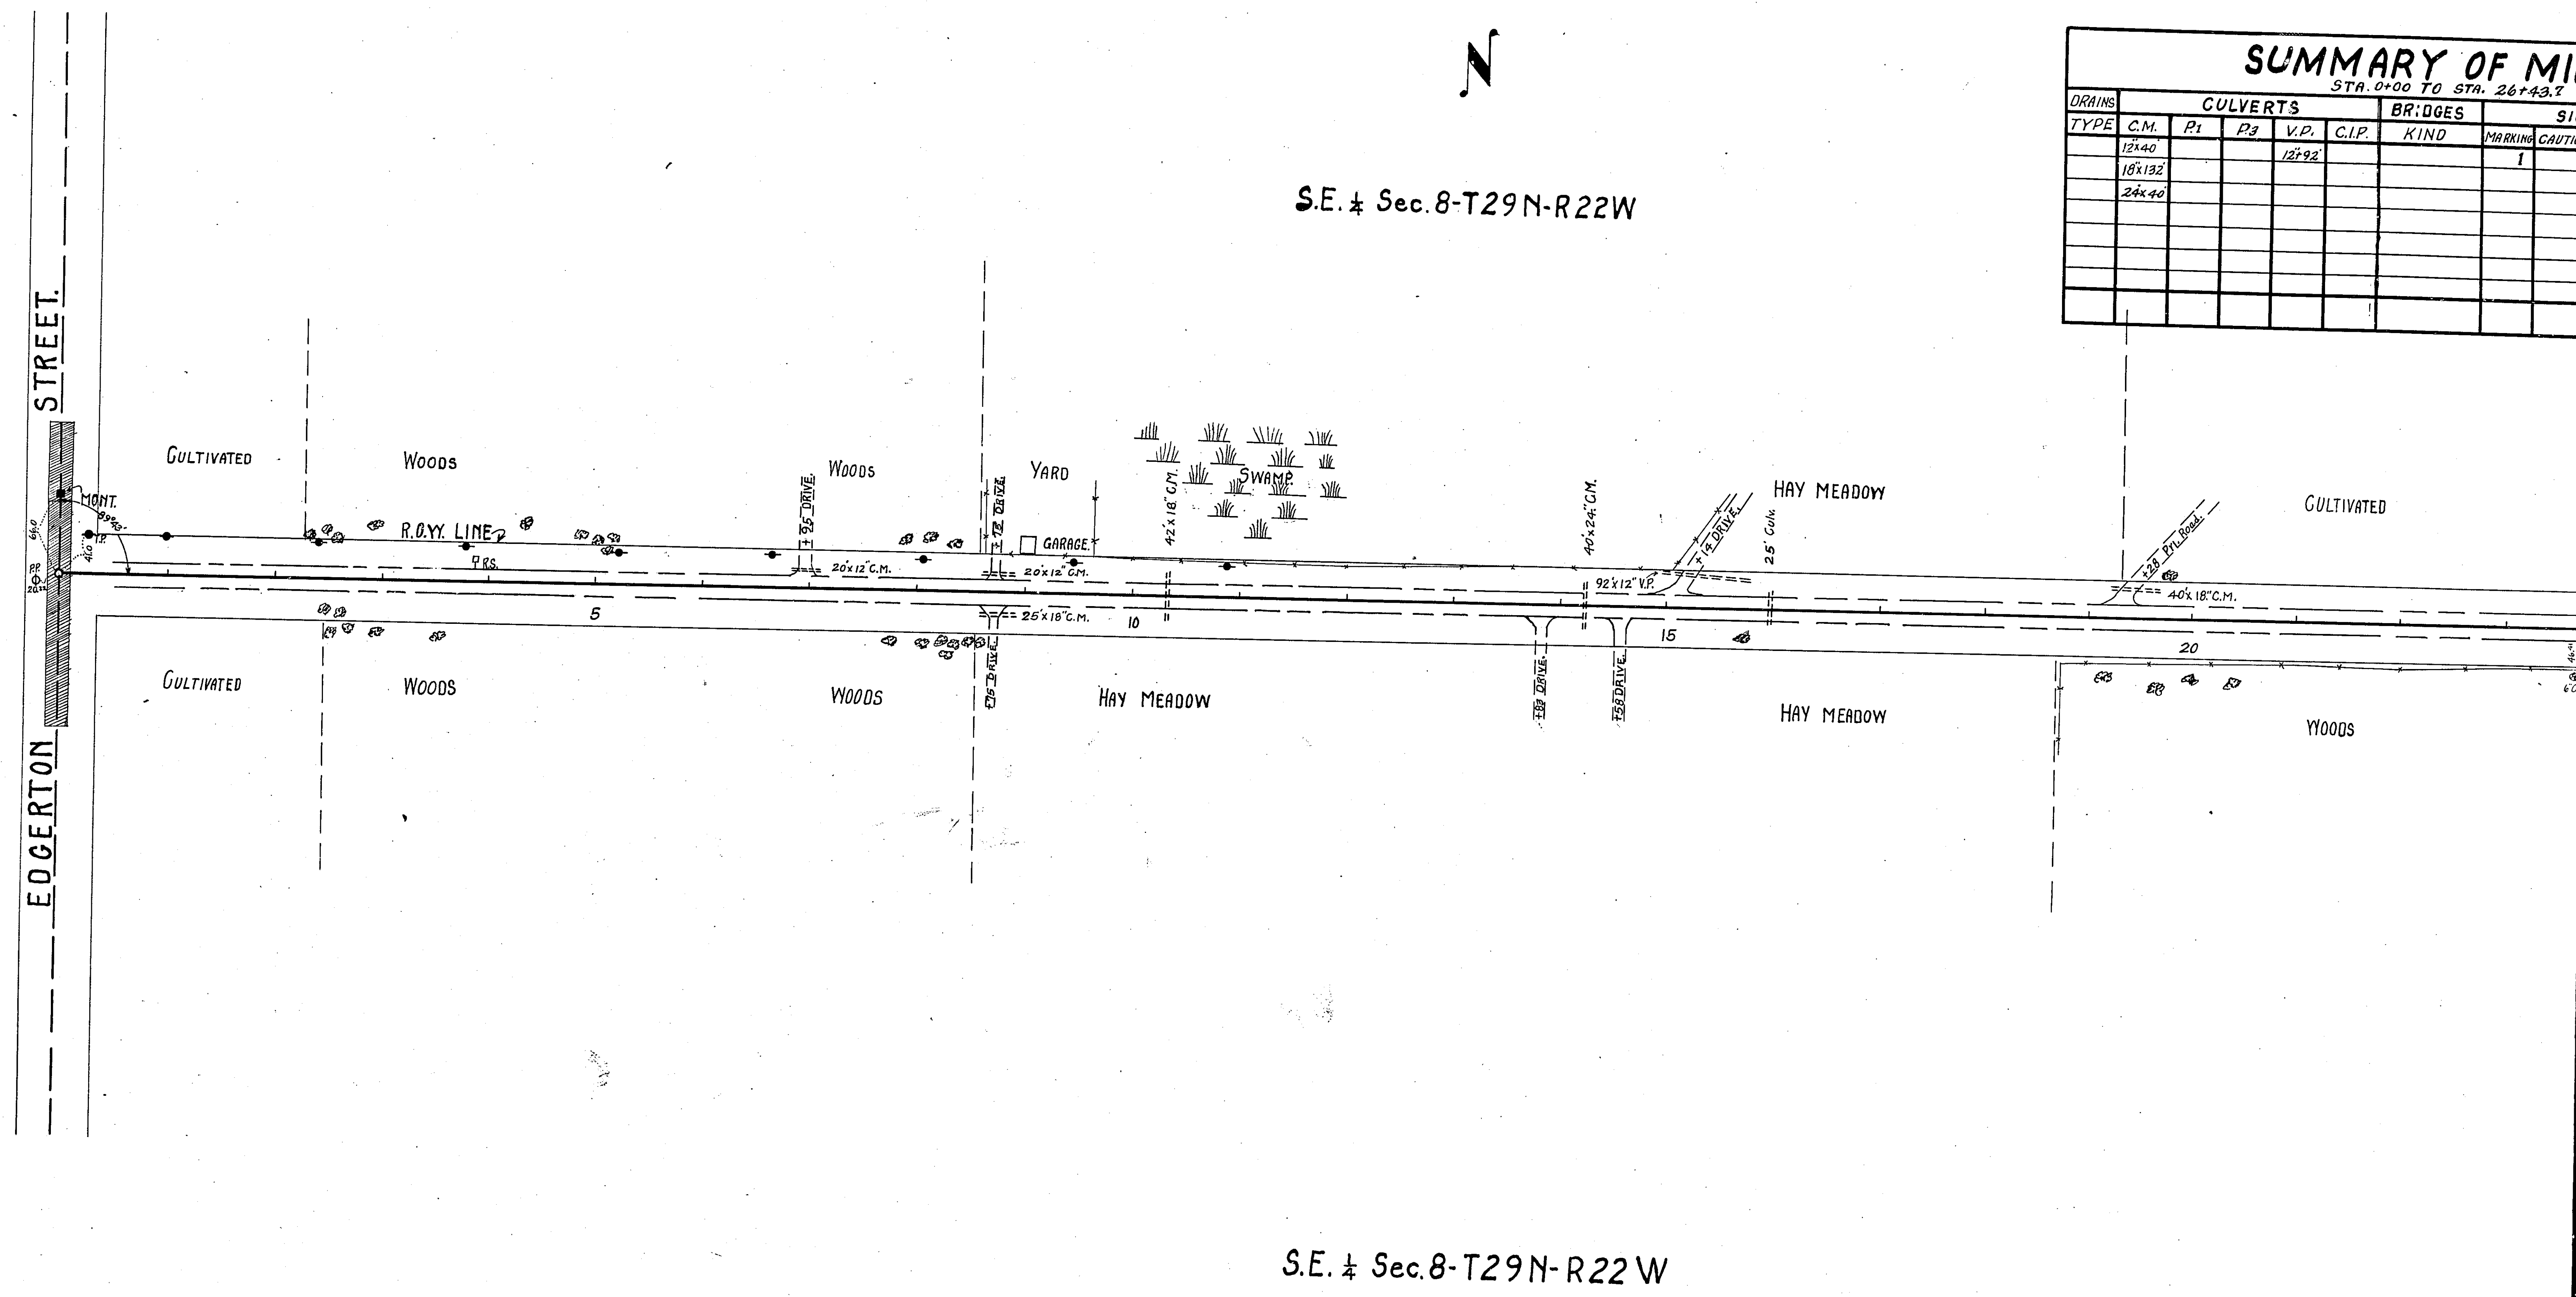


S.E. 1/4 Sec. 8-T29N-R22W

20XF-1/7

ST.

S.E. ¼ Sec. 8-T29N-R22W

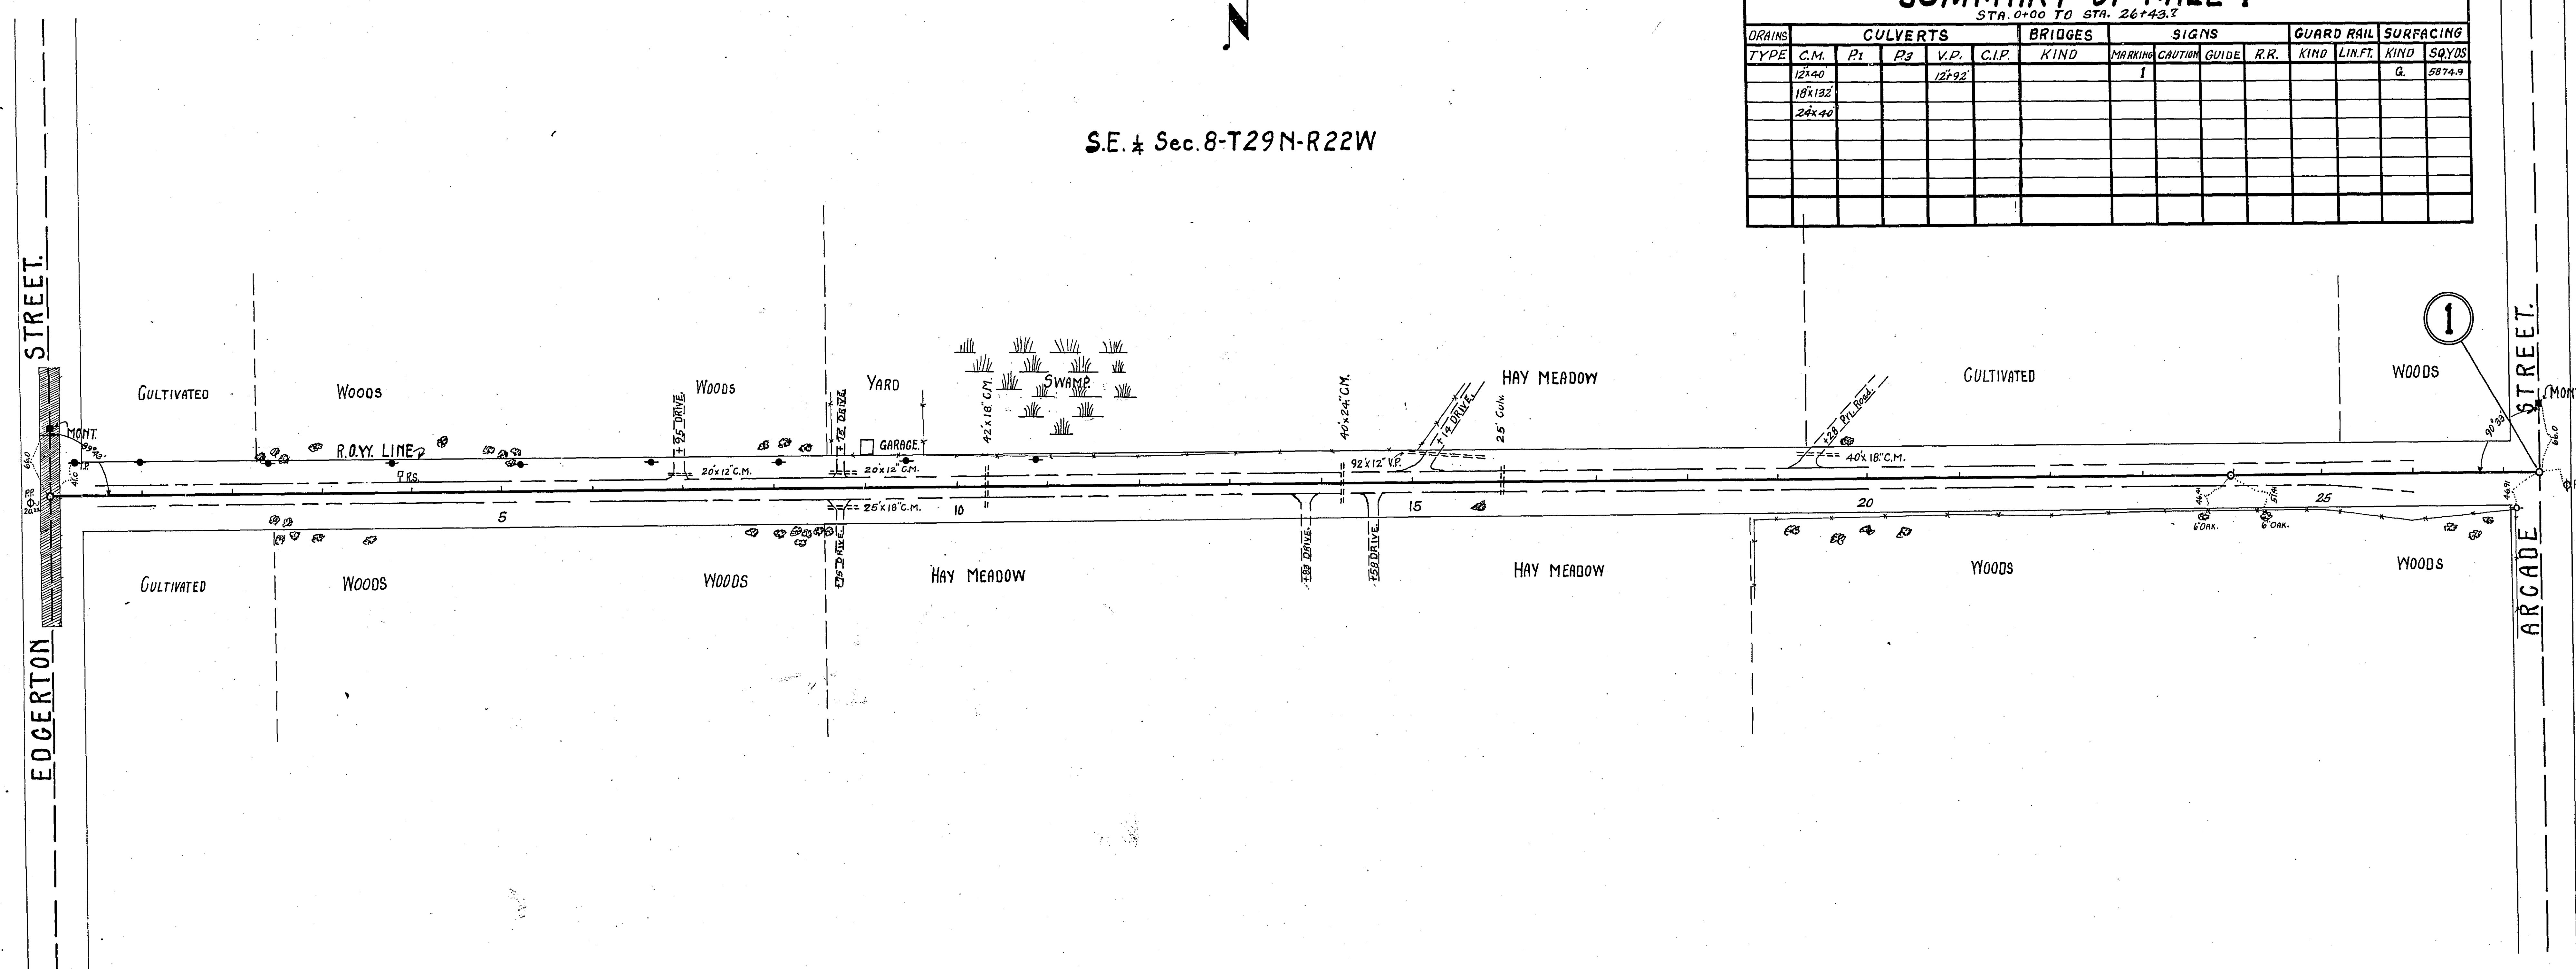

S.E. $\frac{1}{4}$ Sec. 8-T29N-R22W


20XF 277

0+00 to 52,

FROM HERE

Co. ROAD B
ROAD 1/2 66

N
1
10

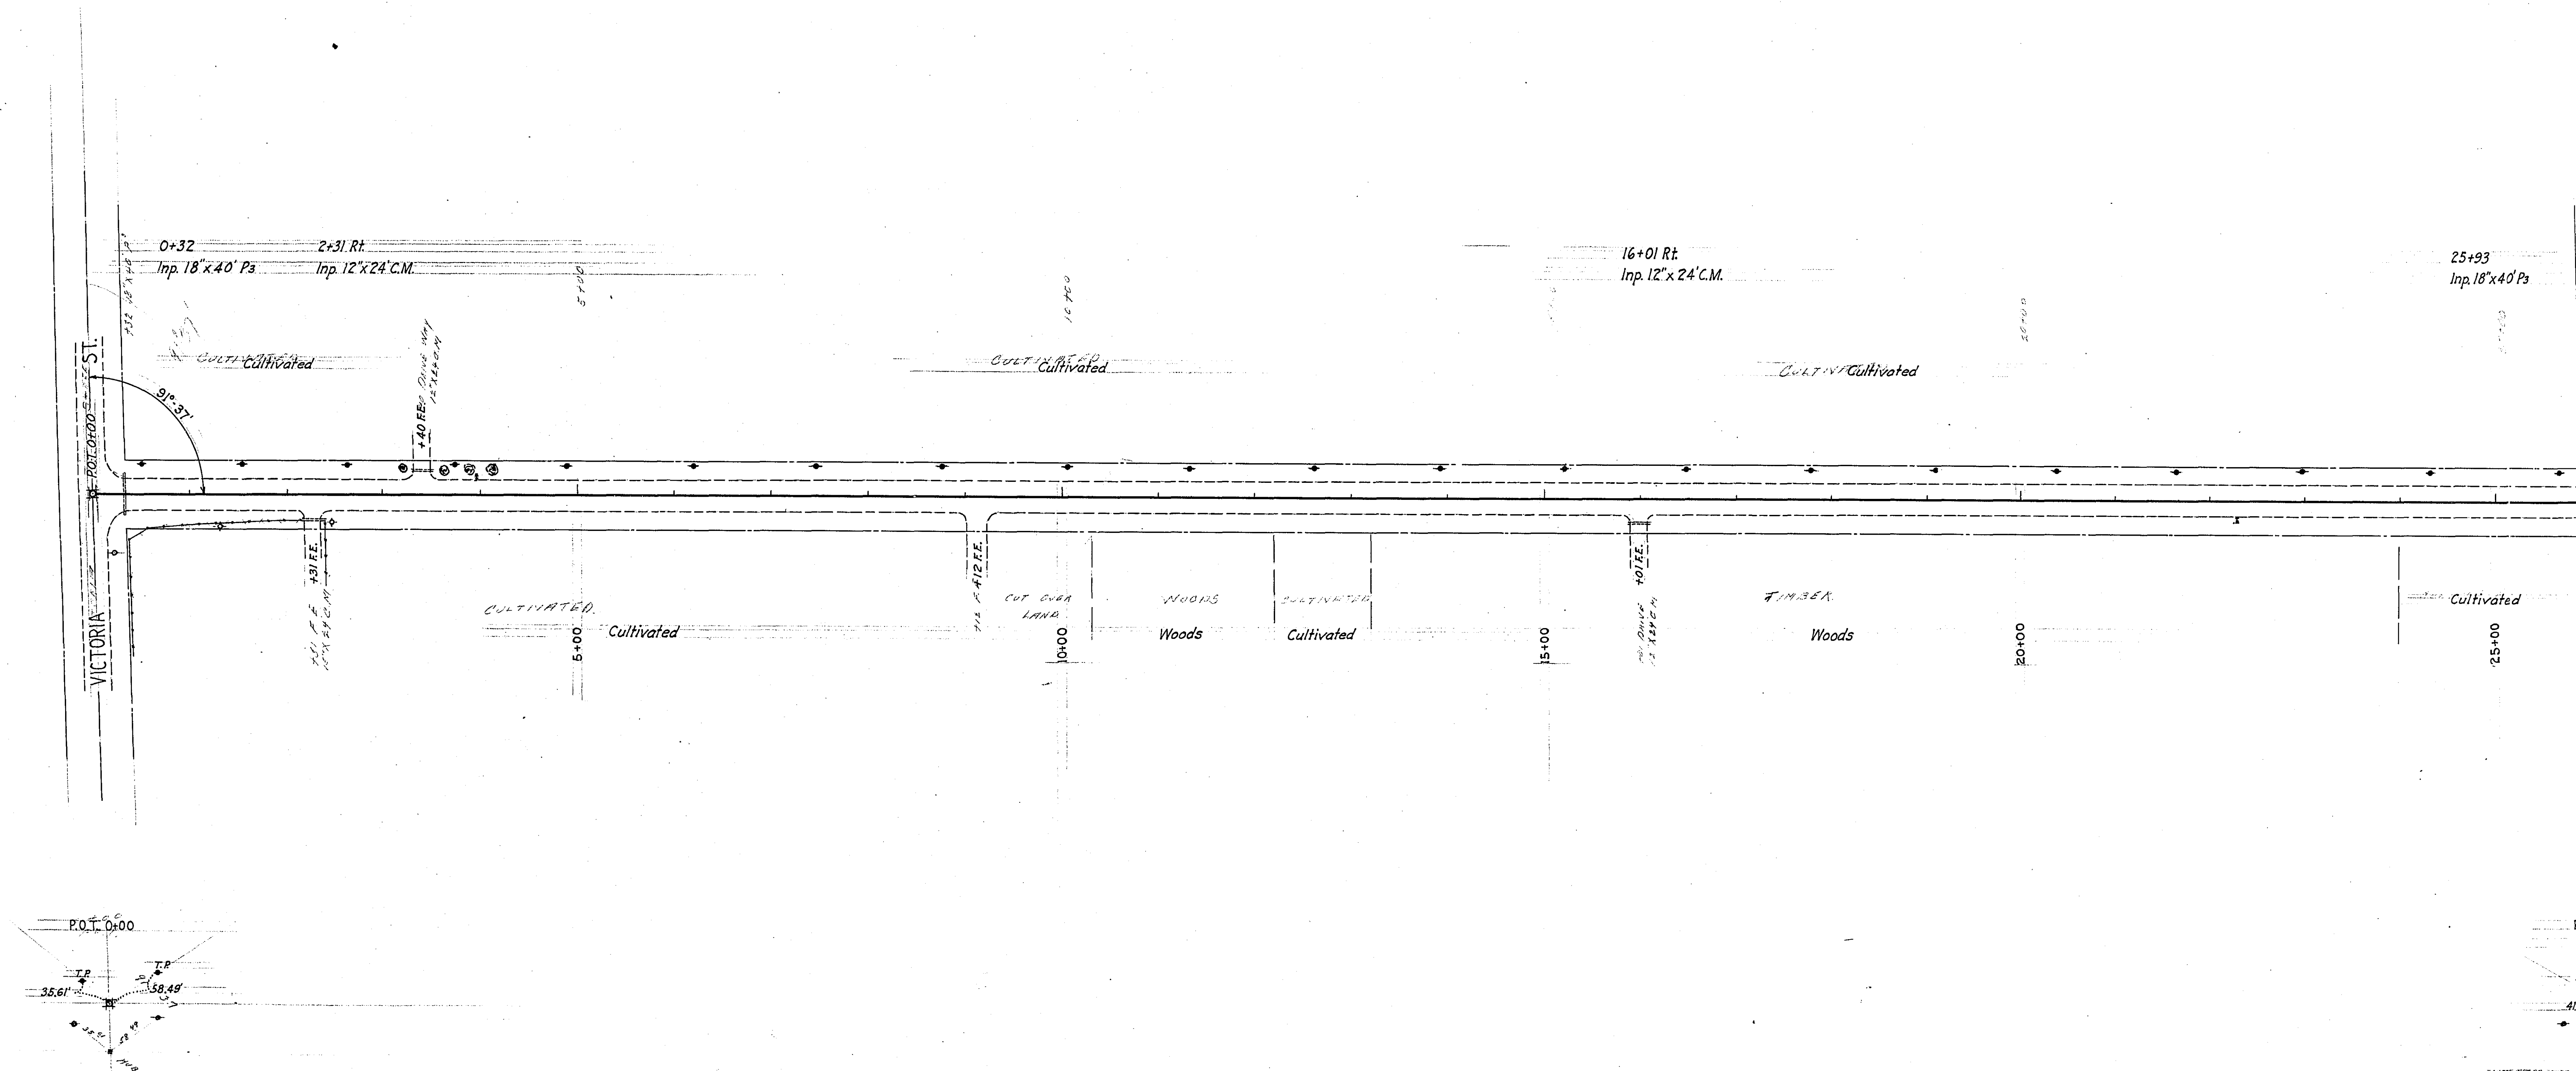

20XF-37

