


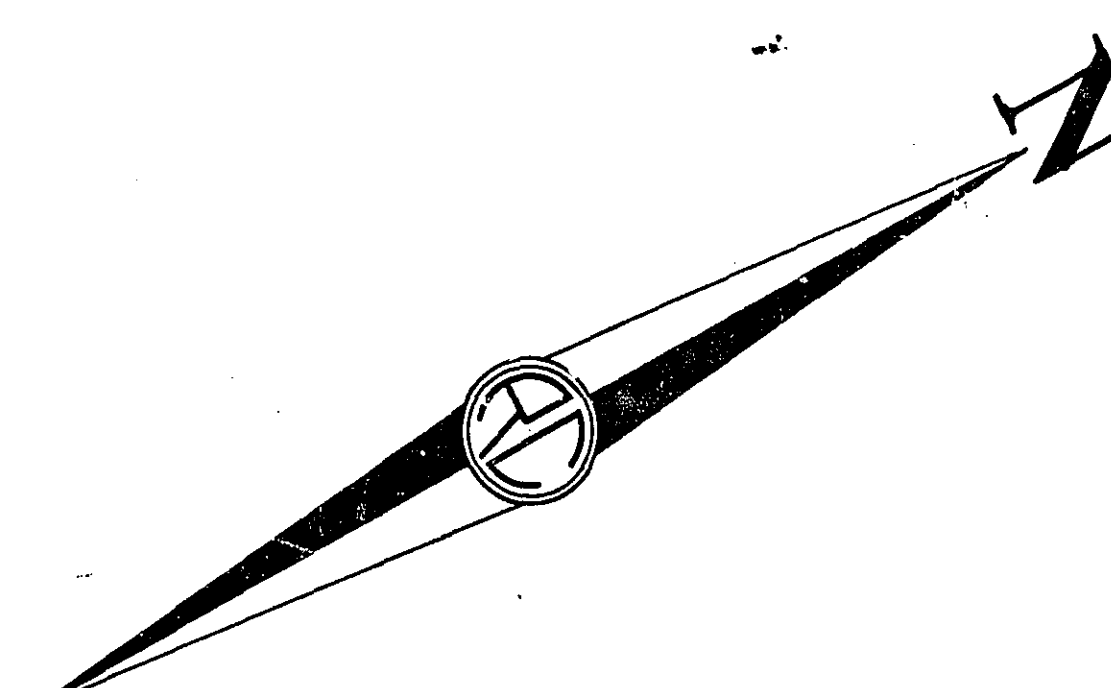

N.W. 1/4 SEC. 33-30-23

S.W. 1/4 SEC. 33-30-23

S.E. 1/4 SEC. 33-30-23

EQUATION
STA. 105+40.40 =
STA. 0+00

MATCH LINE STA. 6100

NEW BRIGHTON RD.

P.I. 105+40.40+0+00

P.O.T. 16+03.52

P.I. 26+26.10
Δ-44°00'R

P.I. 30+66.15
Δ-54°48'L

P.I. 33+66.5
Δ-14°13'L

P.I. 37+76.75
Δ-27°40'R

PC 29+46.40
Δ-54°48'
D-25°L
T-119.75
L-219.20
R-231.01
PT 31+66.60
PC 32+77.71
Δ-14°13'
D-8°L
T-89.39
L-177.71
R-716.78
PT 34+54.82
PC 35+73.08
Δ-27°40'
D-7°R
T-20.67
L-389.24
R-619.02

Start Here

Print



7/2/69

F-5/1,1





[illegible]

P.I. 72+48.53
A-30°46'


SW 1/4 SEC. 33 T. 30 N. R. 23 W.

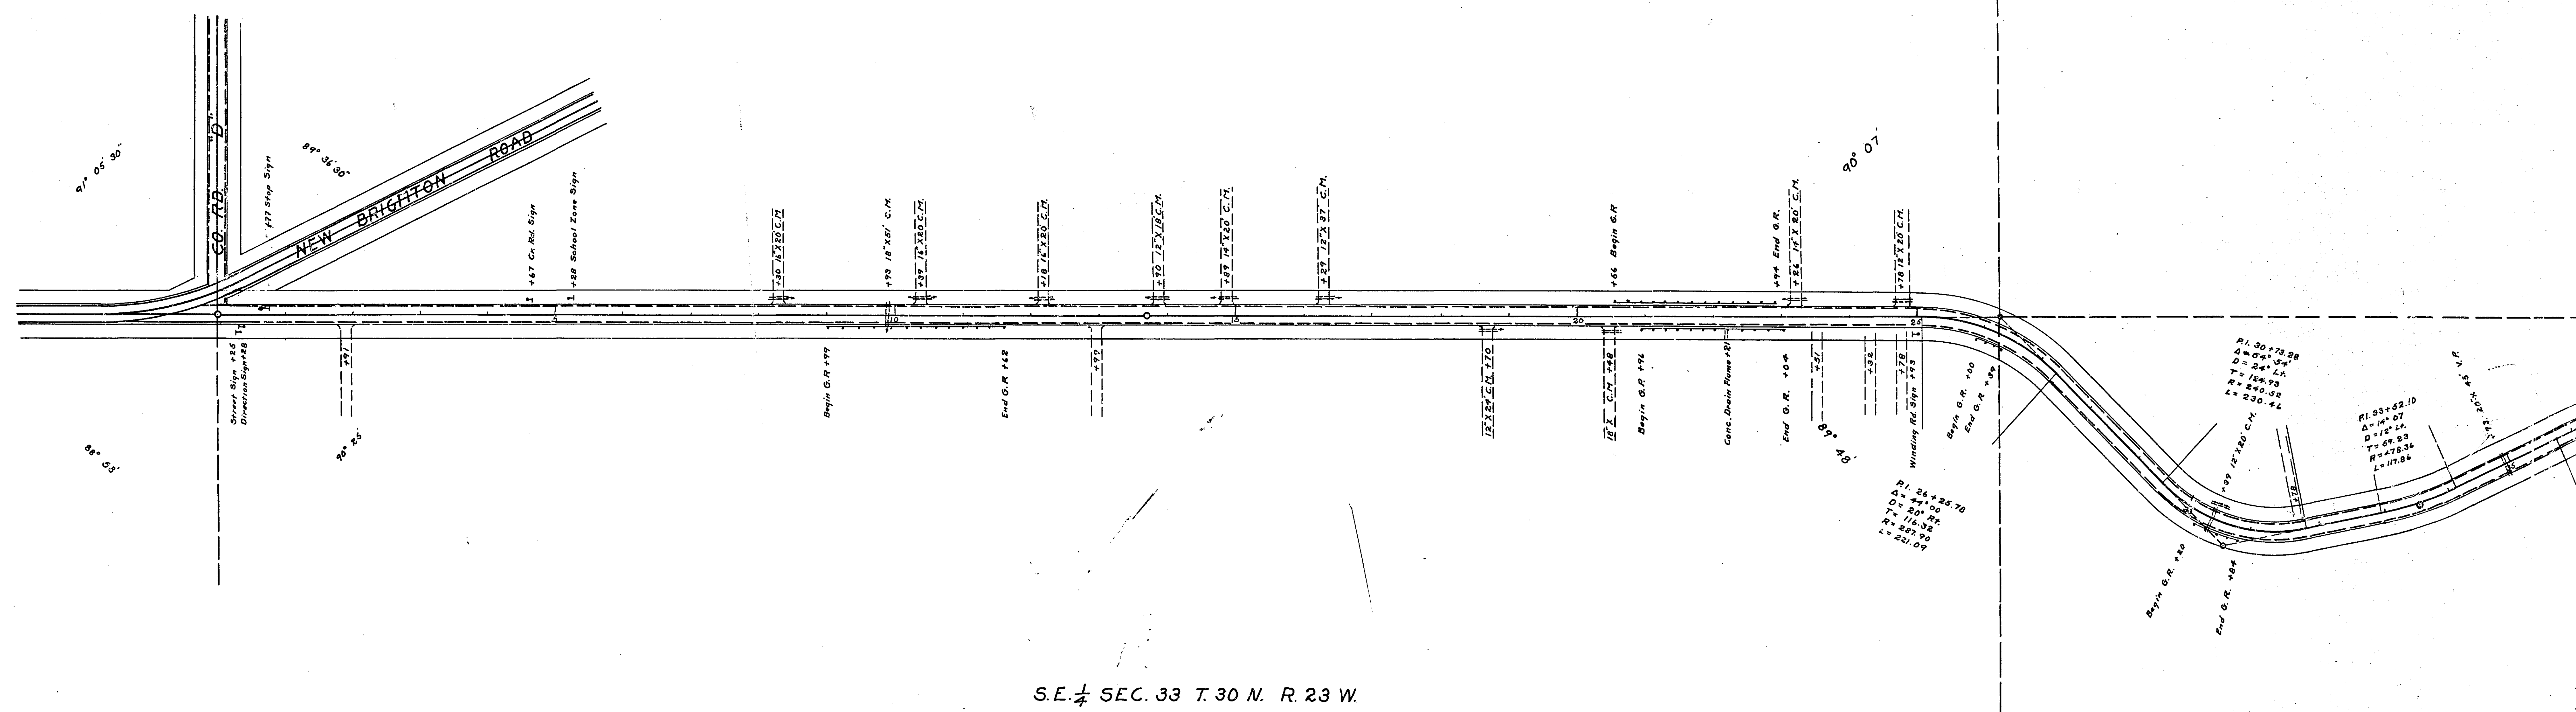
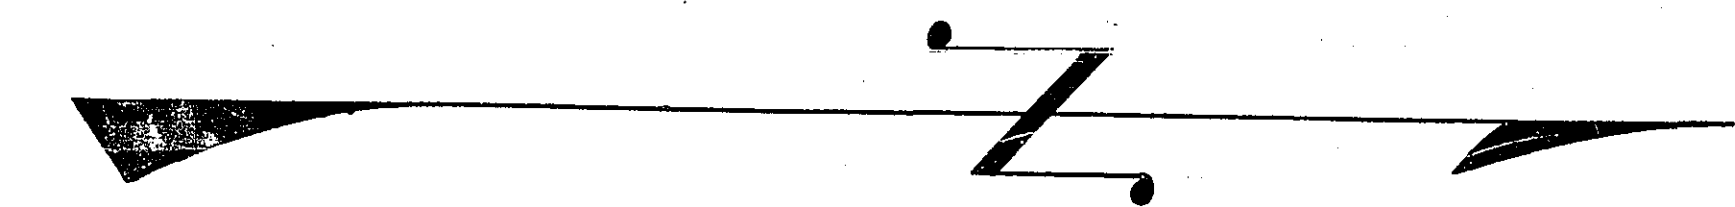


SE 1/4 SEC. 33 T. 30 N. R. 23 W.

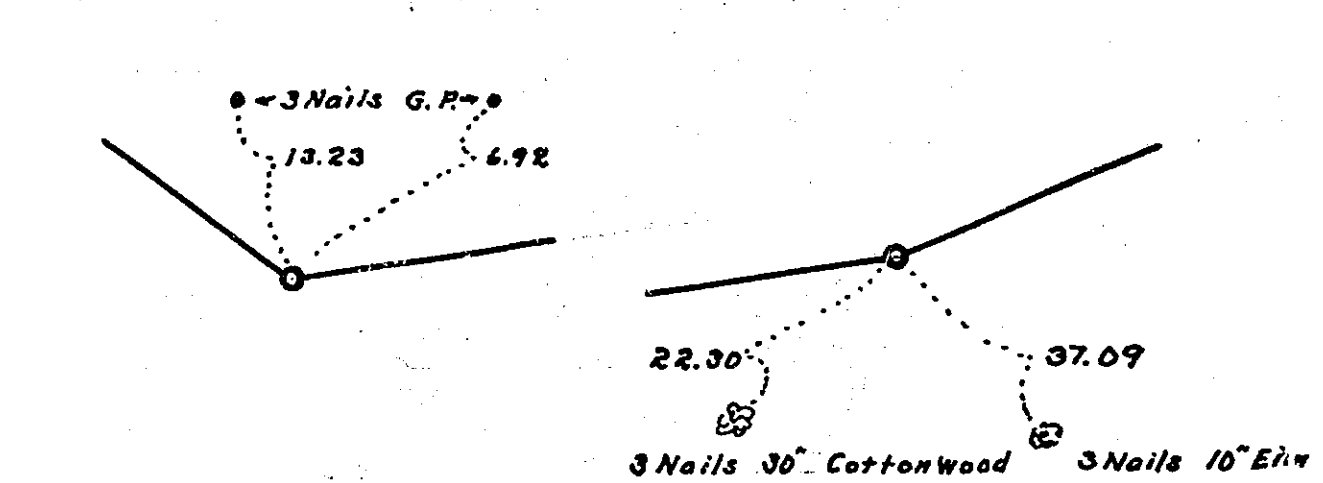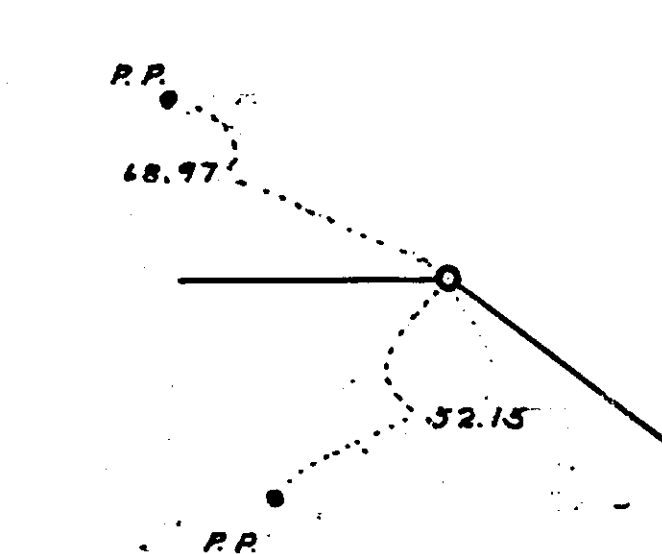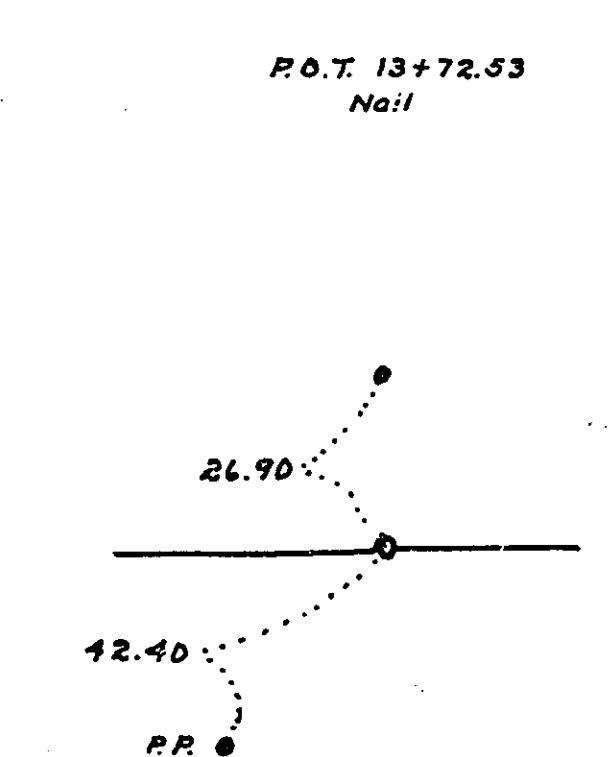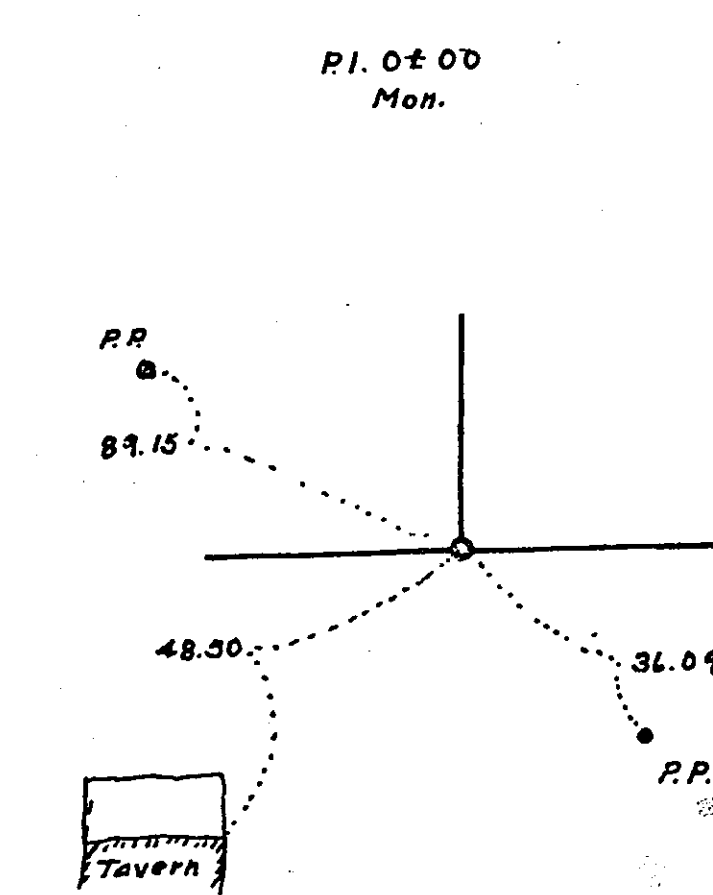

ROAD MAP
JOHANNA BLVD.
FROM CO. RD. D TO S.T.H. #10
ROAD NO. 6

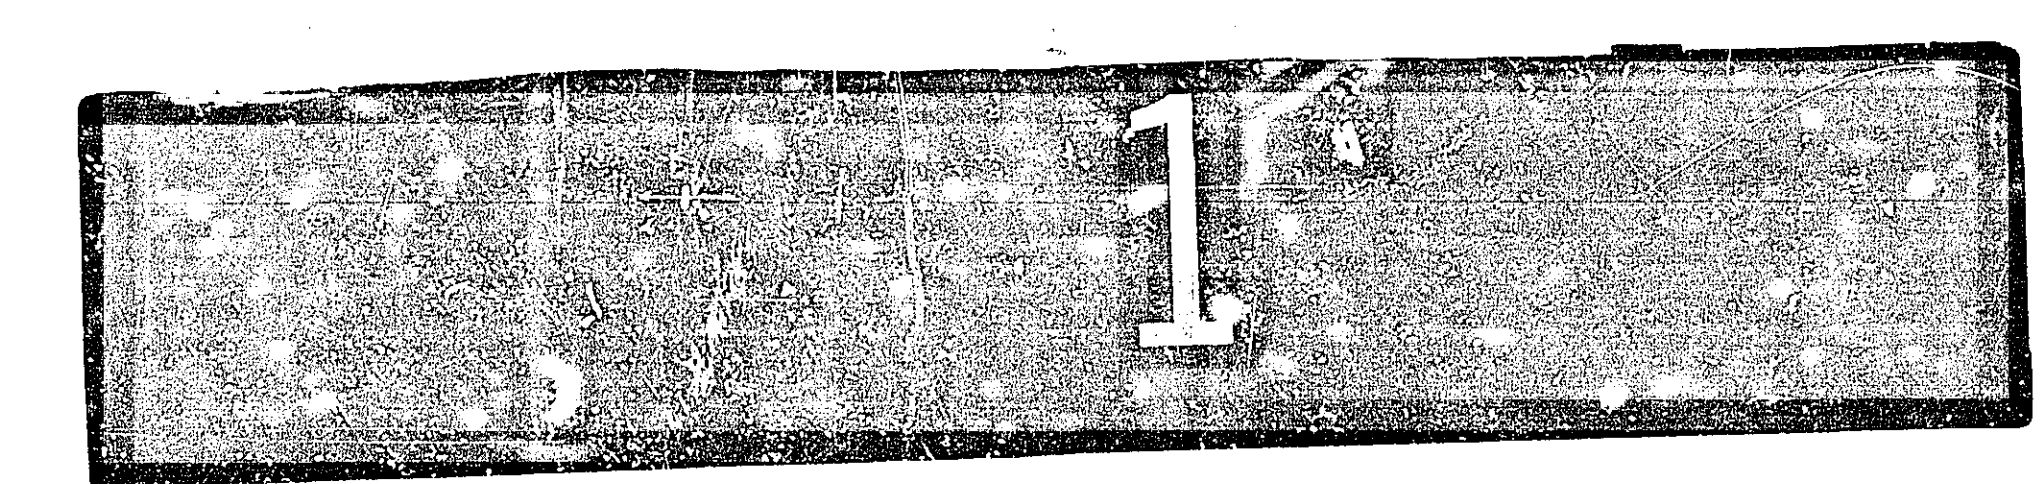

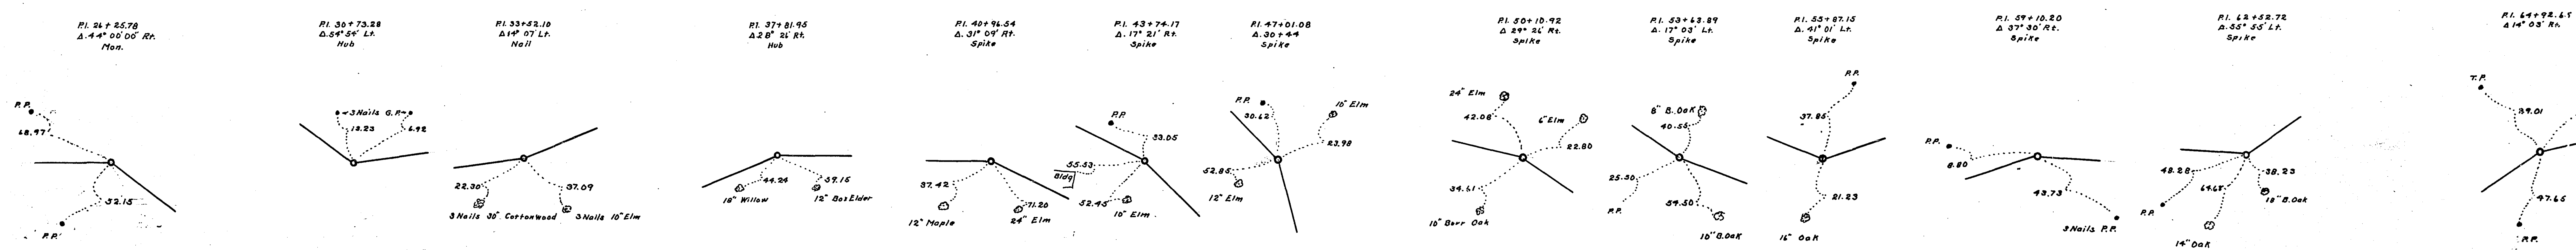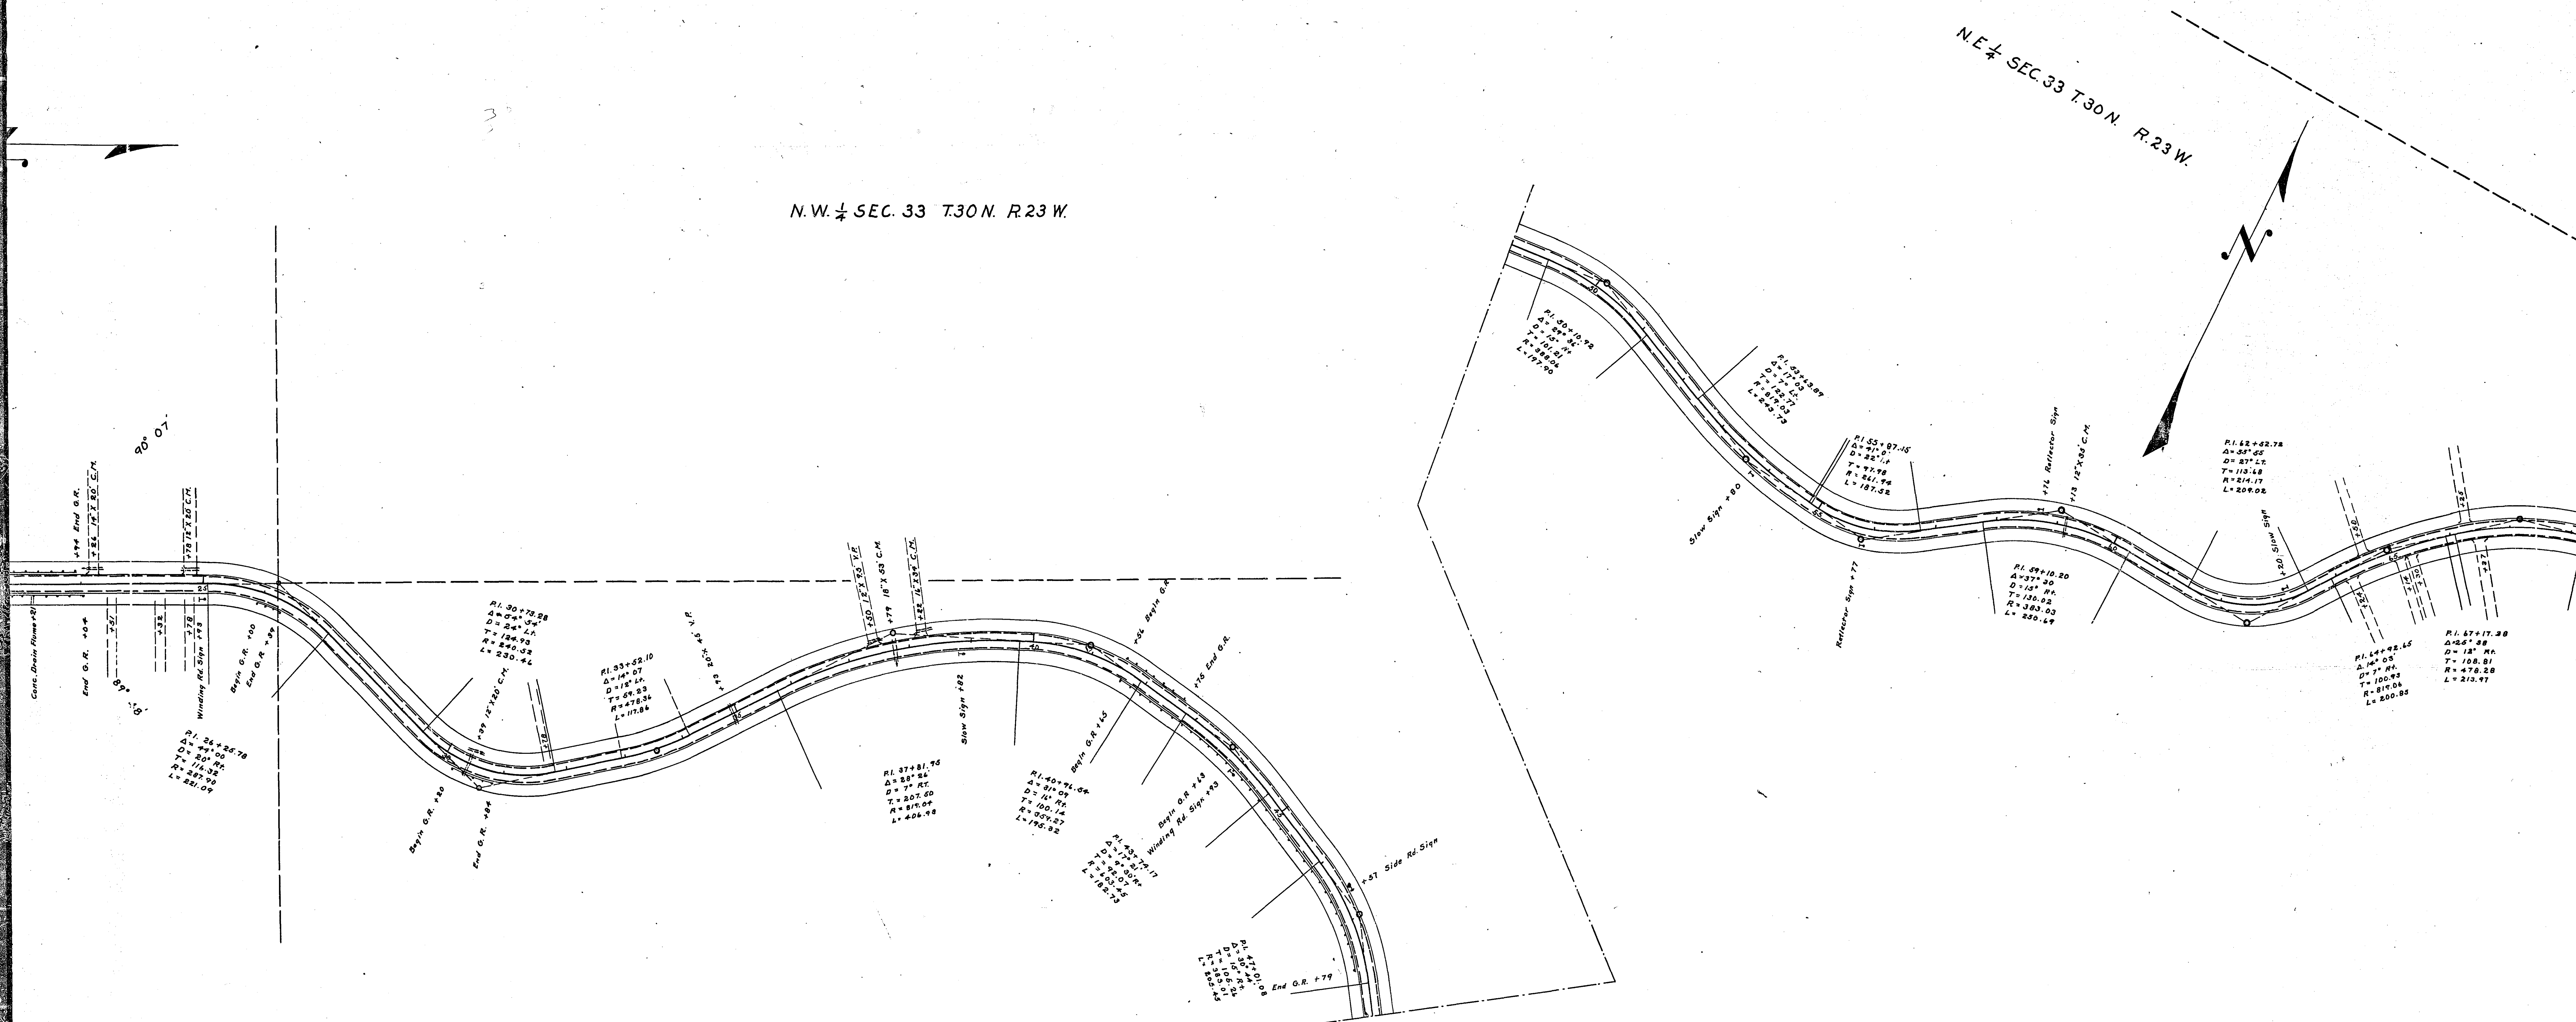

ROAD MAP
JOHANNA BLVD.
FROM CO. RD. D TO S.T.H. #10
ROAD NO. 6

NE 1/4 SEC. 33 T.30 N. R. 23 W.

SW 1/4 SEC. 27 T.30 N. R. 23 W.

NW 1/4 SEC. 34 T.30 N. R. 23 W.

